


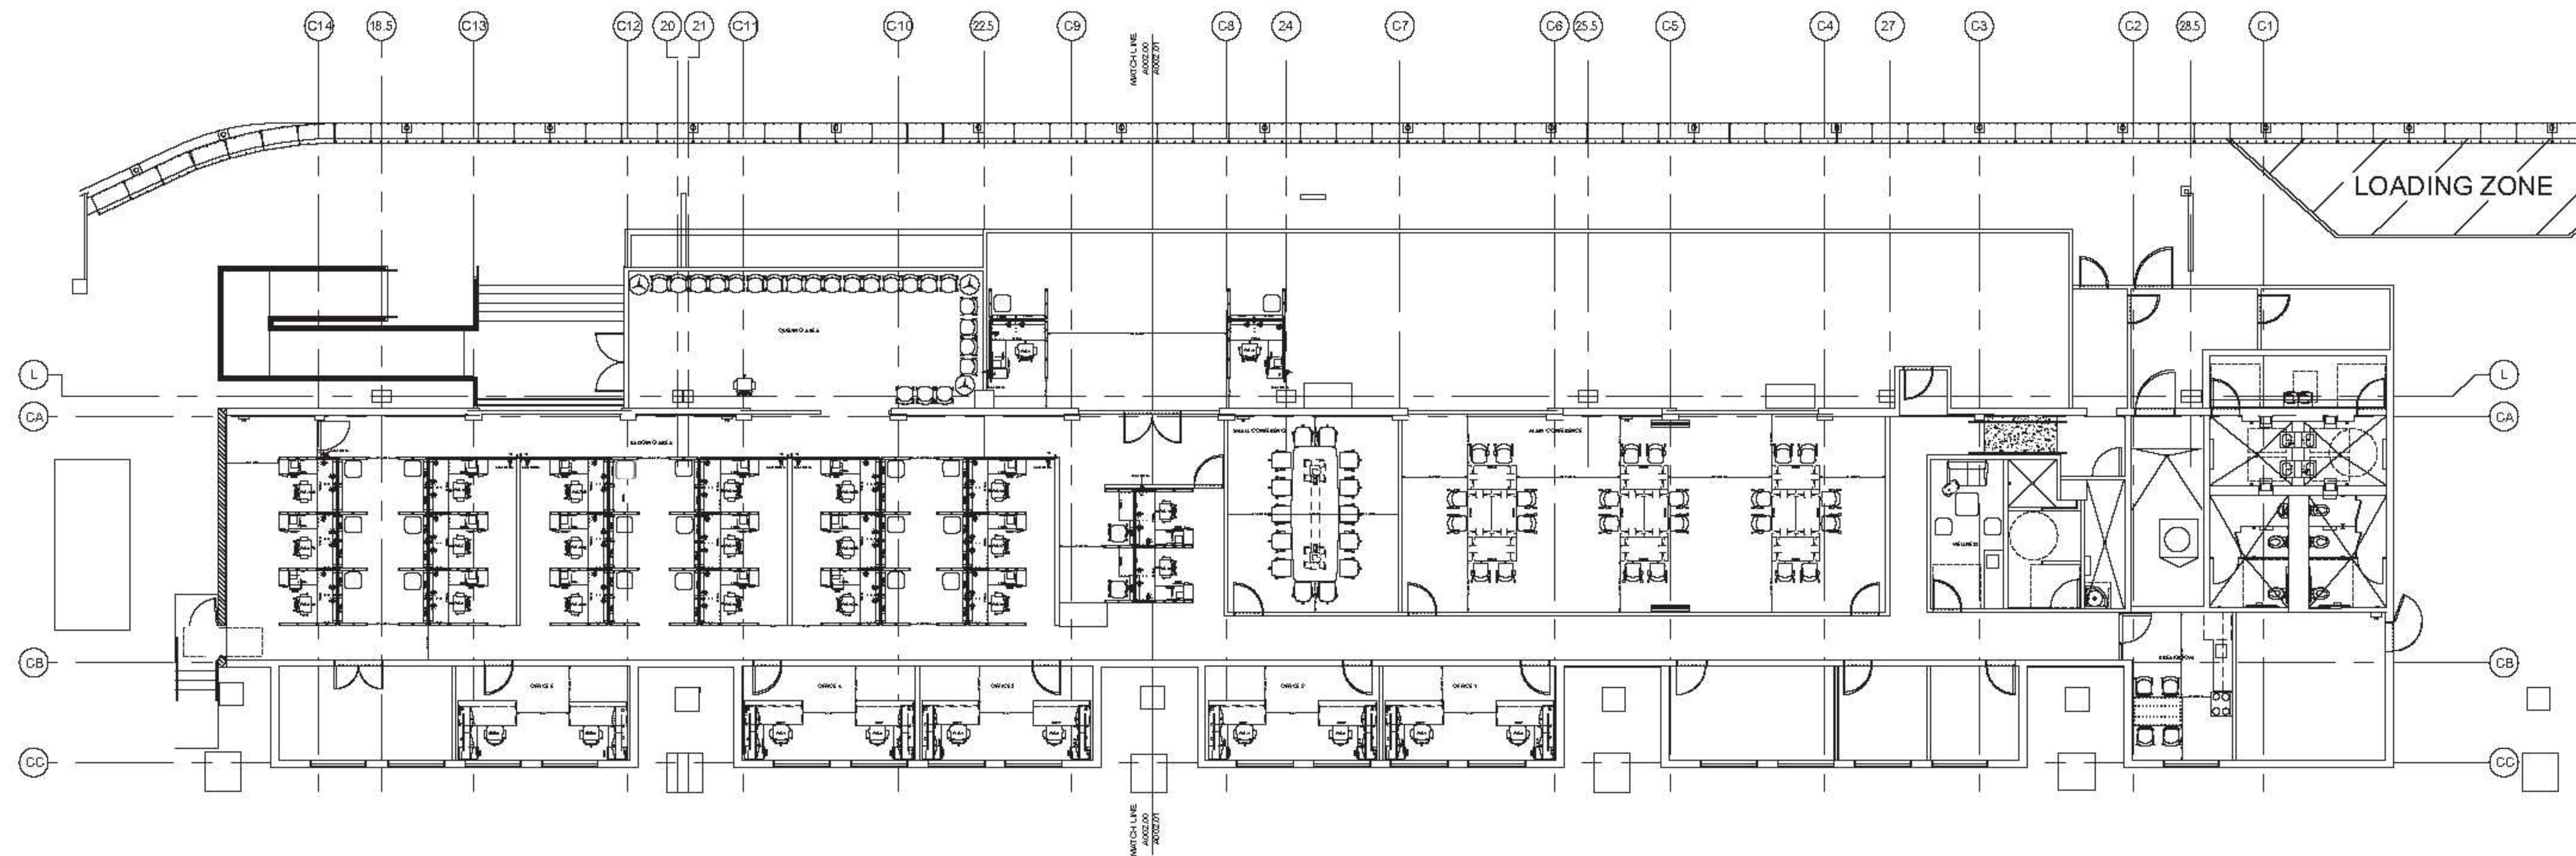

Floor Plan - OVERALL PLAN

Scale: 3/8"=1'-0"

23048 - DOTA - HNL PASS/ID OFFICE RENOVATION

23048_0.ccmdrw

9/15/2022

Designer: JANET C.

This drawing is the confidential property of The Systemcenter, Inc. and contains information that is not to be used except in consideration of bids or proposals rendered herewith. Reproduction or copying of this drawing, in whole or part is prohibited.

SYSTEMCENTER
1738 Silva Street - Honolulu, HI 96819 - (808) 847-0911

1/11

PROJ NO. CO1322-63

ADDENDUM #2

DATE: 03/10/23

Property of The Systemcenter, Inc.



Finishes and renderings shown within may not match exactly,
actual finish samples are available at Systemcenter's
showroom and should be confirmed before ordering.

Rendering - OVERALL PLAN

23048 - DOTA - HNL PASS/ID OFFICE RENOVATION

23048_0.ccmdrw

9/15/2022

Designer: JANET C.

This drawing is the confidential property of
The Systemcenter, Inc. and contains
information that is not to be used except in
consideration of bids or proposals rendered
herewith. Reproduction or copying of this
drawing, in whole or part is prohibited.

SYSTEMCENTER®
1738 Silva Street - Honolulu, HI 96819 - (808) 847-0911

2/11

PROJ NO. CO1322-63

ADDENDUM #2


DATE: 03/10/23

- 1** 58H Panel w/ Markerboard Tile above + Fabric Tile below
- 2** 58H Panel w/ Slat Tile above + Fabric Tile below
- 3** 58H Monolithic Fabric Panel
- 4** 58H Fabric Panel w/ 8H Slat Tile
- 5** 34H Laminate Panel
- 6** Laminate Transaction Top
- 7** Panel Mounted Laminate Worksurface
- 8** Fixed Mtl BBF w/ Laminate Front
- 9** Mtl Locker w/ Laminate Front
- 10** Task Chair w/ Hard Casters
- 11** Pouf
- 12** Freestanding Lexan Screen w/ 2-3/4" Cut-out



PLEASE REPLACE
POUFS WITH CHAIRS
W/CASTERS SIMILAR
TO MATCH ADA
STATIONS ON
FOLLOWING PAGE.

Key Plan

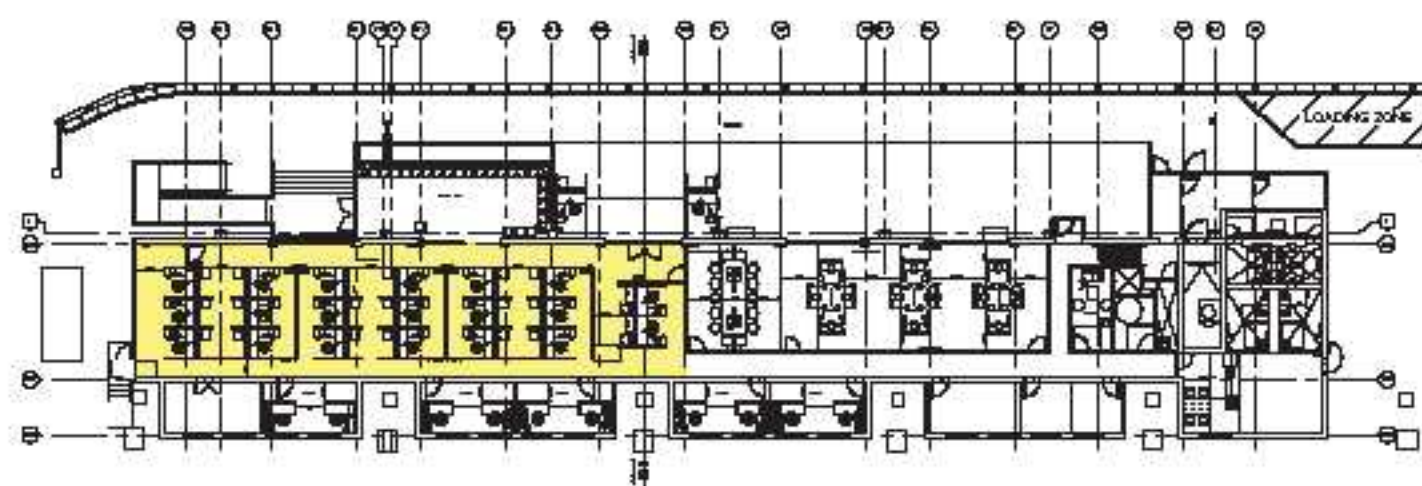

Finishes and renderings shown within may not match exactly, actual finish samples are available at Systemcenter's showroom and should be confirmed before ordering.

Rendering - BADGING AREA WORKSTATION TYPICAL

23048 - DOTA - HNL PASS/ID OFFICE RENOVATION

23048_0.ccmdrw

9/15/2022

Designer: JANET C.

This drawing is the confidential property of The Systemcenter, Inc. and contains information that is not to be used except in consideration of bids or proposals rendered herewith. Reproduction or copying of this drawing, in whole or part is prohibited.

SYSTEMCENTER®
1738 Silva Street - Honolulu, HI 96819 - (808) 847-0911

3/11



PROJ NO. CO1322-63

ADDENDUM #2

DATE: 03/10/23

- 1 58H Panel w/ Markerboard Tile above + Fabric Tile below
- 2 58H Panel w/ Slat Tile above + Fabric Tile below
- 3 58H Monolithic Fabric Panel
- 4 58H Fabric Panel w/ 8H Slat Tile
- 5 34H Laminate Panel
- 6 Laminate Transaction Top
- 7 Laminate Transaction Top at 29H
- 8 Panel Mounted Laminate Worksurface
- 9 Fixed Mtl BBF w/ Laminate Front
- 10 Mtl Locker w/ Laminate Front
- 11 Task Chair w/ Hard Casters
- 12 Side Chair w/ Hard Casters

Key Plan

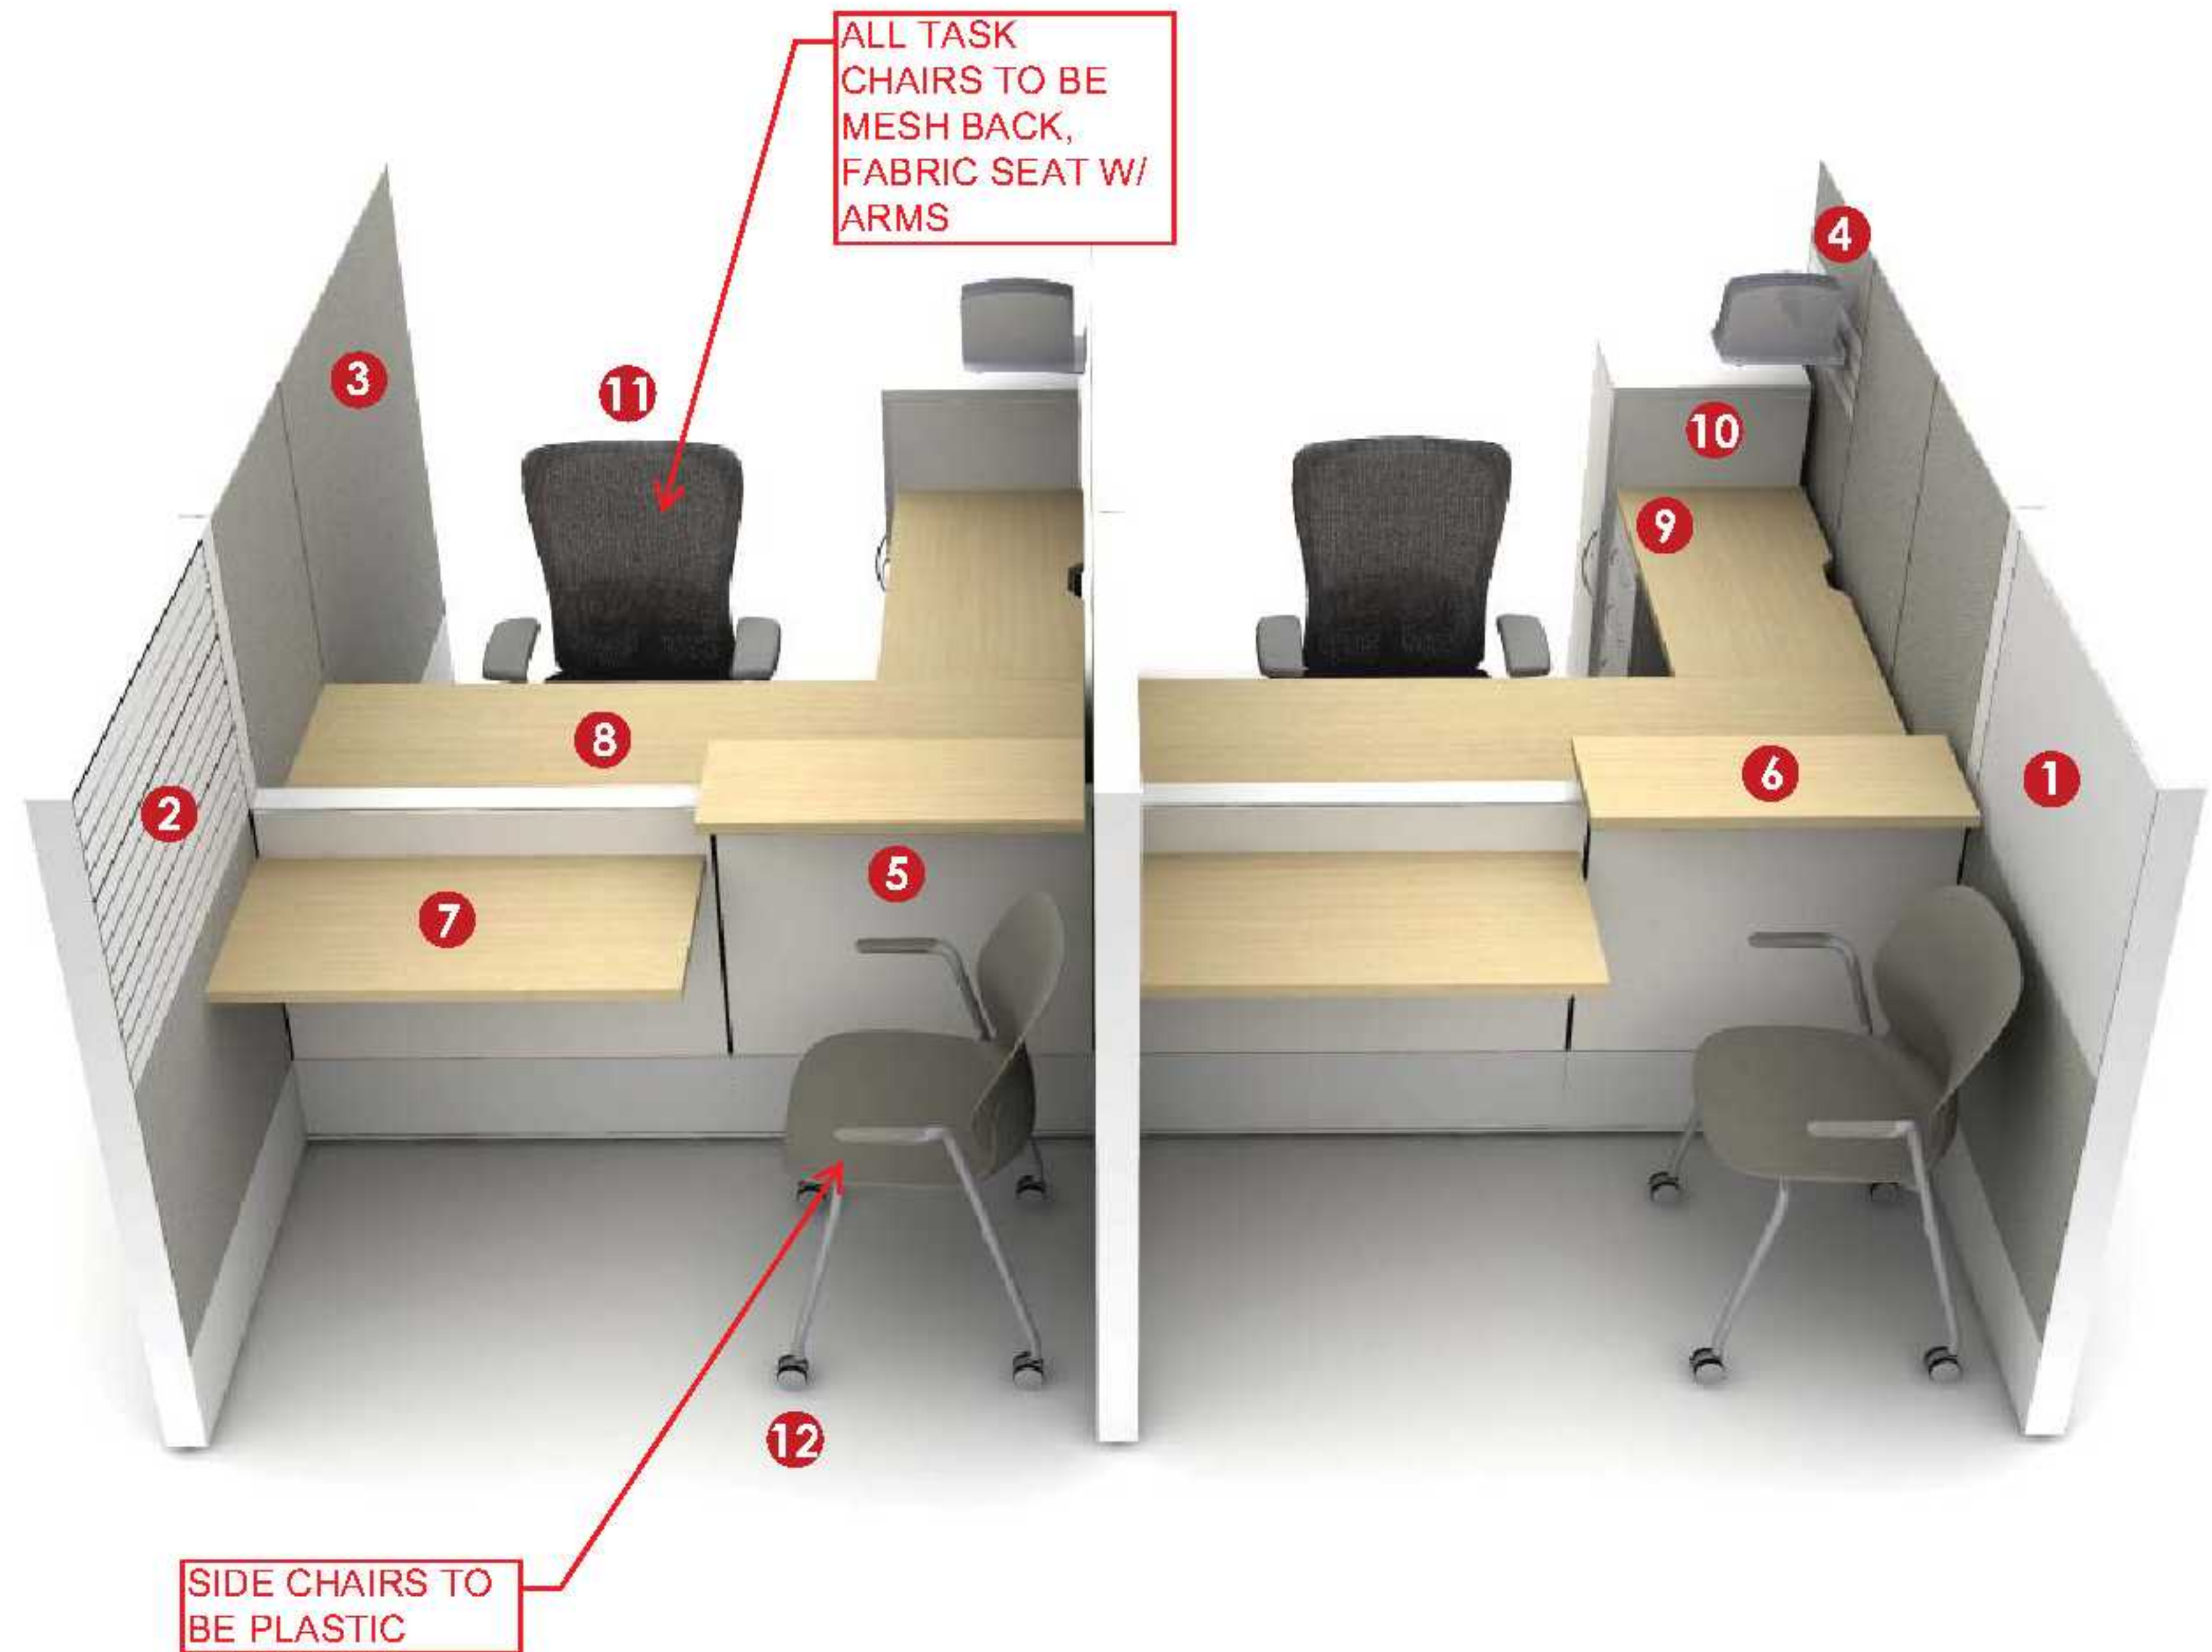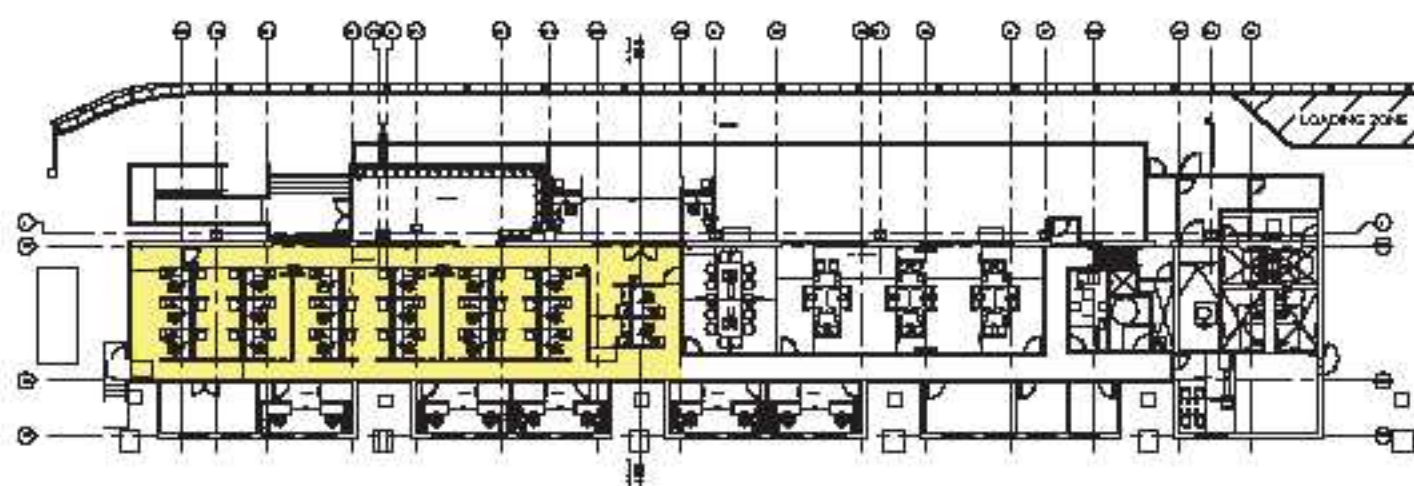

Finishes and renderings shown within may not match exactly, actual finish samples are available at Systemcenter's showroom and should be confirmed before ordering.

Rendering - BADGING AREA ADA WORKSTATION TYPICAL

23048 - DOTA - HNL PASS/ID OFFICE RENOVATION

23048_0.cmdrw

9/15/2022

Designer: JANET C.

This drawing is the confidential property of The Systemcenter, Inc. and contains information that is not to be used except in consideration of bids or proposals rendered herewith. Reproduction or copying of this drawing, in whole or part is prohibited.

SYSTEMCENTER
1738 Silva Street - Honolulu, HI 96819 - (808) 847-0911

4/11


PROJ NO. CO1322-63

ADDENDUM #2

DATE: 03/10/23

- 1 Guest Seat
- 2 Side Table
- 3 Task Chair w/ Hard Casters

Key Plan

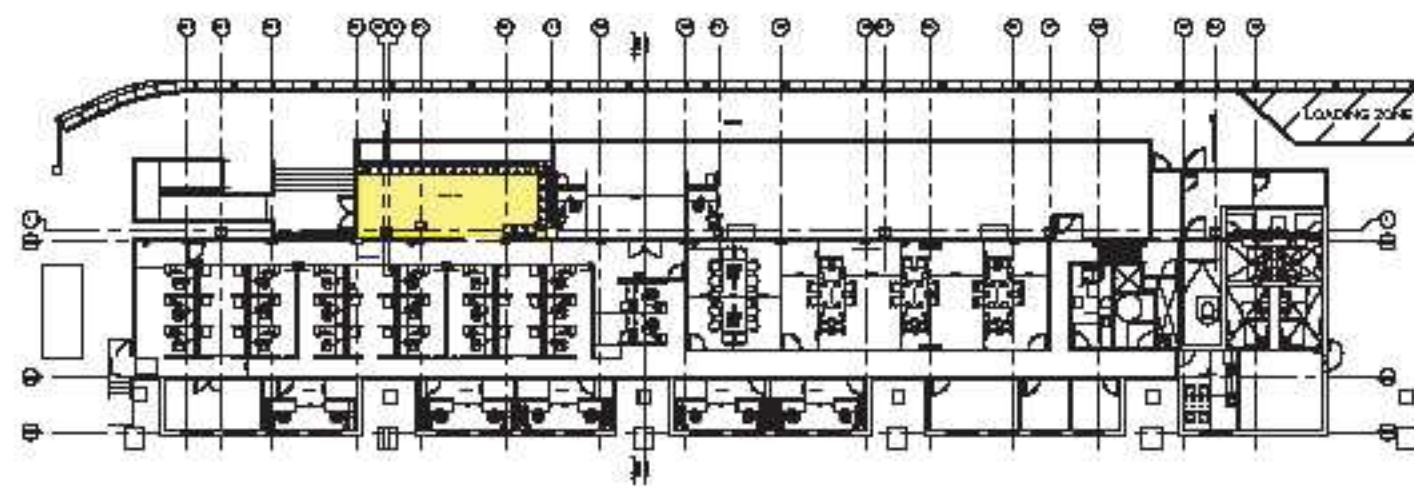

ALL GUEST
CHAIRS TO BE
PLASTIC AND
NESTING



ALL TASK
CHAIRS TO BE
MESH BACK,
FABRIC SEAT W/
ARMS

Finishes and renderings shown within may not match exactly,
actual finish samples are available at Systemcenter's
showroom and should be confirmed before ordering.

Rendering - QUEUING AREA

23048 - DOTA - HNL PASS/ID OFFICE RENOVATION

23048_0.cmdrw

9/15/2022

Designer: JANET C.

This drawing is the confidential property of
The Systemcenter, Inc. and contains
information that is not to be used except in
consideration of bids or proposals rendered
herewith. Reproduction or copying of this
drawing, in whole or part is prohibited.

SYSTEMCENTER®
1738 Silva Street - Honolulu, HI 96819 - (808) 847-0911

5/11


PROJ NO. CO1322-63

ADDENDUM #2

DATE: 03/10/23

- 1 Wood Conference Table w/ Power Module (3PWR/1DATA Each)
- 2 Conference Chair w/ Hard Casters

Key Plan

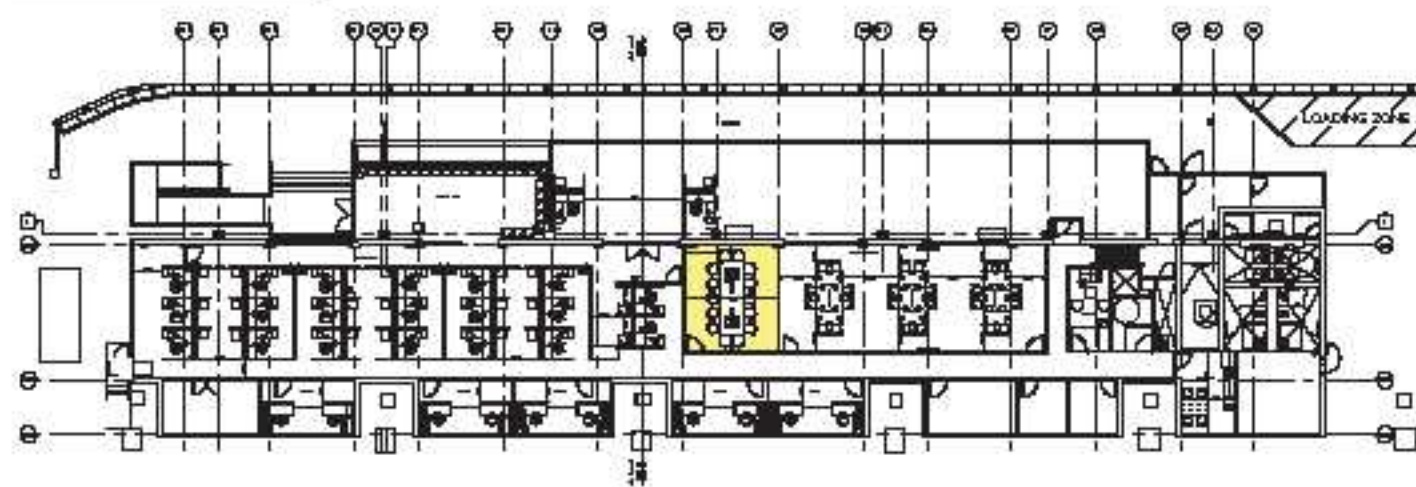

CHAIRS AT
SMALL CONF
ROOM TO BE
MESH BACK,
FABRIC SEATS,
WITH ARMS

Finishes and renderings shown within may not match exactly, actual finish samples are available at Systemcenter's showroom and should be confirmed before ordering.

Rendering - SMALL CONFERENCE

23048 - DOTA - HNL PASS/ID OFFICE RENOVATION

23048_0.ccmdrw

9/15/2022

Designer: JANET C.

This drawing is the confidential property of The Systemcenter, Inc. and contains information that is not to be used except in consideration of bids or proposals rendered herewith. Reproduction or copying of this drawing, in whole or part is prohibited.

SYSTEMCENTER®
1738 Silva Street - Honolulu, HI 96819 - (808) 847-0911

6/11

PROJ NO. CO1322-63



ADDENDUM #2

DATE: 03/10/23

PROVIDE
GROMMET AND
COVER AT EACH
TABLE

- 1 Laminate Flip-Top Table
- 2 Conference w/ Hard Casters

Key Plan

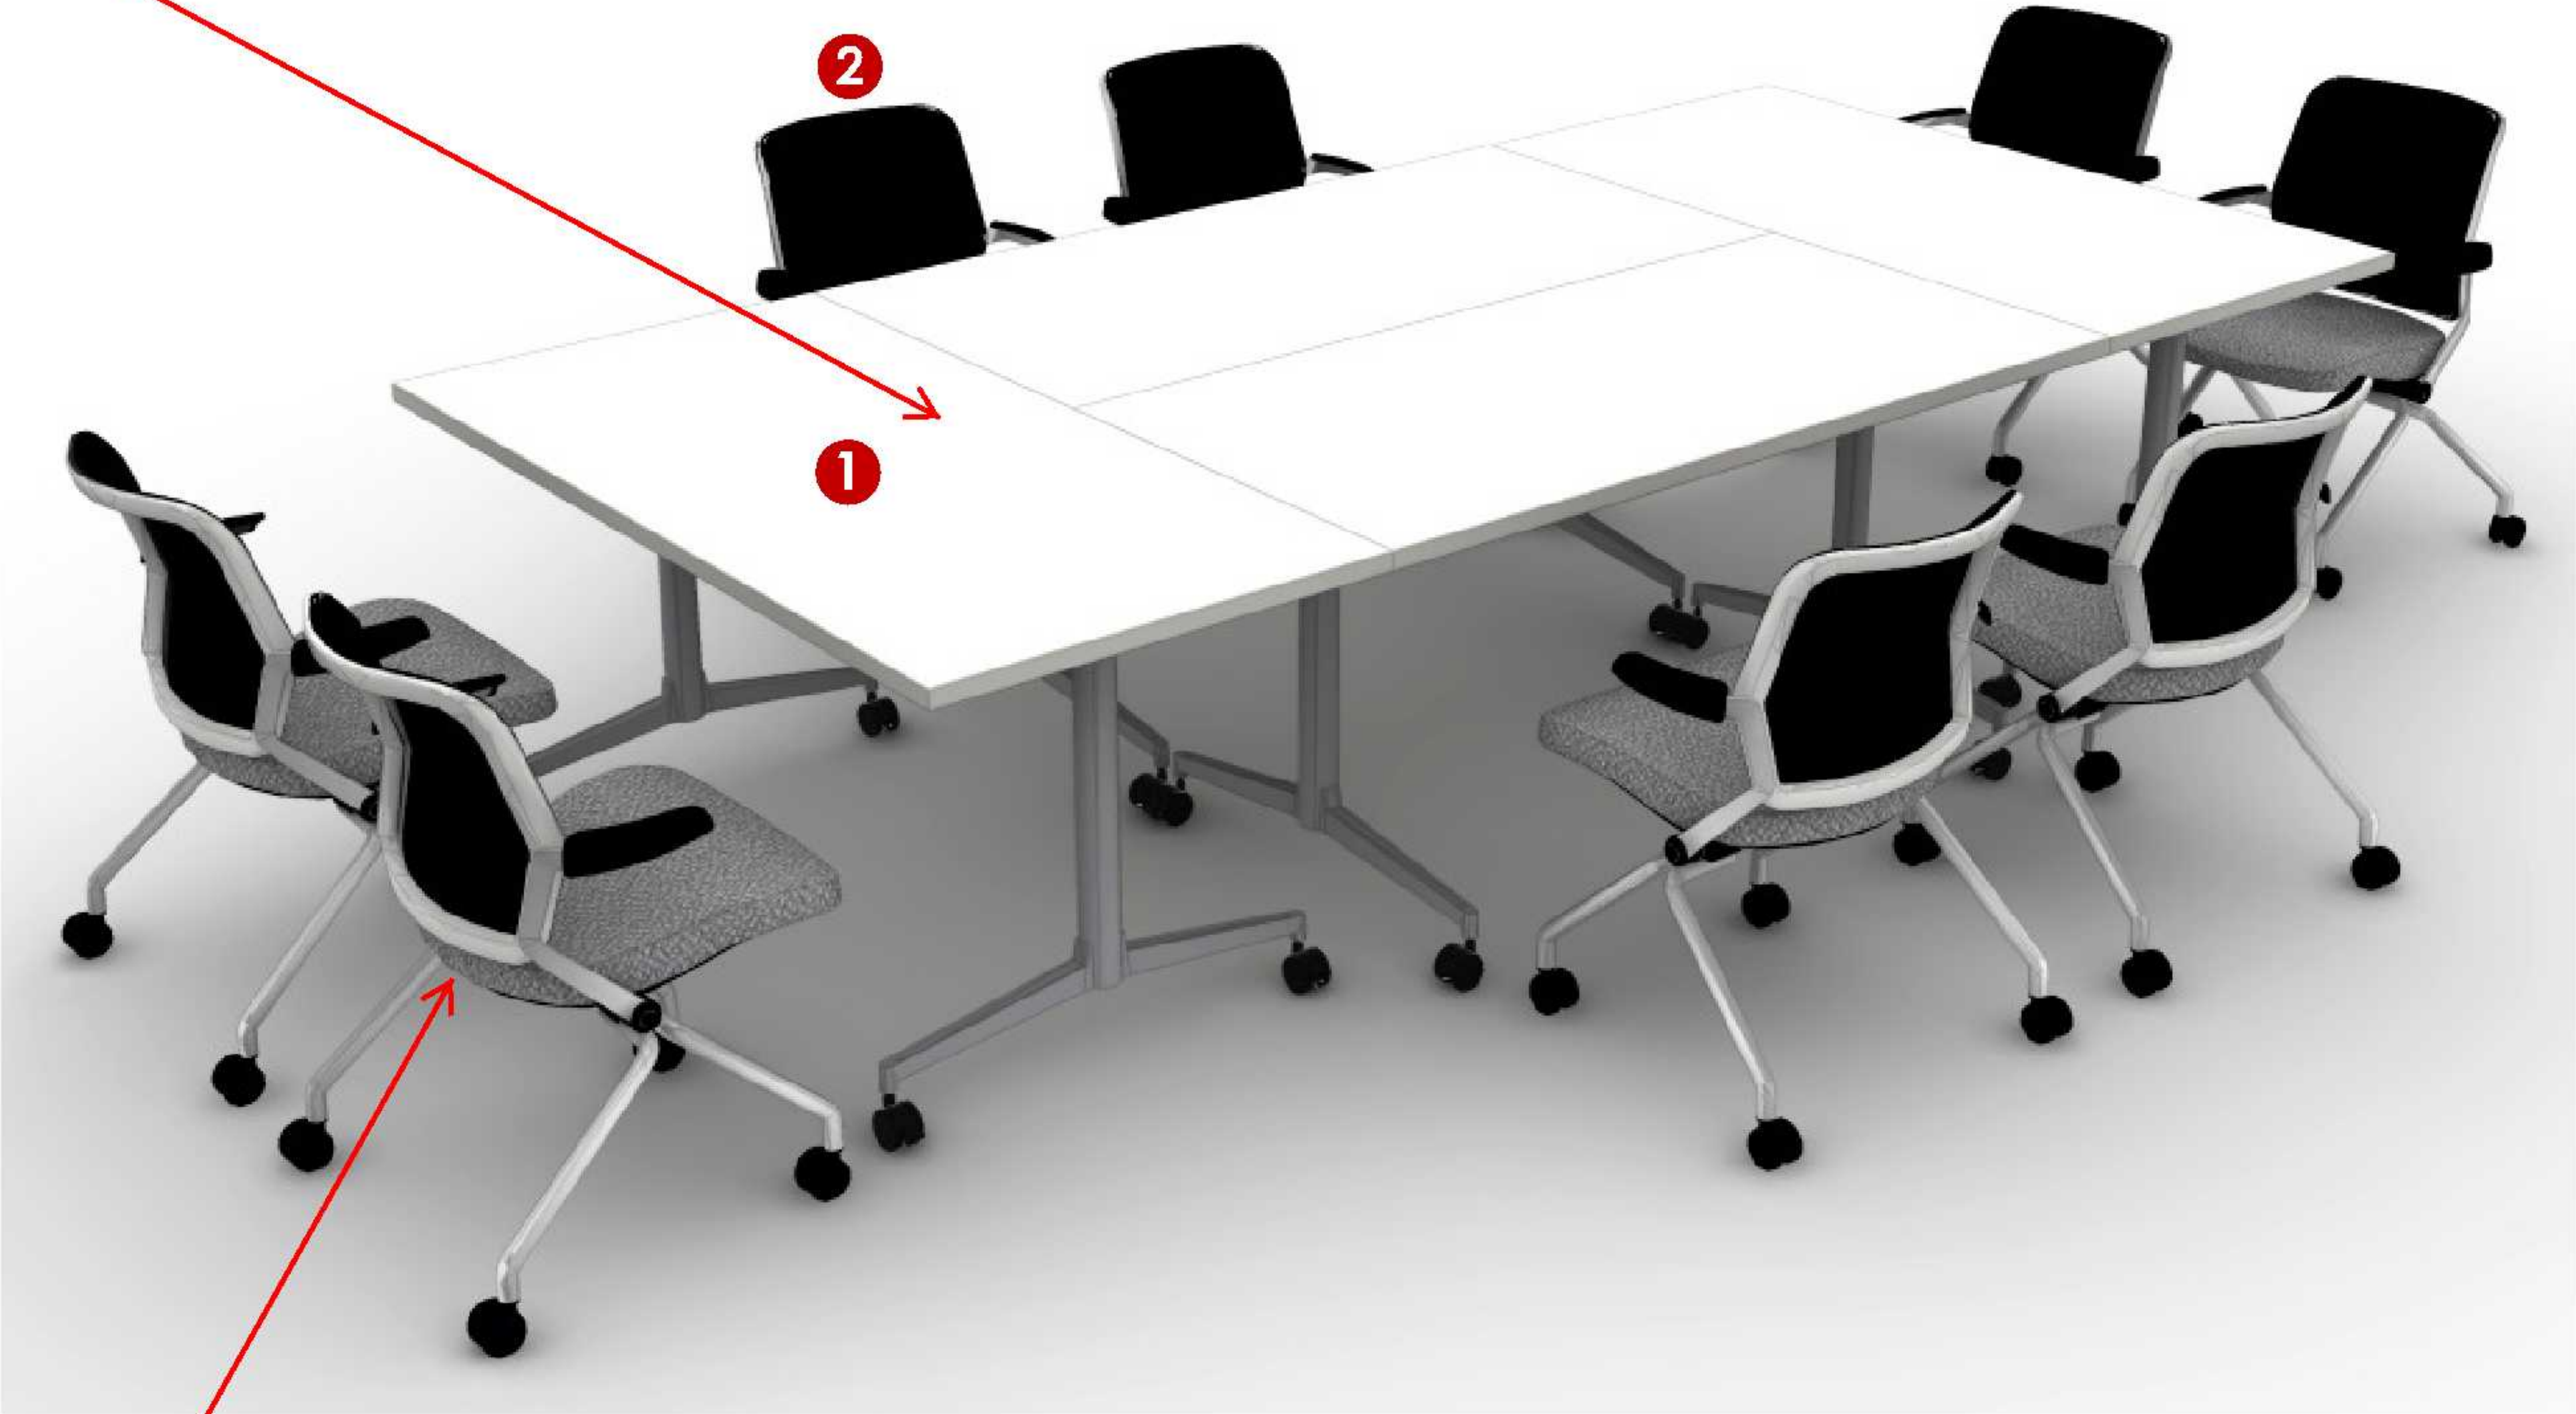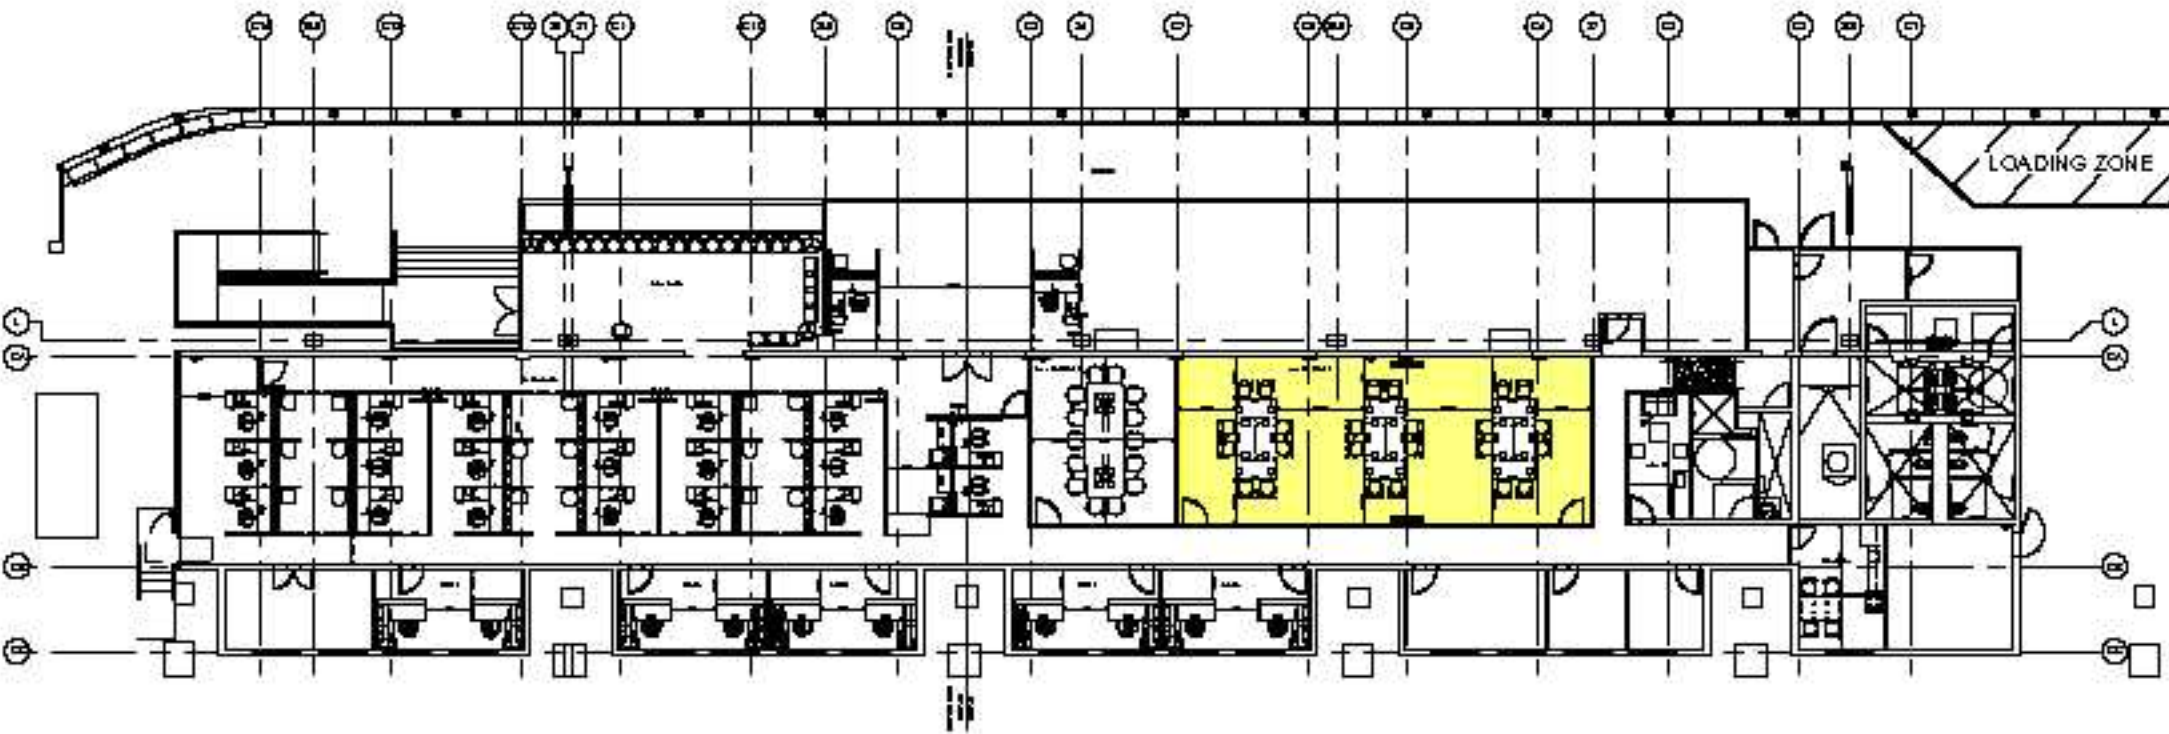

CHAIRS AT MAIN
CONF ROOM TO
BE SEMINAR/
TRAINING TYPE
W/MESH BACK,
FABRIC SEAT
AND ARMS

PROJ NO. CO1322-63
ADDENDUM #2 DATE: 03/10/23

Finishes and renderings shown within may not match exactly,
actual finish samples are available at Systemcenter's
showroom and should be confirmed before ordering.


Rendering - MAIN CONFERENCE

Please provide sofa similar. Sofa shall be full back w/arms on both sides. Support can be metal or wood.


- 1 2-Seat Sofa
- 2 Coffee Table
- 3 Side Table
- 4 Pouf



Prefer sofa with fabric arms. See image on left for reference.

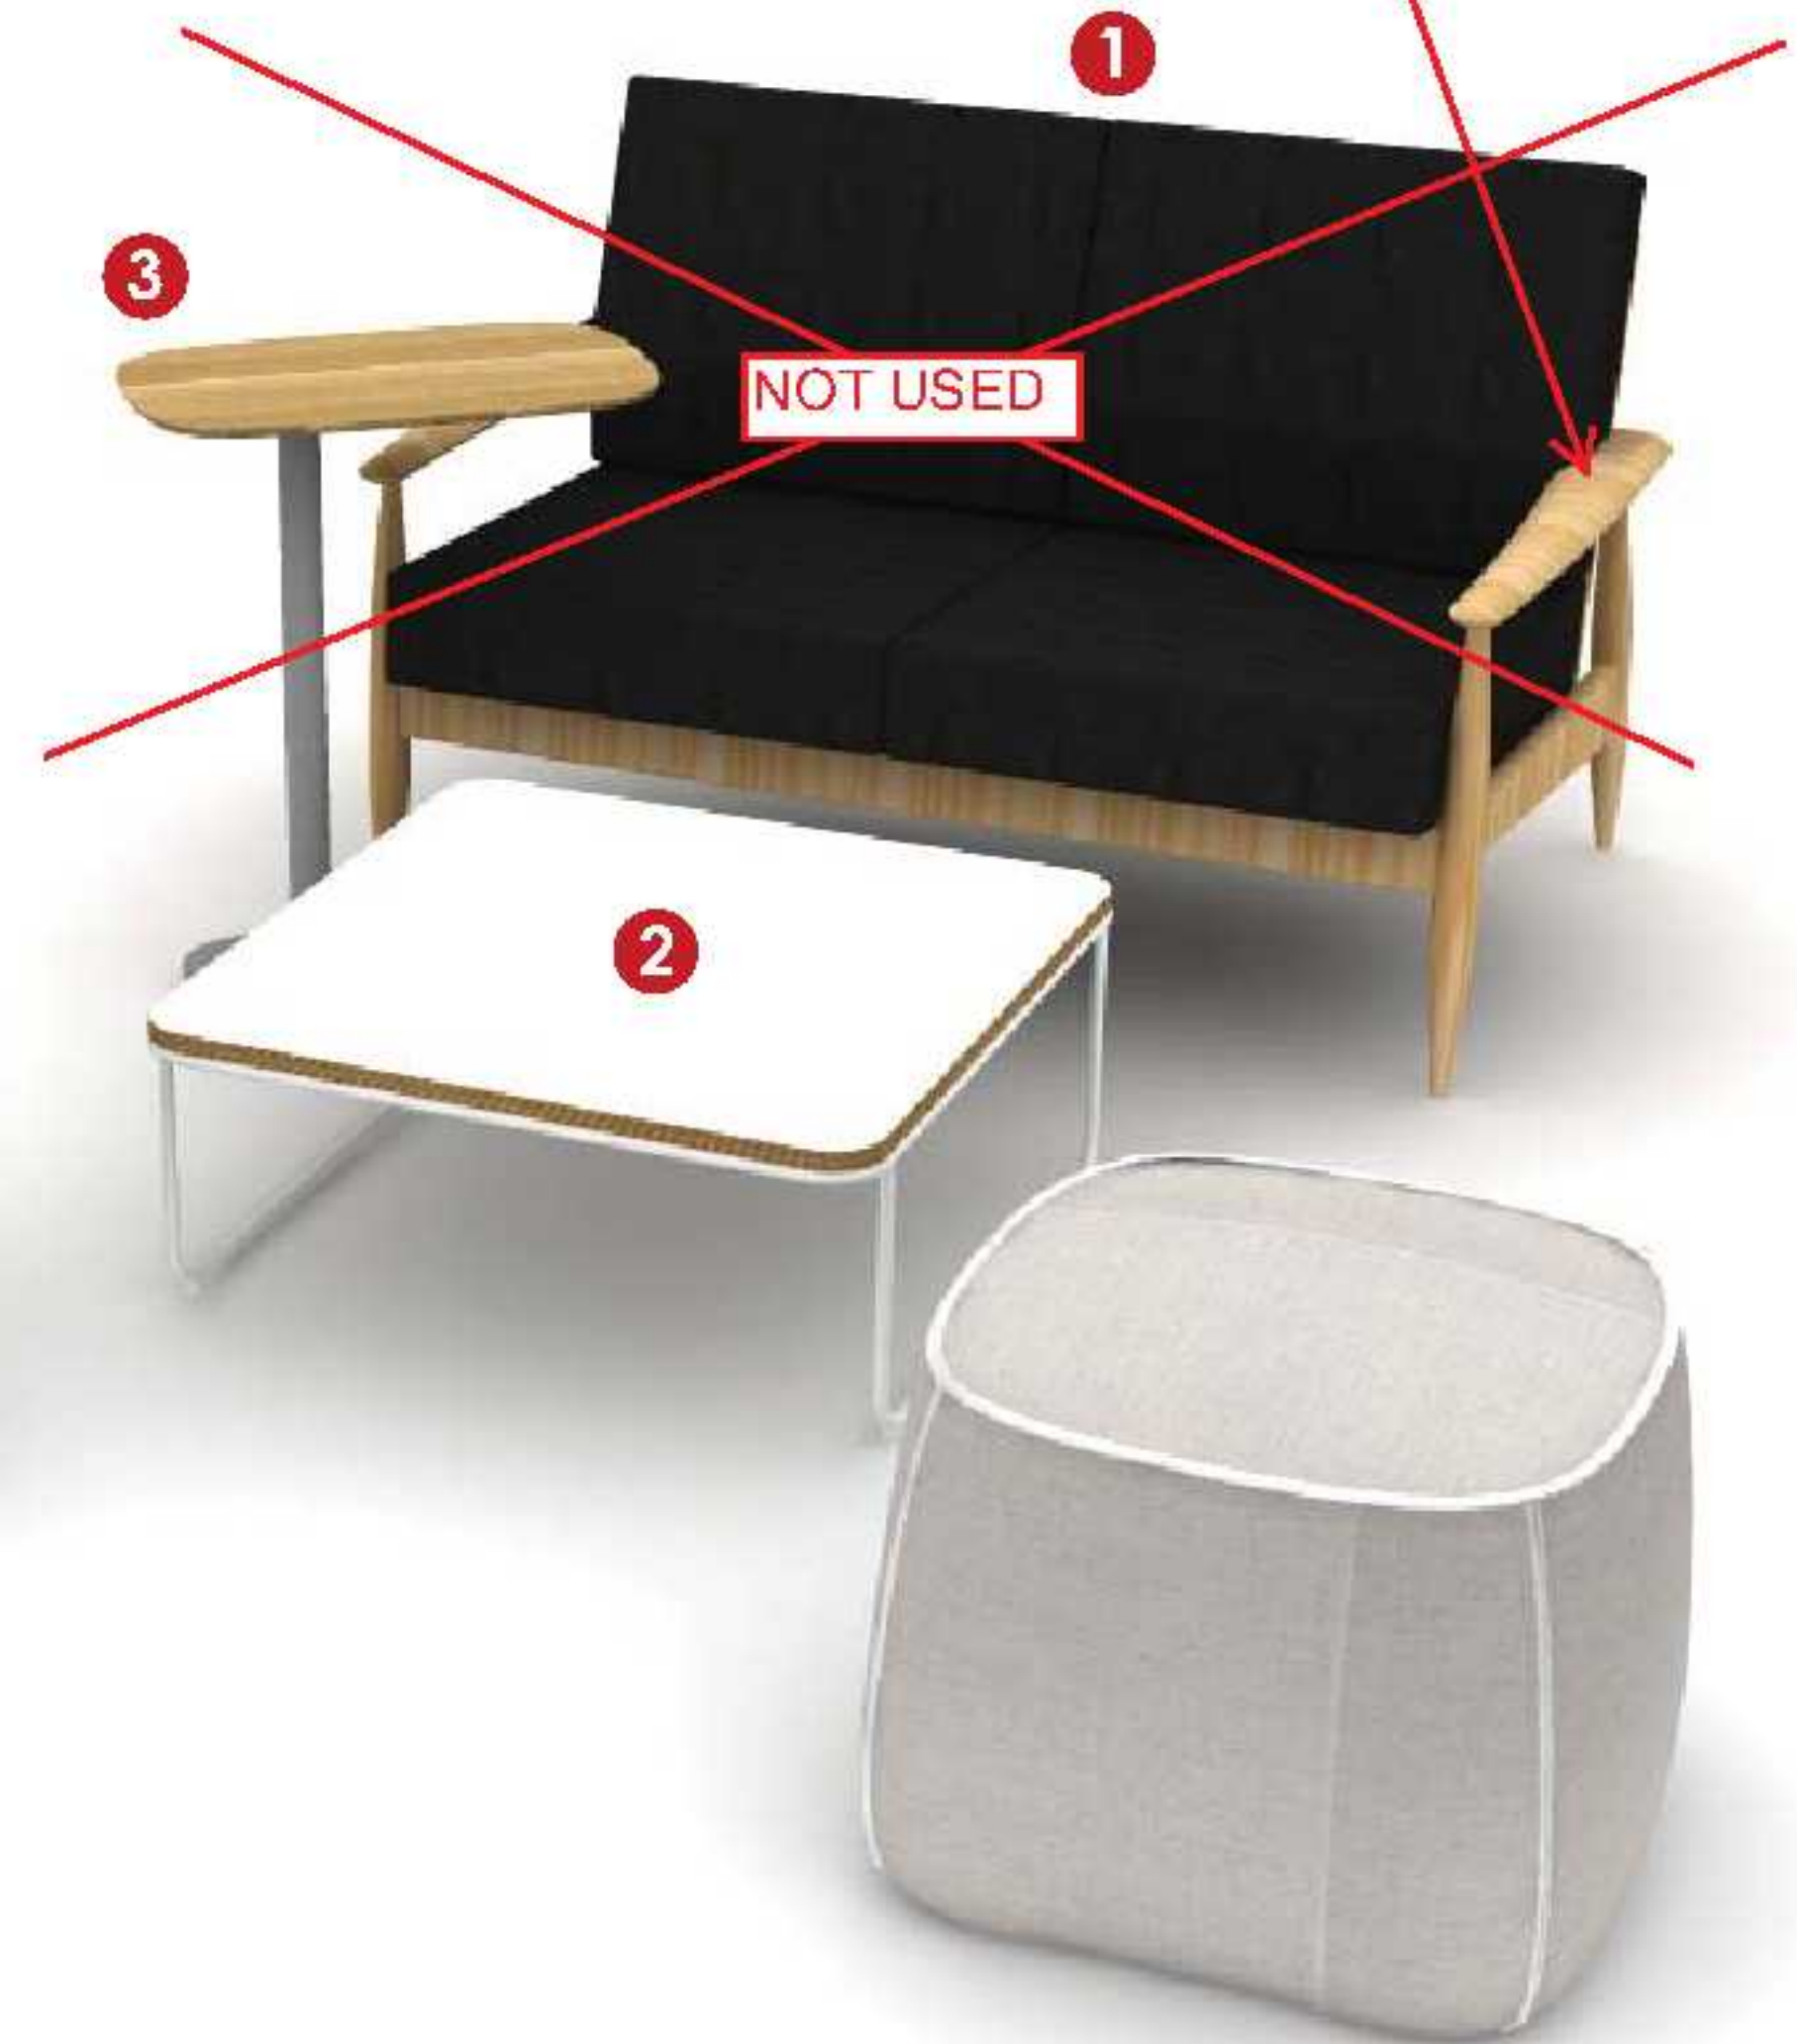

Key Plan

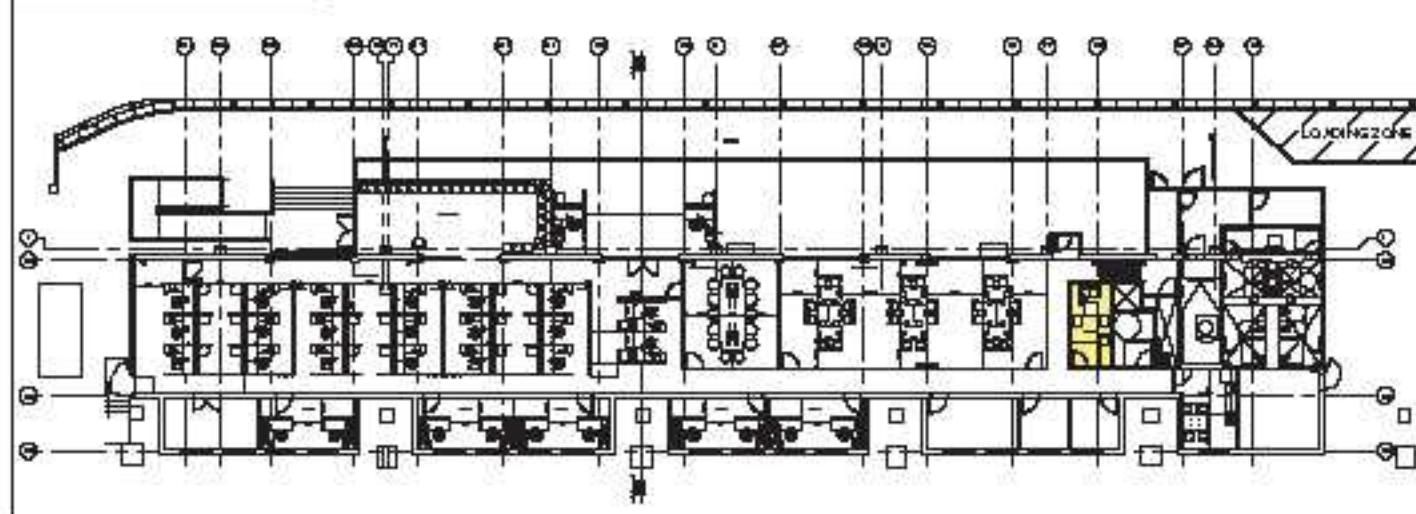

Finishes and renderings shown within may not match exactly, actual finish samples are available at Systemcenter's showroom and should be confirmed before ordering.

Rendering - WELLNESS

23048 - DOTA - HNL PASS/ID OFFICE RENOVATION

23048_0.cmdrw

9/15/2022

Designer: JANET C.

This drawing is the confidential property of The Systemcenter, Inc. and contains information that is not to be used except in consideration of bids or proposals rendered herewith. Reproduction or copying of this drawing, in whole or part is prohibited.

SYSTEMCENTER®
1738 Silva Street - Honolulu, HI 96819 - (808) 847-0911

8/11


PROJ NO. CO1322-63

ADDENDUM #2


DATE: 03/10/23

- 1 Laminate L-Shape Desk
- 2 2.75" Grommet
- 3 Laminate Hutch w/ Tasklight + Fabric Tackboard
- 4 Fixed Laminate BBF
- 5 Task Chair w/ Hard Casters

Key Plan

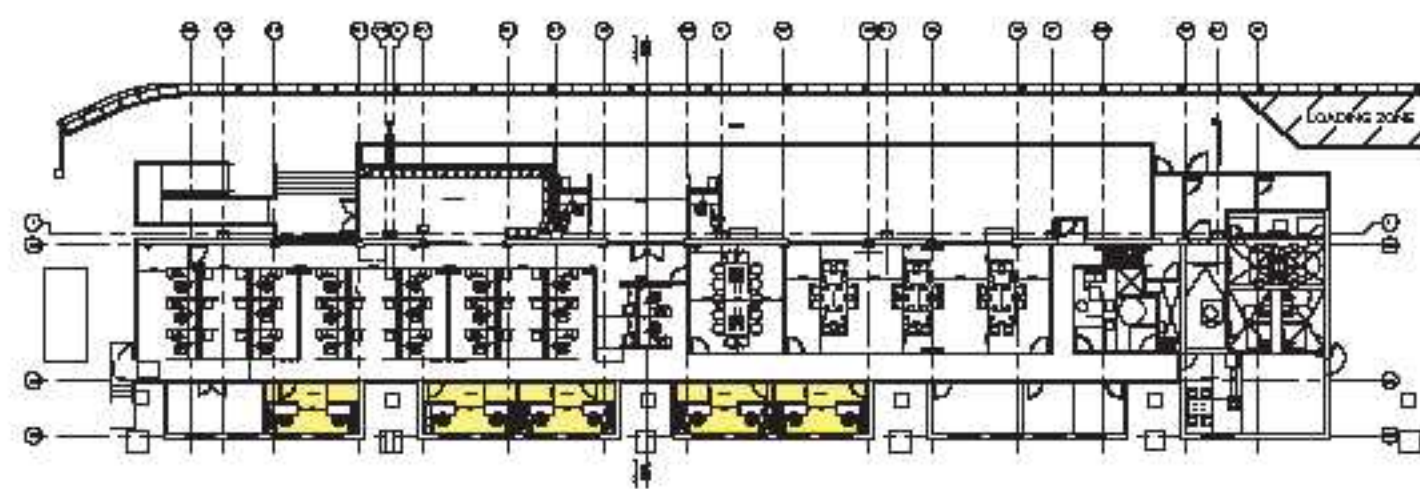

NOT USED

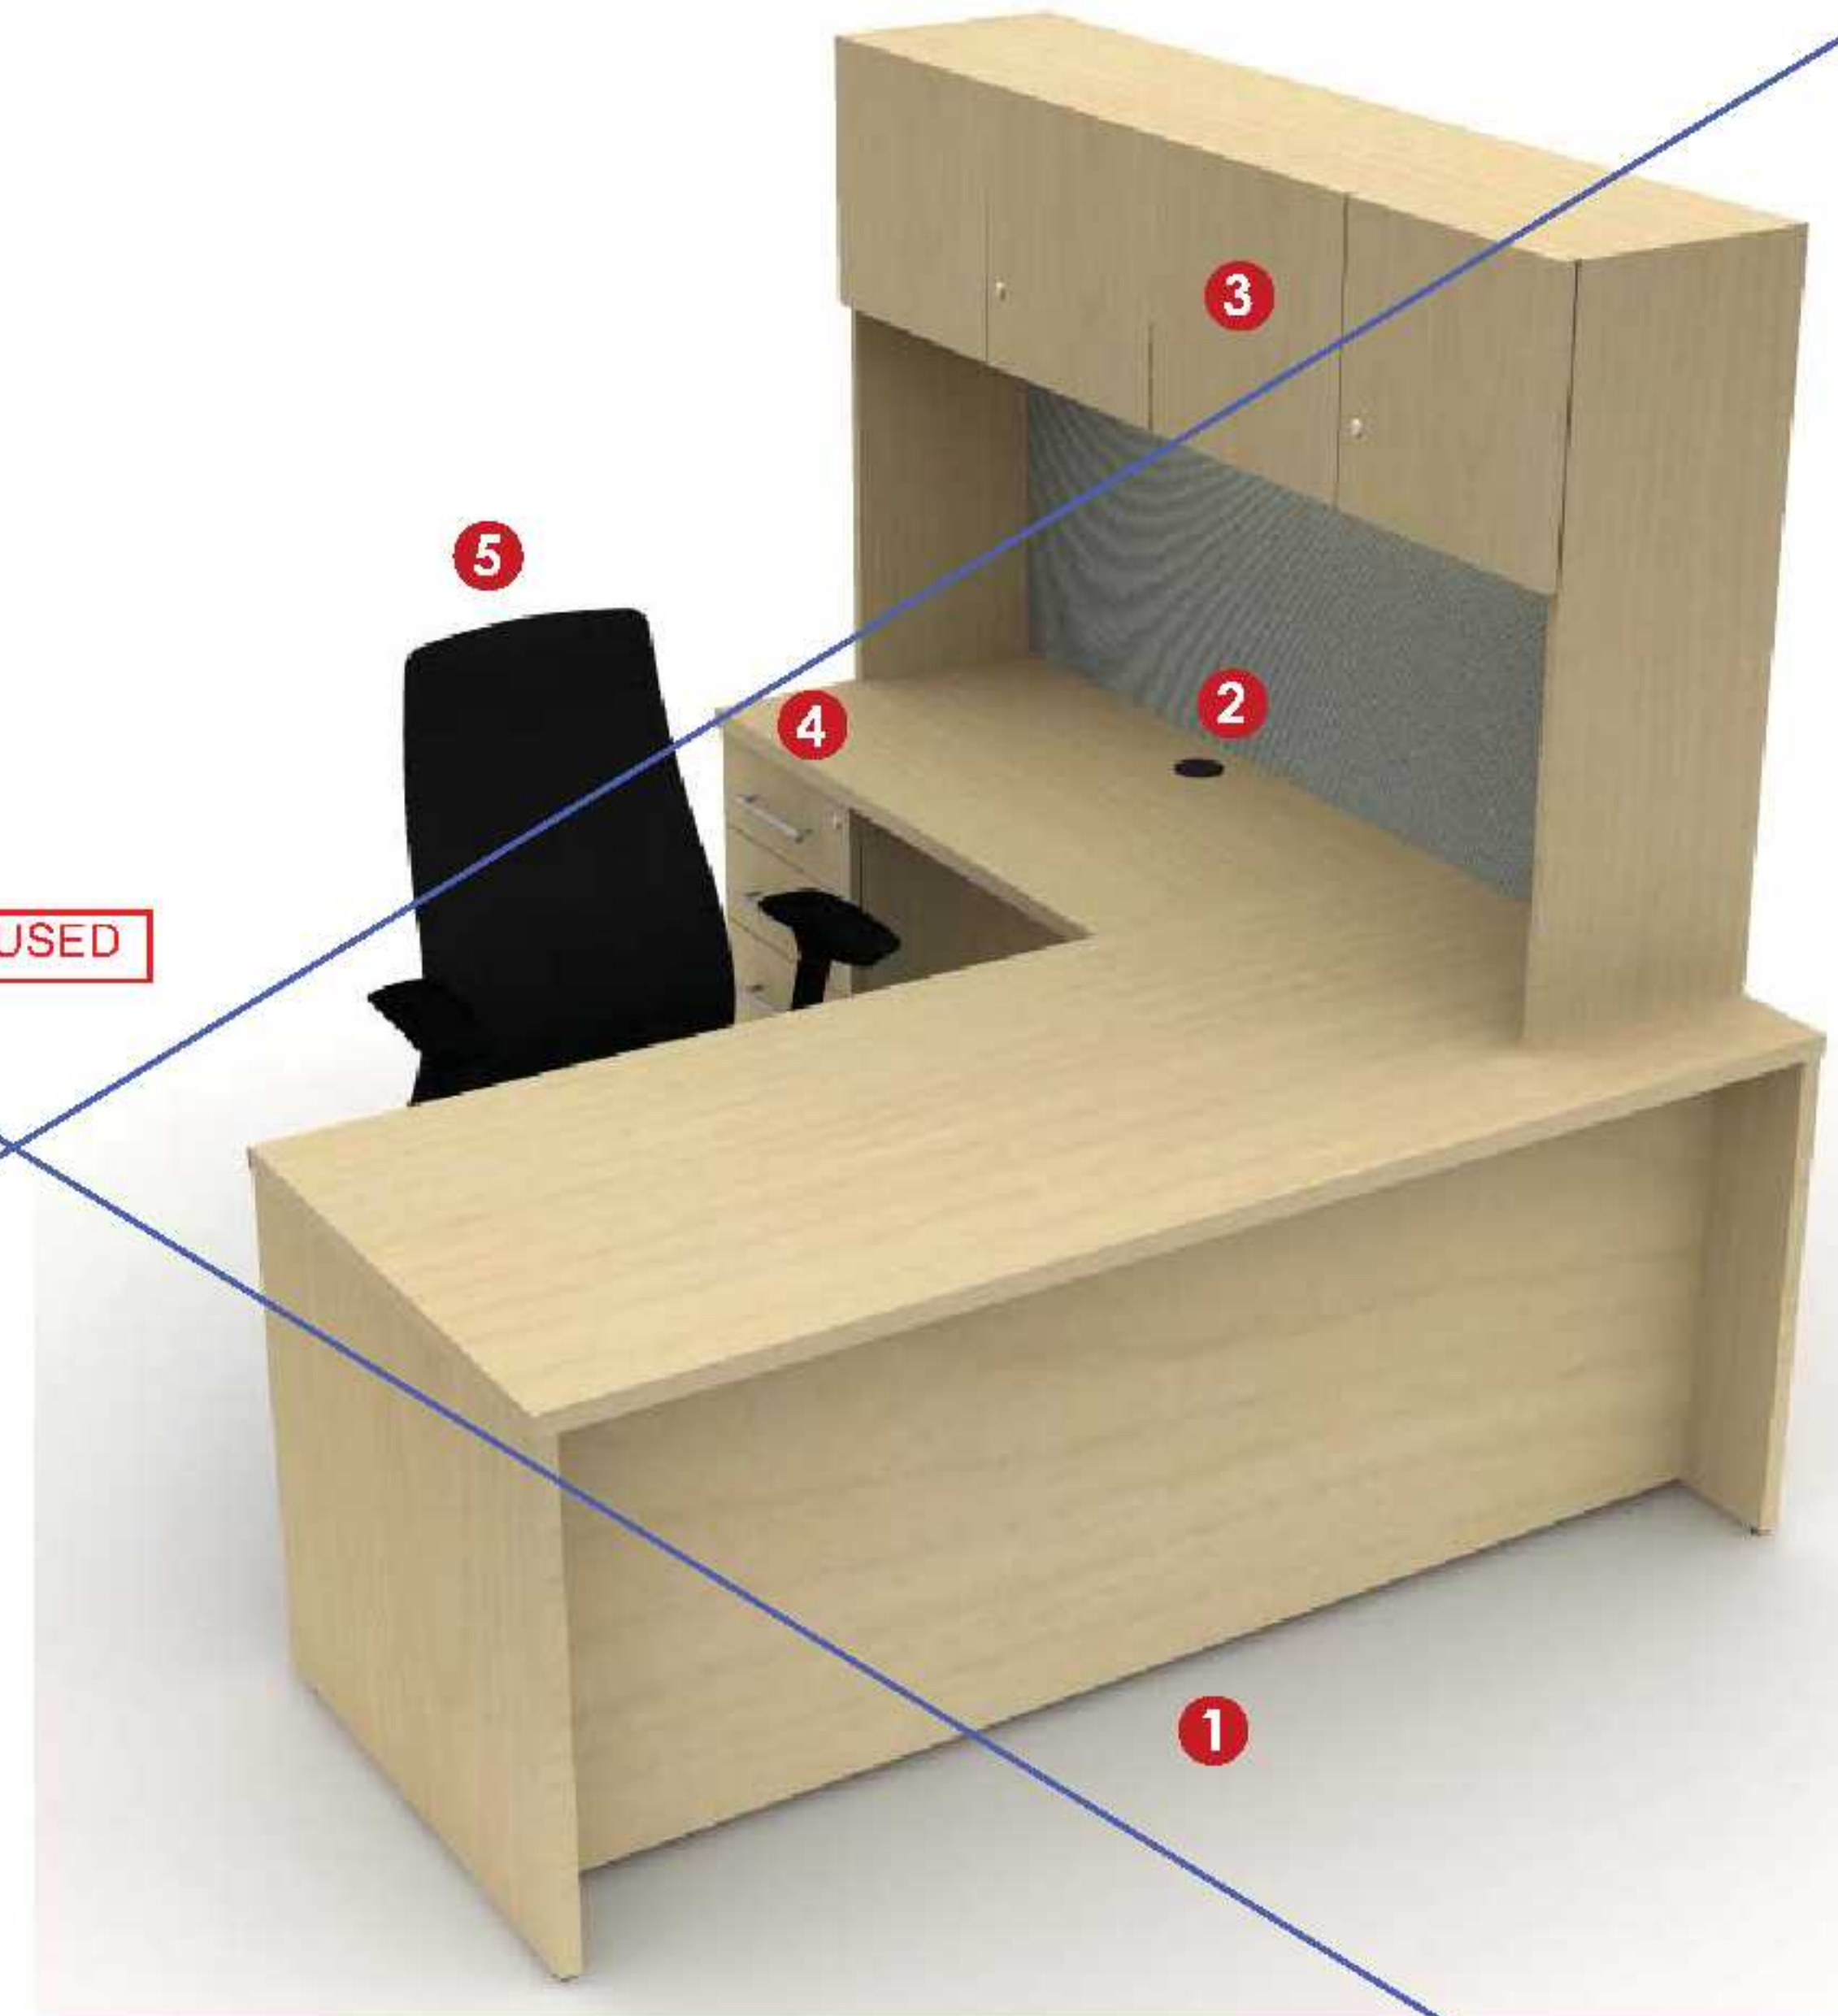

Finishes and renderings shown within may not match exactly, actual finish samples are available at Systemcenter's showroom and should be confirmed before ordering.

Rendering - OFFICES 1-5 TYPICAL (OPTION 1)

23048 - DOTA - HNL PASS/ID OFFICE RENOVATION

23048_0.cmdrw

9/15/2022

Designer: JANET C.

This drawing is the confidential property of The Systemcenter, Inc. and contains information that is not to be used except in consideration of bids or proposals rendered herewith. Reproduction or copying of this drawing, in whole or part is prohibited.

SYSTEMCENTER
1738 Silva Street - Honolulu, HI 96819 - (808) 847-0911

9/15

PROJ NO. CO1322-63

ADDENDUM #2

DATE: 03/10/23

1 Laminate L-Shape Desk

2 2.75" Grommet

3 Wall Mounted Laminate Overhead w/
Tasklight + Wall Mounted Fabric Tackboard


4 Fixed Laminate BBF

5 Task Chair w/ Hard Casters


MAKE WORK SURFACE
HEIGHT ADJUSTABLE &
POWERED, C-LEG
TYPE. POWER TO BE
120V. PLEASE ALSO
EXTEND MAIN WORK
SURFACE TO 80" MIN.

- POWER MODULE TO
BE STANDARD PADDLE TYPE.
- TOTAL LIFT CAPACITY SHALL
BE 250 LBS MIN.
- INTEGRATED POWER MODULE
-

Key Plan

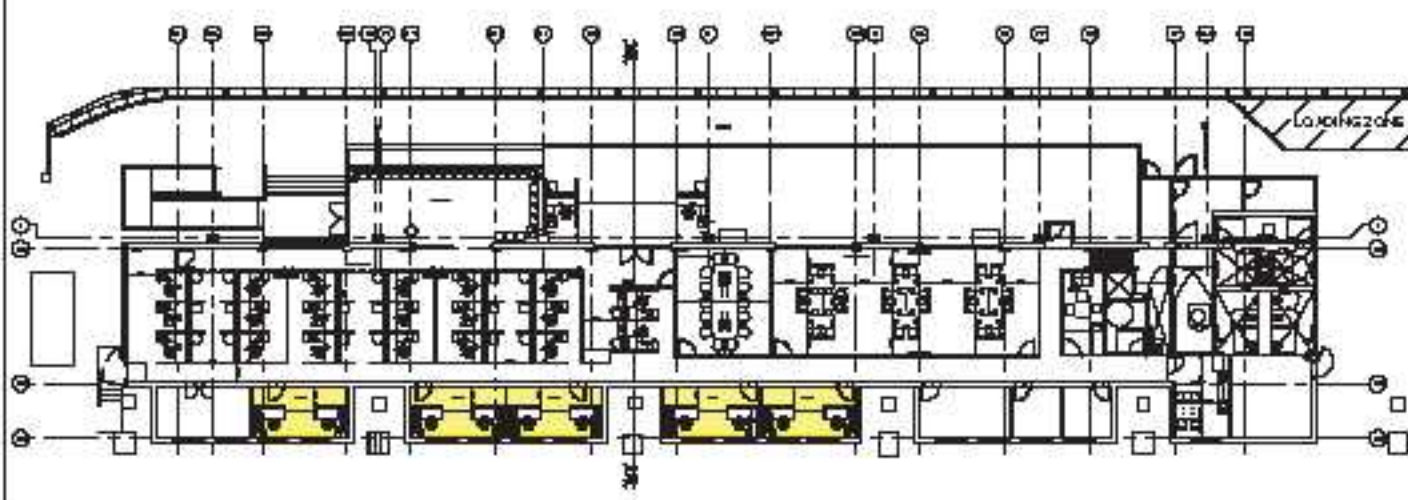

REMOVE HUTCH

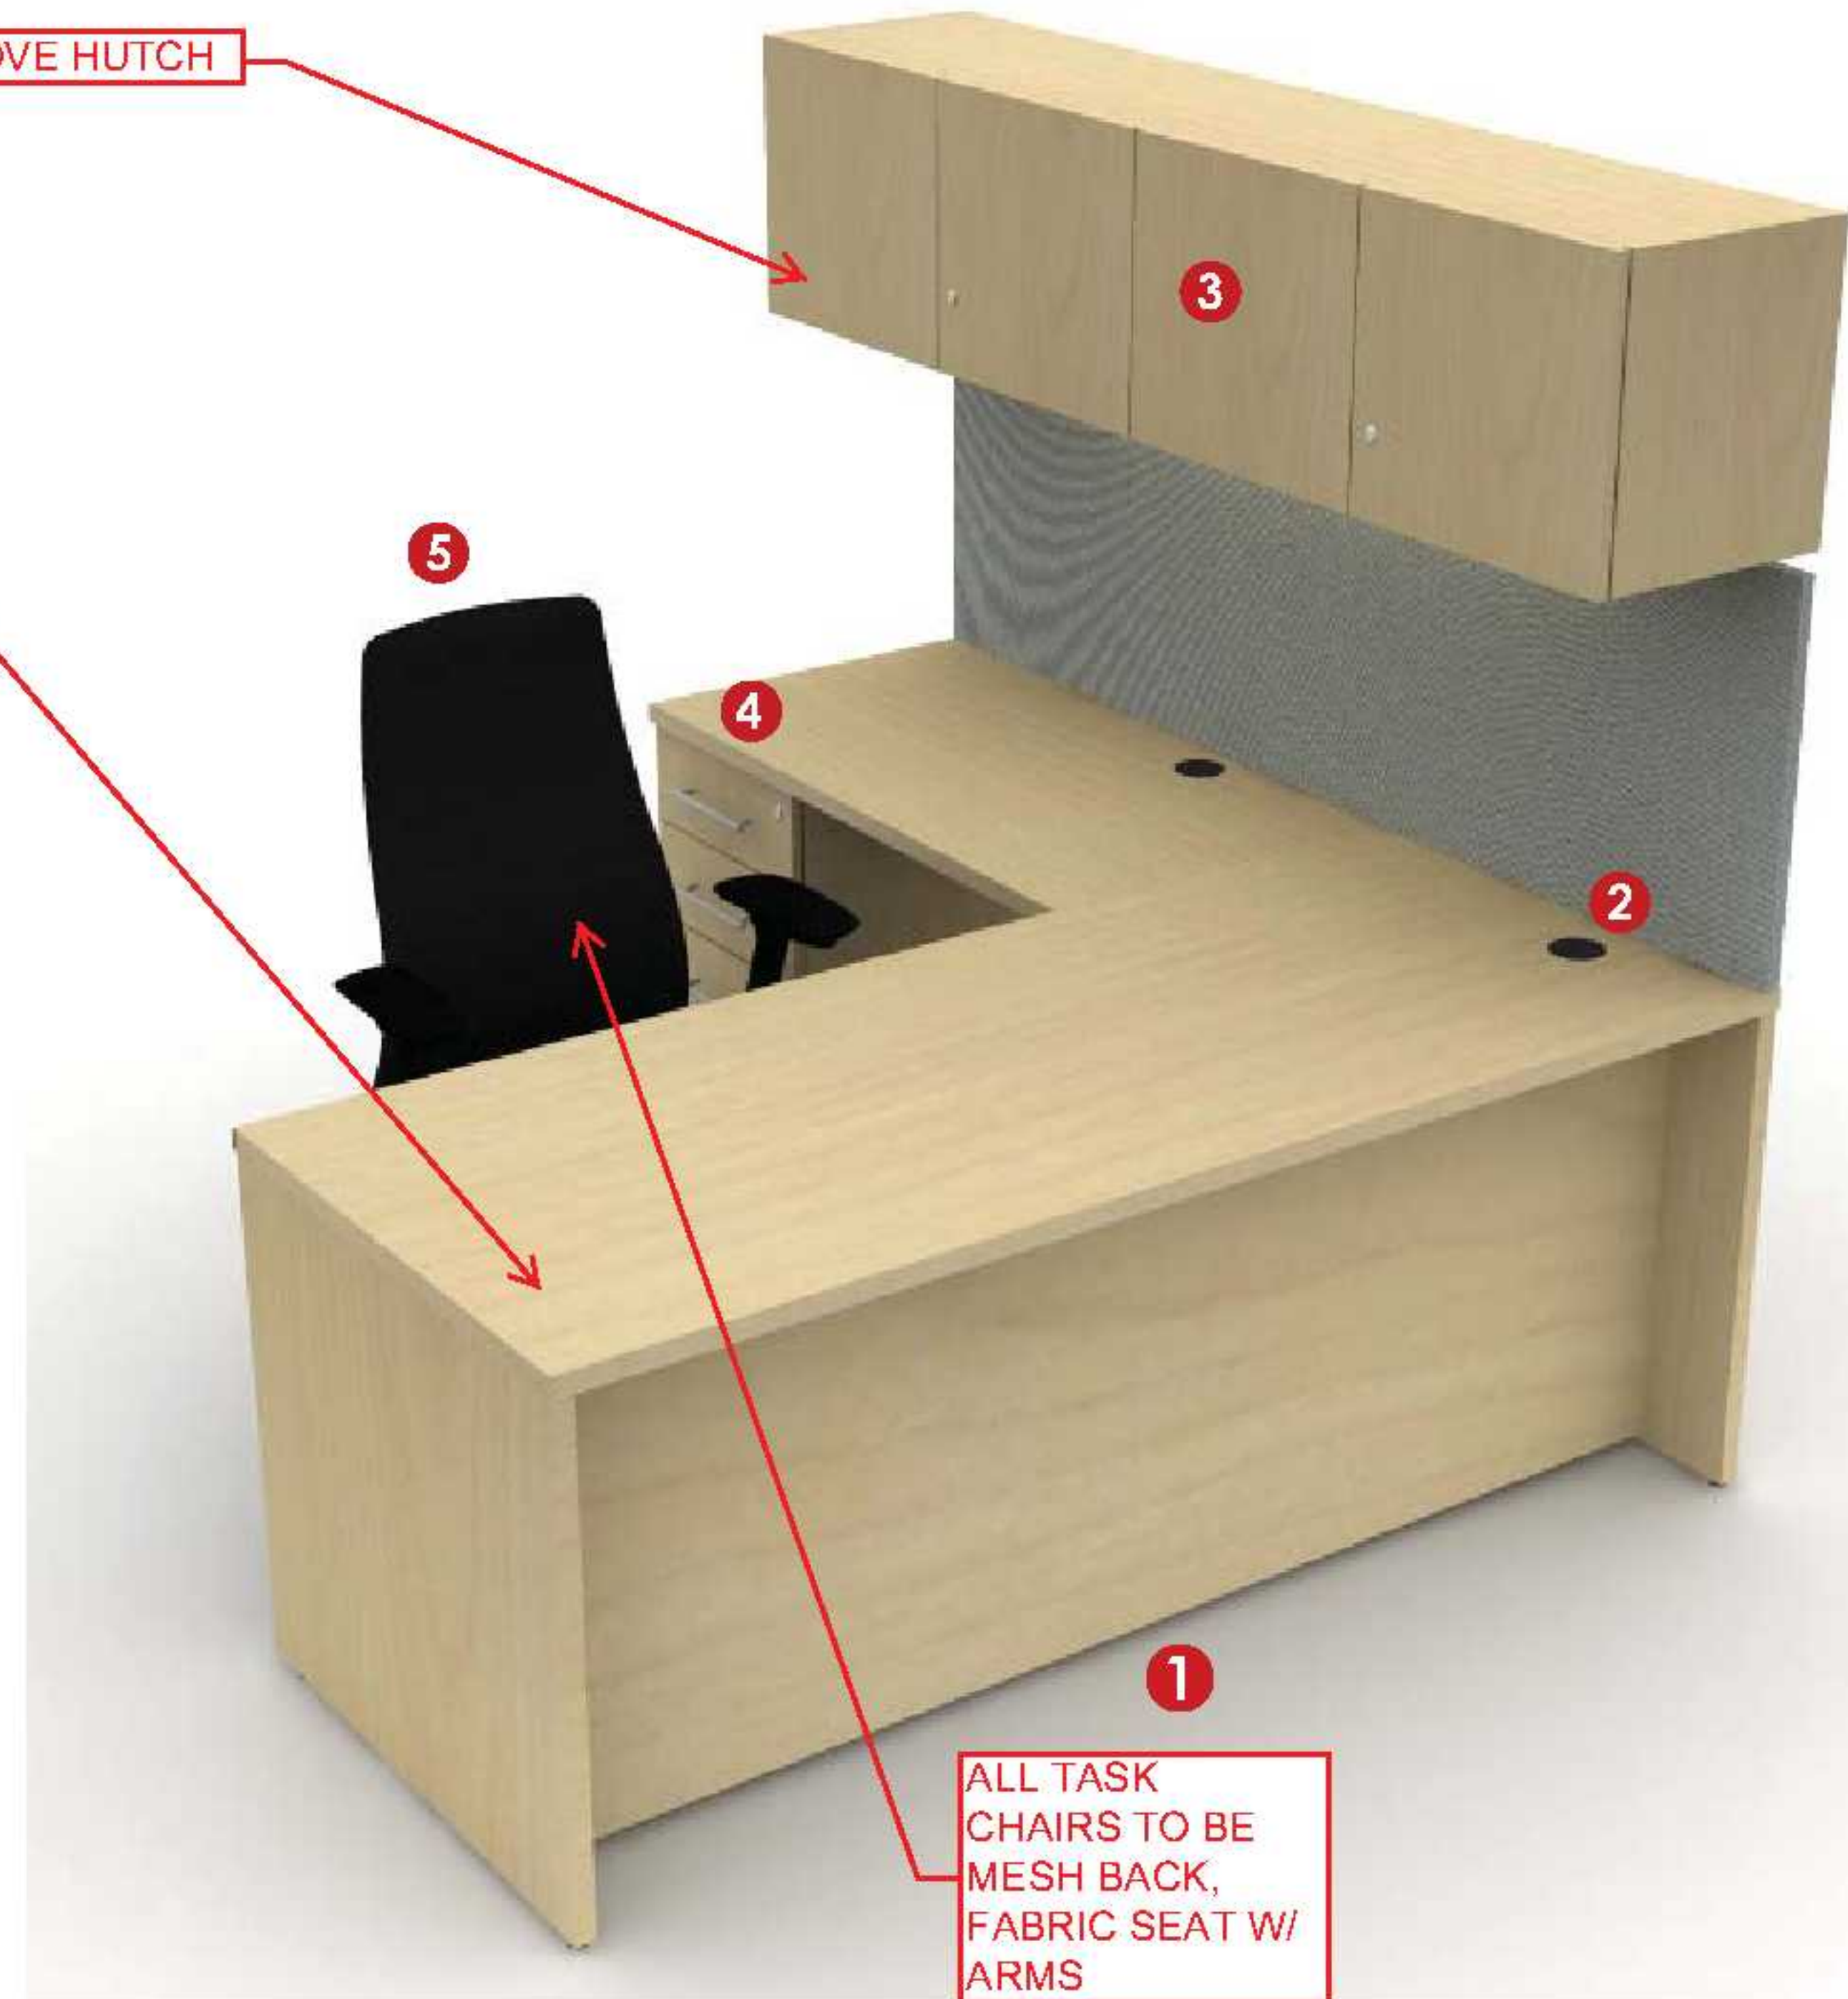

ALL TASK
CHAIRS TO BE
MESH BACK,
FABRIC SEAT W/
ARMS

Finishes and renderings shown within may not match exactly,
actual finish samples are available at Systemcenter's
showroom and should be confirmed before ordering.

Rendering - OFFICES 1-5 TYPICAL (OPTION 2)

23048 - DOTA - HNL PASS/ID OFFICE RENOVATION

23048_0.cmdrw

9/15/2022

Designer: JANET C.

This drawing is the confidential property of
The Systemcenter, Inc. and contains
information that is not to be used except in
consideration of bids or proposals rendered
herein. Reproduction or copying of this
drawing, in whole or part is prohibited.

SYSTEMCENTER
1738 Silva Street - Honolulu, HI 96819 - (808) 847-0911

10/11

PROJ NO. CO1322-63


ADDENDUM #2

DATE: 03/10/23

1 Laminate Table at Counter Height

2 Stools

Key Plan

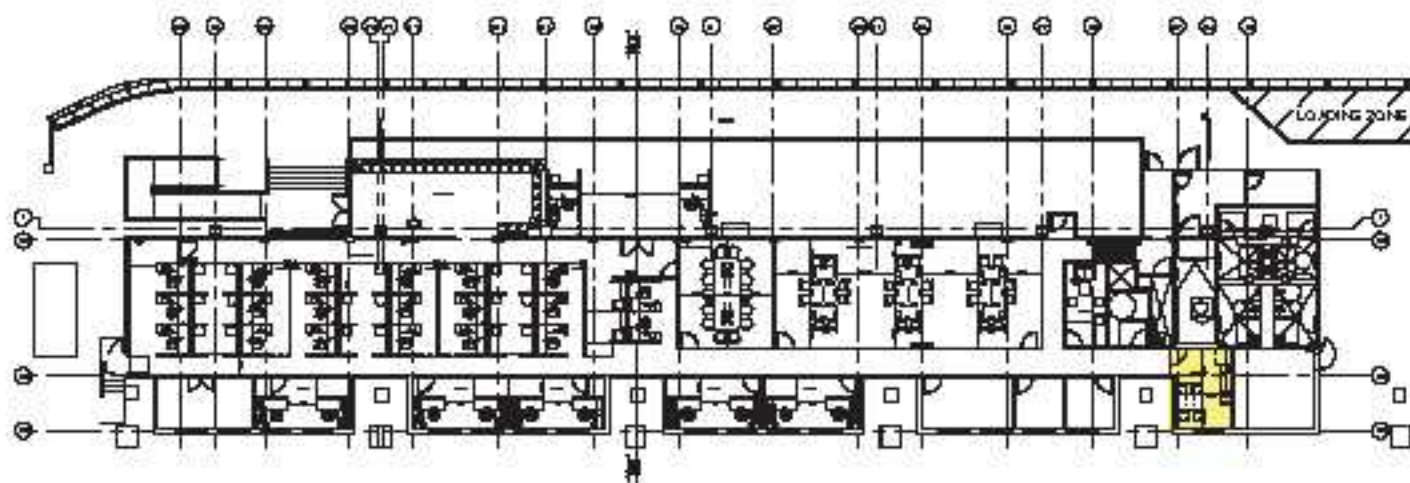

ADDENDUM #2 DATE: 03/10/23

PLEASE PROVIDE
STANDARD HEIGHT
TABLE AND CHAIRS FOR
ADA REQUIREMENTS.
COUNTER HEIGHT TO BE
36" MAX. PLEASE ALSO
PROVIDE NESTING TYPE.



Finishes and renderings shown within may not match exactly,
actual finish samples are available at Systemcenter's
showroom and should be confirmed before ordering.

Rendering - BREAKROOM

23048 - DOTA - HNL PASS/ID OFFICE RENOVATION

23048_0.cmdrw

9/15/2022

Designer: JANET C.

This drawing is the confidential property of
The Systemcenter, Inc. and contains
information that is not to be used except in
consideration of bids or proposals rendered
herewith. Reproduction or copying of this
drawing, in whole or part is prohibited.

SYSTEMCENTER®
1738 Silva Street - Honolulu, HI 96819 - (808) 847-0911

11/11

PROJ NO. CO1322-63

ADDENDUM #2

DATE: 03/10/23