

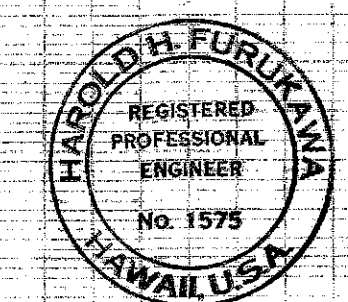


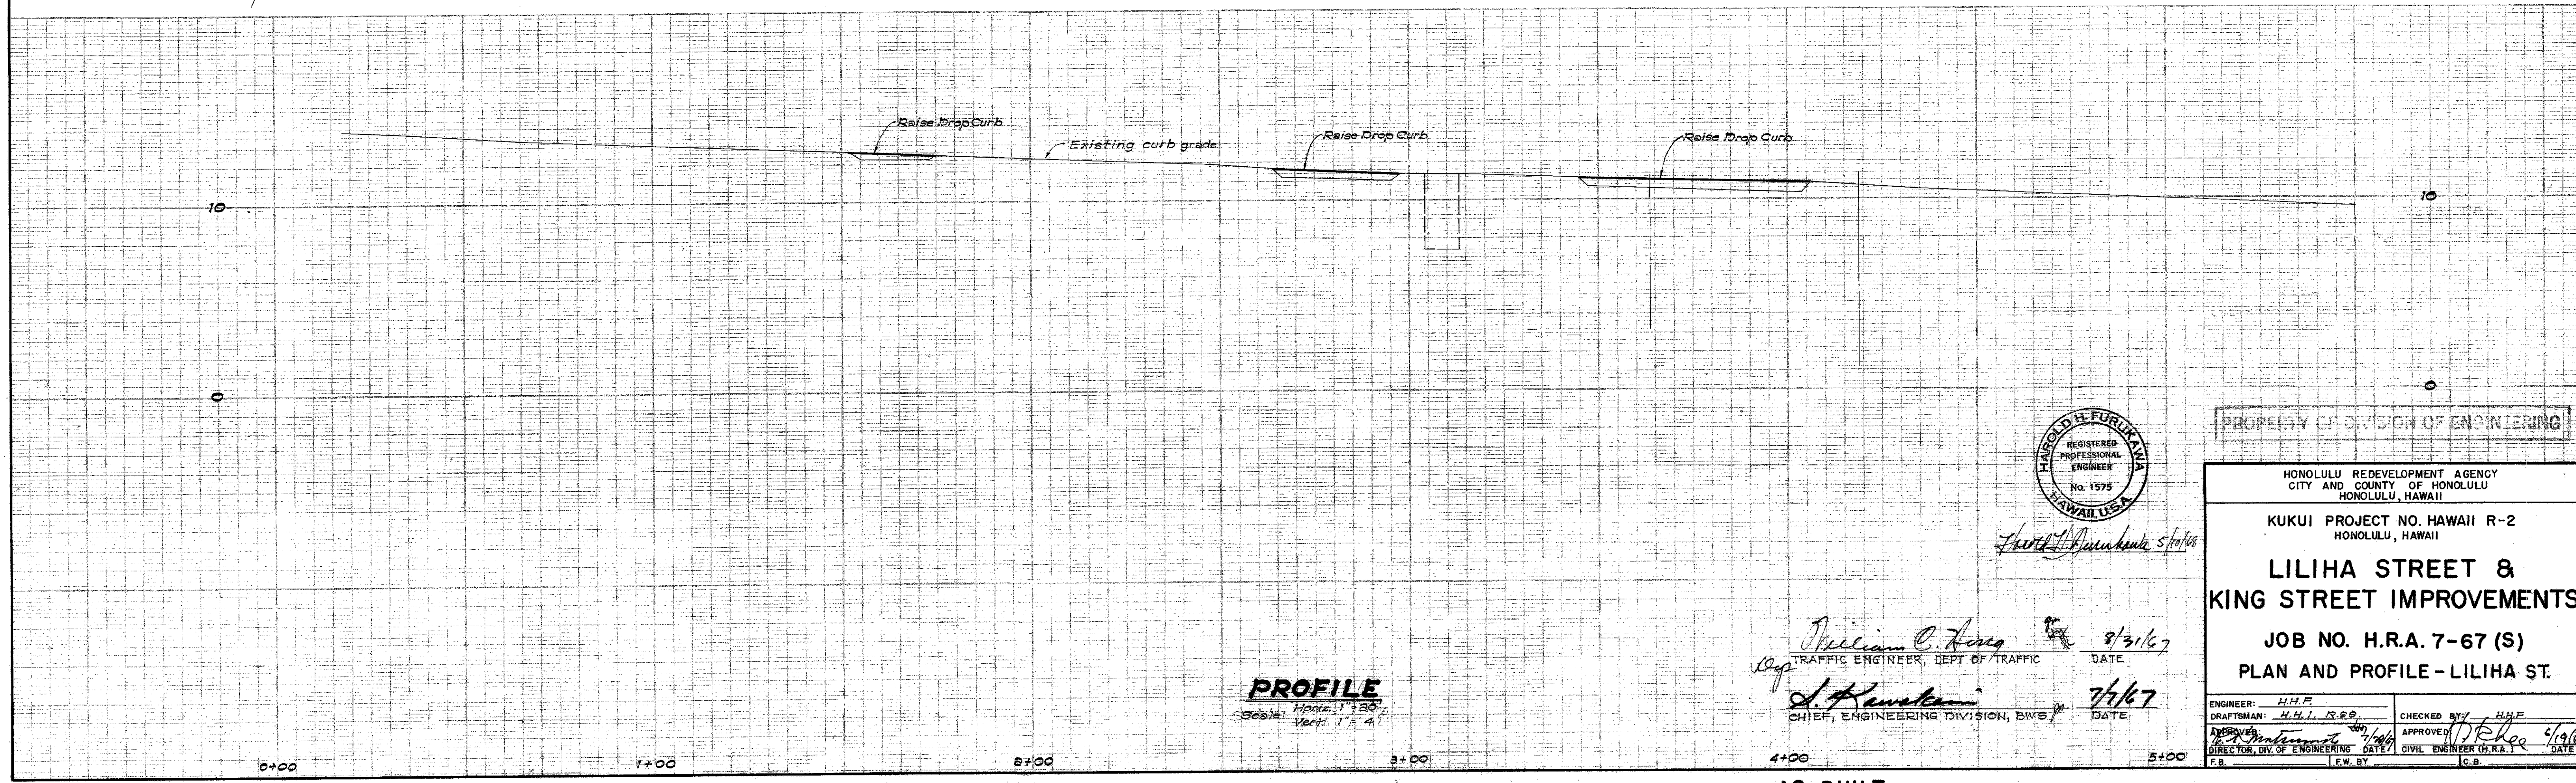


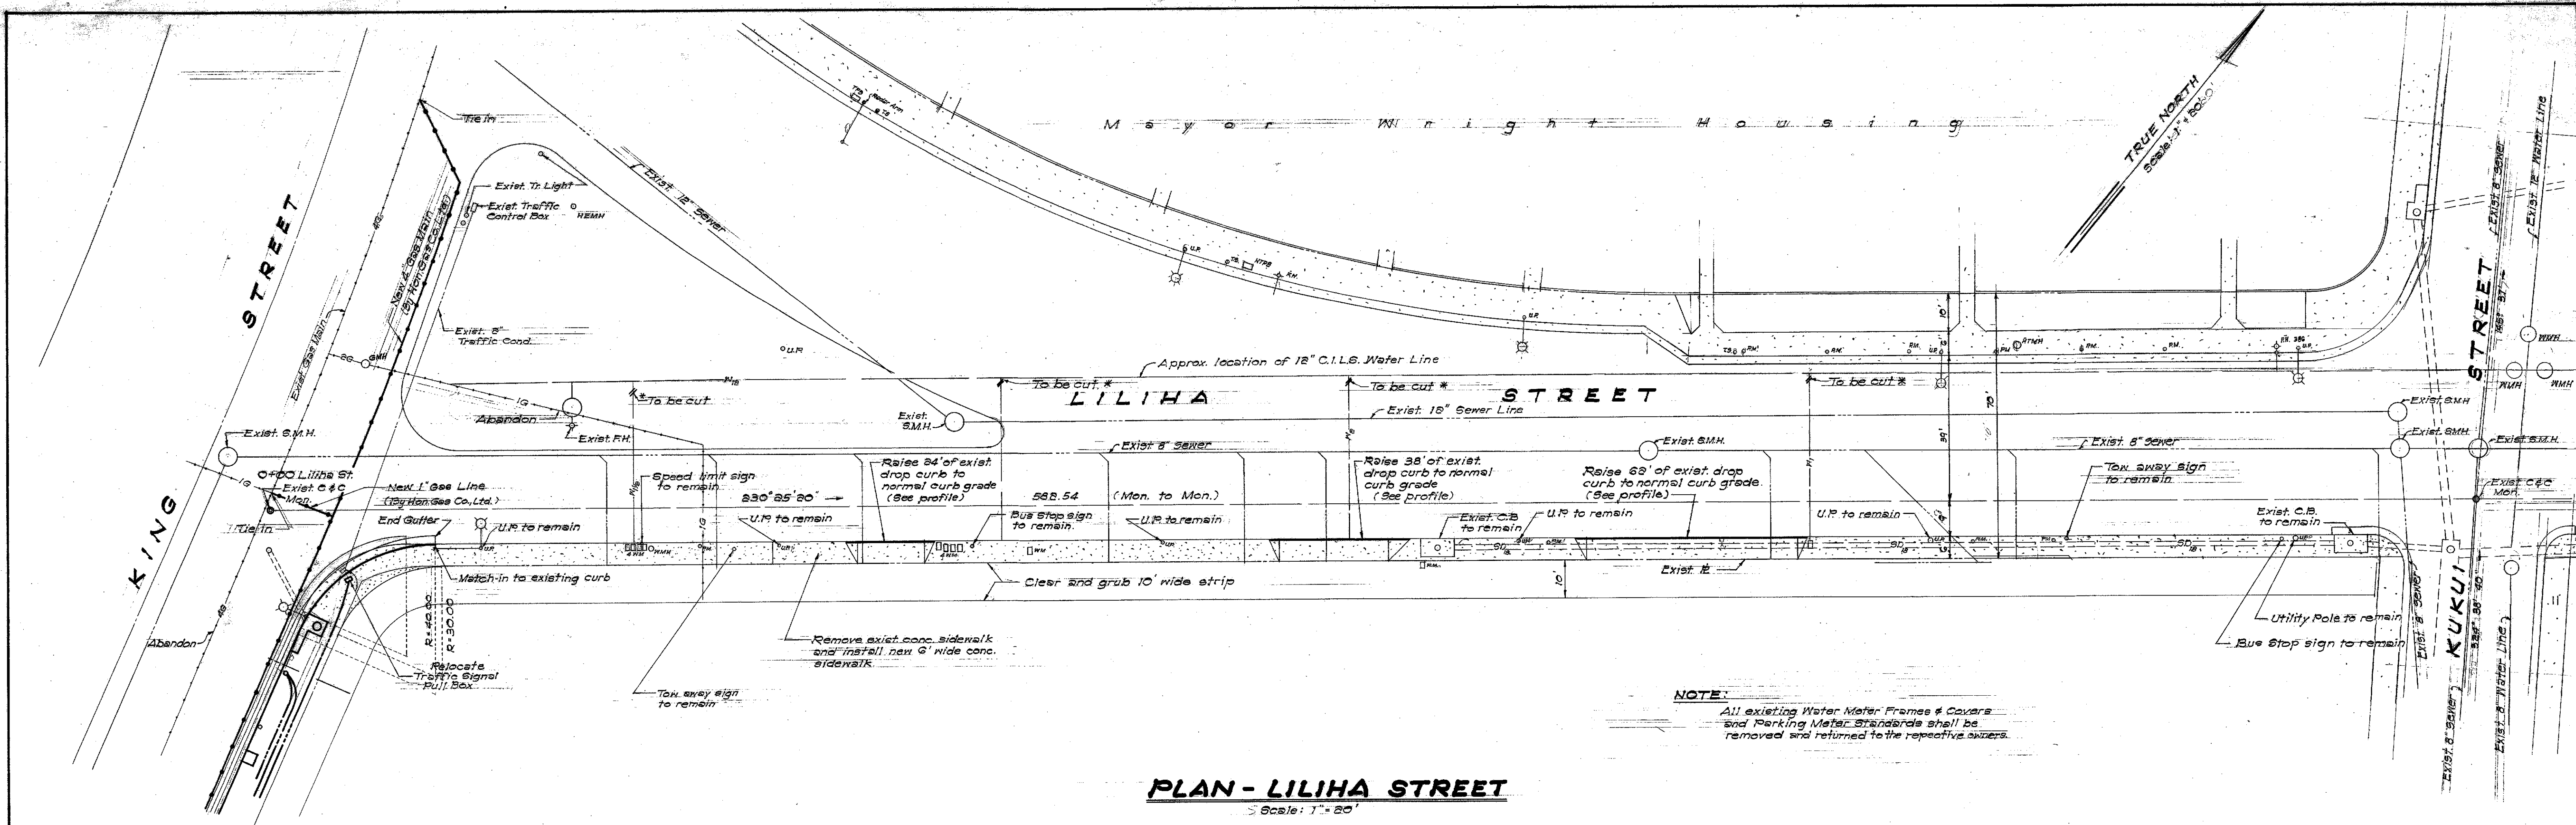

*William C. King* 8/31/67  
TRAFFIC ENGINEER, DEPT. OF TRAFFIC DATE


*A. Kawakami* 7/6/67  
CHIEF, ENGINEERING DIVISION, BWS DATE

|                                                                                                                           |                                                                                           |
|---------------------------------------------------------------------------------------------------------------------------|-------------------------------------------------------------------------------------------|
| HONOLULU REDEVELOPMENT AGENCY<br>CITY AND COUNTY OF HONOLULU<br>HONOLULU, HAWAII                                          |                                                                                           |
| KUKUI PROJECT NO. HAWAII R-2<br>HONOLULU, HAWAII                                                                          |                                                                                           |
| <b>LILIHA STREET &amp; KING STREET IMPROVEMENTS</b>                                                                       |                                                                                           |
| JOB NO. H.R.A. 7-67 (S)<br>PLAN AND PROFILE - LILIHA ST.                                                                  |                                                                                           |
| ENGINEER: H.H.F.<br>DRAFTSMAN: H.H.I. R.E.S.<br>APPROVED: <i>[Signature]</i> 4/1/68<br>DIRECTOR, DIV. OF ENGINEERING DATE | CHECKED BY: H.H.F.<br>APPROVED: <i>[Signature]</i> 4/1/68<br>CIVIL ENGINEER (H.R.A.) DATE |

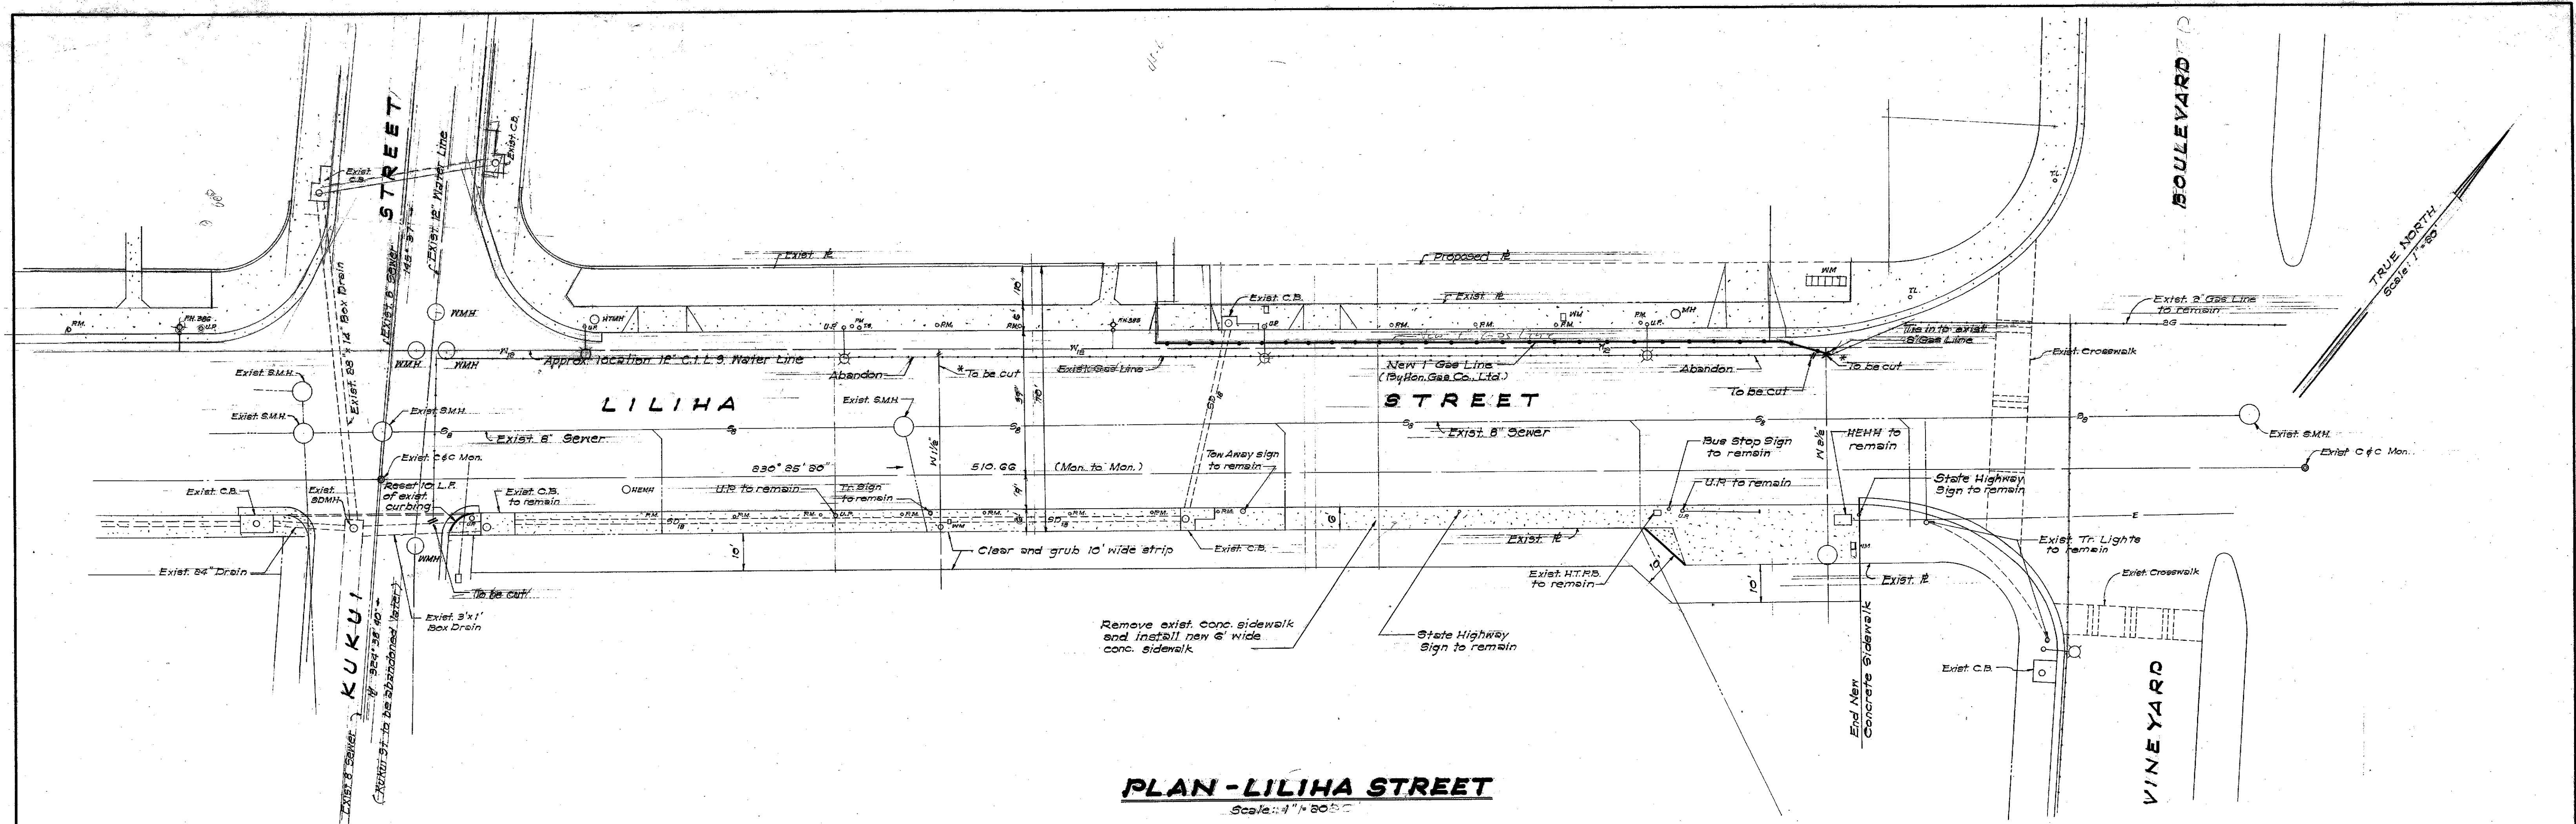

**PLAN - LILIHA STREET**


Scale: 4" = 80' 0"

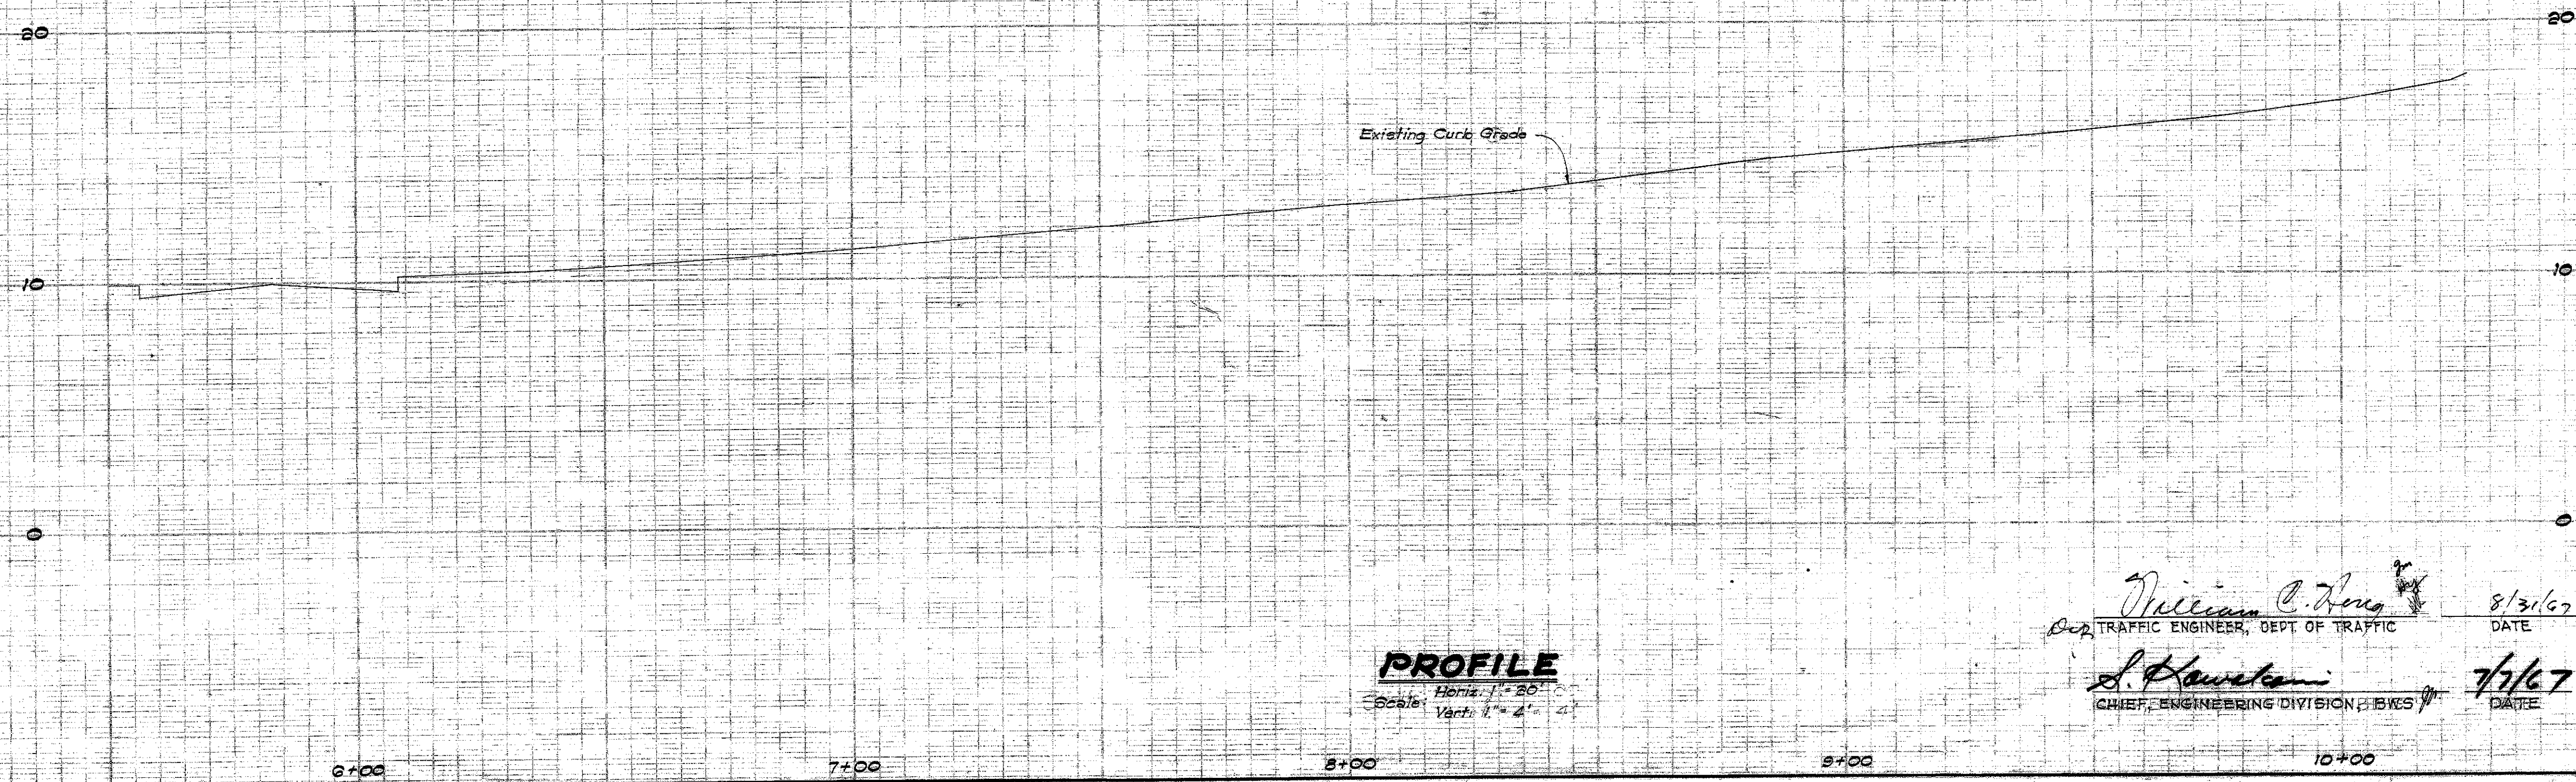

**PROFILE**

Scale: Horiz. 1" = 20'  
Vert. 1" = 4'

PROPERTY OF DIVISION OF ENGINEERING

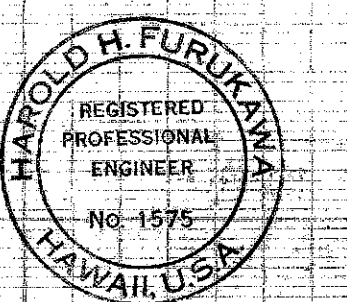

*Harold A. Furukawa 5/10/68*

|                                                                                                                      |                                                                                                                       |
|----------------------------------------------------------------------------------------------------------------------|-----------------------------------------------------------------------------------------------------------------------|
| HONOLULU REDEVELOPMENT AGENCY<br>CITY AND COUNTY OF HONOLULU<br>HONOLULU, HAWAII                                     |                                                                                                                       |
| KUKUI PROJECT NO. HAWAII R-2<br>HONOLULU, HAWAII                                                                     |                                                                                                                       |
| <b>LILIHA STREET &amp;<br/>KING STREET IMPROVEMENTS</b>                                                              |                                                                                                                       |
| JOB NO. H.R.A. 7-67 (S)<br>PLAN AND PROFILE - LILIHA ST.                                                             |                                                                                                                       |
| ENGINEER: H.H.F.<br>DRAFTSMAN: H.H.F. R.S.B.<br>APPROVED: <i>[Signature]</i><br>DIRECTOR, DIV. OF ENGINEERING / D.B. | CHECKED: <i>[Signature]</i> H.H.F.<br>APPROVED: <i>[Signature]</i> H.H.F.<br>CIVIL ENGINEER (H.R.A.)<br>DATE: 4/16/68 |
| F.B.                                                                                                                 | C.B.                                                                                                                  |

*William C. King* 8/31/67  
CHIEF ENGINEER, DEPT. OF TRAFFIC  
DATE

*S. Hawston* 7/7/67  
CHIEF ENGINEERING DIVISION, BWS  
DATE

AS-BUILT

SHEET NO. 4 OF 7 SHEETS

15-11-2-4