

HONOLULU REDEVELOPMENT AGENCY
CITY AND COUNTY OF HONOLULU
HONOLULU, HAWAII

LILIHA STREET AND KING STREET IMPROVEMENTS


JOB NO. H.R.A. 7-67(S)

TAX MAP KEY: 1-7-25 & 28


KUKUI PROJECT NO. HAWAII R-2
HONOLULU, OAHU, HAWAII

AS-BUILT TRACINGS

Certified By Harold H. Furukawa Date 5/10/68
Approved By Cullen P. Poon Date 8/21/68

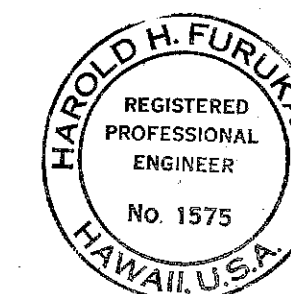

APPROVED

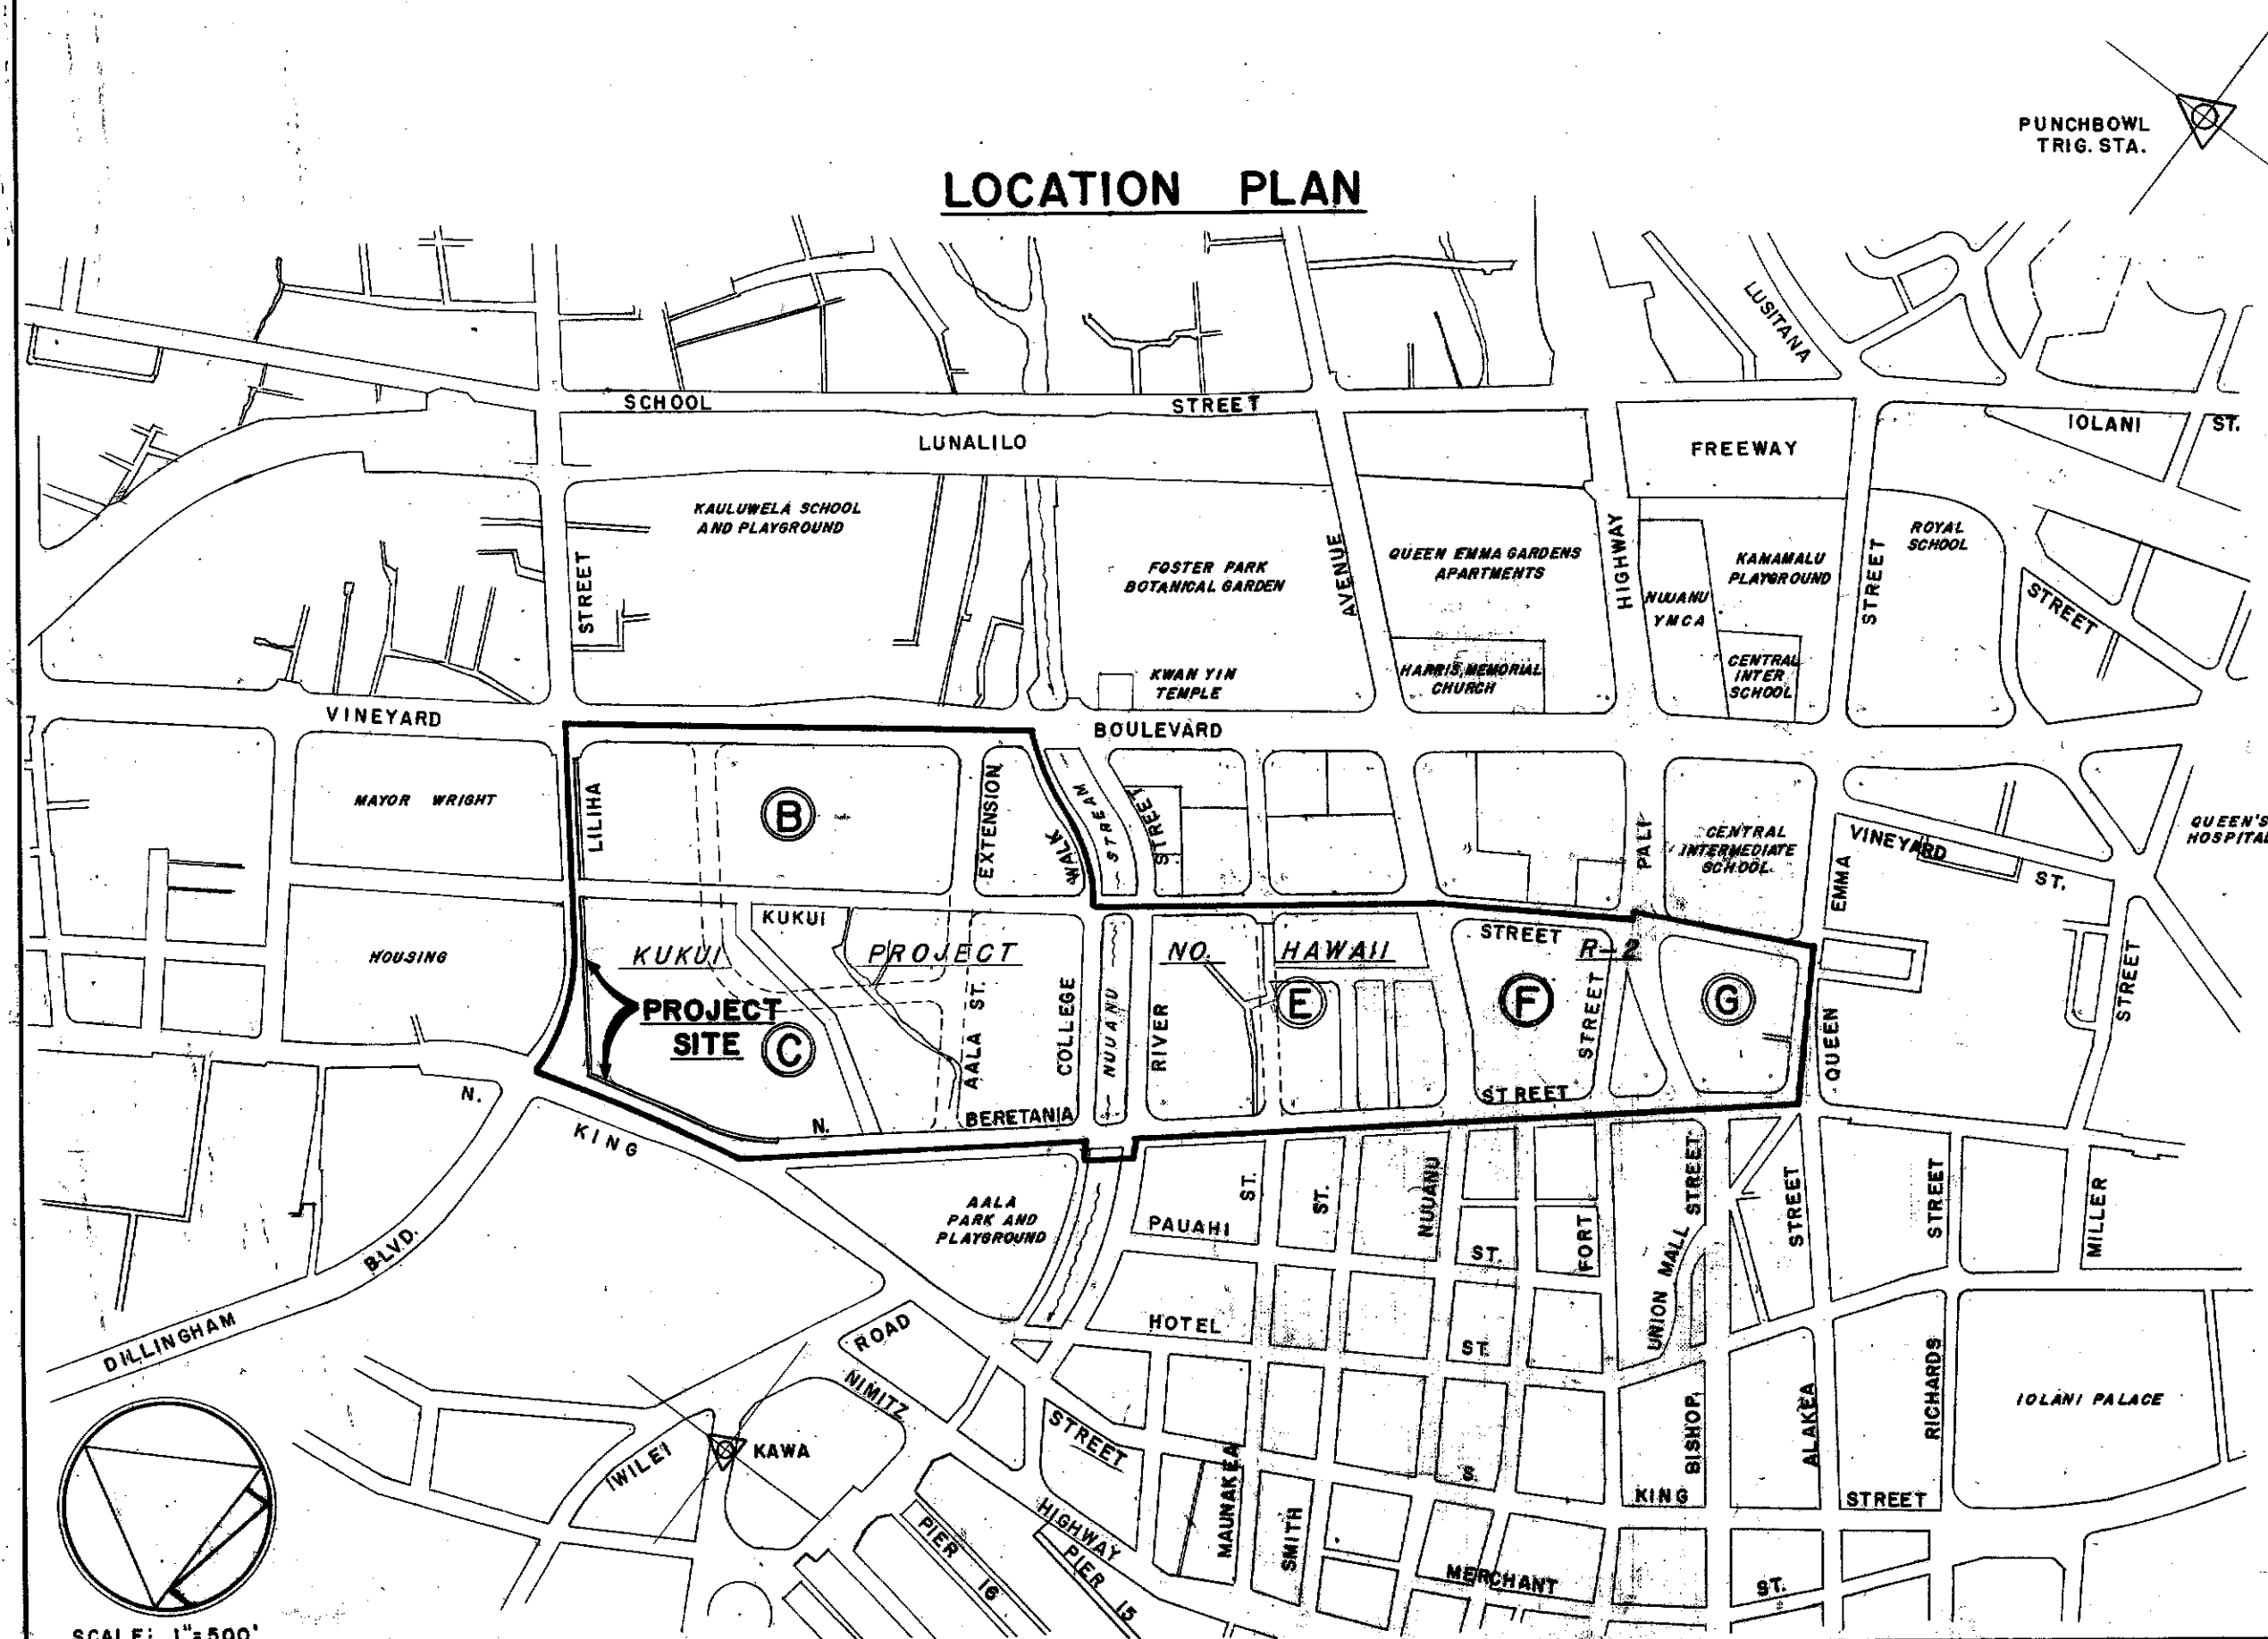

INDEX

DESCRIPTION	SHEET NO.
TITLE SHEET	1
PLAN AND PROFILE - KING STREET	2
PLAN AND PROFILE - LILIHA STREET	3 & 4
MISCELLANEOUS DETAILS	5
STANDARD STREET LIGHTING DETAILS	6 OMITTED
STANDARD TRAFFIC DETAILS	7 OMITTED

Re Maier 9-11-67
MANAGER, HONOLULU REDEVELOPMENT AGENCY DATE

Hallock 9/11/67
for PLANNING DIRECTOR, PLANNING DEPT., C&C OF HONOLULU DATE

Yoshi Kominato 7-28-67
CHIEF ENGINEER, DEPT. OF PUBLIC WORKS, C&C OF HONOLULU DATE

Emorgan 7-7-67
MANAGER & CHIEF ENGINEER, BOARD OF WATER SUPPLY DATE

William C. Hony 8/31/67
for TRAFFIC ENGINEER, DEPT. OF TRAFFIC, C&C OF HONOLULU DATE

Shirley L. Lusk 7-12-67
for DIRECTOR, DIVISION OF SANITATION, STATE OF HAWAII DATE

AS-BUILT

SHEET NO. 1 OF 7 SHEETS

15-11-2-1