



FED. ROAD DIST. NO.	STATE	FED. AID PROJ. NO.	FISCAL YEAR	SHEET NO.	TOTAL SHEETS
				5	6

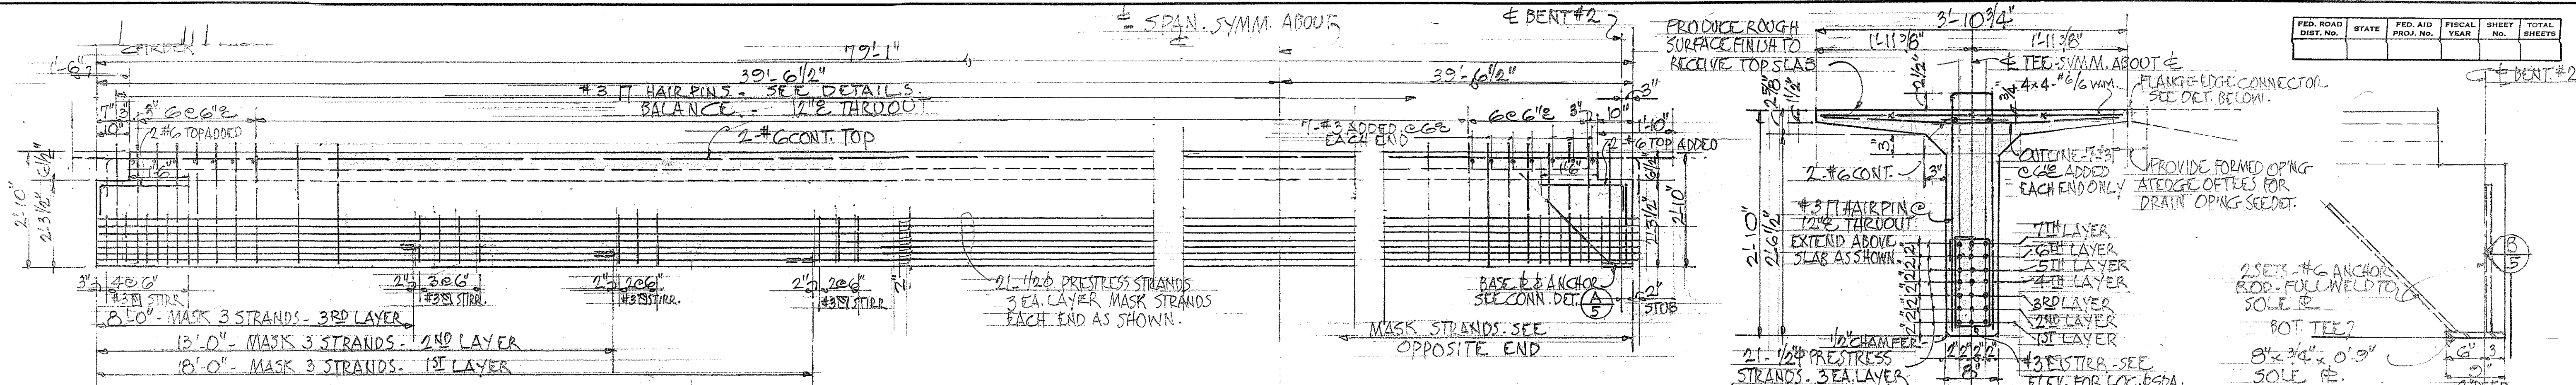


TYPICAL PRESTRESSED TEE DETAIL SCALE: 1/2"=1'-0"

TYPICAL SECTION THRU PRESTRESSED TEE SCALE: 1"=1'-0"


CONN. DETAIL (A) SCALE: 1"=1'-0"

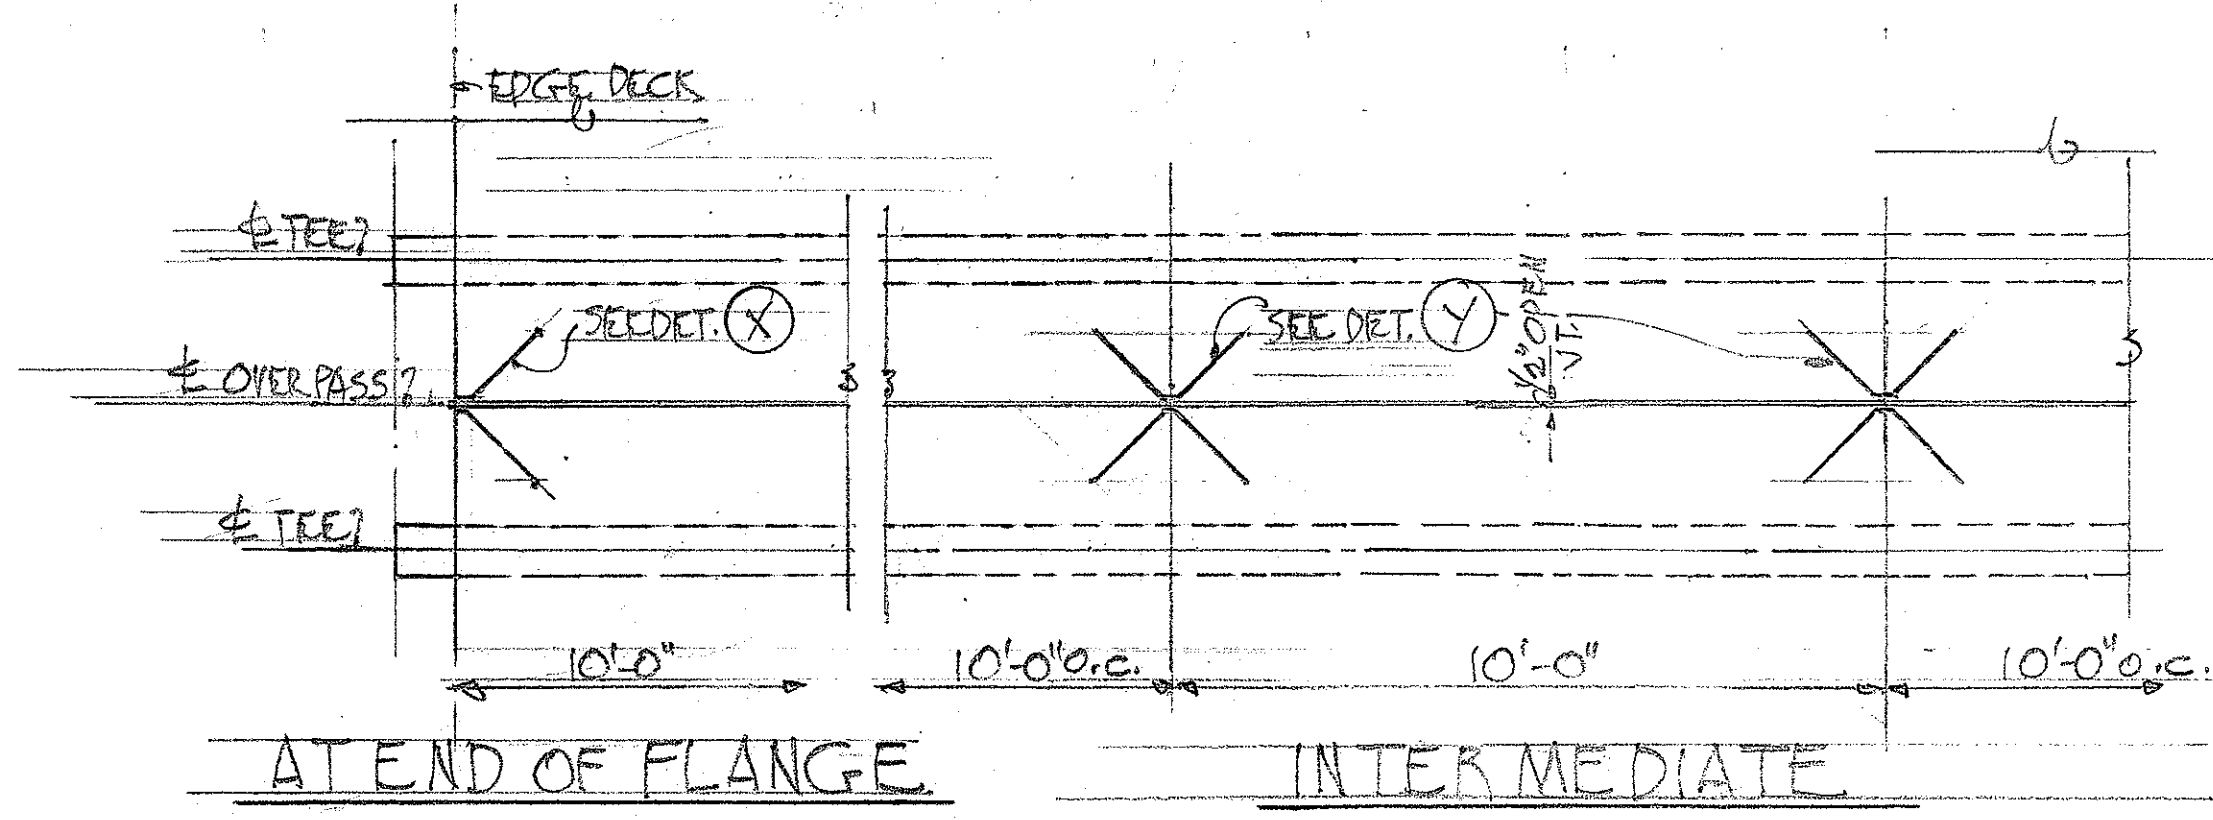


PLAN. TYPICAL PRESTRESS TEE FLANGE EDGE CONNECTOR LOCATIONS

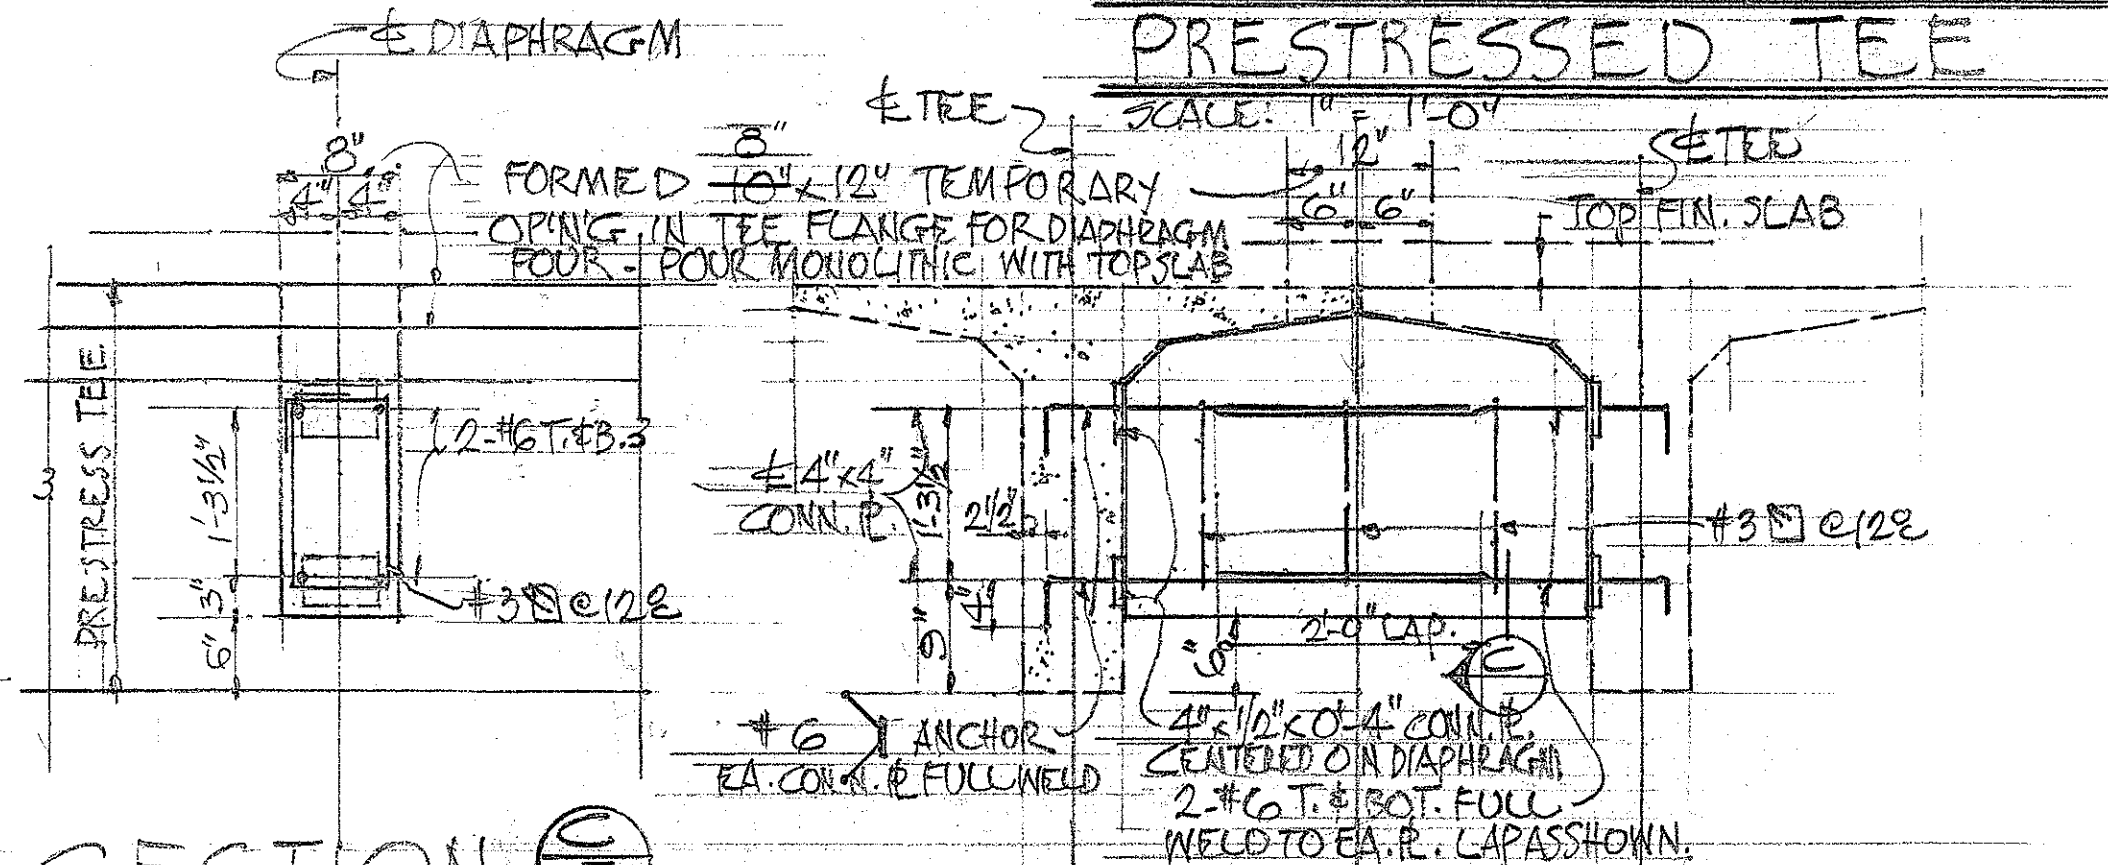


TYPICAL DIAPHRAGM DETAIL SCALE: 3/4"=1'-0"

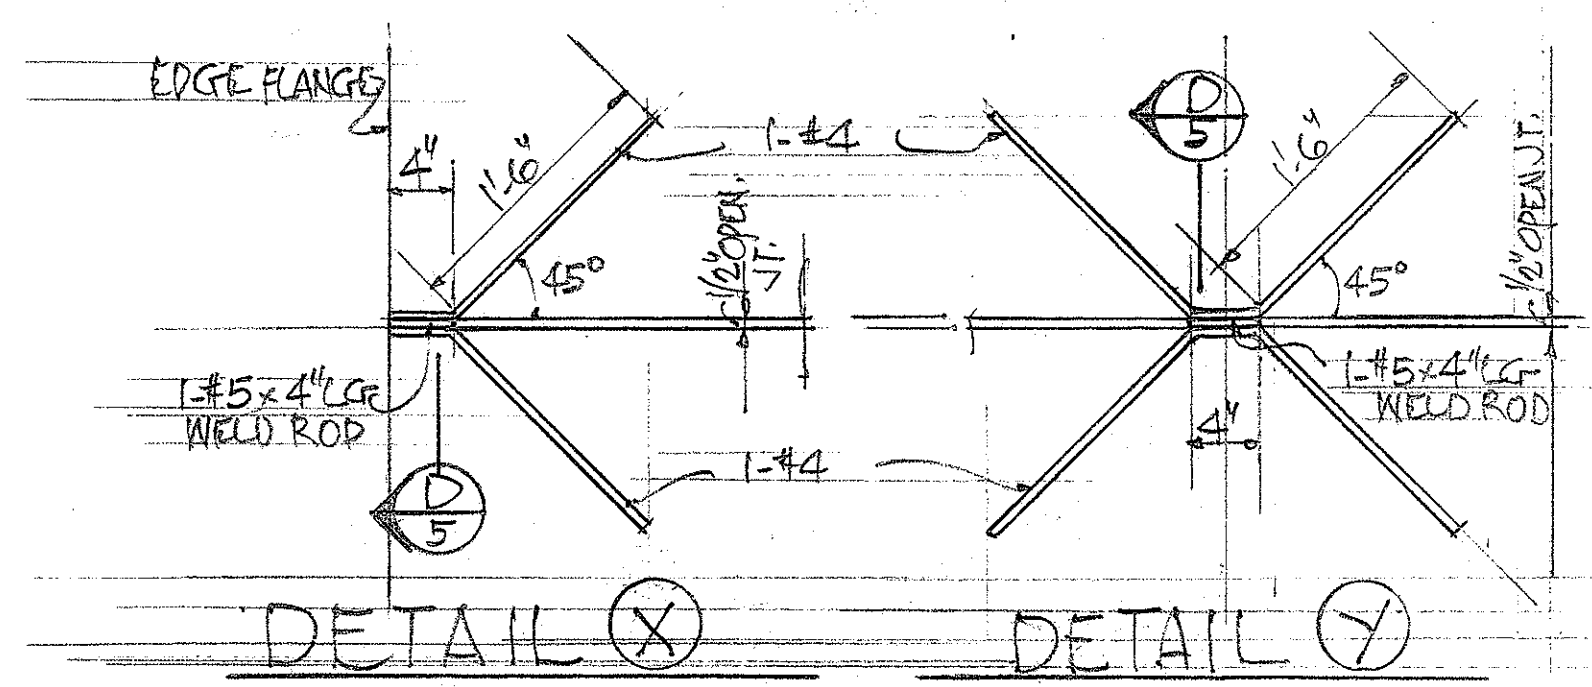


DETAIL (X) DETAIL (Y)

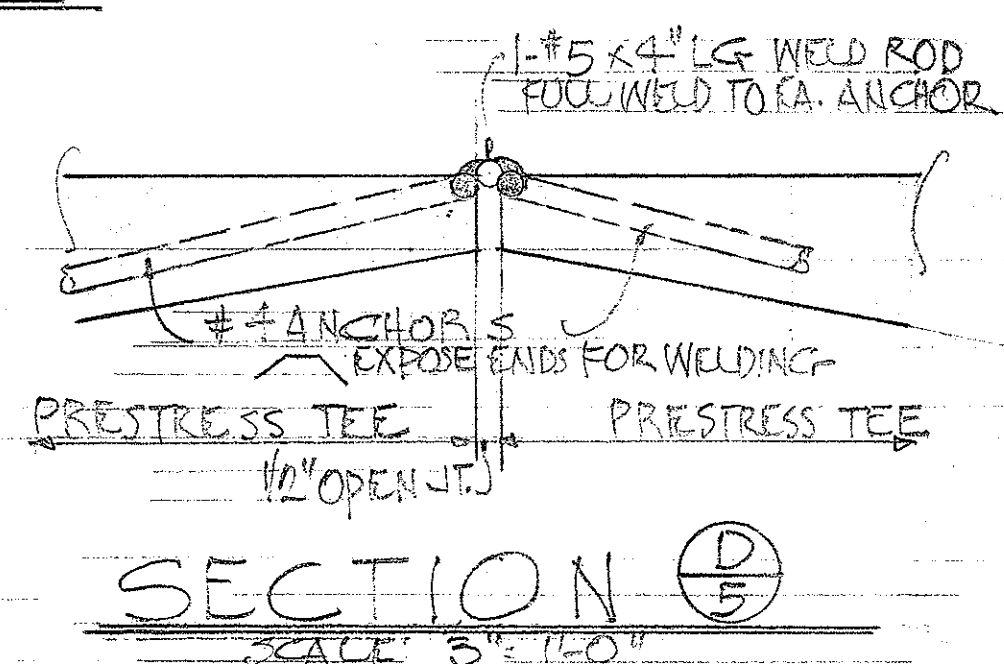

SECTION (D) SCALE: 3/4"=1'-0"

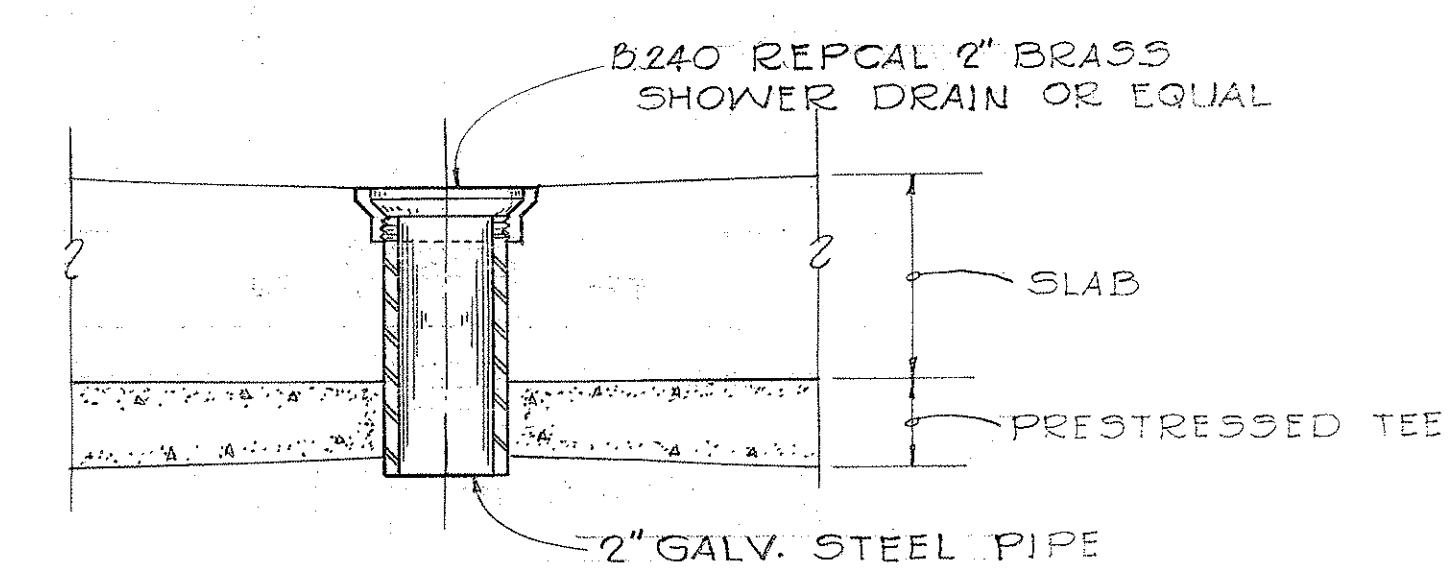

SECTION (E) SCALE: 3/4"=1'-0"

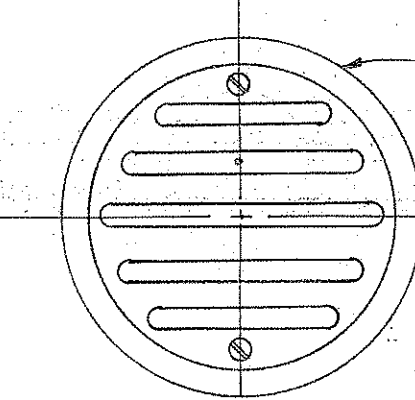

TOP VIEW SCALE: 6"=1'-0"

TYPICAL FLOOR DRAIN DETAILS SCALE: AS SHOWN

DEPARTMENT OF TRANSPORTATION
DIVISION OF HIGHWAYS
STATE OF HAWAII
PRESTRESSED TEE DETAIL
PEDESTRIAN OVERPASS
ON KAM IV ROAD
PROJECT NO G-3120 01 60
JANUARY 1961

DESIGNED BY	DATE
DRAWN BY	
CHECKED BY	
NOTED BY	
QUANTITIES CHECKED BY	
ORIGINAL PLAN	
NOTE BOOK	
NO.	

