



FED. ROAD DIST. NO.	STATE	FED. AID PROJ. NO.	FISCAL YEAR	SHEET NO.	TOTAL SHEETS
				4	6

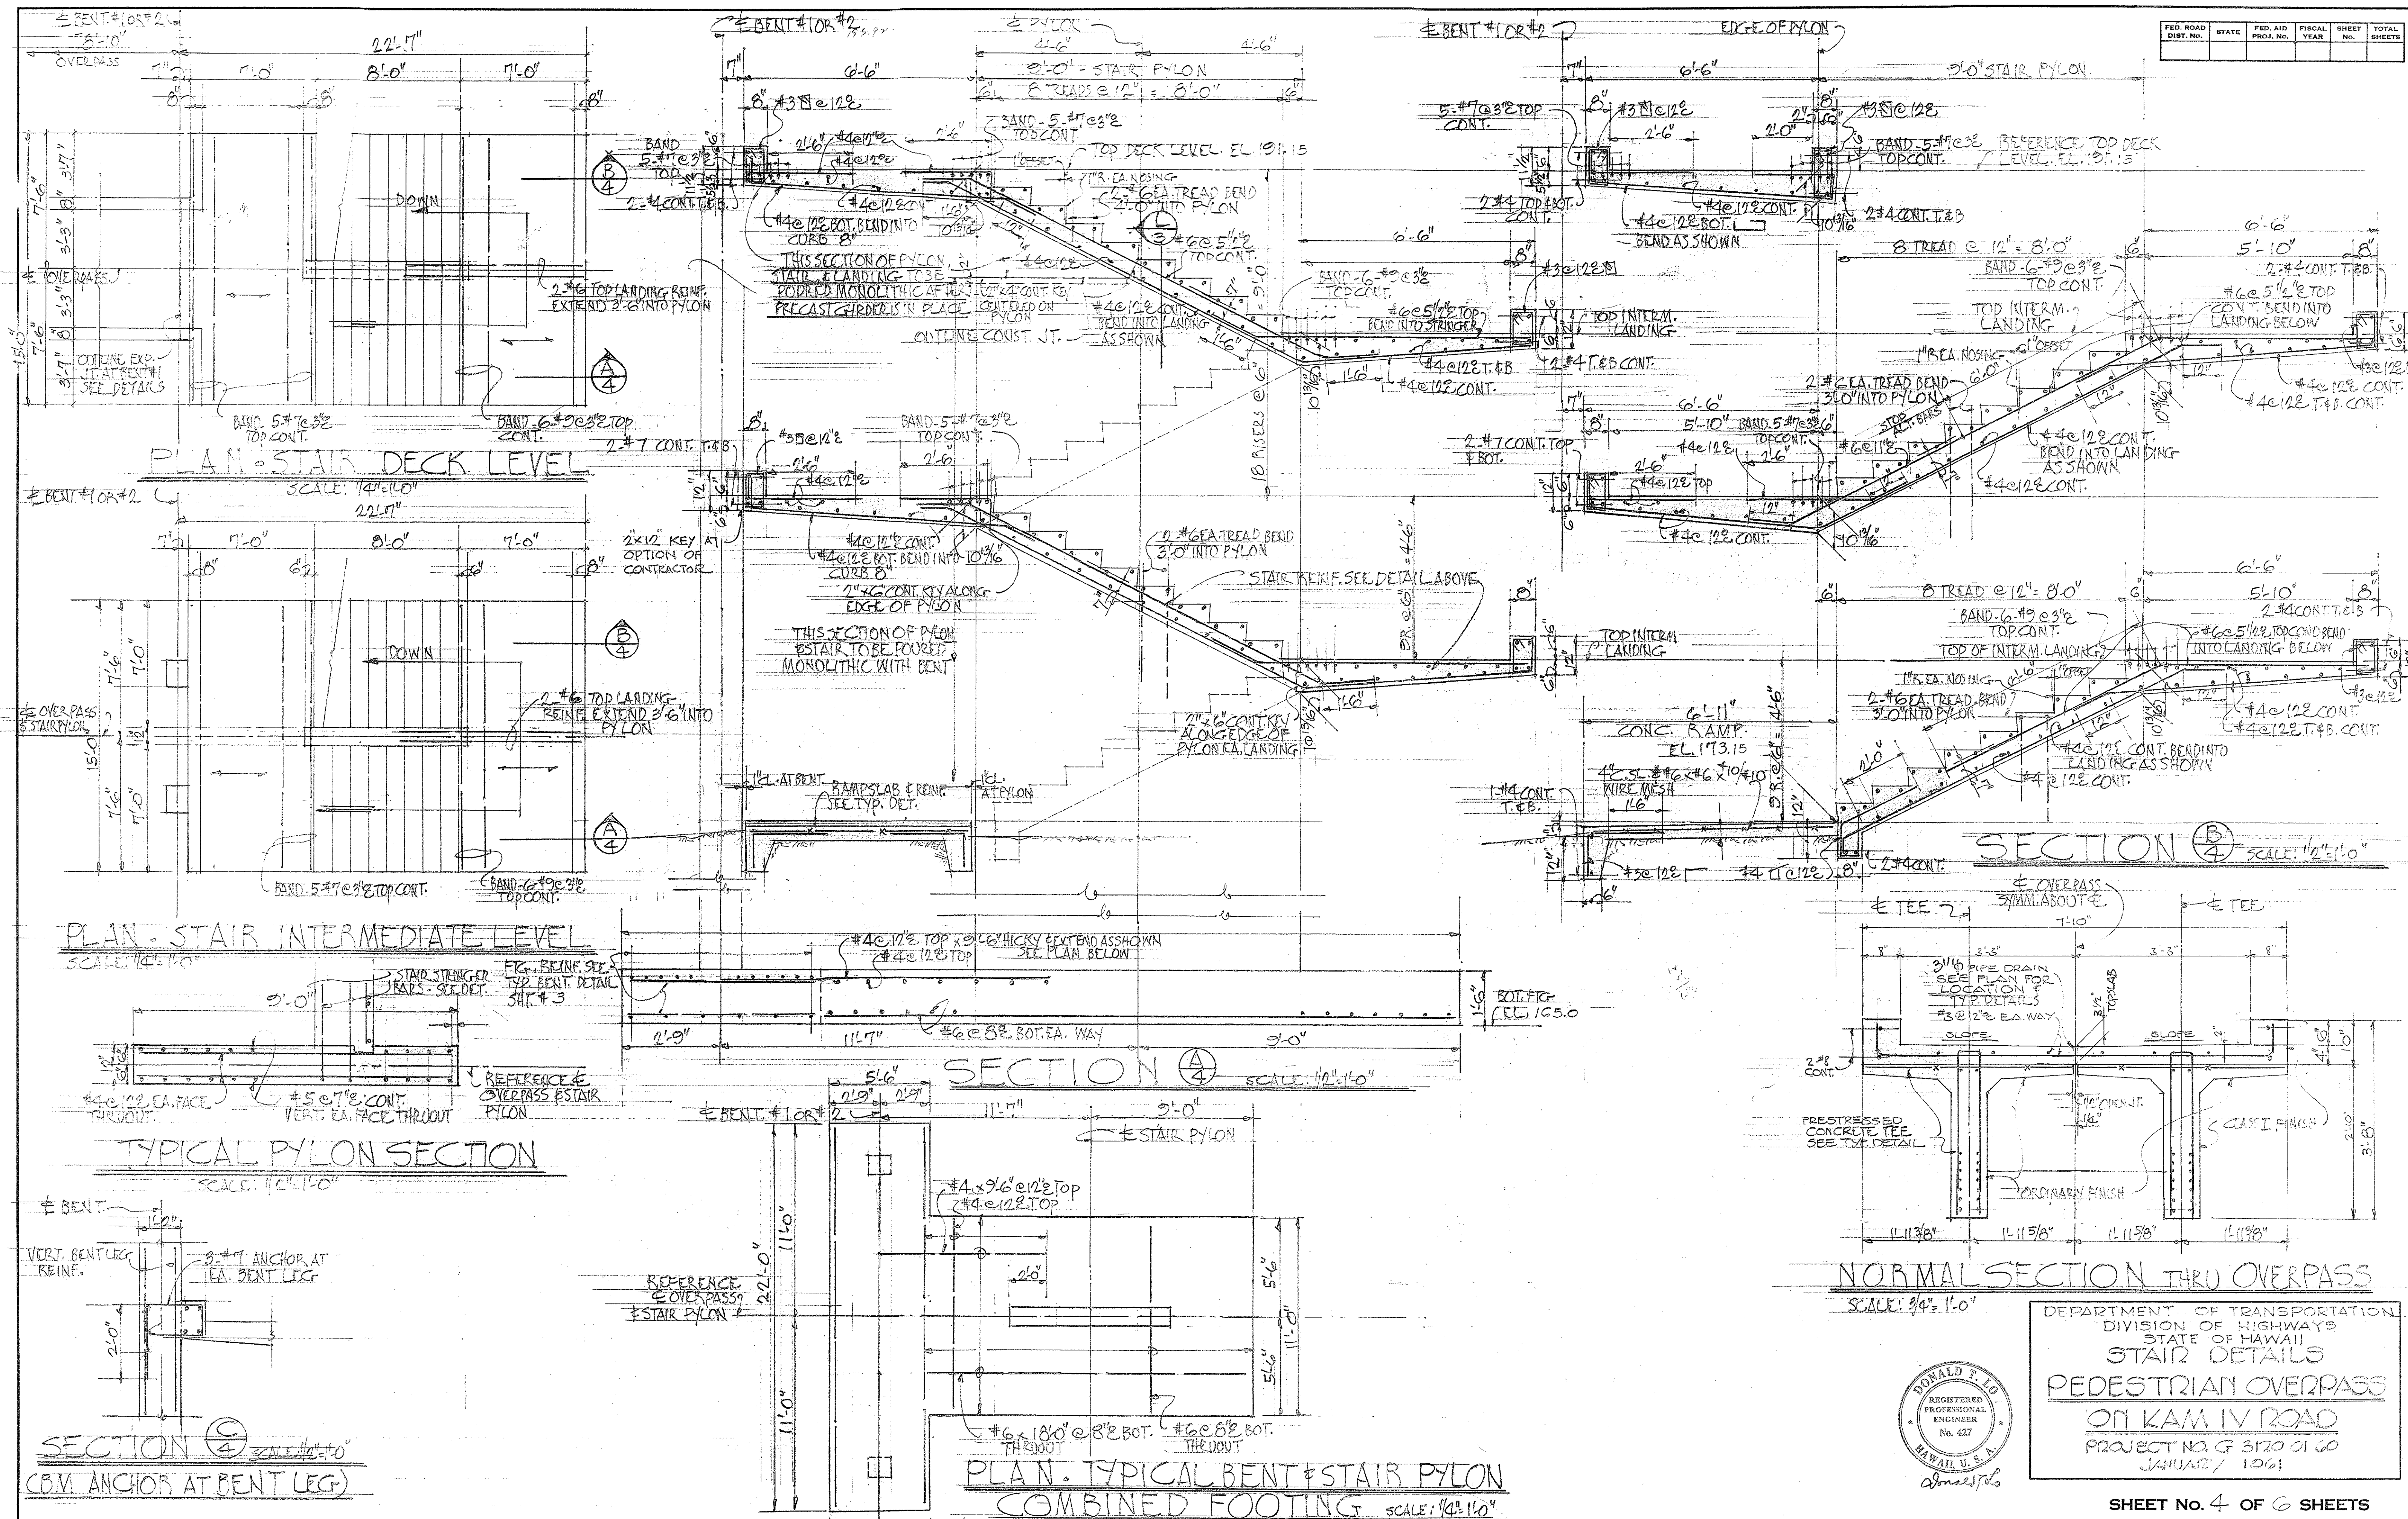

DATE	
SURVEY PLOTTED BY	
DESIGNED BY	
TRACED BY	
QUANTITIES CHECKED BY	
NOTE BOOK NO.	
DRAWN BY	

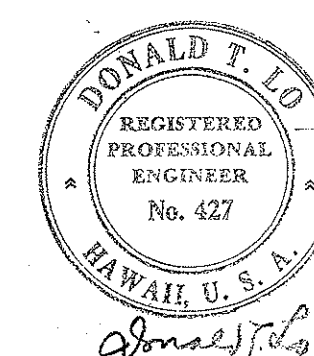

DEPARTMENT OF TRANSPORTATION
DIVISION OF HIGHWAYS
STATE OF HAWAII
STAIR DETAILS
PEDESTRIAN OVERPASS
ON KAM IV ROAD
PROJECT NO. G 3170 01 60
JANUARY 1961