

# INDEX TO DRAWINGS

| SHEET NO. | DESCRIPTION               |
|-----------|---------------------------|
| 1         | TITLE SHEET & SITE PLAN   |
| 2         | LAYOUT PLAN & BORING LOGS |
| 3         | BENT DETAILS              |
| 4         | STAIR DETAILS             |
| 5         | PRESTRESSED TEE DETS.     |
| 6         | HAND RAIL DETAILS         |

| FED. ROAD DIST. NO. | STATE | FED. AID PROJ. NO. | FISCAL YEAR | SHEET NO. | TOTAL SHEETS |
|---------------------|-------|--------------------|-------------|-----------|--------------|
|                     |       |                    |             |           |              |

STATE OF HAWAII  
DEPARTMENT OF TRANSPORTATION  
DIVISION OF HIGHWAYS  
HONOLULU, OAHU, HAWAII



PLANS OF  
PEDESTRIAN OVERPASS

ON  
KAM IV ROAD

PROJECT NO. G-3120-01-60

DISTRICT OF HONOLULU

ISLAND OF OAHU

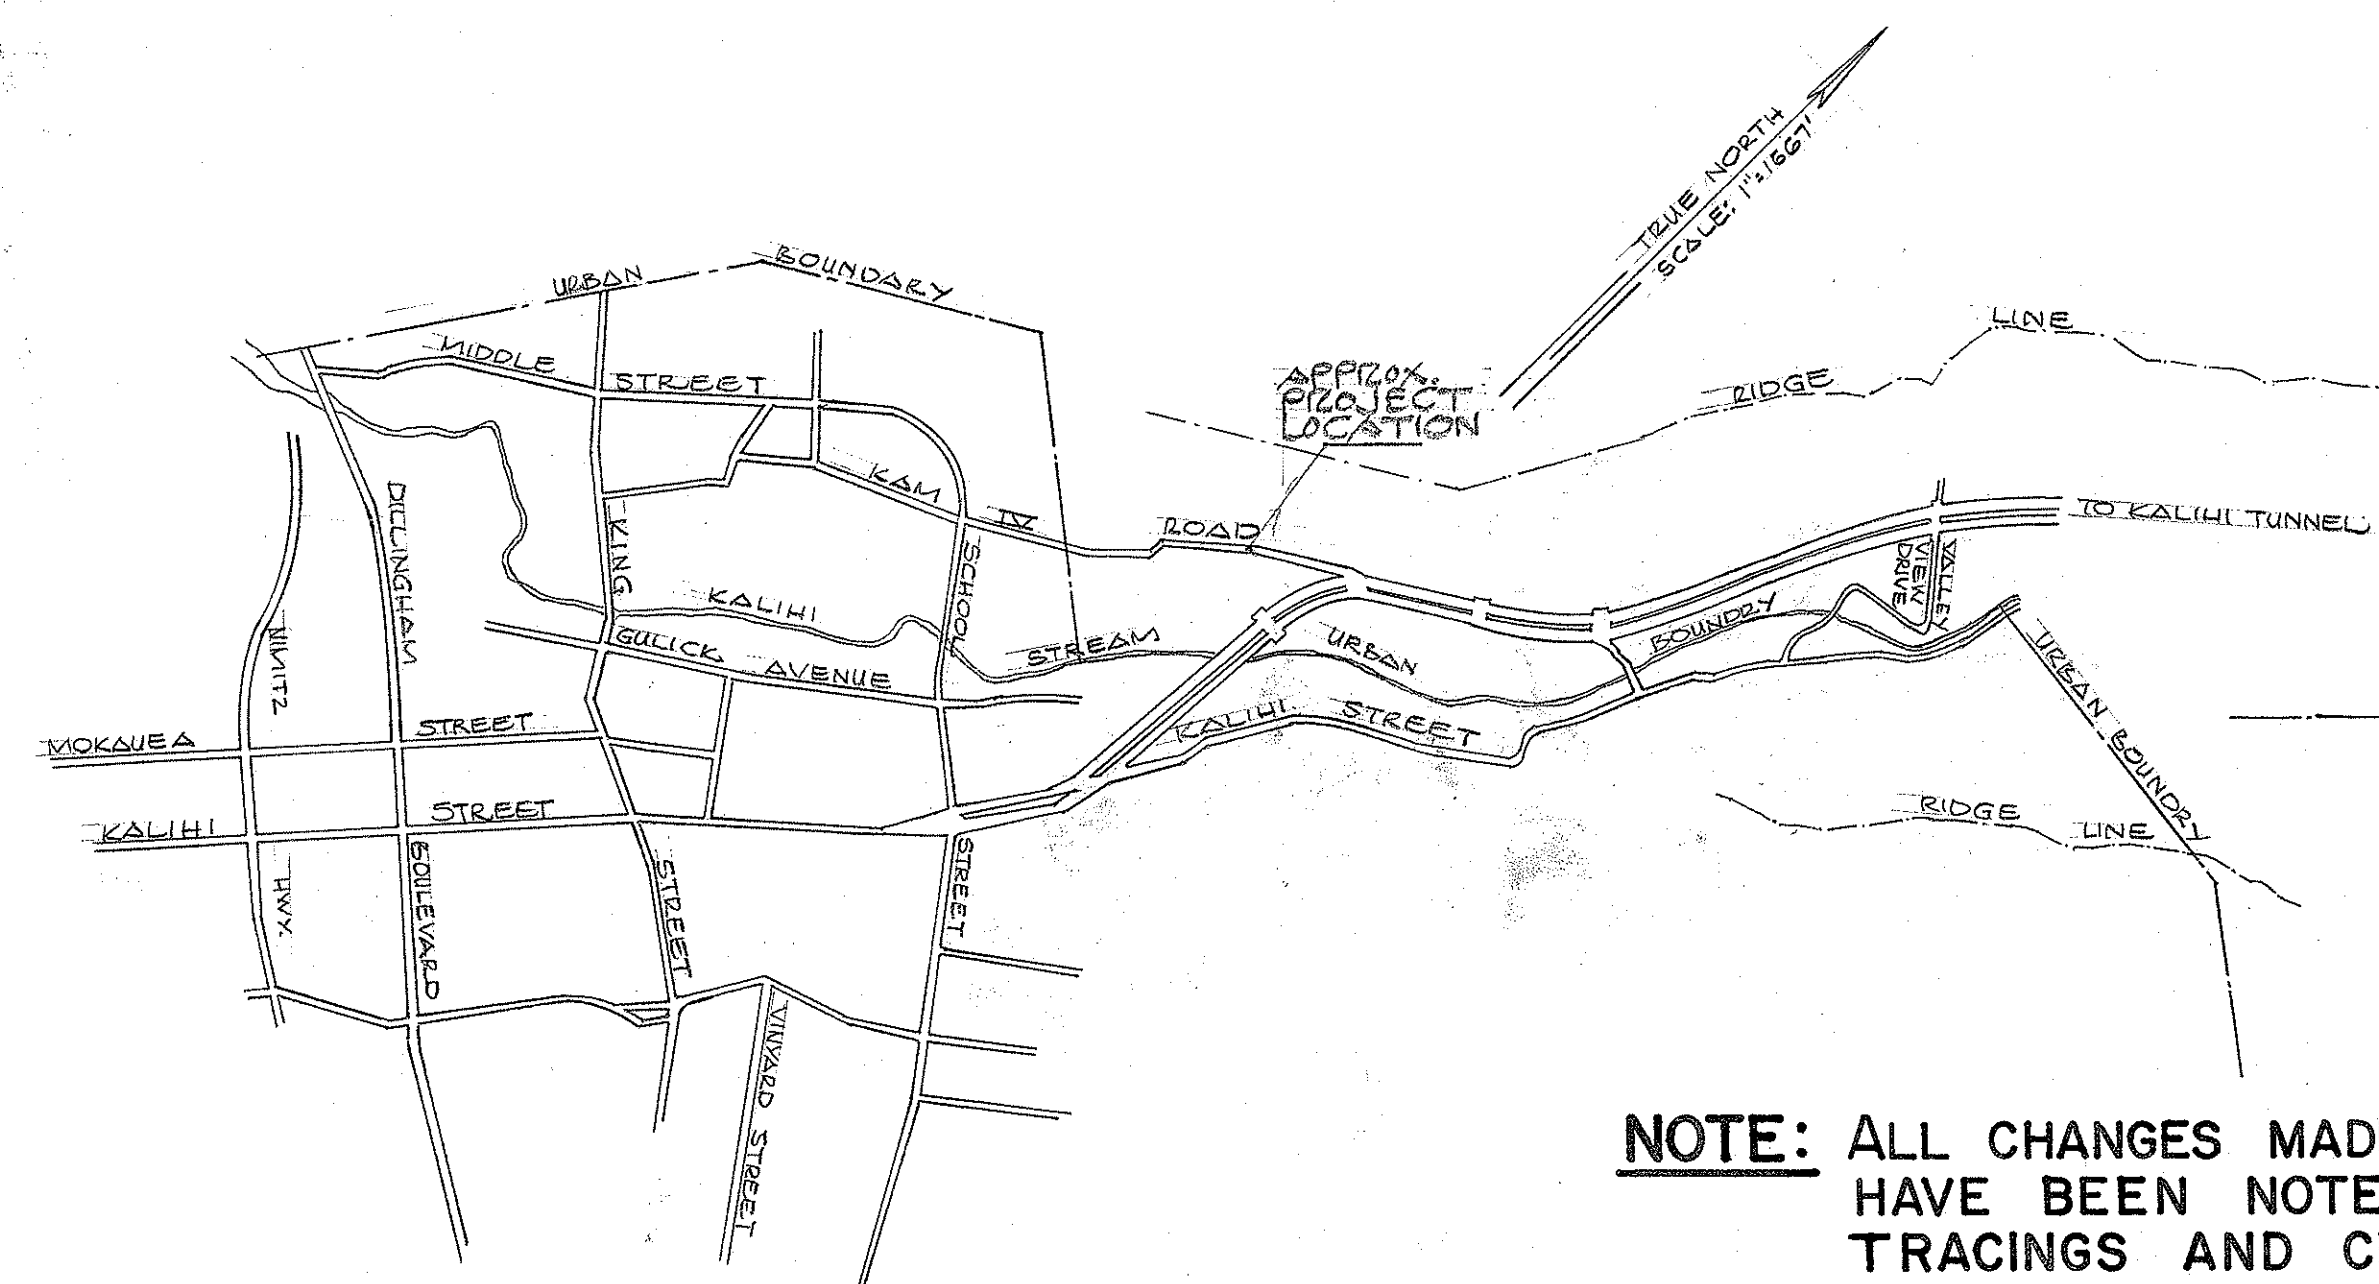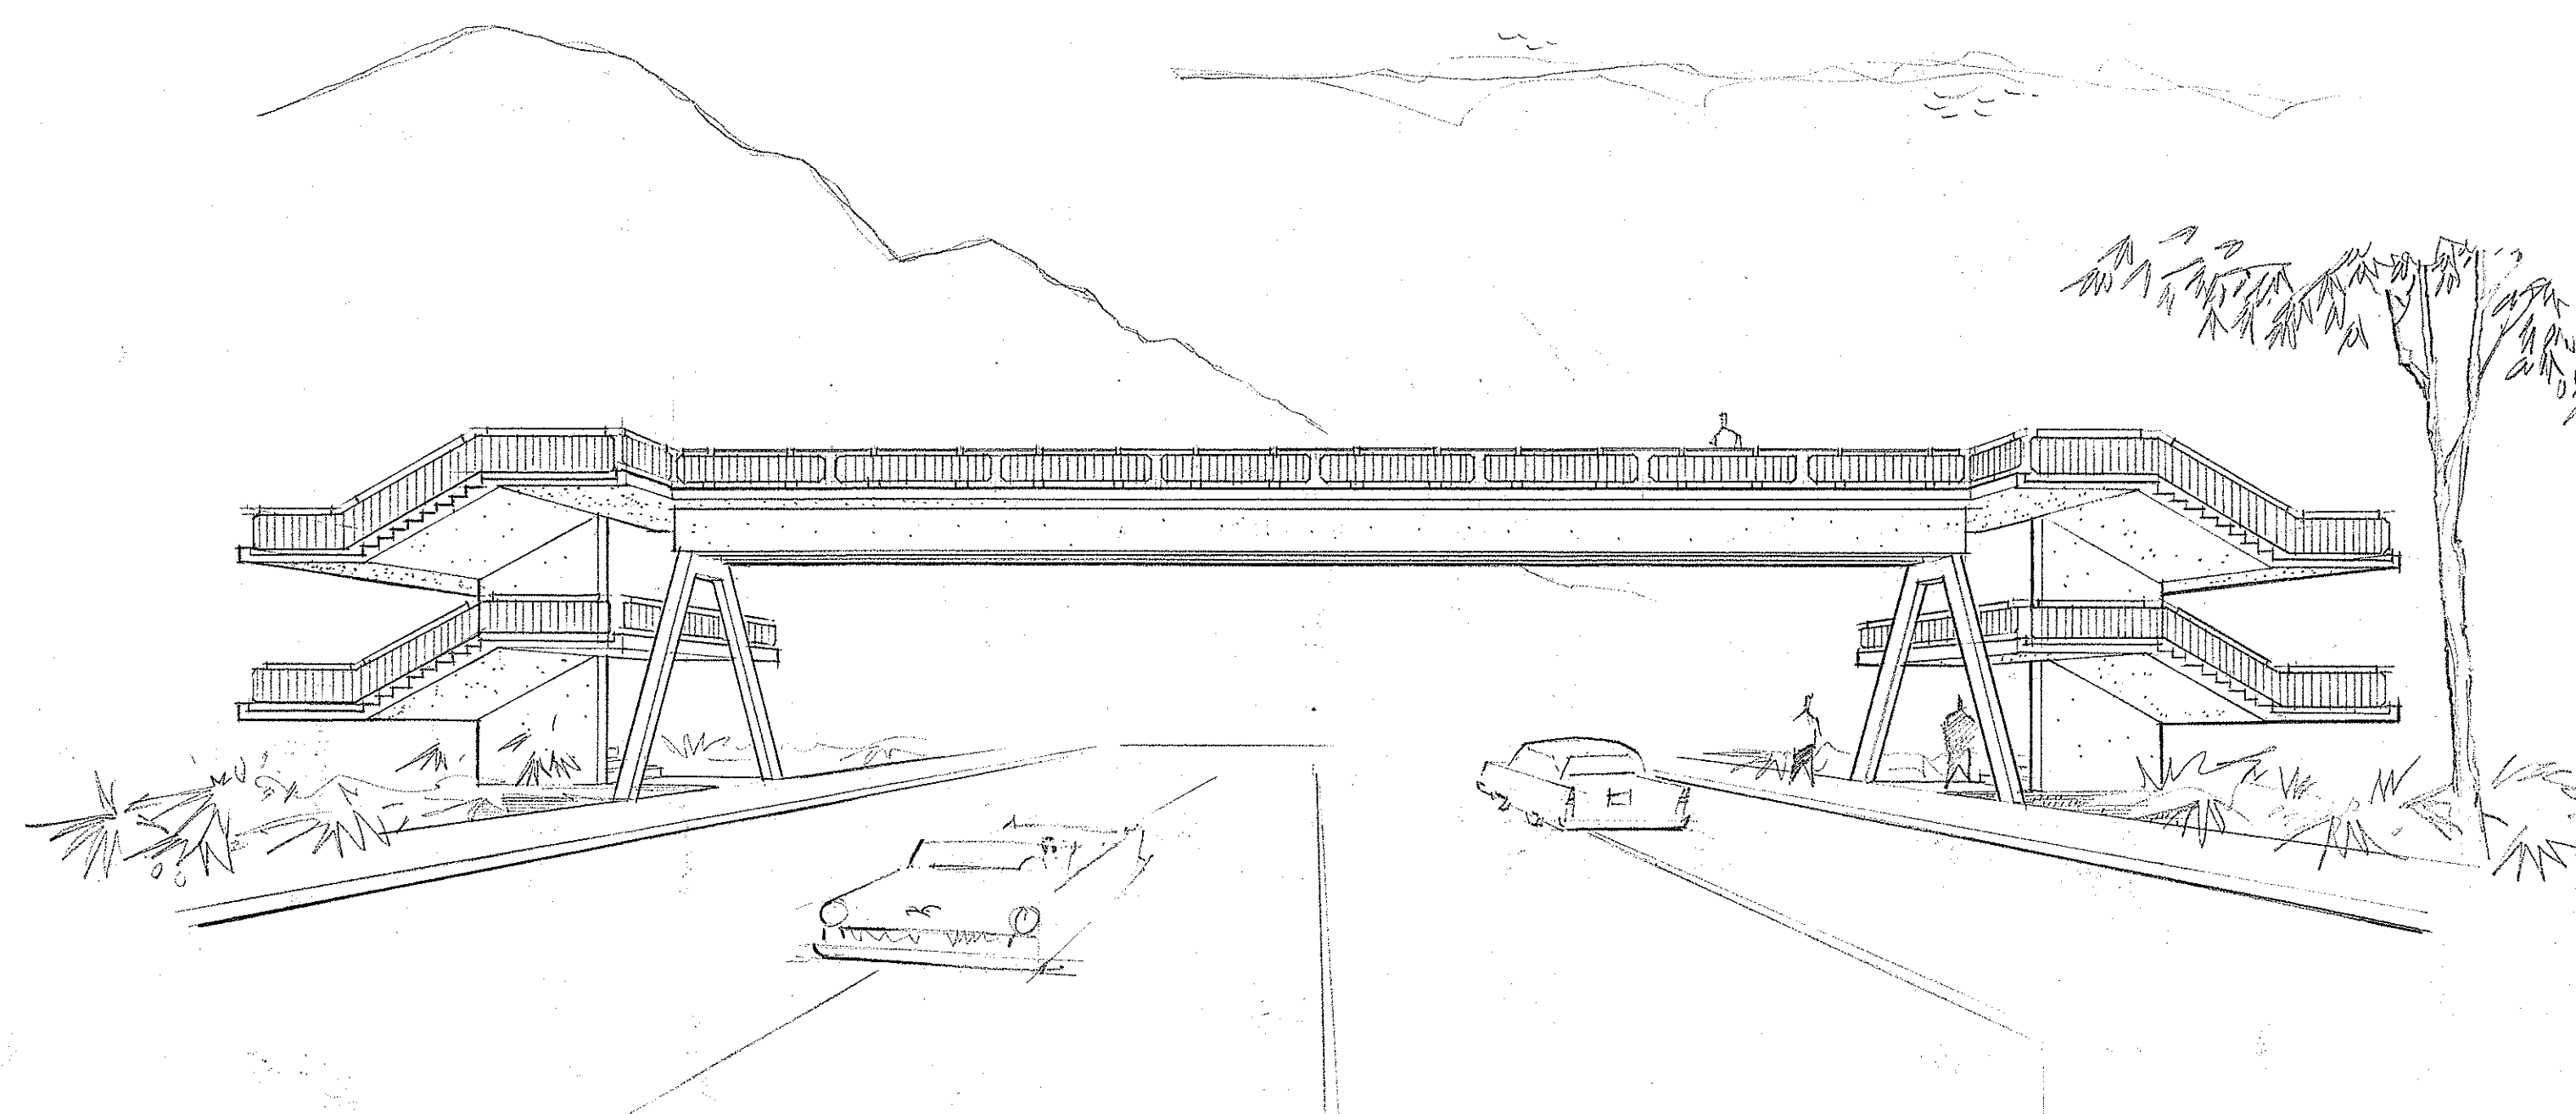


LOCATION PLAN  
SCALE: 1" = 1667'

**NOTE:** ALL CHANGES MADE DURING CONSTRUCTION  
HAVE BEEN NOTED IN RED ON THESE  
TRACINGS AND CHECKED BY

*Jerry E. Nishida*  
PROJECT ENGINEER


8-2-63  
DATE

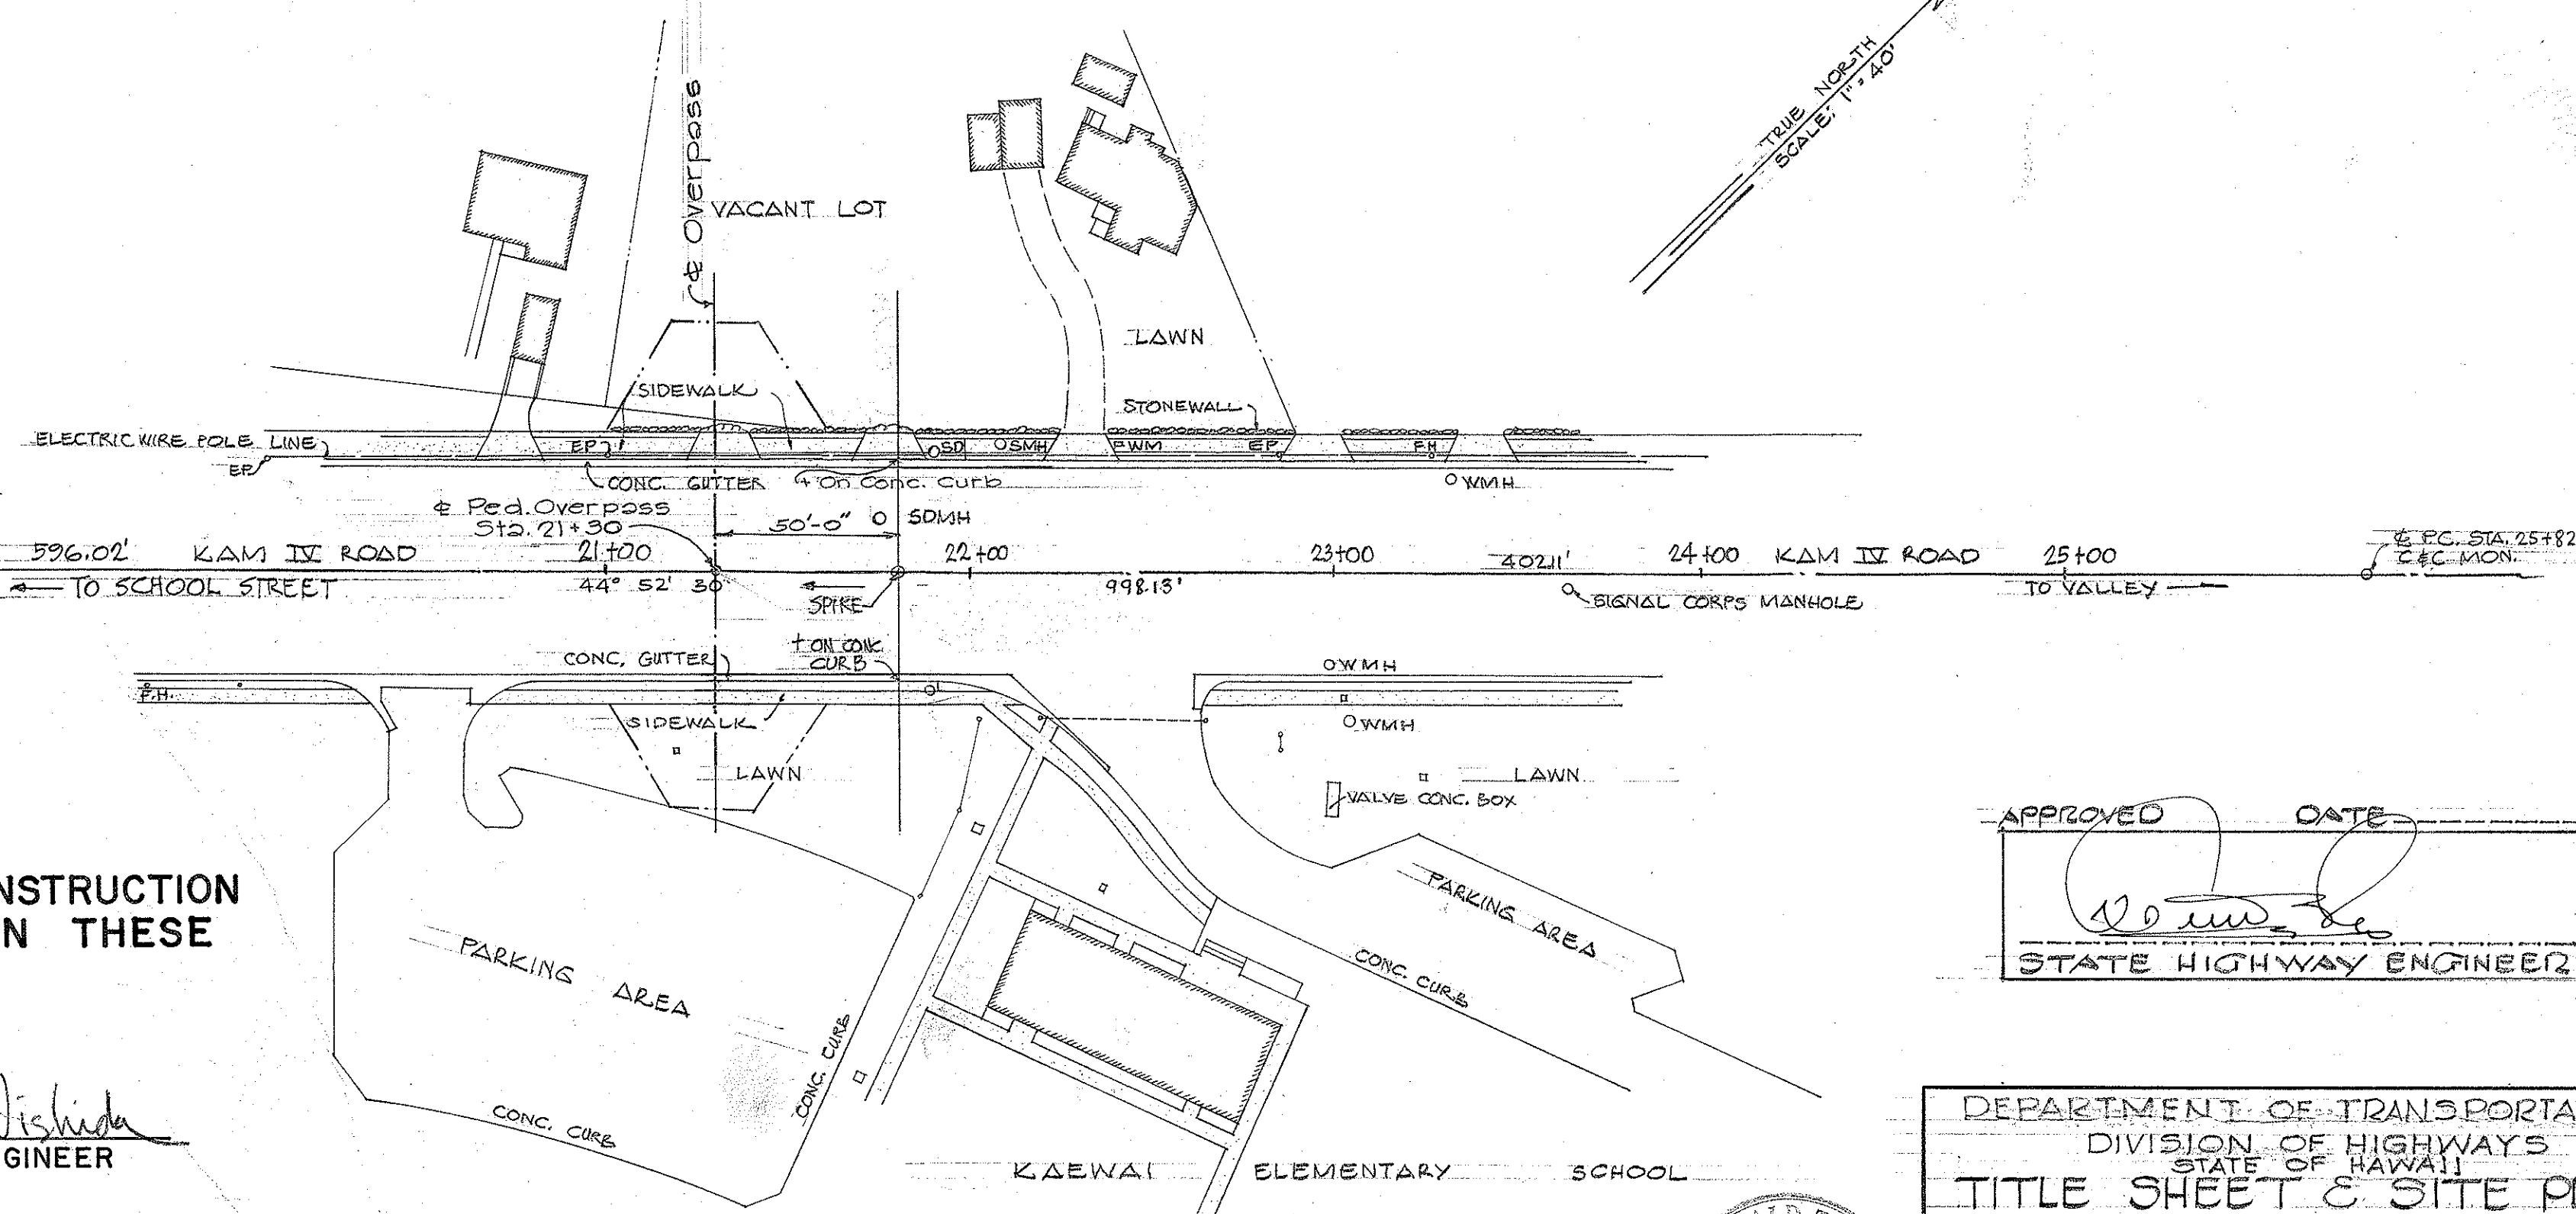

SITE PLAN  
SCALE: 1" = 40'

APPROVED *[Signature]* DATE  
STATE HIGHWAY ENGINEER

DEPARTMENT OF TRANSPORTATION  
DIVISION OF HIGHWAYS  
STATE OF HAWAII  
TITLE SHEET & SITE PLAN  
PEDESTRIAN OVERPASS  
ON KAM IV ROAD  
PROJECT NO. G-3120-01-60  
JANUARY 1961

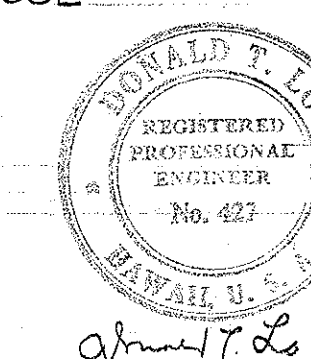

SHEET No. 1 OF 6 SHEETS

|                       |      |
|-----------------------|------|
| SURVEY PLOTTED BY     | DATE |
| DRAWN BY              |      |
| TRACED BY             |      |
| QUANTITIES CHECKED BY |      |
| NOTE BOOK CHECKED BY  |      |
| ORIGINAL PLAN No.     |      |