



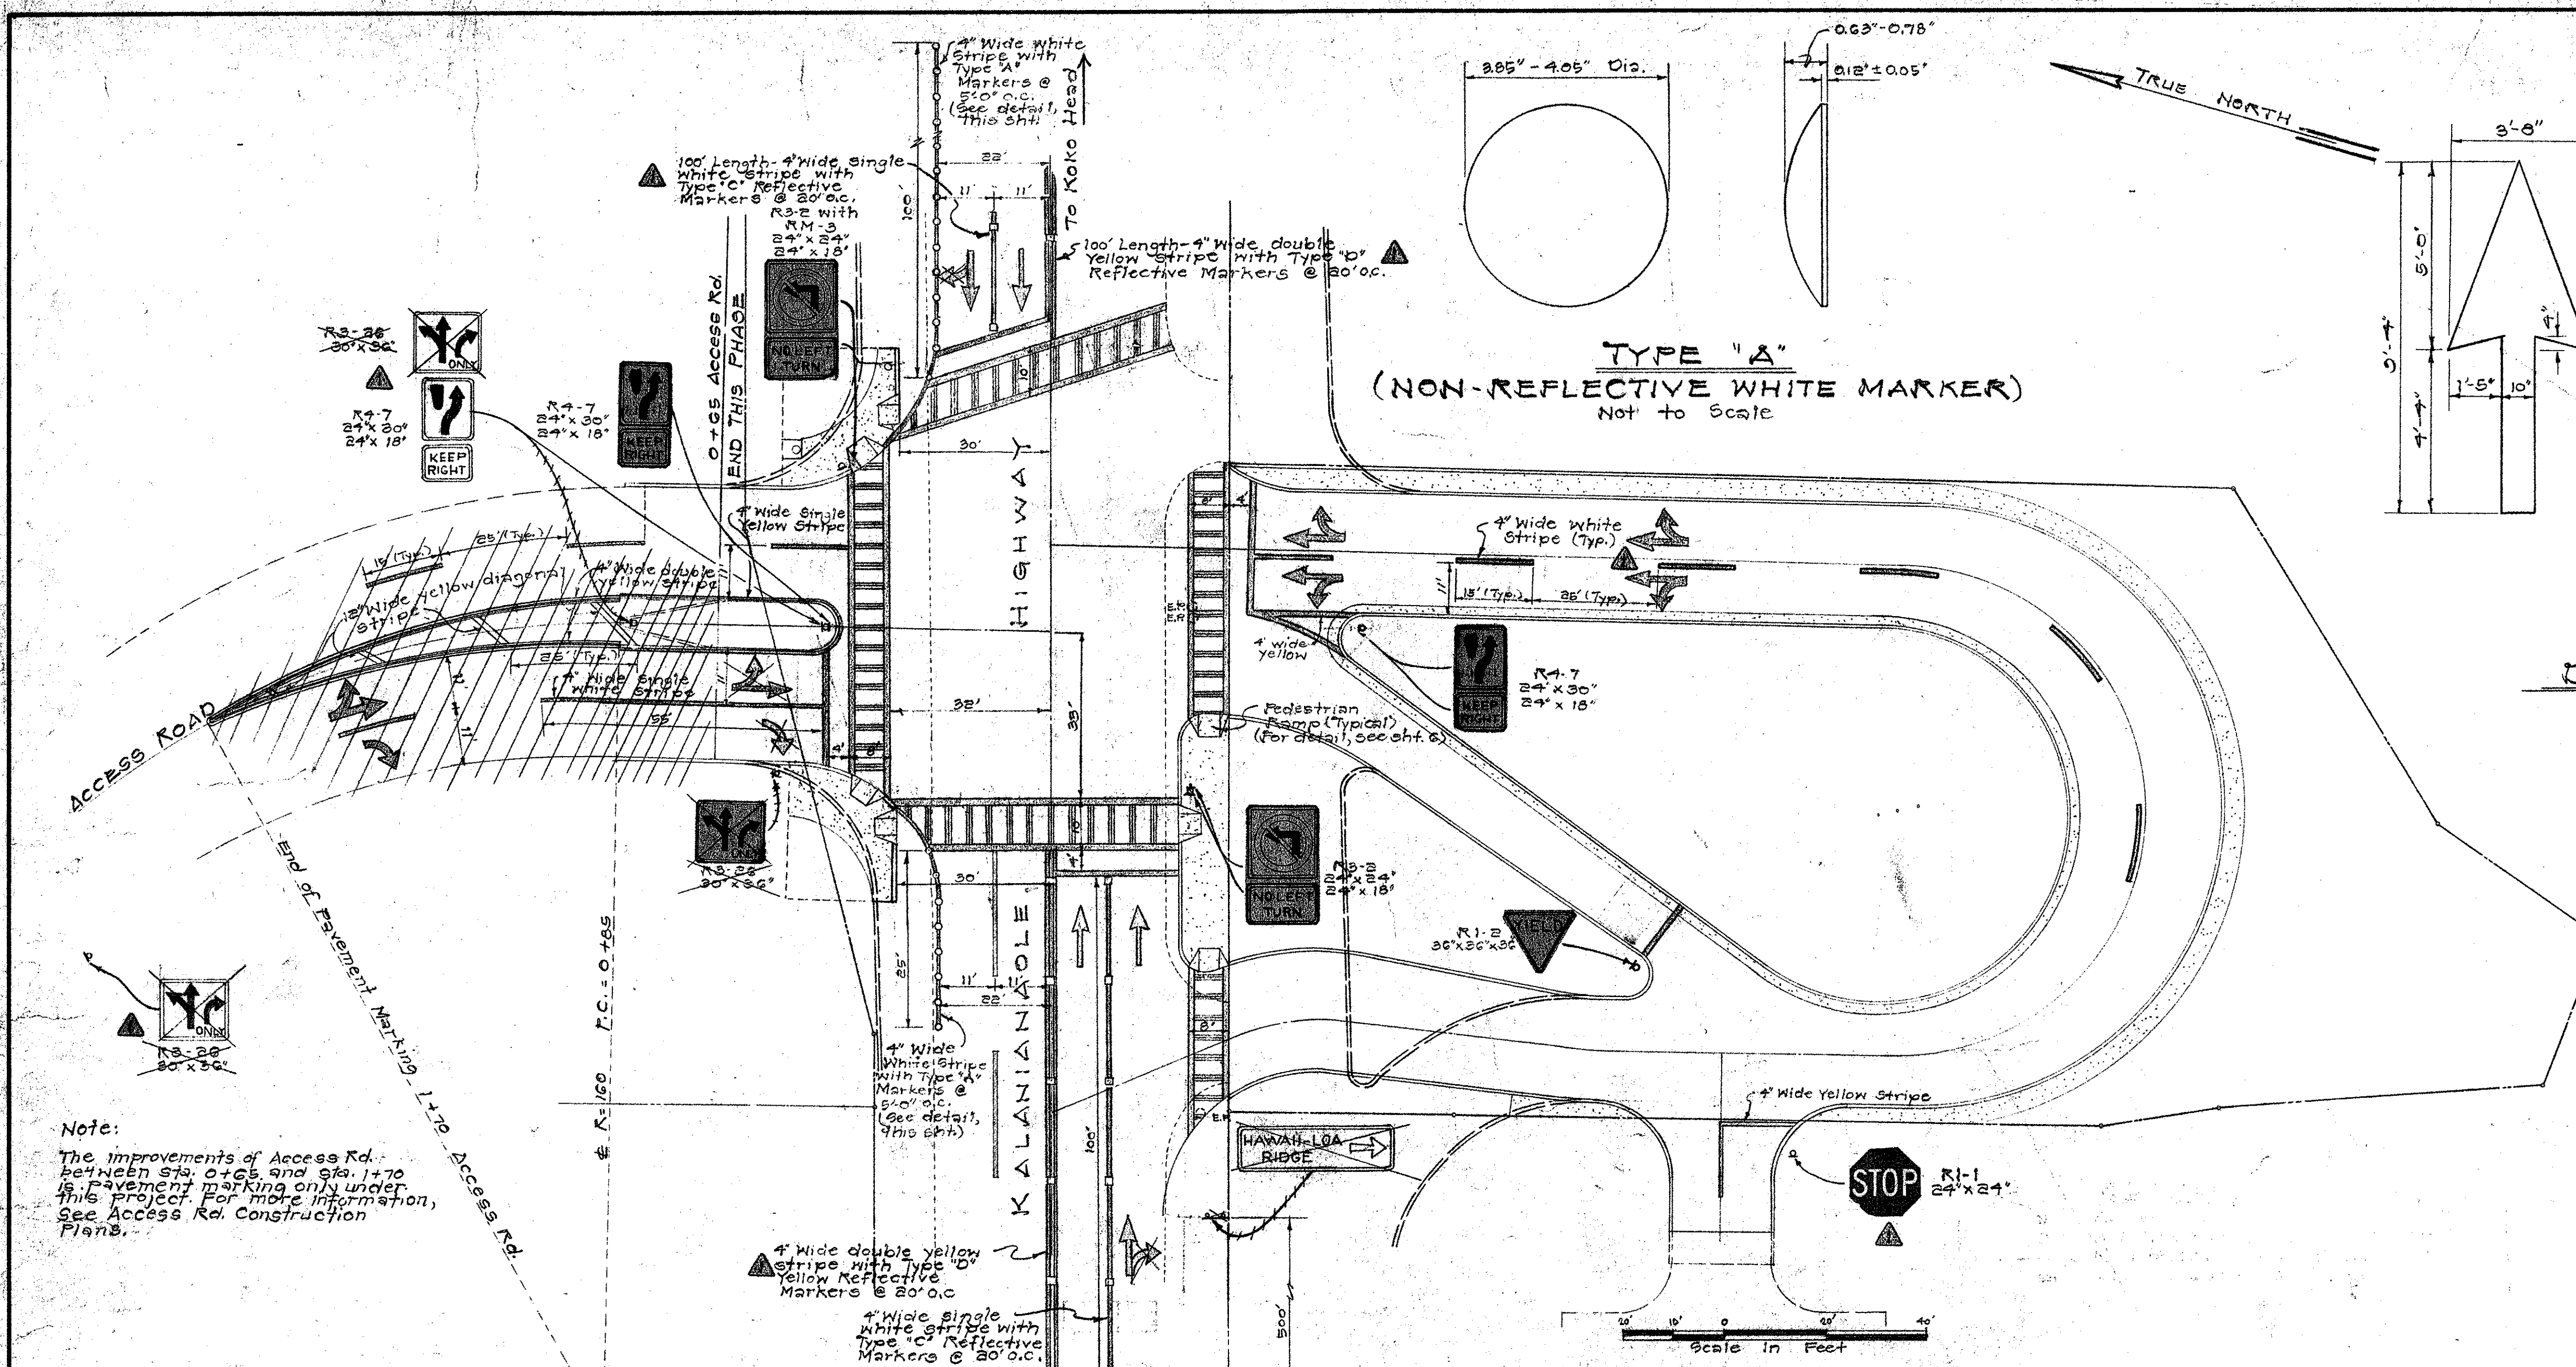


DETAILS ~ PAVEMENT ARROWS
Scale: 3/8" = 1'-0"

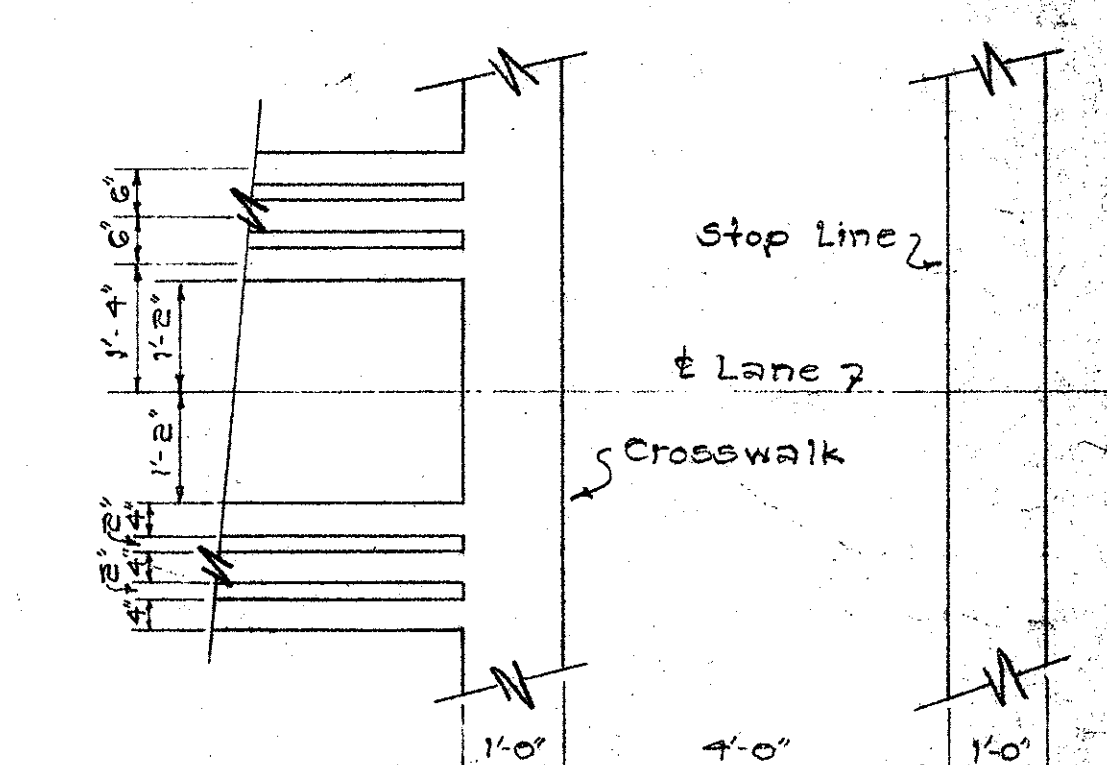


CROSSWALK AND STOP LINE DETAIL
Scale: 1/8" = 1'-0"

- DIRECTIONAL SIGN NOTES**
1. Signs shall conform to State Plans and Specifications for regulatory and warning signs.
 2. Lettering shall conform to BPR Manual Standard Alphabets for Highway Signs, 1966, Use Series 'E' Modified Letters.
 3. Arrows and borders shall conform to details as shown on plan.
 4. Legend, Arrows and borders shall be reflectorized white on reflectorized green background.
 5. For mounting, see detail this sheet.

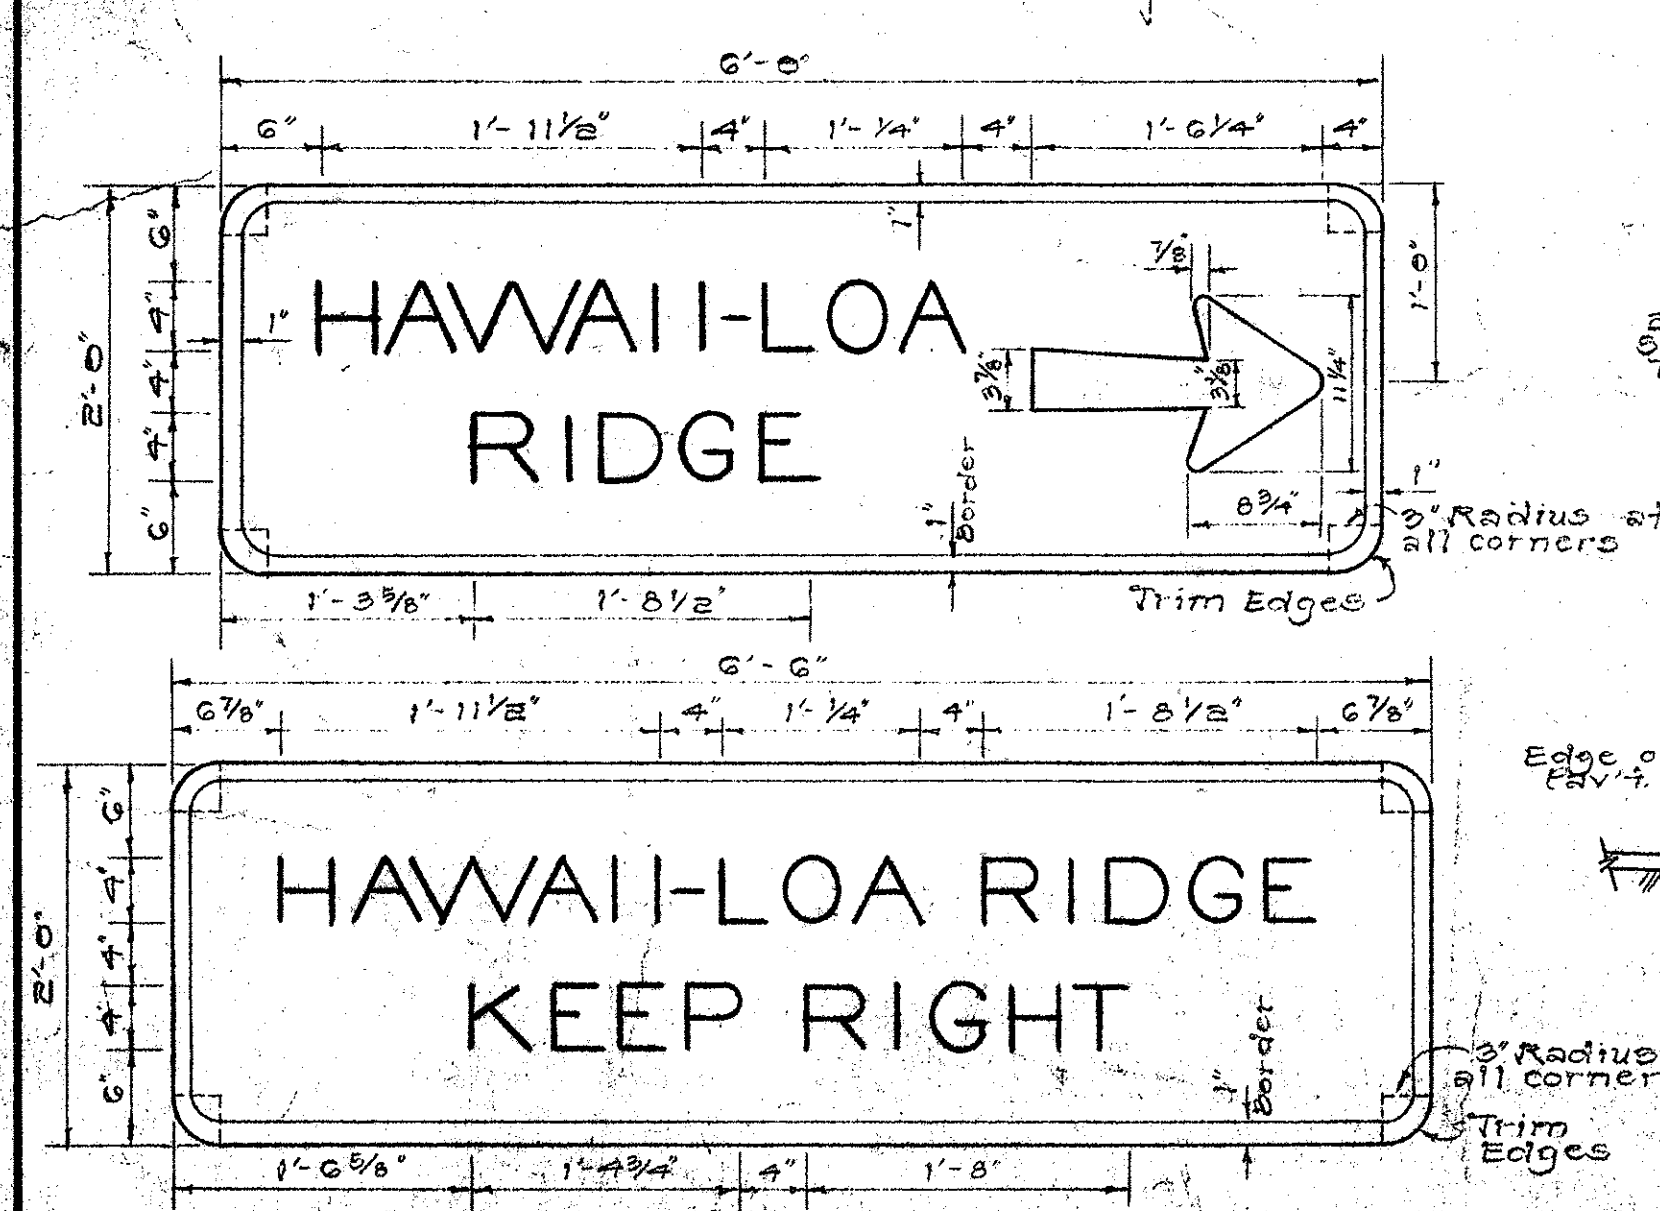

DETAILS ~ DIRECTIONAL SIGNS
Scale: 1" = 1'-0"

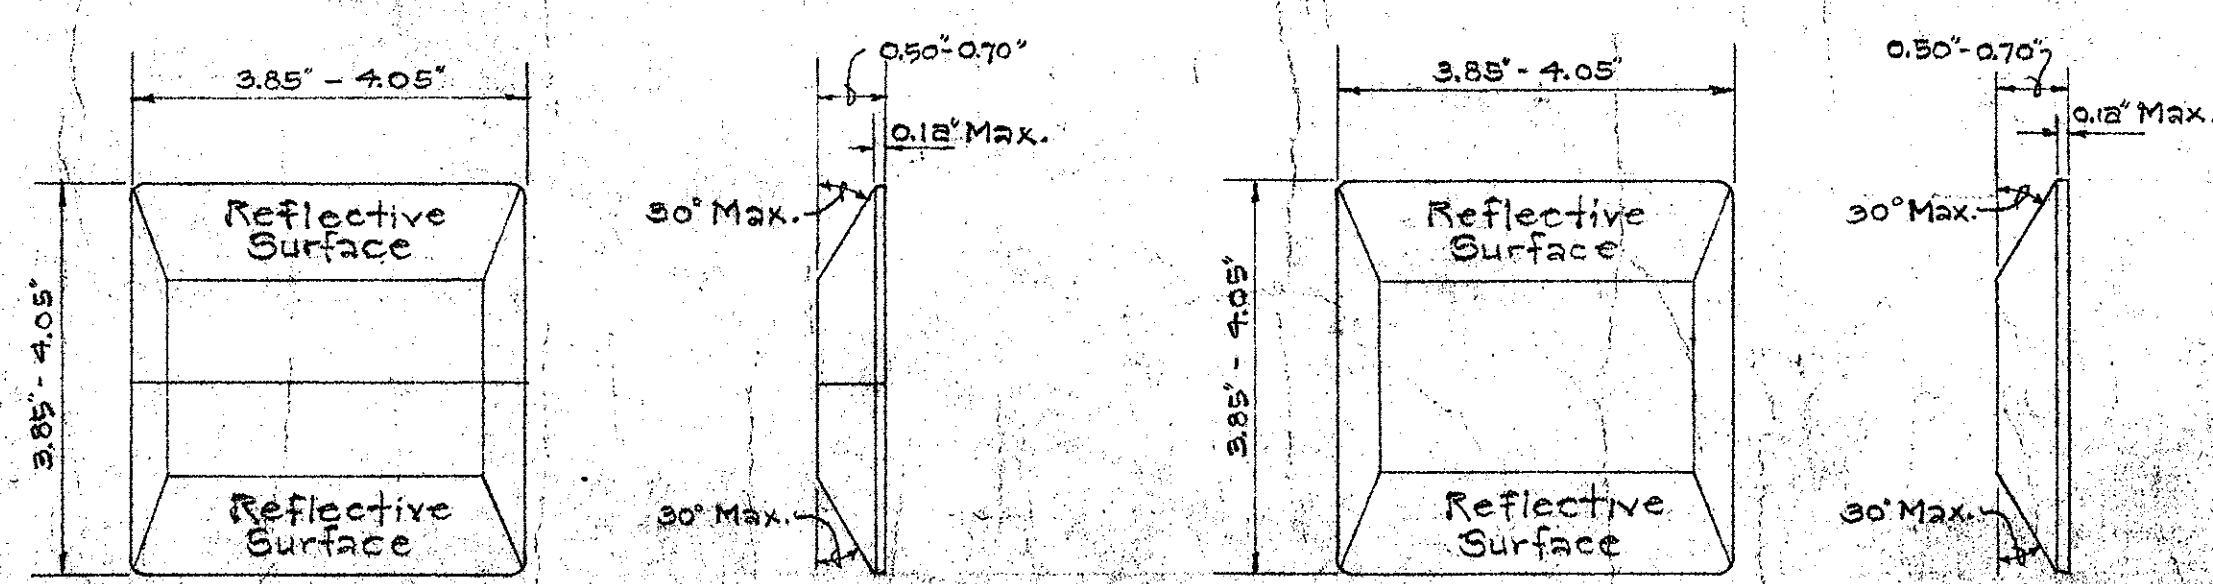

TYPE 'C' TYPE 'D'
Not to Scale Not to Scale

THIS WORK WAS PREPARED BY ME OR UNDER MY SUPERVISION

Signature: *[Signature]* 10-1-73

BRUCE L. GRAY
REGISTERED PROFESSIONAL ENGINEER
No. 1552
HAWAII, U.S.A.

REVISION	DATE	DESCRIPTION	BY	APPROVED
1	10/1/73	Additional signs and pavement markings	GRAY	10/1/73

GRAY, RHEE & ASSOCIATES, INC.
CONSULTING ENGINEERS
118 S. KING ST.
HONOLULU, OAHU, HAWAII

HAWAII LOA RIDGE
JUGHANDLE INTERSECTION
AND DRAIN OUTLET
WAILUPE AND NUI, HONOLULU, OAHU, HAWAII

TRAFFIC SIGNAL, SIGN AND PAVEMENT MARKING PLAN

ENGINEER: *[Signature]* DRAWN BY: *[Signature]* CHECKED BY: *[Signature]*

APPROVED BY: *[Signature]* DEPUTY DIRECTOR, DEPT. OF TRANSPORTATION SERVICES, HAWAII