



TOP VIEW

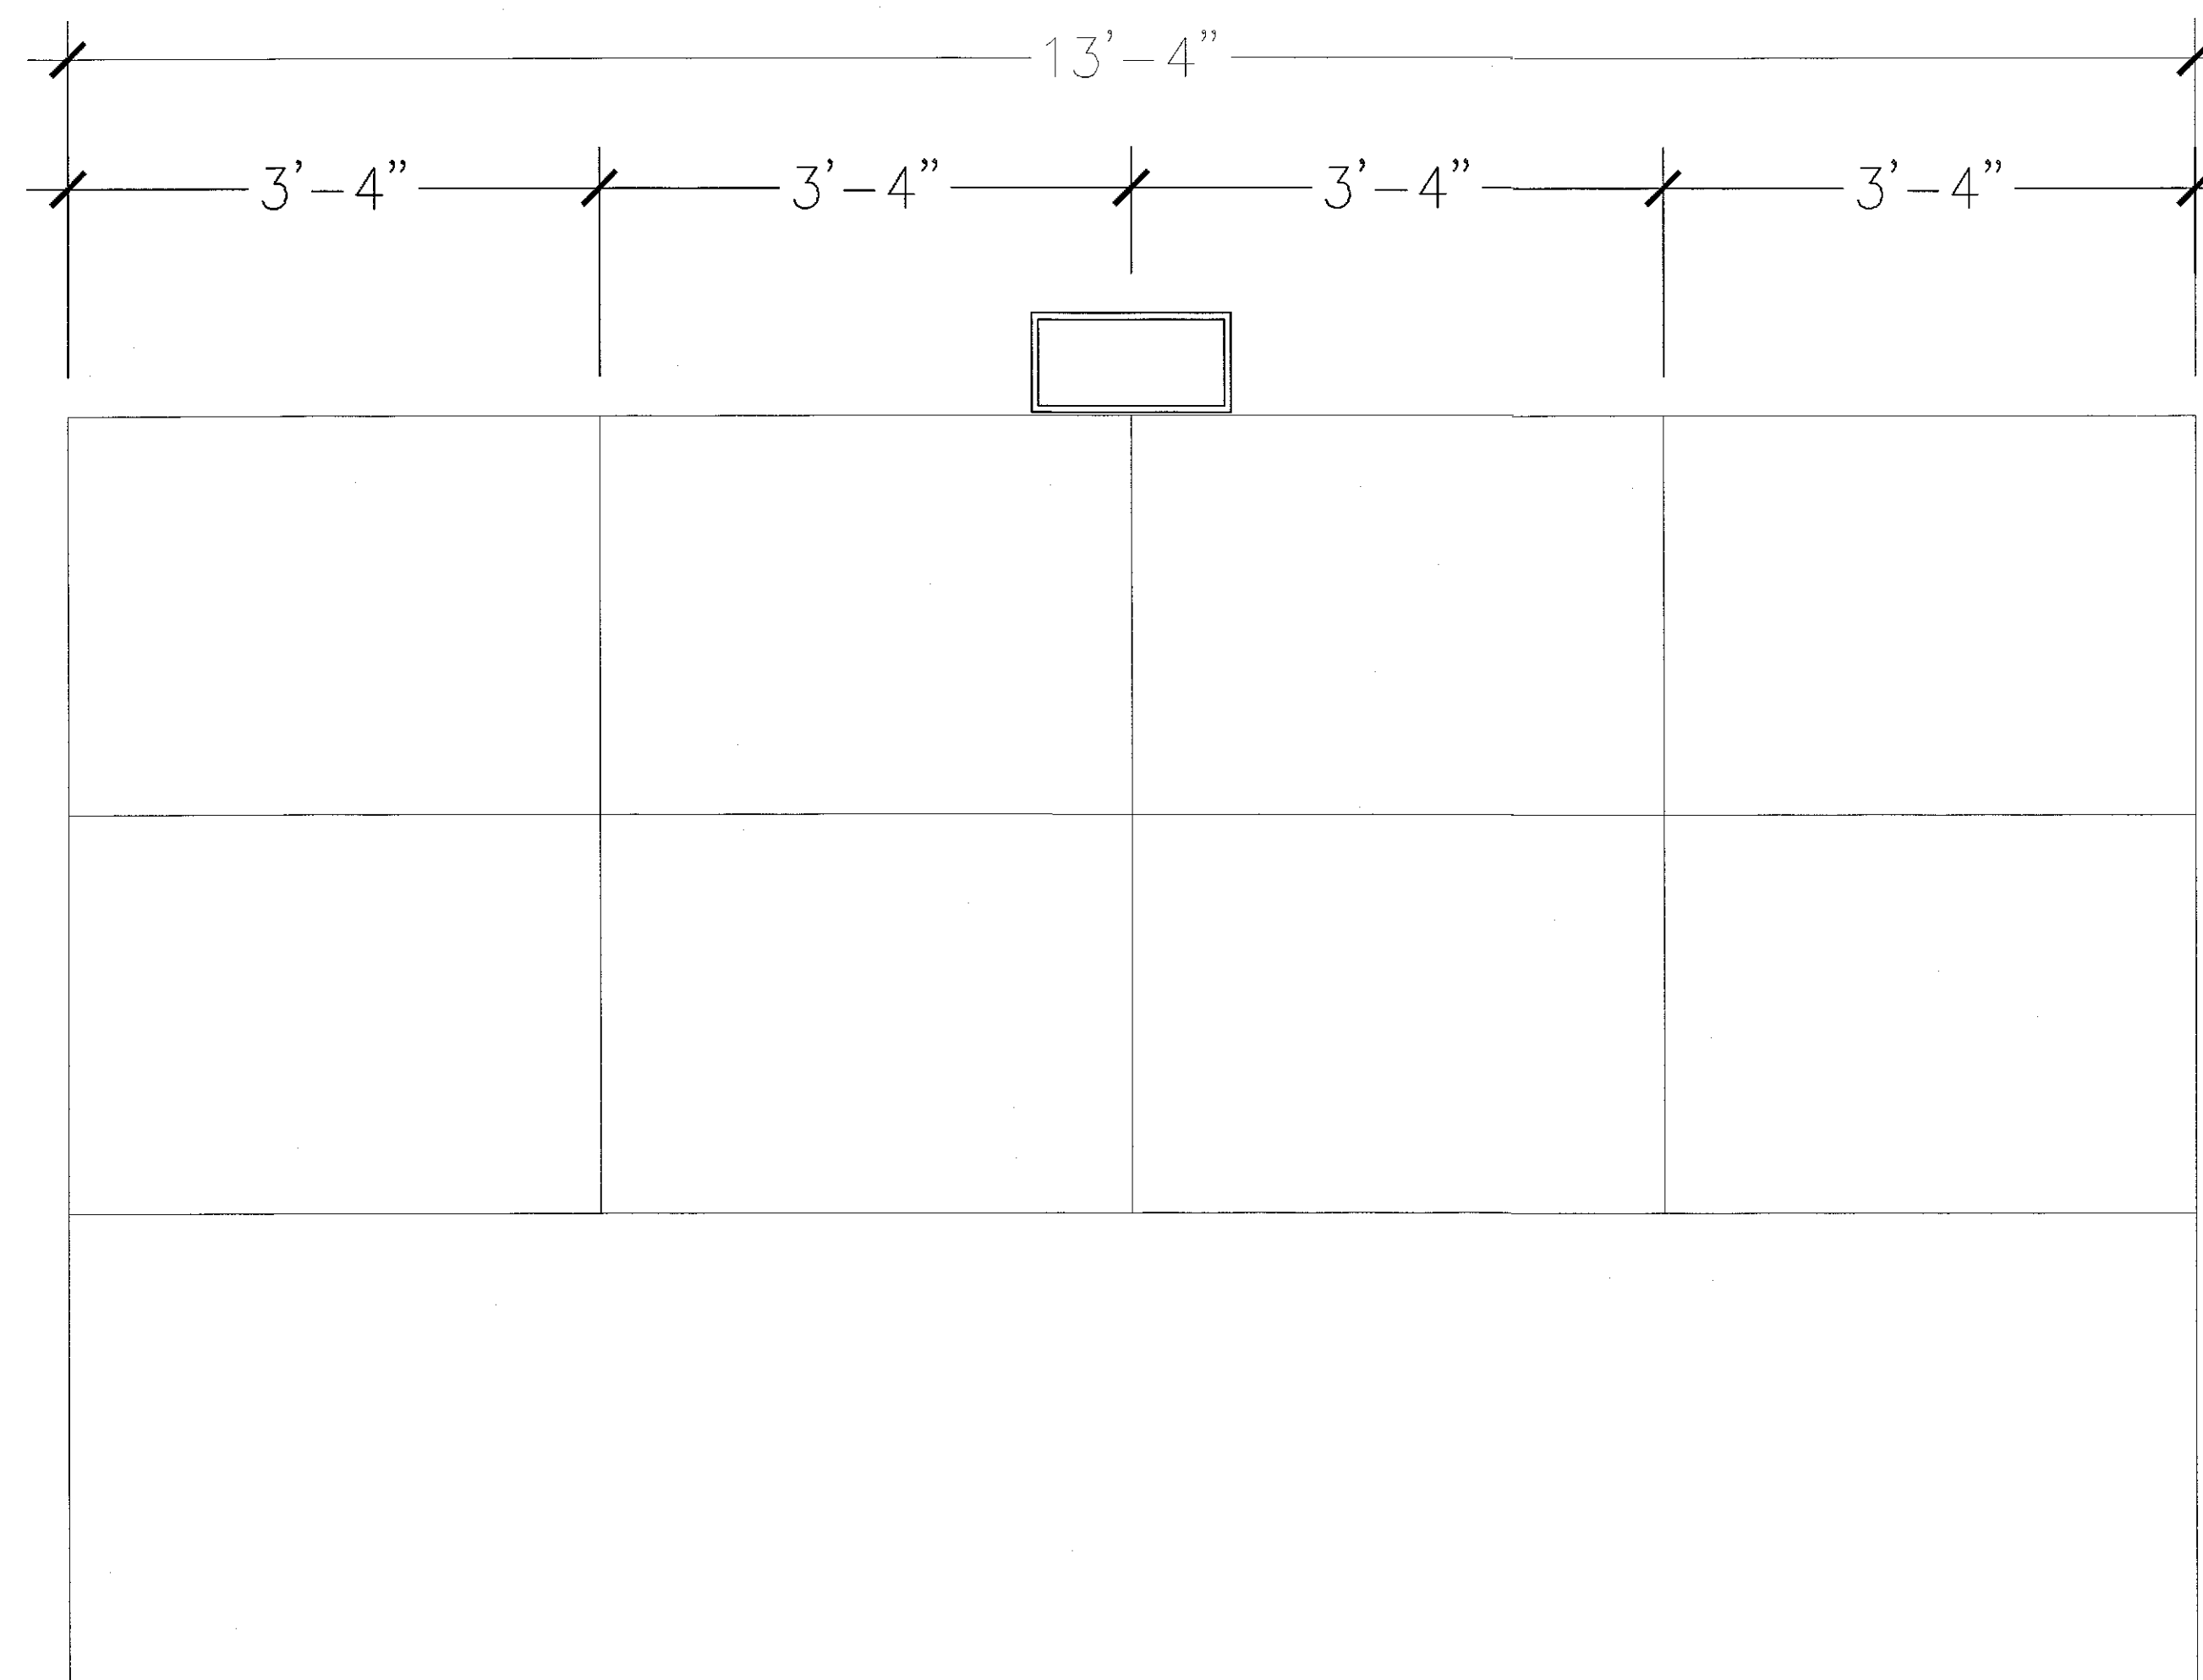

FRONT VIEW

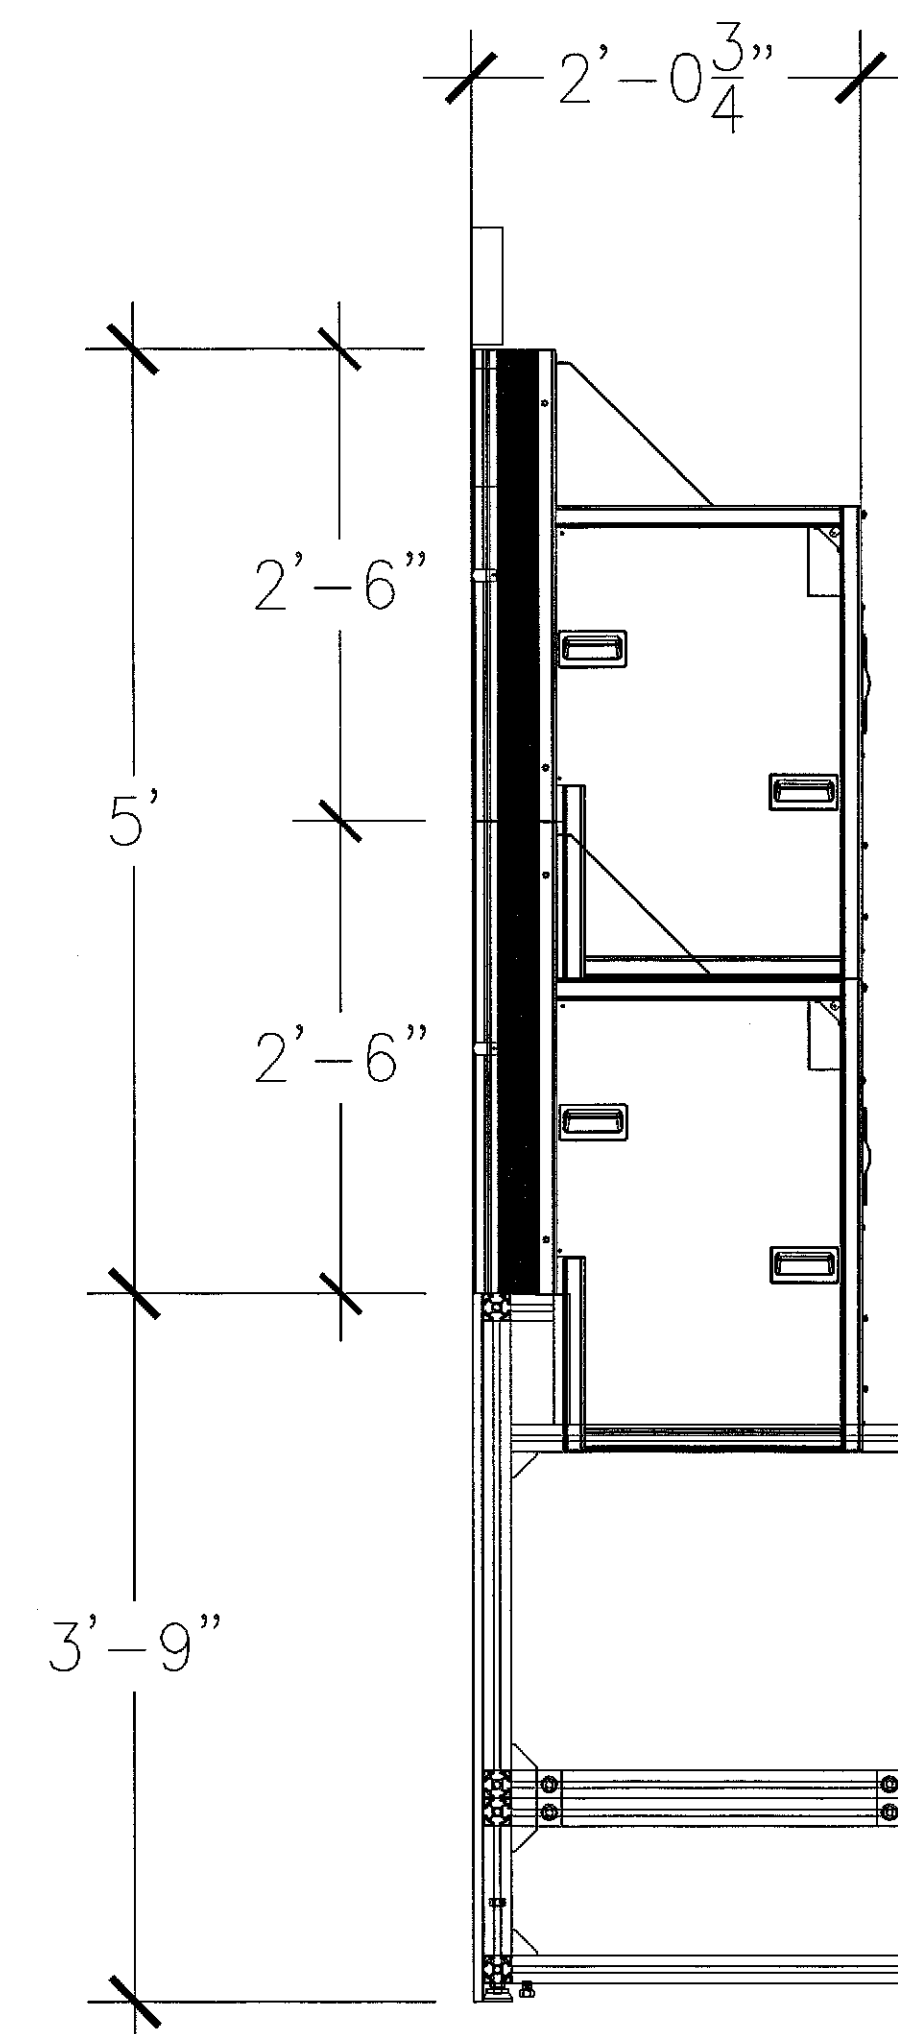

SIDE VIEW

The Audio Visual Company
Since 1970
System Design & Integration

AS-BUILT

1 VIDEO WALL LAYOUT
SCALE: NTS

Notice: This Drawing is the property of The Audio Visual Company. All Information contained herein that is not generally known shall be confidential except to the extent the Information has been previously established. This Drawing may not be reproduced, copied or used as the basis for manufacture or sale without a written permission.

CONTRACT NO. IM-0300(118)-R		THE AUDIO VISUAL COMPANY 98-810 MOANALUA RD. AIEA, HI. 96701 PHONE: 808.485.3200 FAX: 808.487.0733	
APPROVALS	DATE	FREEWAY MANAGEMENT SYSTEM PHASE 1B	
DRAWN JL	11/19/12	TRAFFIC OPERATIONS CENTER UNIT 5A	
CHECKED		SIZE	FILE NAME
REVISED DATE		D	DISPLAY
APPROVED BY		DRAWING NO.	REV
UNIT INCH CM		AVC0 1.02	B
SCALE		SHEET OF	