



1 2 3 4 5 6 7 8 9 10

I
H
G
F
E
D
C
B
A

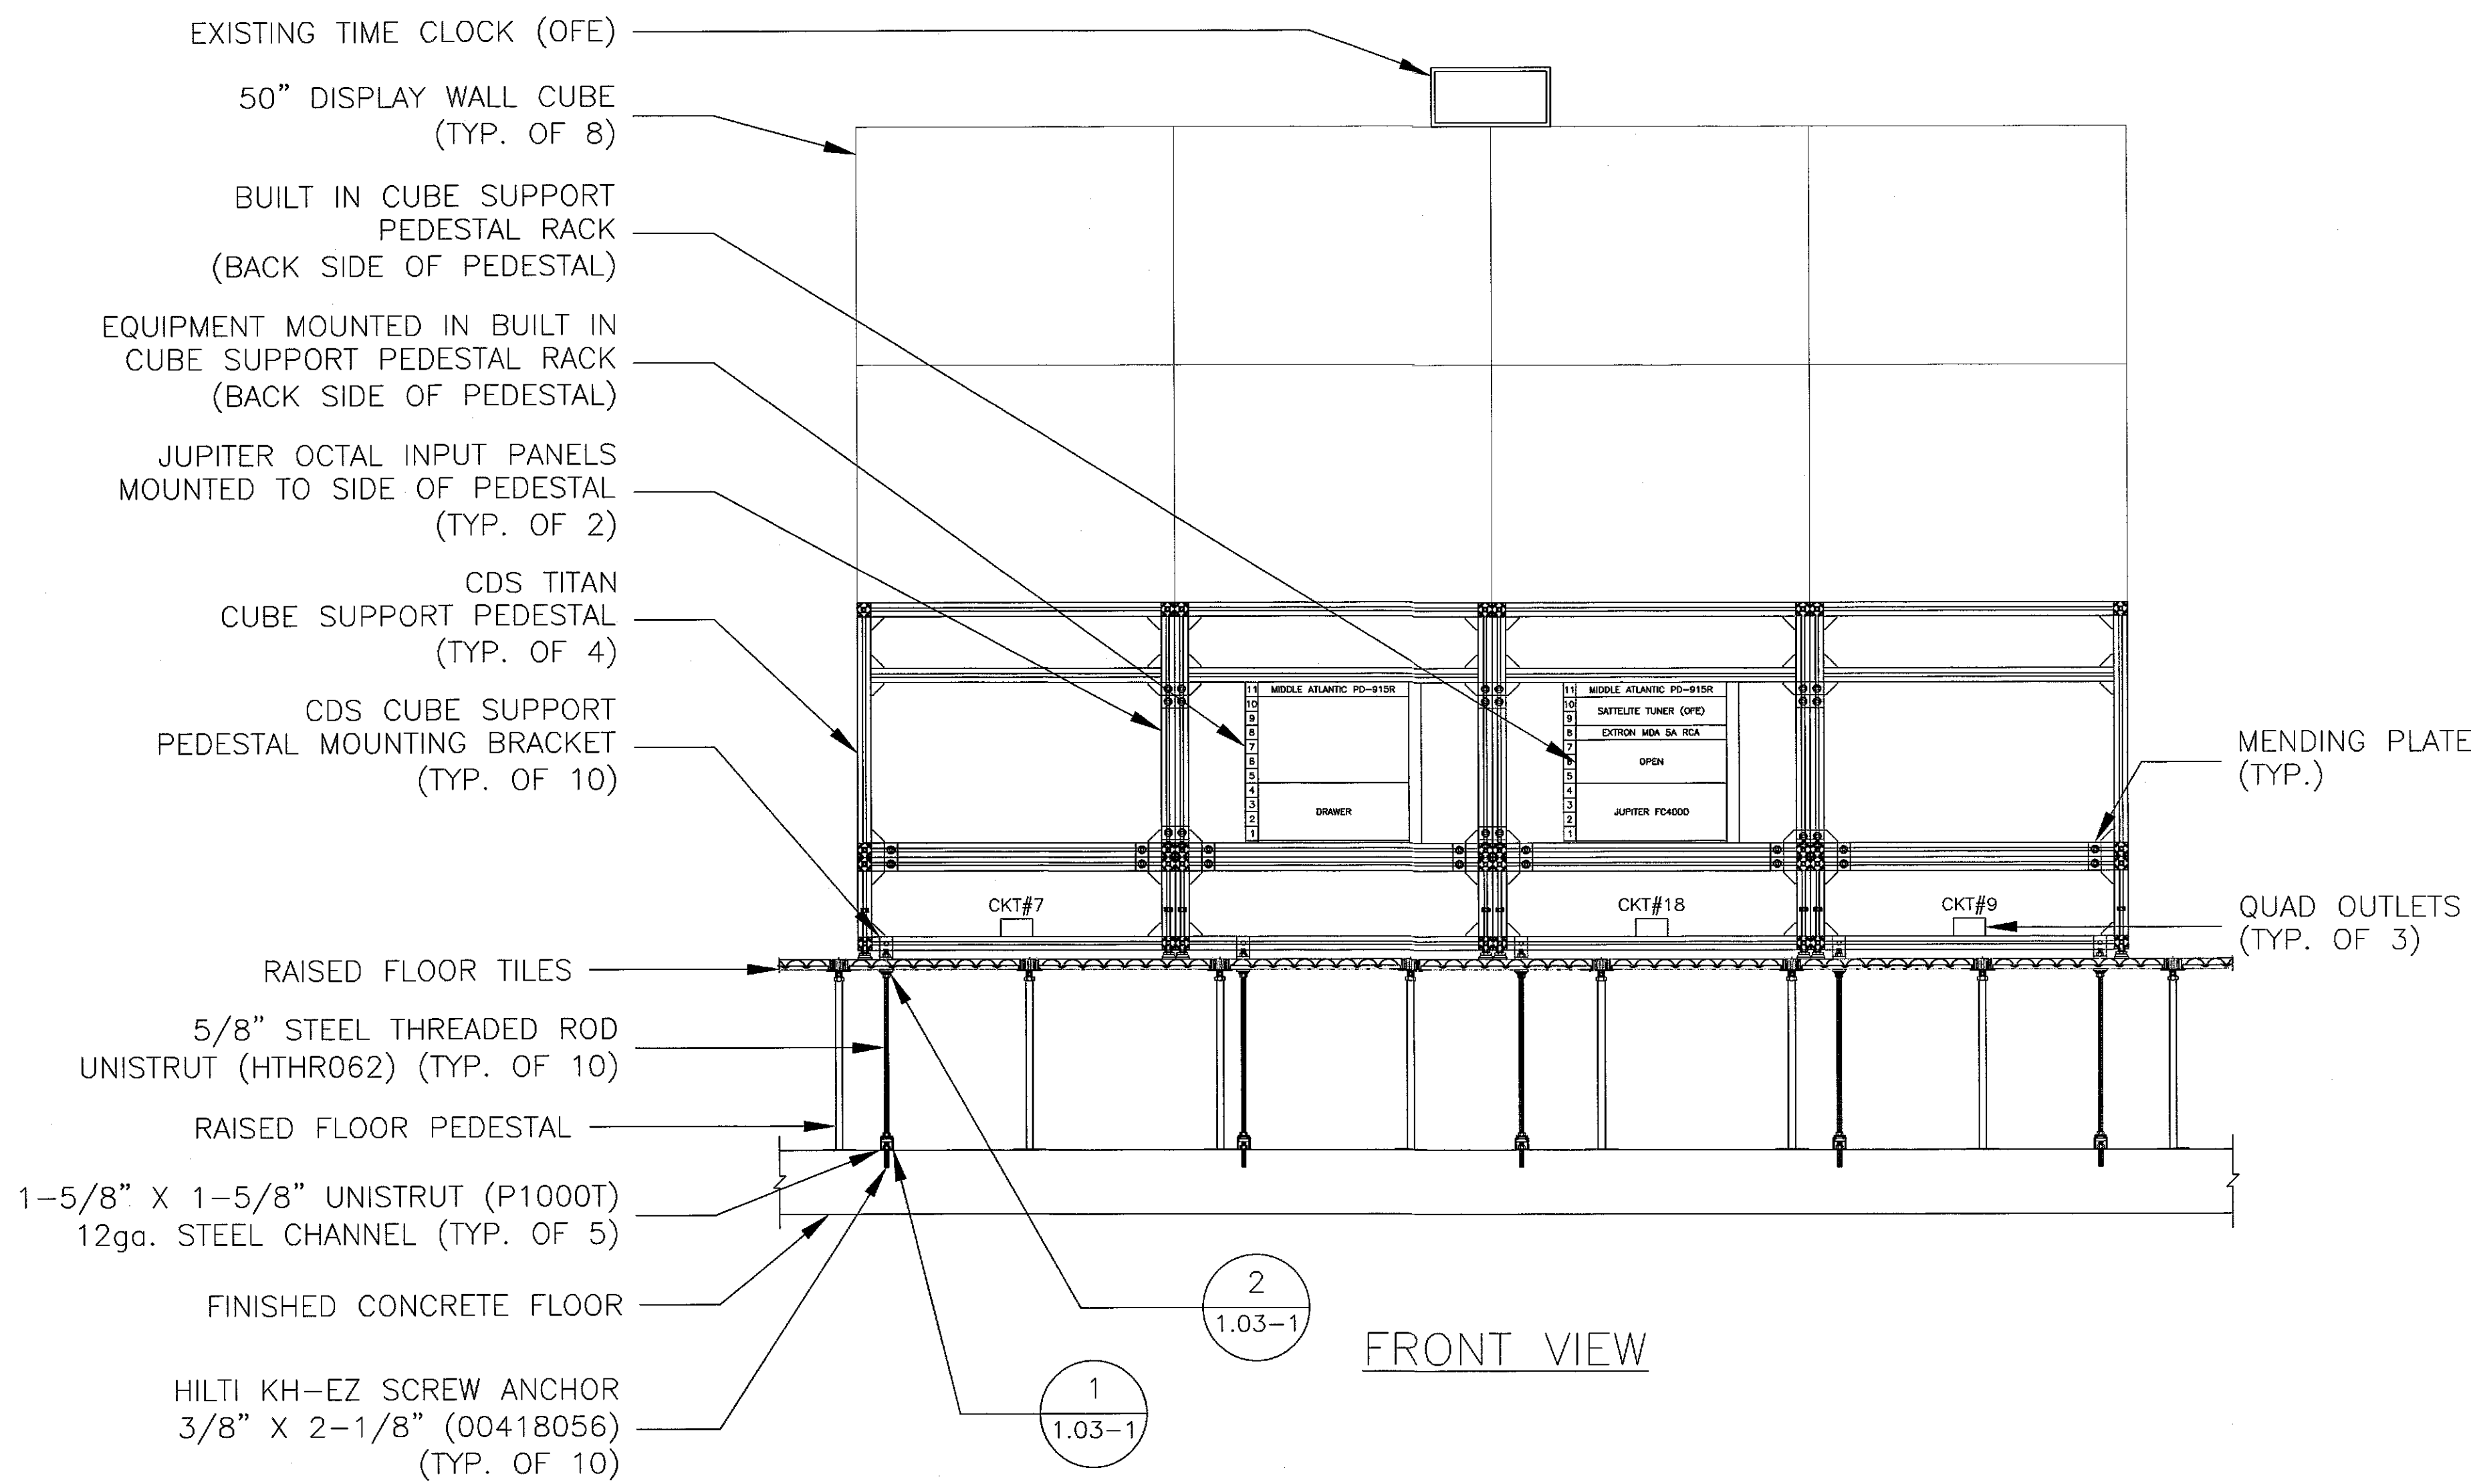

FRONT VIEW

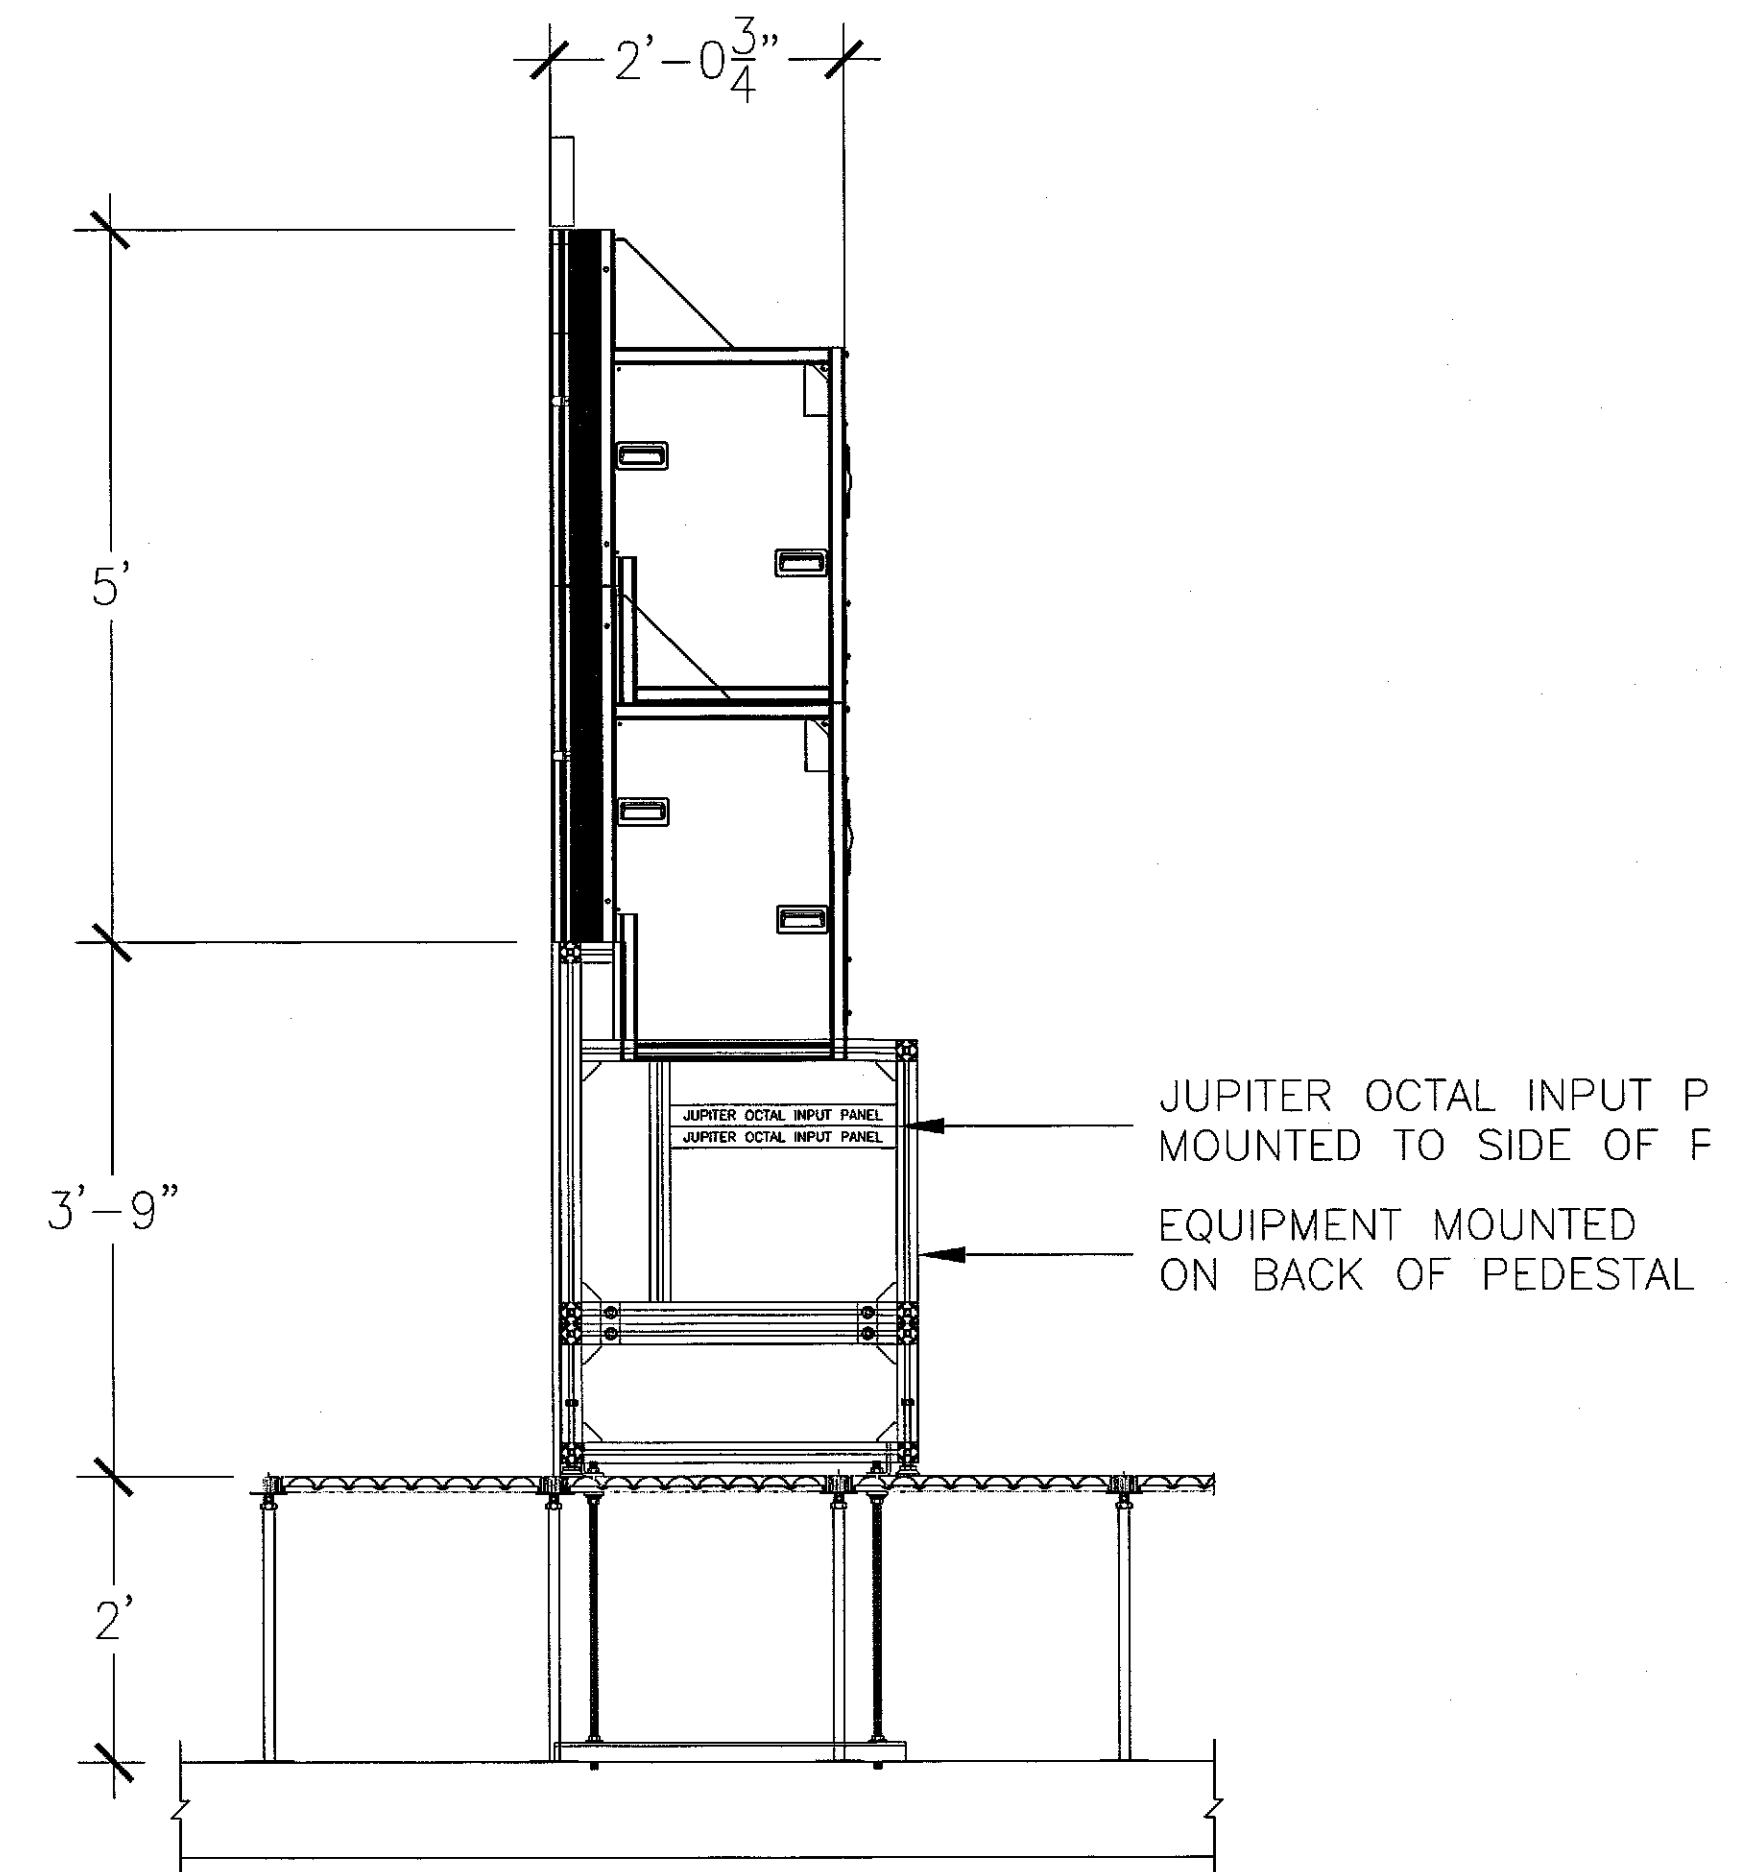

SIDE VIEW

1 VIDEO WALL MOUNTING DETAIL
SCALE: NTS

AS-BUILT

The Audio
Visual Company
System Design & Integration

Notice: This Drawing is the property of
The Audio Visual Company. All Information
contained herein that is not generally known
shall be confidential except to the extent the
Information has been previously established.
This Drawing may not be reproduced, copied
or used as the basis for manufacture or
sale without a written permission.

| | | |
|--------------------|----------------|--|
| CONTRACT NO. | IM-0300(118)-R | THE AUDIO VISUAL COMPANY 98-810 MOANALUA RD. AIEA, HI. 96701 PHONE: 808.485.3200 FAX: 808.487.0733 |
| APPROVALS | DATE | |
| DRAWN | JL | 11/19/12 |
| CHECKED | | |
| REVISED DATE | JL | 8/13/13 |
| APPROVED BY: | | |
| UNIT INCH CM | SCALE | FILE NAME DRAWING NO. REV |
| | | D MOUNTING DETAIL AVCO 1.03 G |
| | | SHEET OF |