


1 SECURING UNISTRUT TO CONCRETE FLOOR
SCALE: NTS

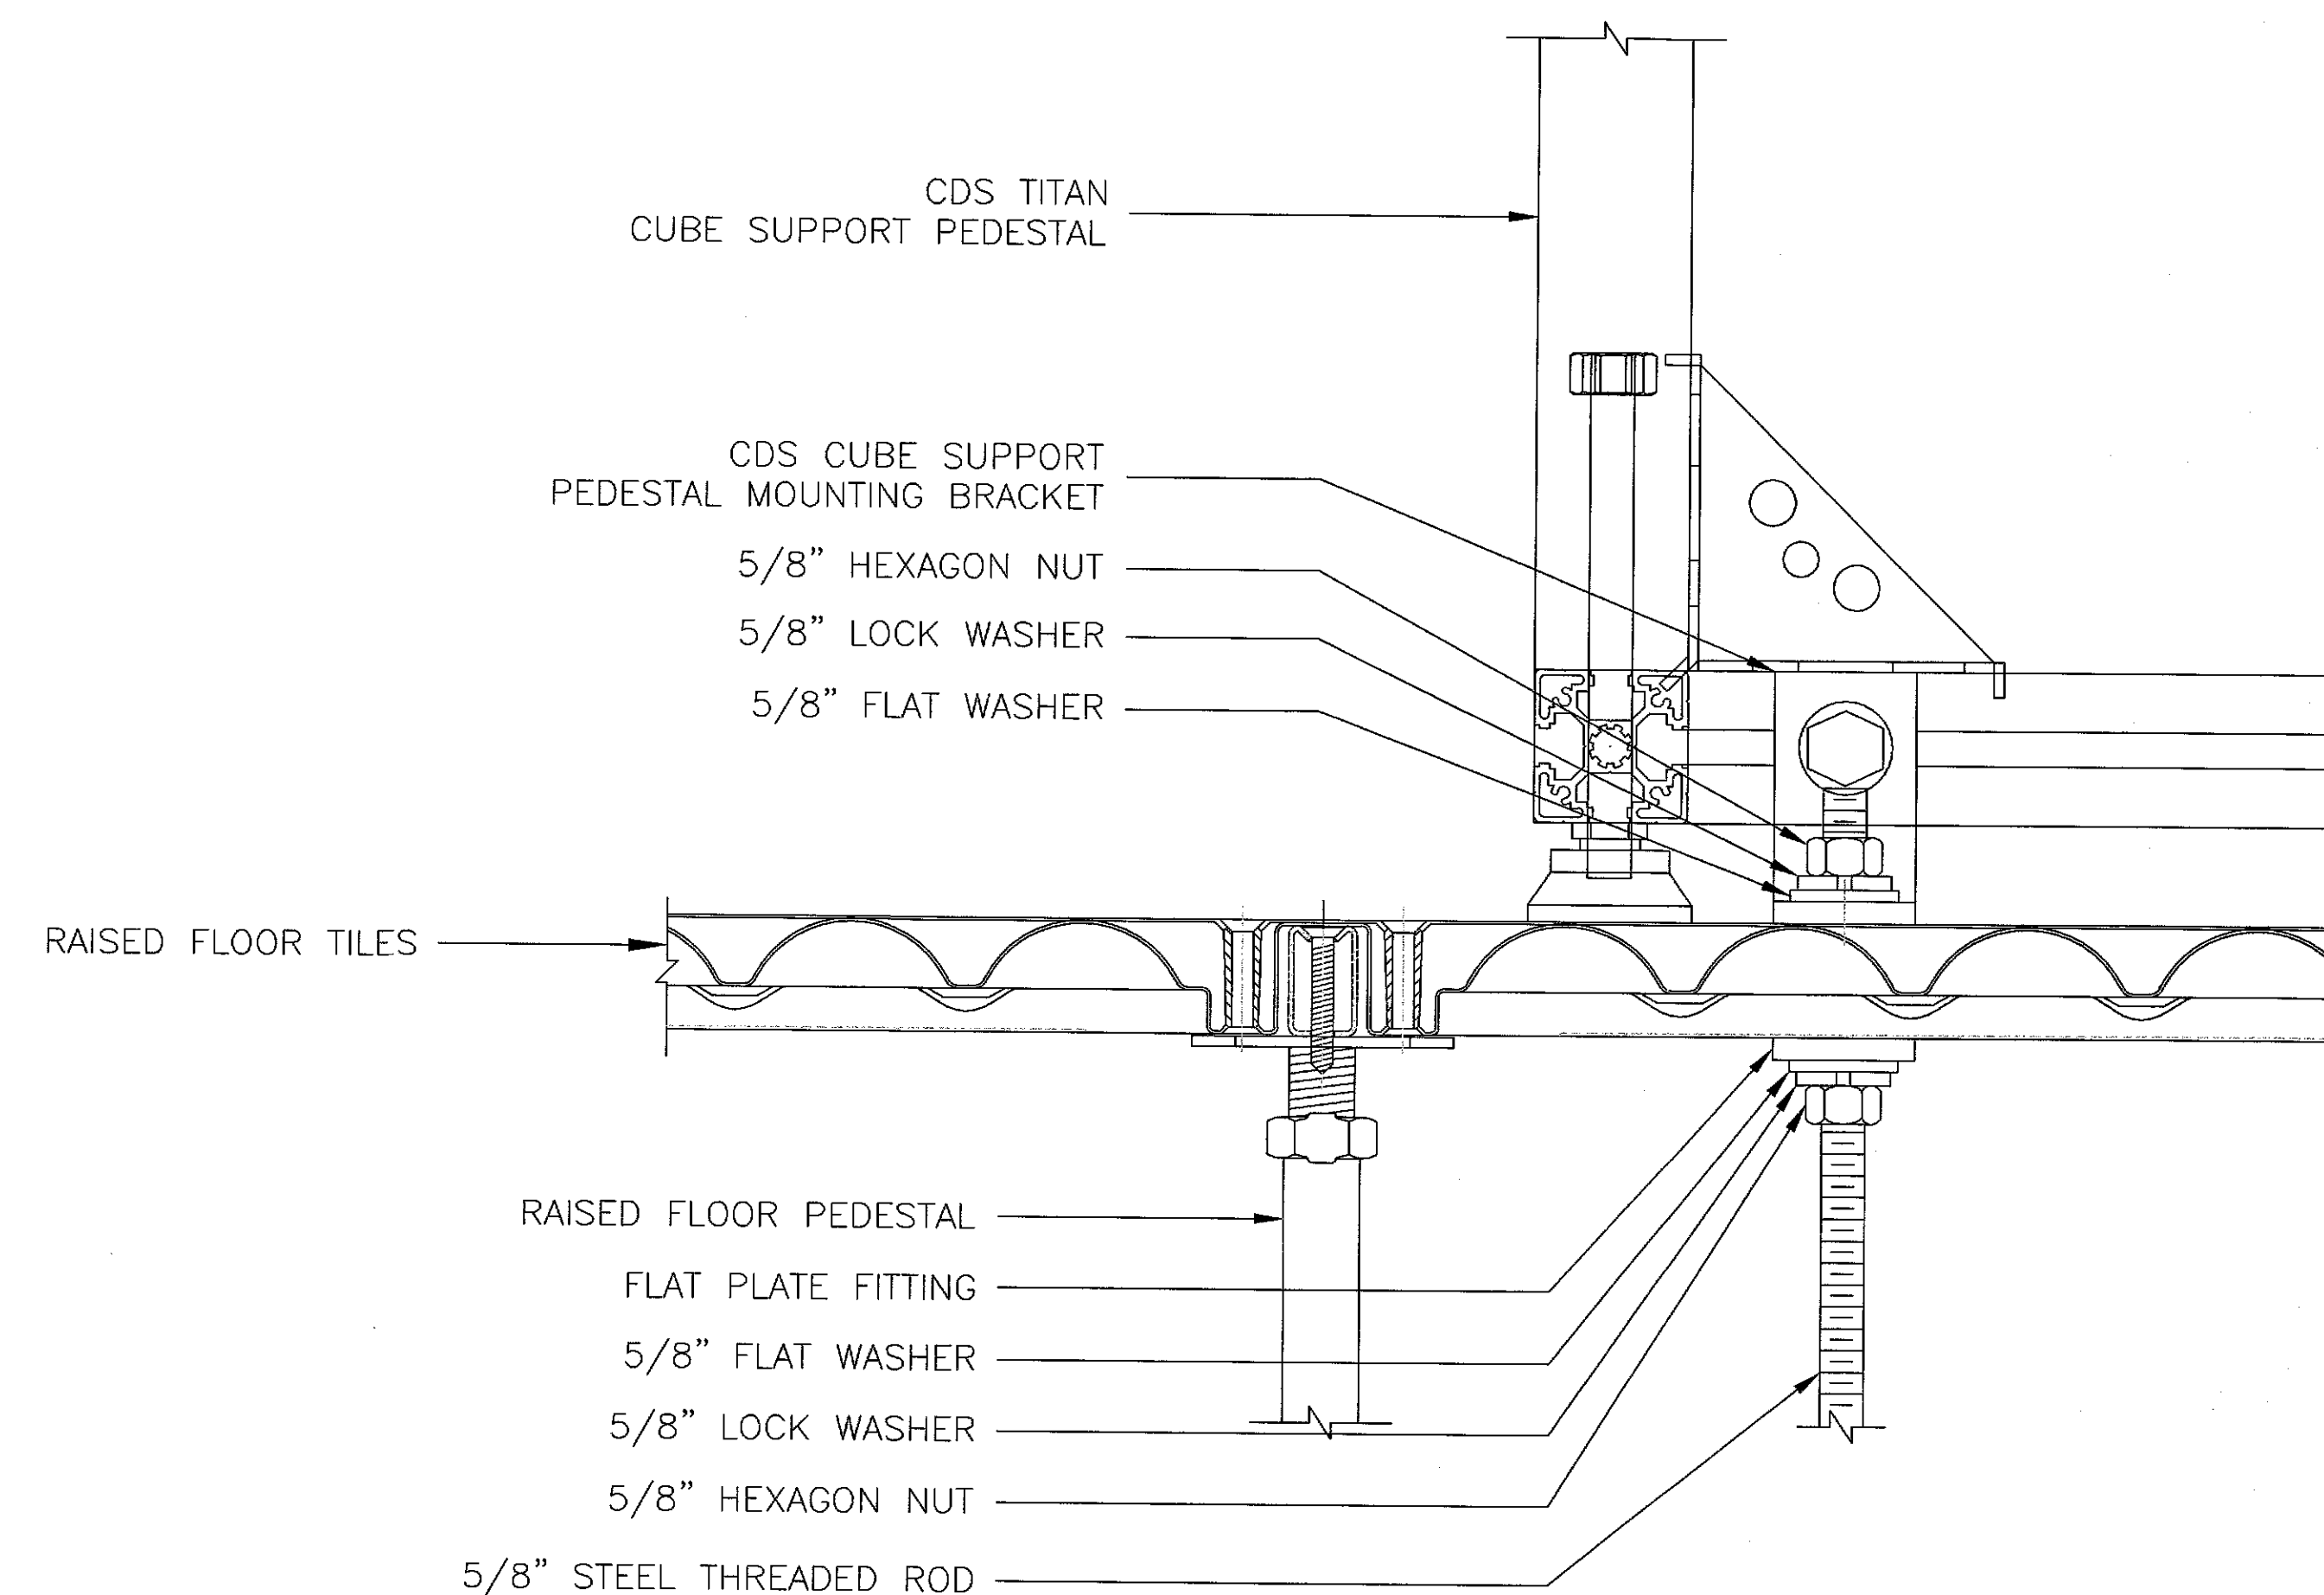

2 SECURING PEDESTAL TO CONCRETE FLOOR
SCALE: NTS

LEGEND

DESCRIPTION	MANUFACTURER	PART NUMBER
1-5/8" X 1-5/8" 12 GUAGE CHANNEL STRUT	UNISTRUT	P1000T
5/8" HEXAGON NUT	UNISTRUT	HHXN062EG
5/8" LOCK WASHER	UNISTRUT	HLKW062EG
5/8" FLAT WASHER	UNISTRUT	HFLW062EG
CHANNEL NUT W/SPRING	UNISTRUT	P1012S
FLAT PLATE FITTING	UNISTRUT	P1964
5/8" THREADED ROD	UNISTRUT	HTHR062
3/8" X 2-1/8" KH-EZ SCREW ANCHOR	HILTI	00418056

AS-BUILT

The Audio Visual Company
Since 1970
System Design & Integration

Notice: This Drawing is the property of The Audio Visual Company. All Information contained herein that is not generally known shall be confidential except to the extent the Information has been previously established. This Drawing may not be reproduced, copied or used as the basis for manufacture or sale without a written permission.

CONTRACT NO.	IM-0300(118)-R	THE AUDIO VISUAL COMPANY 98-810 MOANALUA RD. AIEA, HI. 96701 PHONE: 808.485.3200 FAX: 808.487.0733
APPROVALS	DATE	
DRAWN	JL	3/4/13
CHECKED		
REVISED DATE:	JL	8/13/13
APPROVED BY:		
UNIT	FILE NAME	DRAWING NO.
INCH	D	TRAFFIC OPERATIONS CENTER UNIT 5A
CM	MOUNTING DETAIL	AVCO 1.03-1
SCALE		SHEET OF