


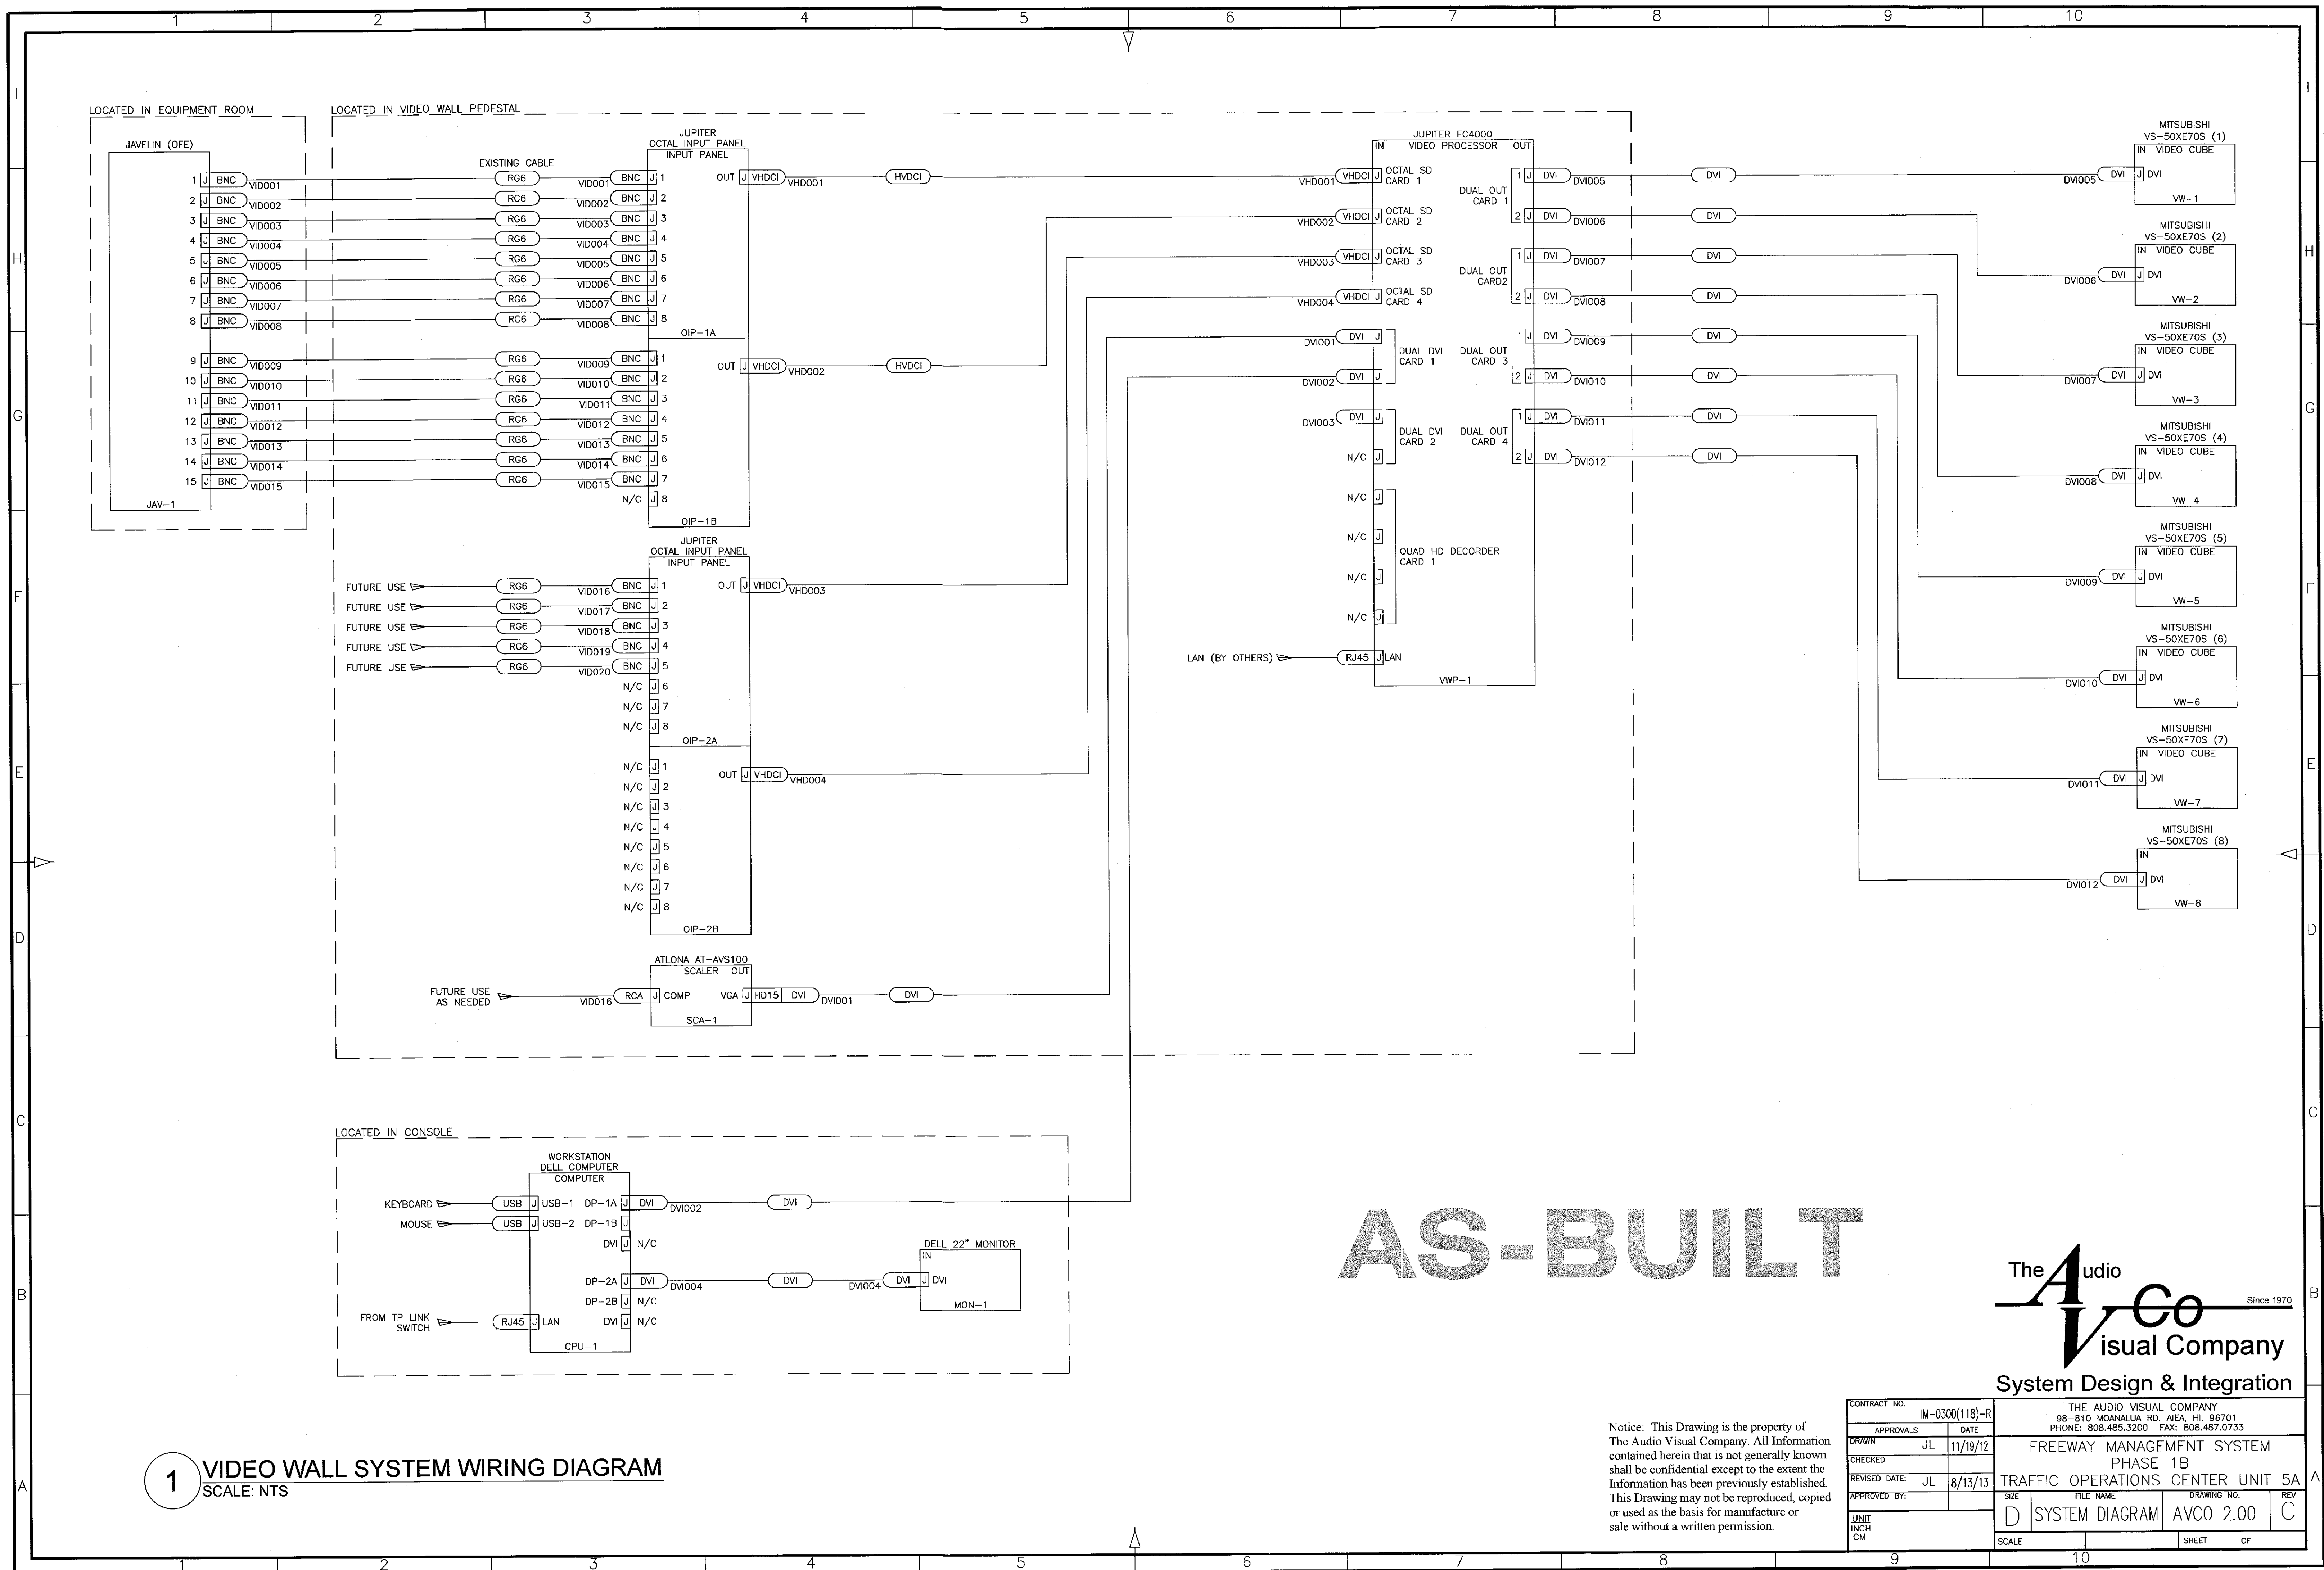

1 VIDEO WALL SYSTEM WIRING DIAGRAM
SCALE: NTS

AS-BUILT

The Audio Visual Company
Since 1970
System Design & Integration

Notice: This Drawing is the property of The Audio Visual Company. All Information contained herein that is not generally known shall be confidential except to the extent the Information has been previously established. This Drawing may not be reproduced, copied or used as the basis for manufacture or sale without a written permission.

CONTRACT NO.	IM-0300(118)-R	THE AUDIO VISUAL COMPANY	98-810 MOANALUA RD. AIEA, HI. 96701
APPROVALS	DATE	PHONE: 808.485.3200 FAX: 808.487.0733	
DRAWN	JL 11/19/12	FREEWAY MANAGEMENT SYSTEM	
CHECKED		PHASE 1B	
REVISED DATE:	JL 8/13/13	TRAFFIC OPERATIONS CENTER UNIT 5A	
APPROVED BY:		FILE NAME	DRAWING NO.
UNIT		D SYSTEM DIAGRAM	AVCO 2.00
INCH		SCALE	SHEET
CM			OF