

INDEX TO DRAWINGS	
SHEET NO.	DESCRIPTION
1	TITLE SHEET
2	TYPICAL SECTIONS
3-6	PLAN & PROFILE
7-10	DRIVEWAY & DRAINAGE DETAIL
11-12	STANDARD DETAILS
13-19	CROSS SECTIONS

STATE OF HAWAII
DEPARTMENT OF TRANSPORTATION
HIGHWAYS DIVISION
HONOLULU, HAWAII
"AS BUILT"
PLANS OF


KAENA POINT ROAD

KAENA POINT TOWARD MOKULEIA
FEDERAL AID PROJECT NO. S-O990(2)

DISTRICT OF WAIALUA
ISLAND OF OAHU

SCALE

PLAN 1 INCH = 50 FEET
PROFILE HOR. 1 INCH = 50 FEET
VER. 1 INCH = 5 FEET
CROSS SECTIONS HOR. 1 INCH = 10 FEET
VER. 1 INCH = 10 FEET

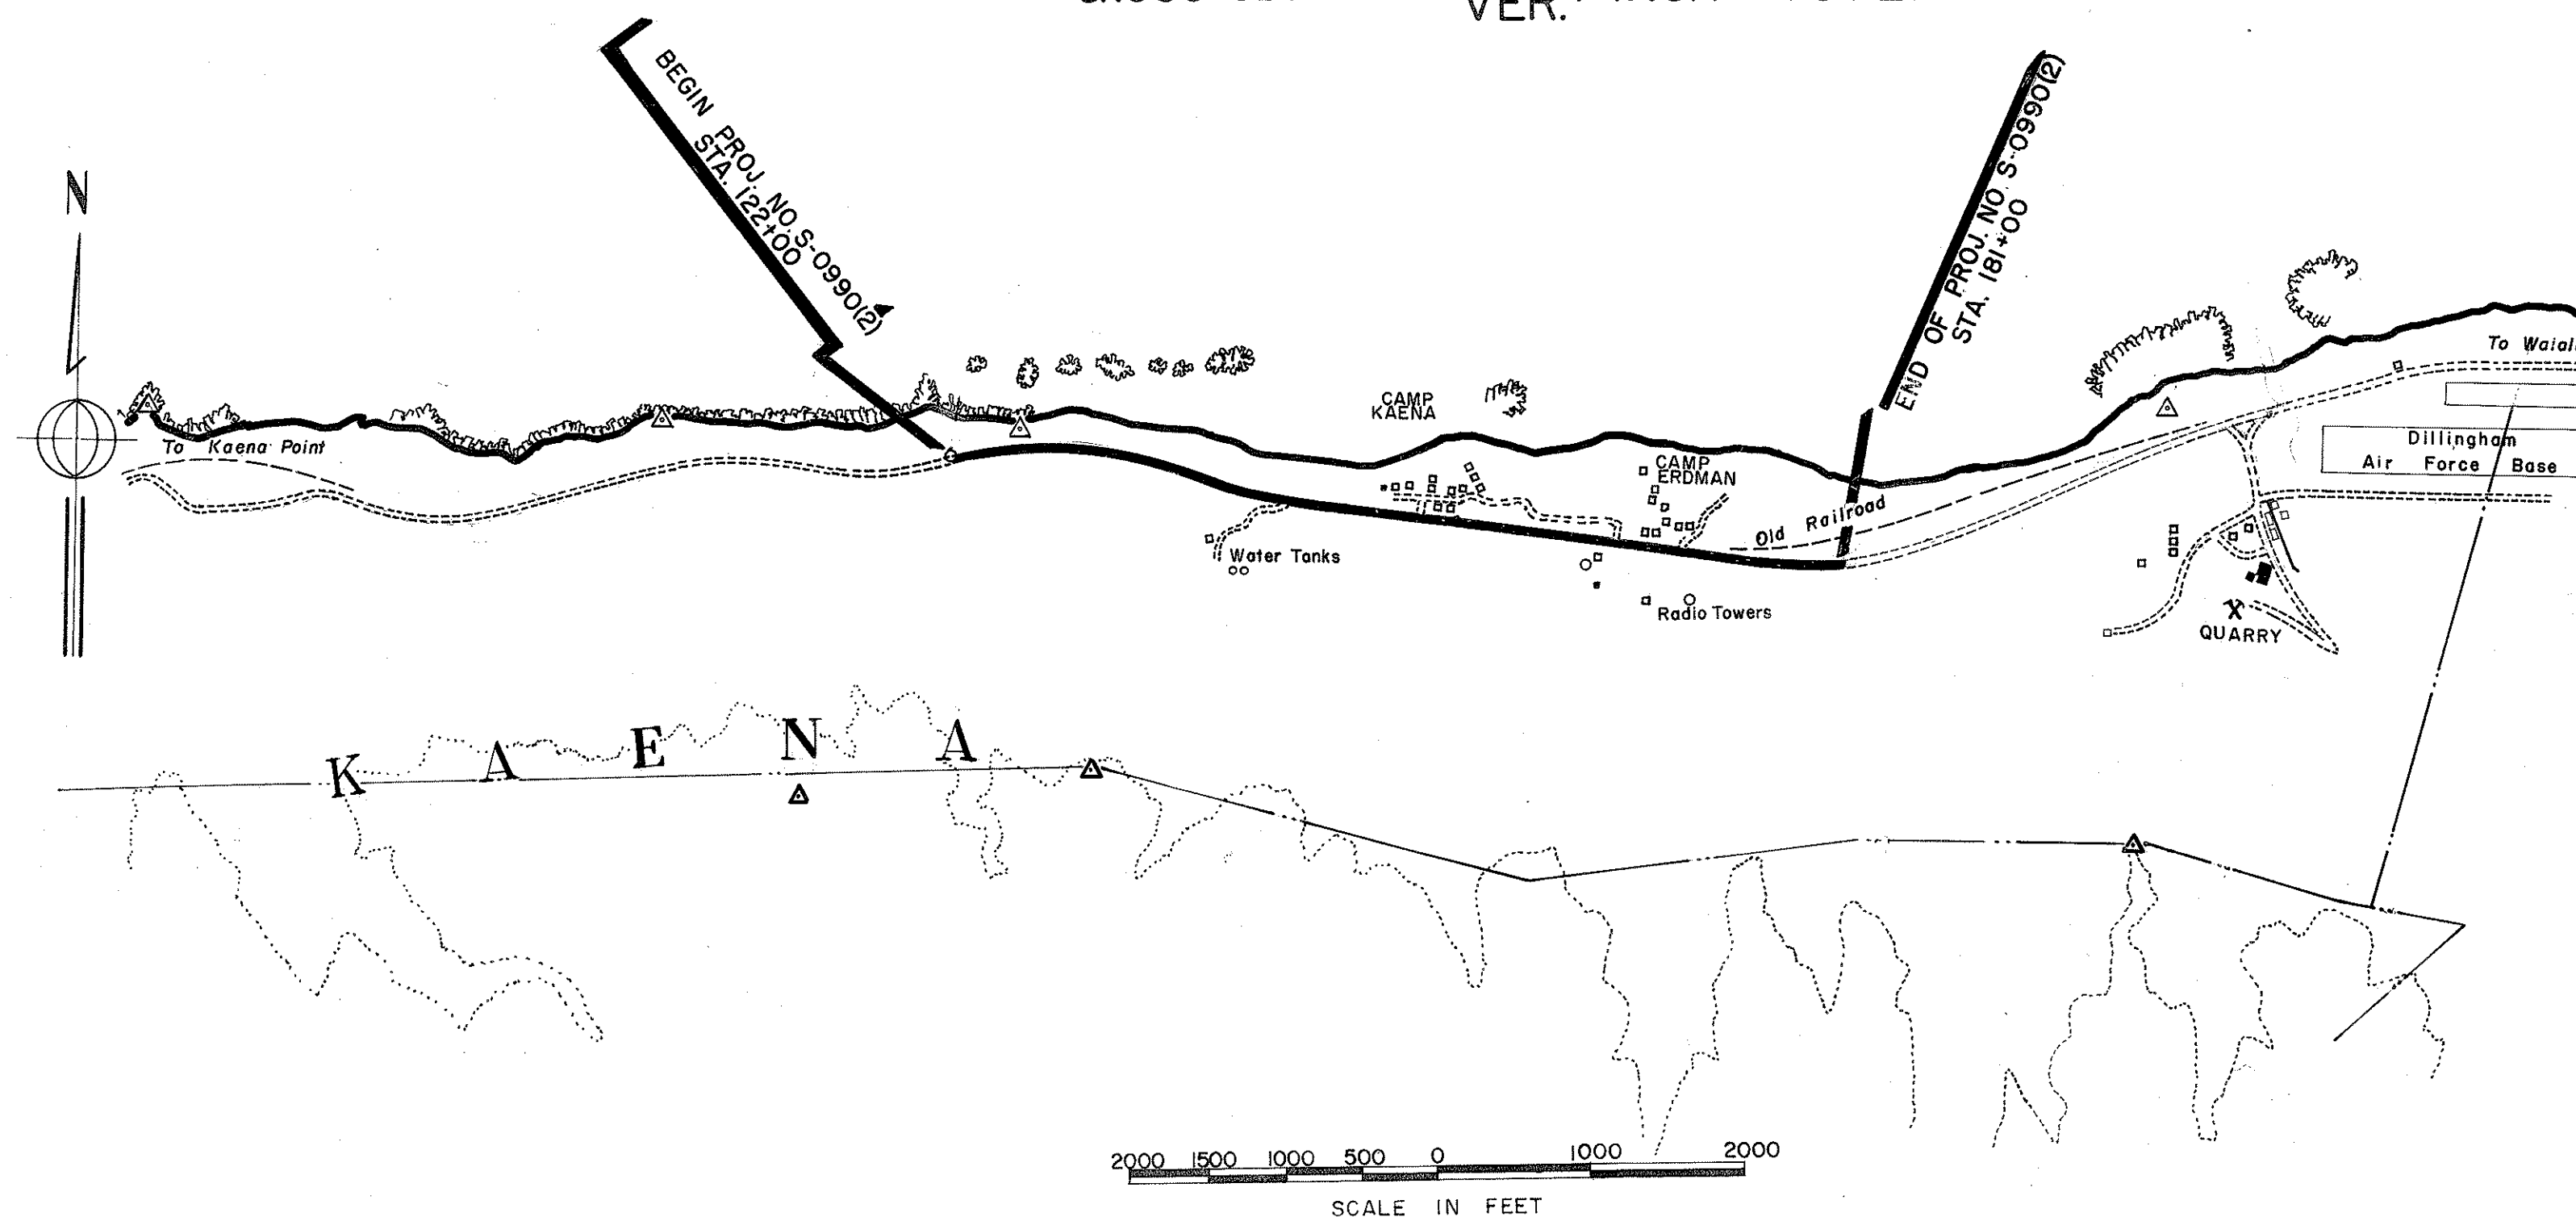


LAYOUT PLAN

GROSS & NET LENGTH OF PROJECT 1.117 MILES

FED. ROAD DIST. NO.	STATE	FED. AID PROJ. NO.	FISCAL YEAR	SHEET NO.	TOTAL SHEETS
HAWAII	HAW.	S-0990(2)	62-63	1	19

LOCATION OF PROJ. NO. S-0990(2)

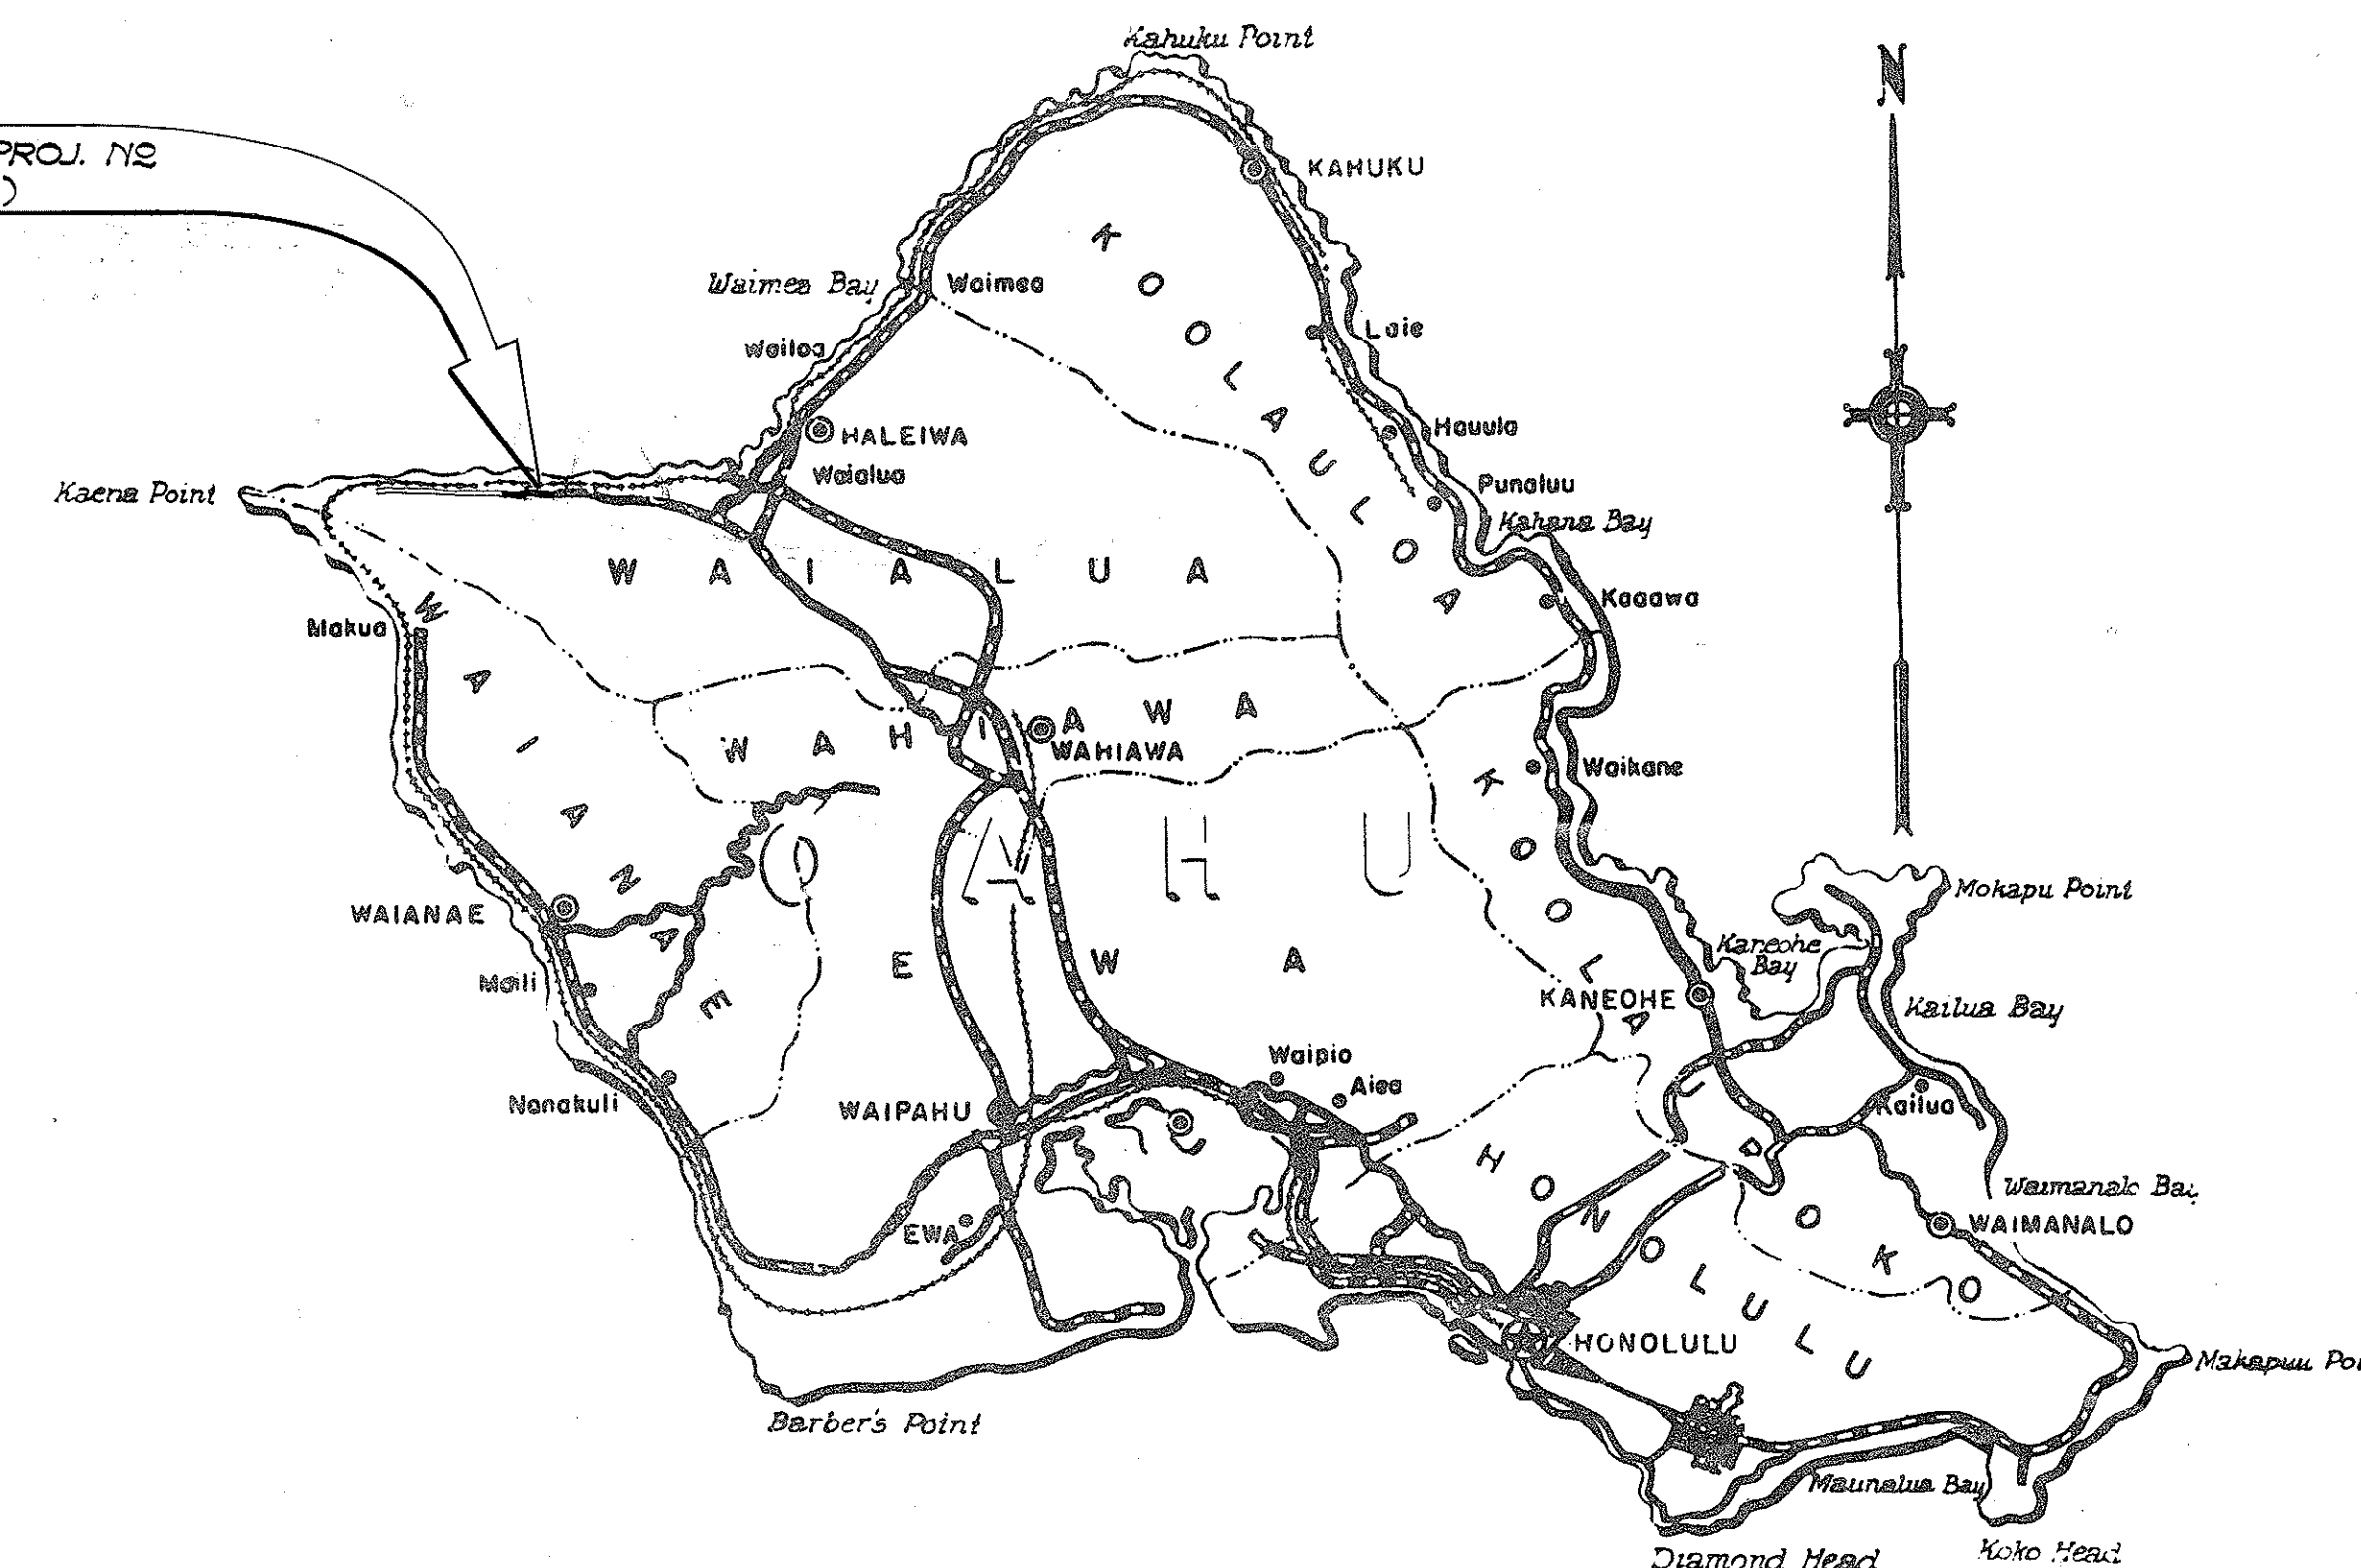

Federal Aid Projects Previously Constructed Or Under Construction

DESIGN CLASSIFICATION

ADT	1962	= 50
ADT	1982	= 800
DHV		= 12 %
D		= 55/45
T		= 13 %
V		= 50 MPH

NOTE: ALL CHANGES MADE DURING CONSTRUCTION ARE SHOWN IN RED ON THESE TRACINGS AND ARE CHECKED BY

George C. K. K.
PROJECT ENGINEER
July 30, 1964
DATE

APPROVED: DATE 1 May 63
Fujis Watanabe

DEPARTMENT OF COMMERCE
BUREAU OF PUBLIC ROADS
APPROVED:
DIVISION ENGINEER DATE

S 0 9 9 0 0 2 . 1

DD-H-3
SURVEY PLOTTED BY
DESIGNED BY
TRACED BY
QUANTITIES BY
CHECKED BY