


FED. ROAD DIST. NO.	STATE	FED. AID PROJ. NO.	FISCAL YEAR	SHEET NO.	TOTAL SHEETS
HAWAII	HAW.	STP-0300(43)	2002	10	12

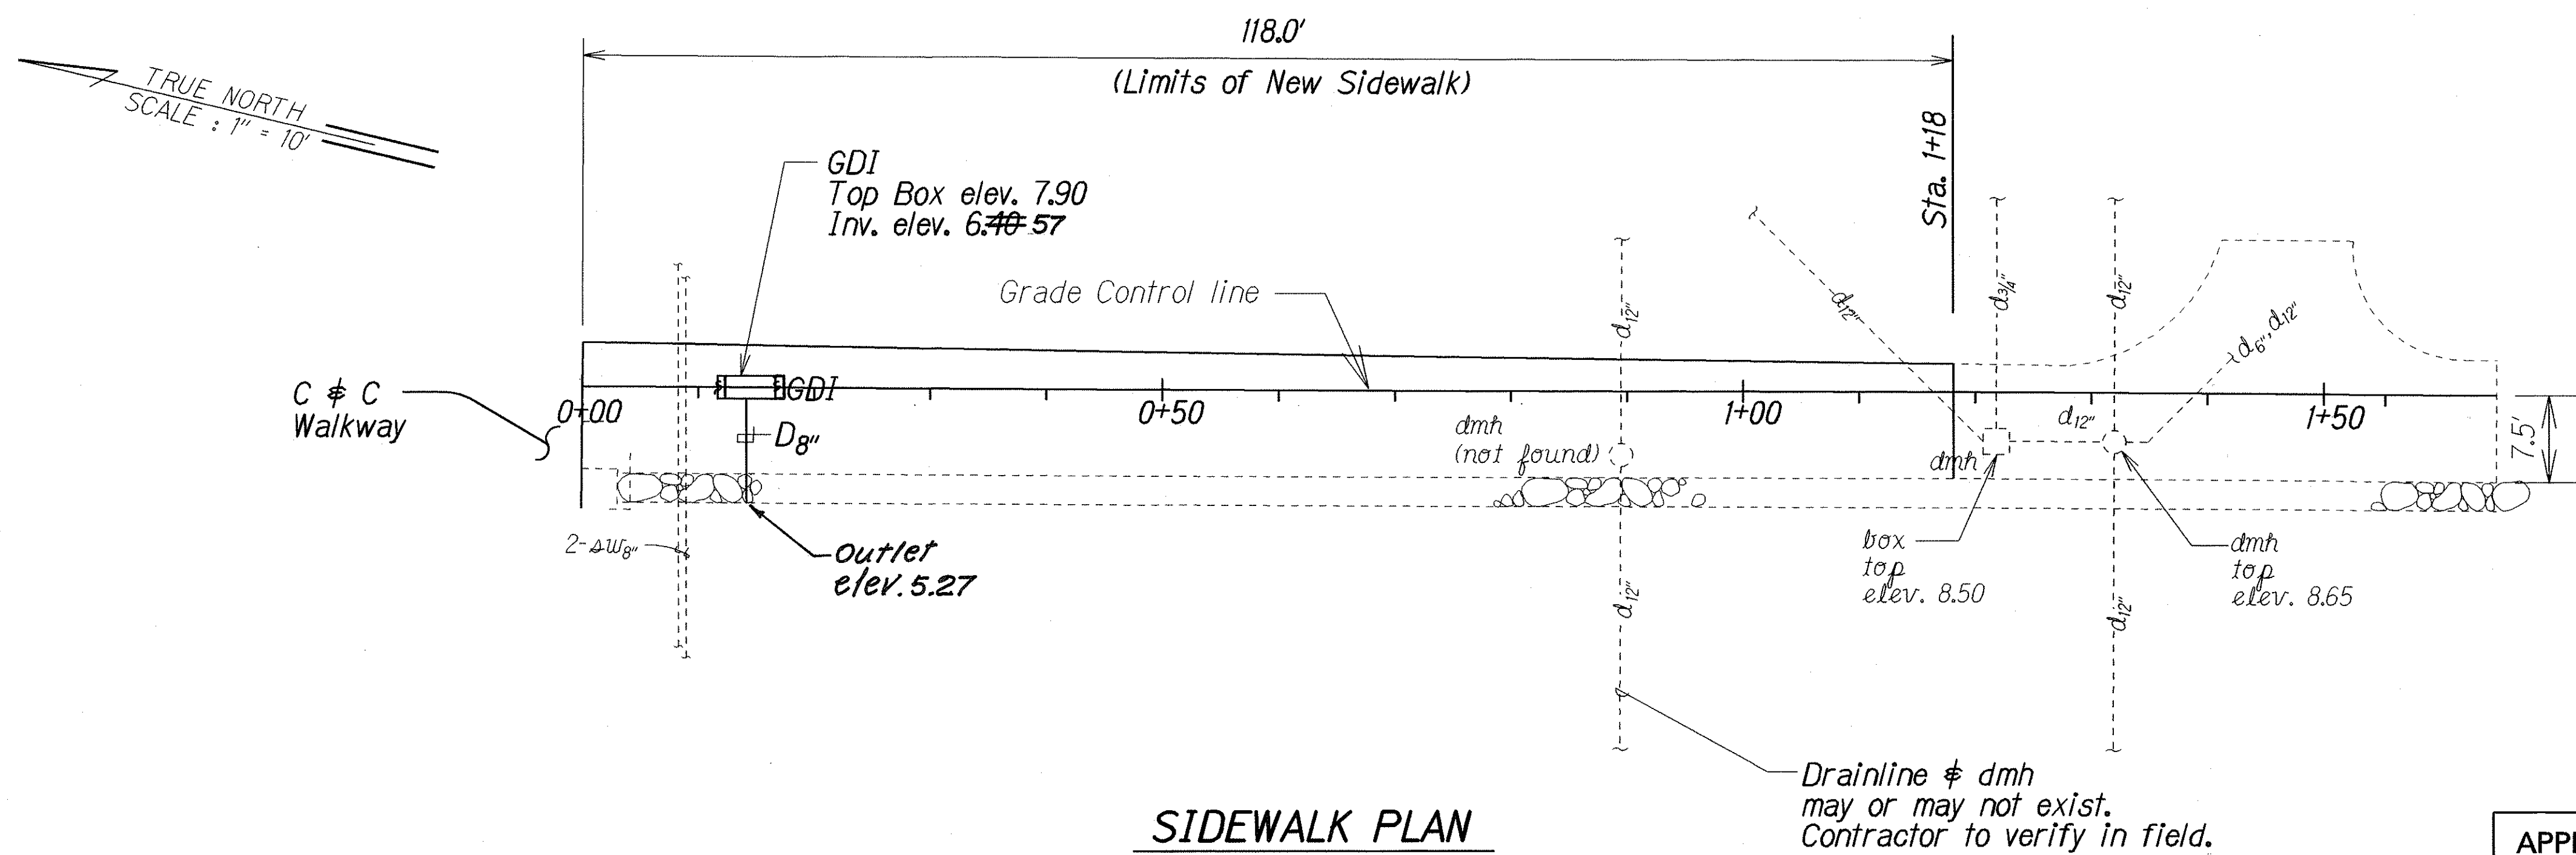


SIDEWALK PLAN
Scale: 1" = 10'

APPROVED:

Mano A. Rao
SENIOR VICE-PRESIDENT
FOR ADMINISTRATION
UNIVERSITY OF HAWAII
STATE OF HAWAII

11/14/01
DATE

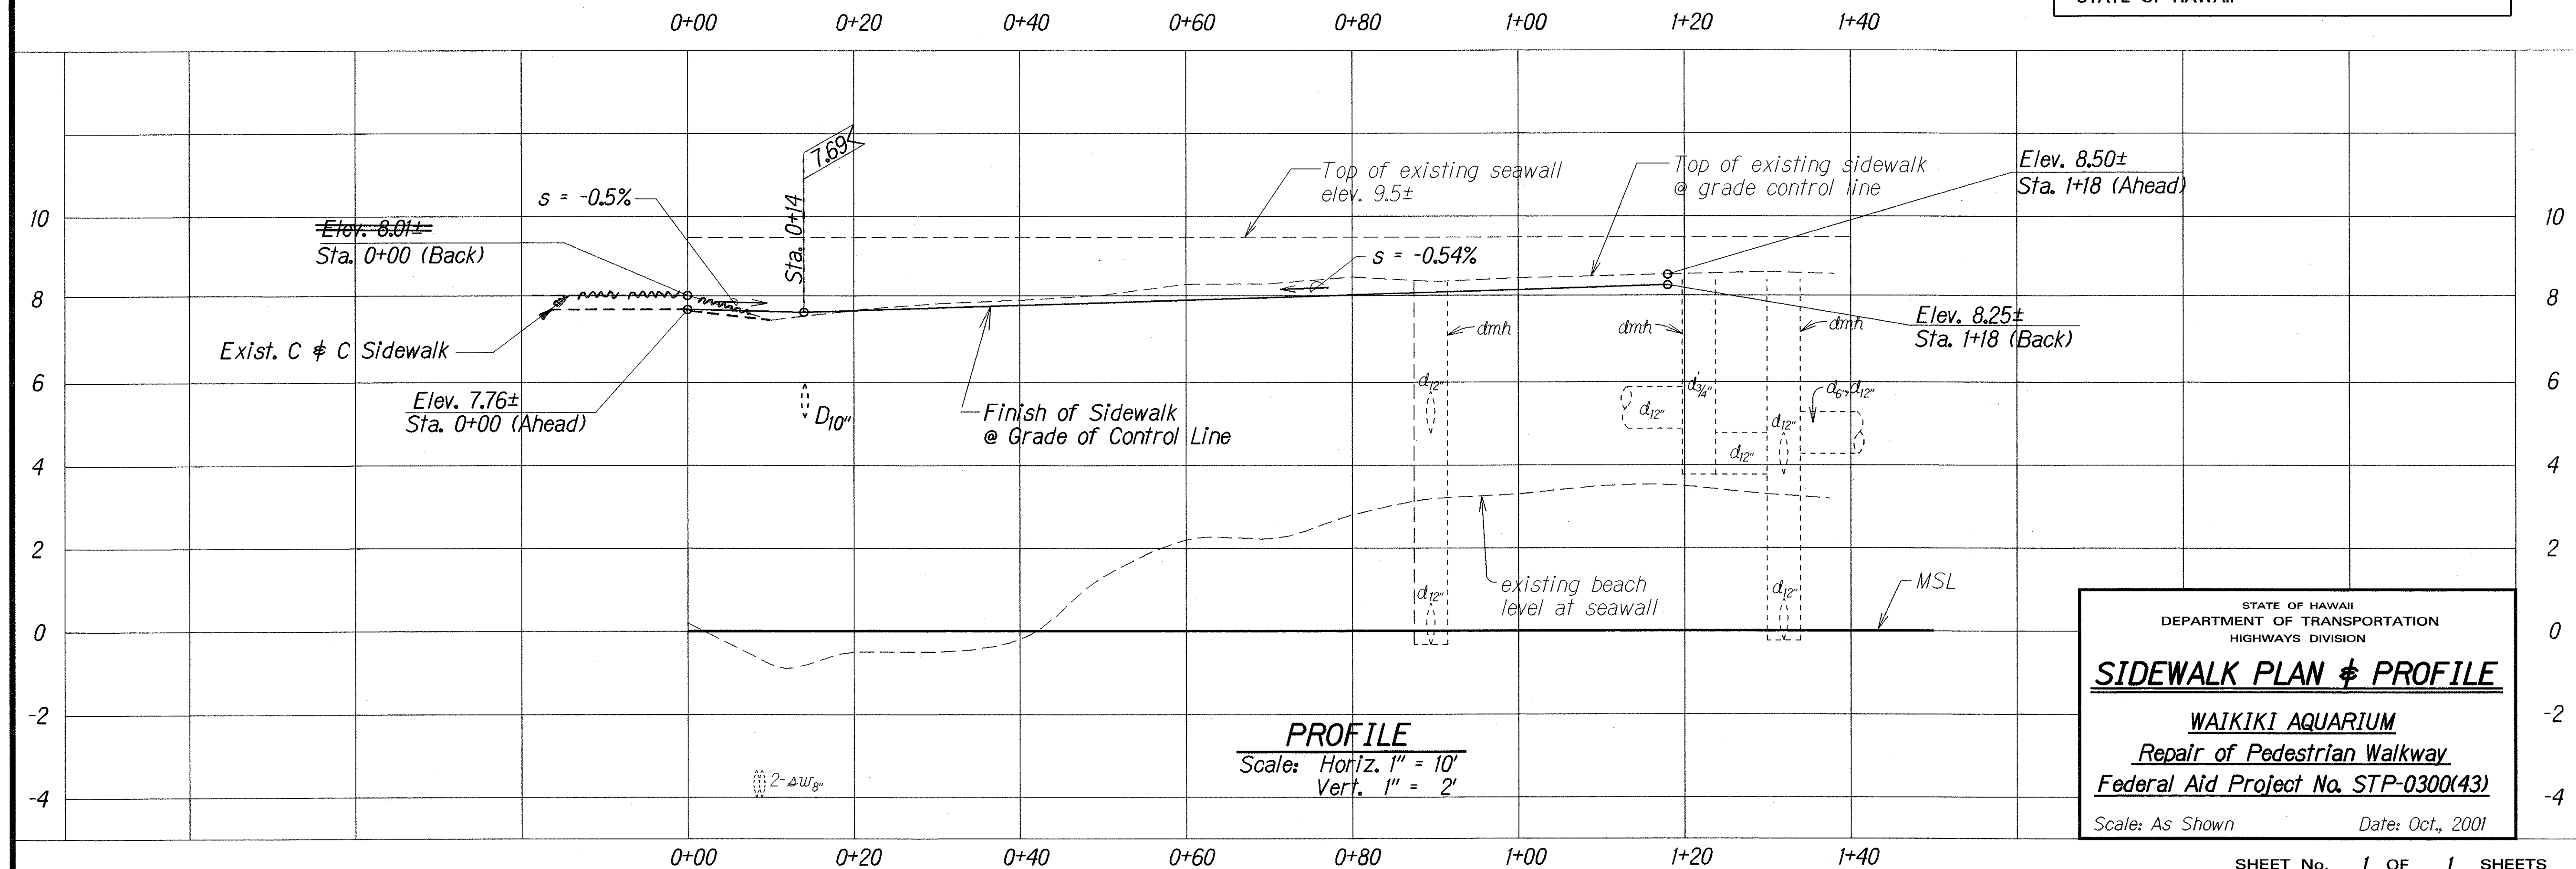

PROFILE
Scale: Horiz. 1" = 10'
Vert. 1" = 2'

STATE OF HAWAII
DEPARTMENT OF TRANSPORTATION
HIGHWAYS DIVISION

SIDEWALK PLAN & PROFILE

WAIKIKI AQUARIUM
Repair of Pedestrian Walkway
Federal Aid Project No. STP-0300(43)
Scale: As Shown Date: Oct., 2001

ORIGINAL PLAN	SURVEY PLOTTED BY	DATE
NOTE BOOK	DRAWN BY	
	CHECKED BY	
	QUANTITIES BY	