
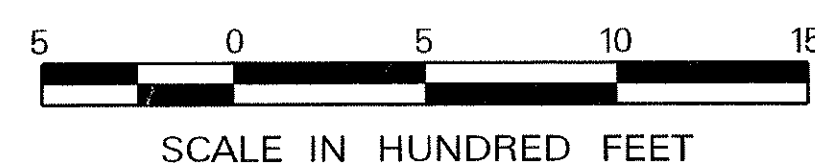




INDEX TO DRAWINGS	
SHEET NO.	DESCRIPTION
1	TITLE SHEET
2	STANDARD PLANS SUMMARY
3	GENERAL NOTES & LEGEND
4 - 5	WATER POLLUTION AND EROSION CONTROL NOTES
6	TYPICAL BMP - NOTES, PLANS AND DETAILS
7	LAYOUT PLAN
8	PLAN DETAIL
9	TYPICAL SECTION AND DETAILS
10	SIDEWALK PLAN & PROFILE
11	DRAINAGE PLAN AND DETAILS
12	EXISTING SALTWATER & DRAIN SYSTEMS

STATE OF HAWAII
DEPARTMENT OF TRANSPORTATION
HIGHWAYS DIVISION
HONOLULU, HAWAII
"AS-BUILT"
PLANS FOR
WAIKIKI AQUARIUM
REPAIR OF PEDESTRIAN WALKWAY
FEDERAL AID PROJECT NO. STP-0300(43)
DISTRICT OF HONOLULU
ISLAND OF OAHU

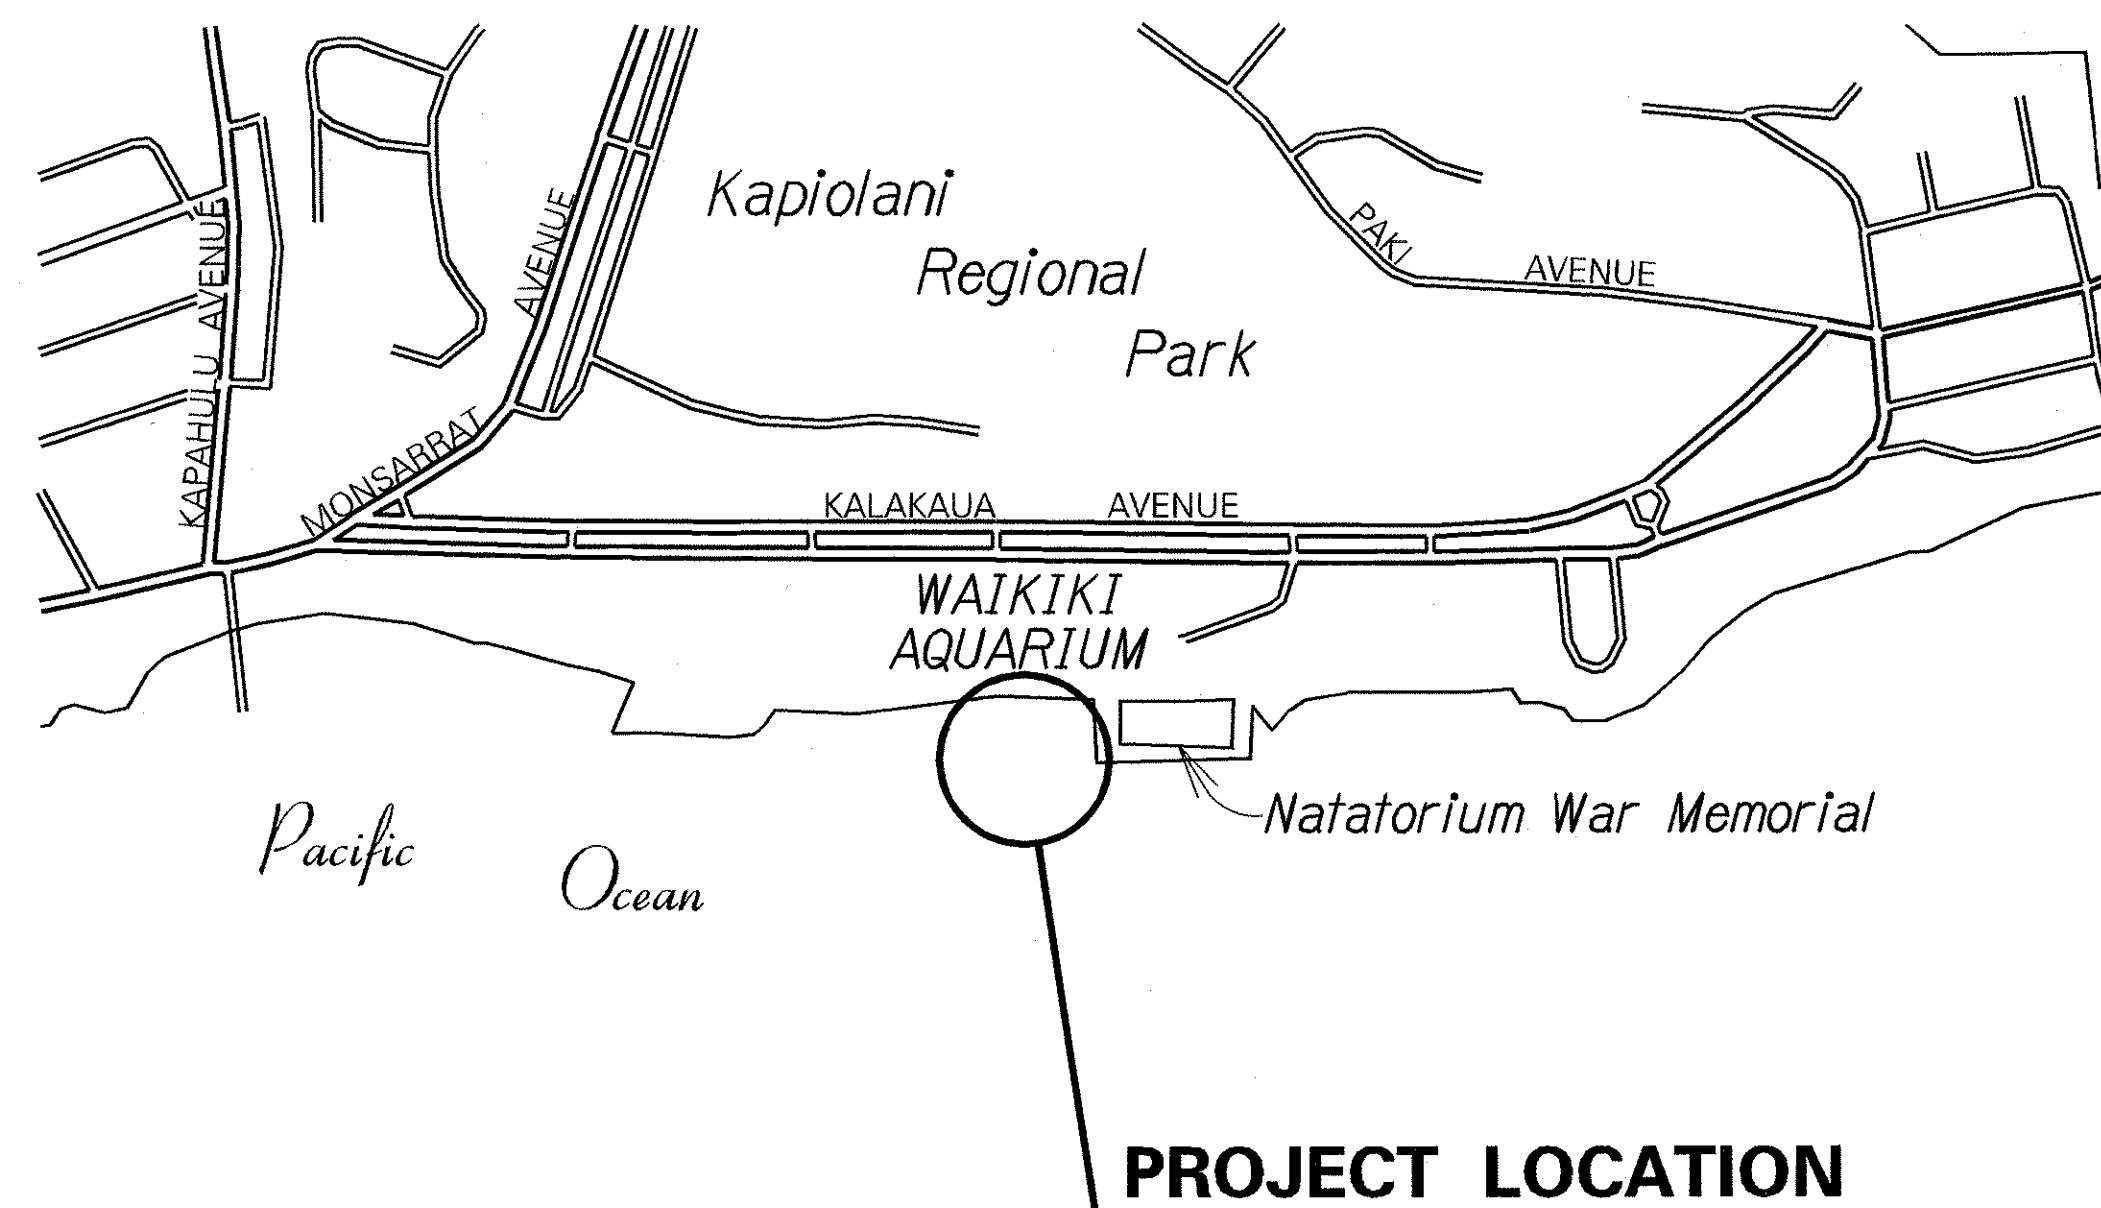

LAYOUT PLAN
NET LENGTH OF PROJECT..... 118 FEET

FED. ROAD DIST. NO.	STATE	FED. AID PROJ. NO.	FISCAL YEAR	SHEET NO.	TOTAL SHEETS
HAWAII	HAW.	STP-0300(43)	2002	1	12

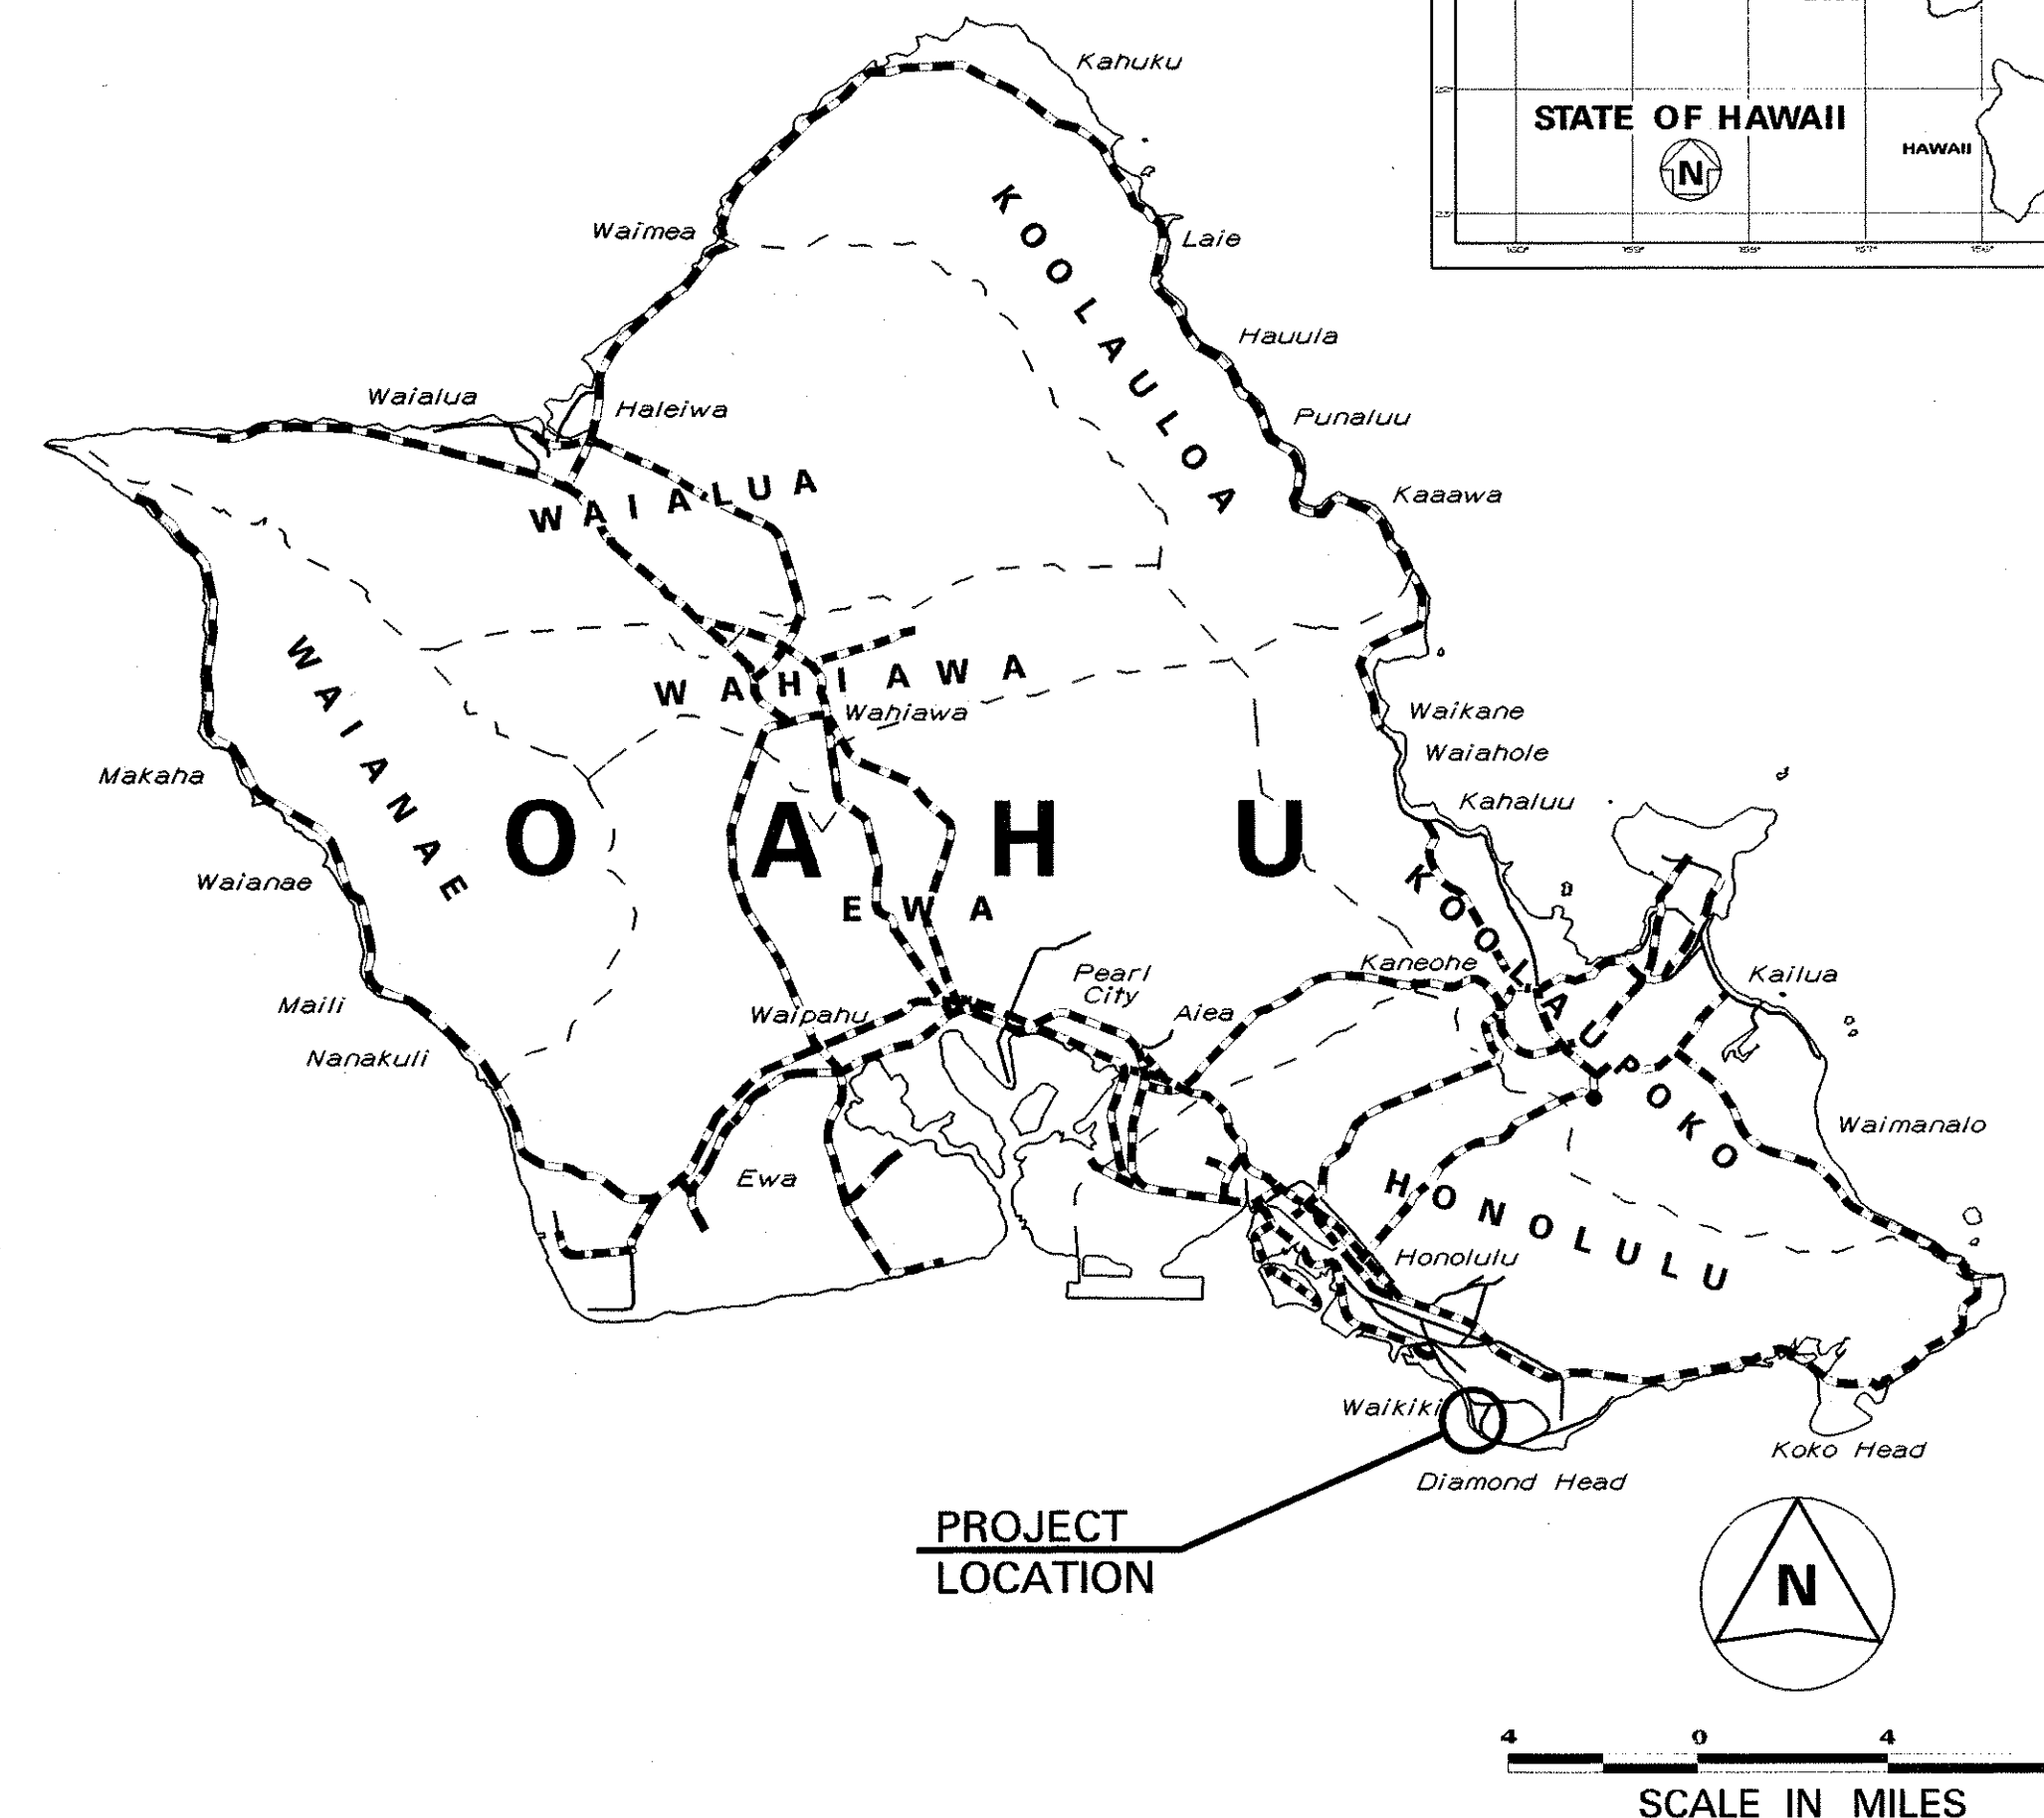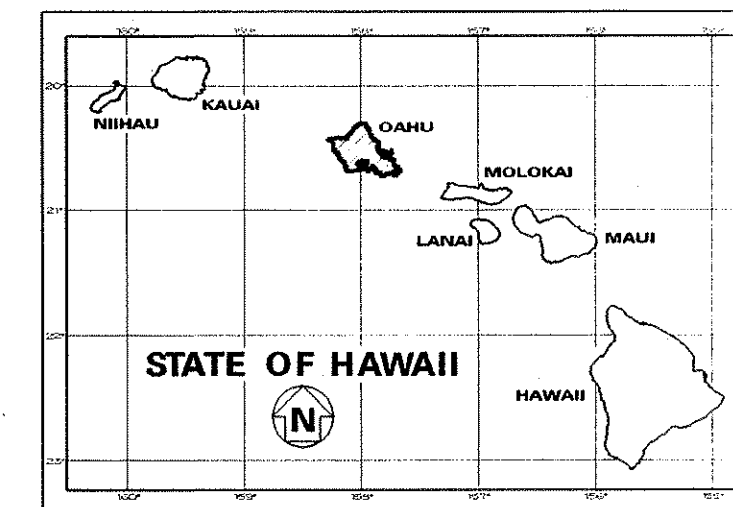

----- FEDERAL AID PROJECTS PREVIOUSLY CONSTRUCTED OR UNDER CONSTRUCTION

APPROVED:

SENIOR VICE-PRESIDENT
FOR ADMINISTRATION
UNIVERSITY OF HAWAII
STATE OF HAWAII

11/14/01
DATE

DEPARTMENT OF TRANSPORTATION
STATE OF HAWAII
APPROVED:

DIR. OF TRANSPORTATION

10/30/01
DATE

CHANGES MADE DURING CONSTRUCTION HAVE BEEN INCORPORATED ON THESE PLANS EXCEPT CHANGES IN THE ORIGINAL THEORETICAL QUANTITIES. FOR ACTUAL QUANTITIES, REFER TO PROJECT LEDGER AND/OR COMPUTATION BOOK.

RESIDENT ENGINEER

12/9/02
DATE