


JAMB: STRIKE SIDE

JAMB: HINGE SIDE

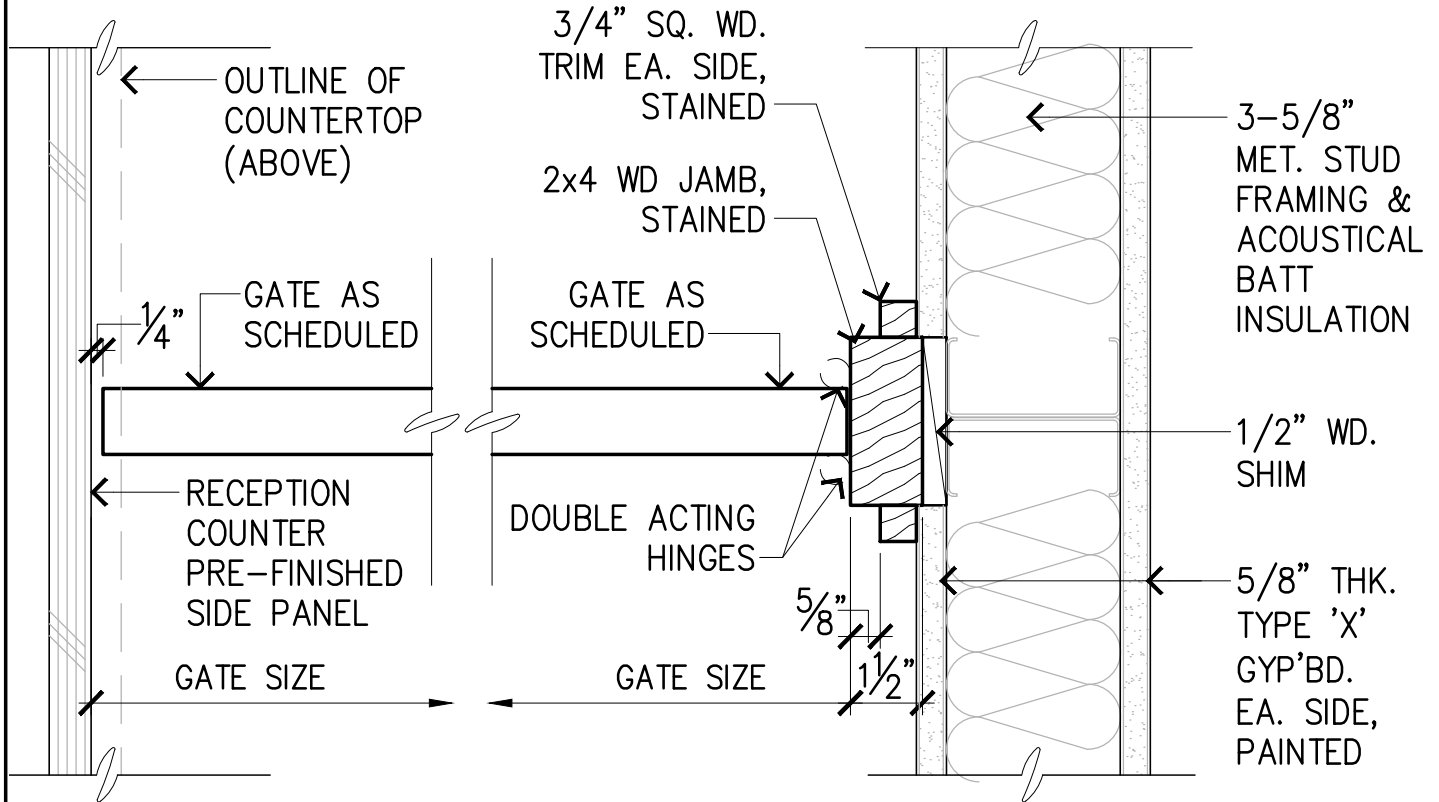

DOUBLE ACTING HINGES
(BASIS OF DESIGN PRODUCT)
MANUFACTURER: SUGATSUNE
MODEL: JDA-180-40A
QUANTITY: (2) REQUIRED

WOOD GATE
SOLID CORE FLUSH WOOD GATE,
STAINED FINISH, 1-1/2" THK.

PARTIAL HEIGHT GATE JAMBS

SCALE: 3"=1'-0"

USHIJIMA
ARCHITECTS, INC.

PROJECT NAME:
REPAIR HARBOR AGENT'S OFFICE AT
KALAELOA BARBERS POINT HARBOR
KALAELOA BARBERS POINT HARBOR, HAWAII

REFERENCE DETAIL/SHEET: A-4

DATE: 4/28/2023

SHEET

SKA-1

RFI 4 - NEW PARTIAL HEIGHT GATE