


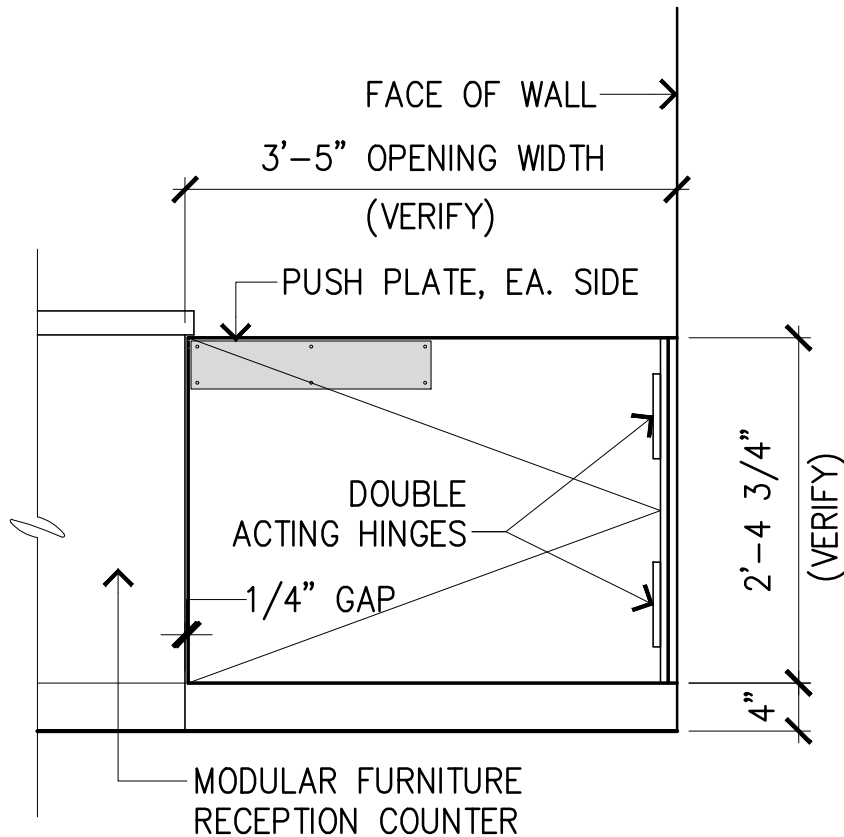

PUSH PLATES

(BASIS OF DESIGN PRODUCT)

MANUFACTURER: ASSA ABLOY

MODEL: ROCKWOOD 71G

DIMENSIONS: 4"x20"x.062"THK.

MATERIAL: STAINLESS STEEL

PARTIAL HEIGHT GATE ELEVATION

SCALE: 3/4"=1'-0"

USHIJIMA ARCHITECTS, INC.	PROJECT NAME: REPAIR HARBOR AGENT'S OFFICE AT KALAELOA BARBERS POINT HARBOR KALAELOA BARBERS POINT HARBOR, HAWAII	SHEET SKA-2
	REFERENCE DETAIL/SHEET: A-4 DATE: 4/28/2023	

RFI 4 – NEW PARTIAL HEIGHT GATE