


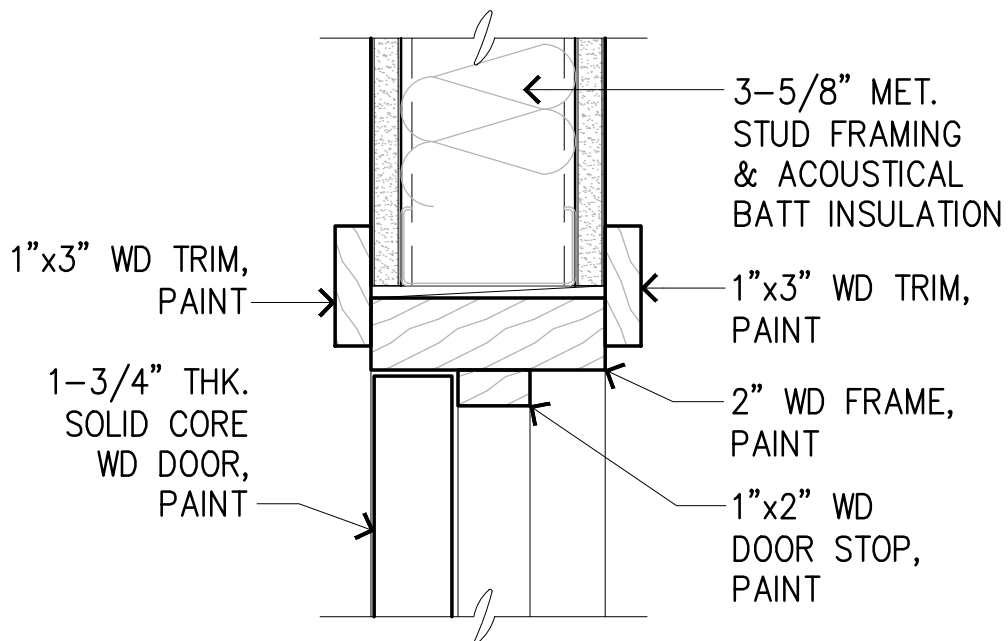

WOOD DOOR HEAD (JAMB SIM.)

SCALE: 3"=1'-0"

USHIJIMA ARCHITECTS, INC.	PROJECT NAME: REPAIR HARBOR AGENT'S OFFICE AT KALAELOA BARBERS POINT HARBOR KALAELOA BARBERS POINT HARBOR, HAWAII		SHEET SKA-3
	REFERENCE DETAIL/SHEET: A-4	DATE: 4/28/2023	

RFI 9 – WOOD DOOR FRAME