

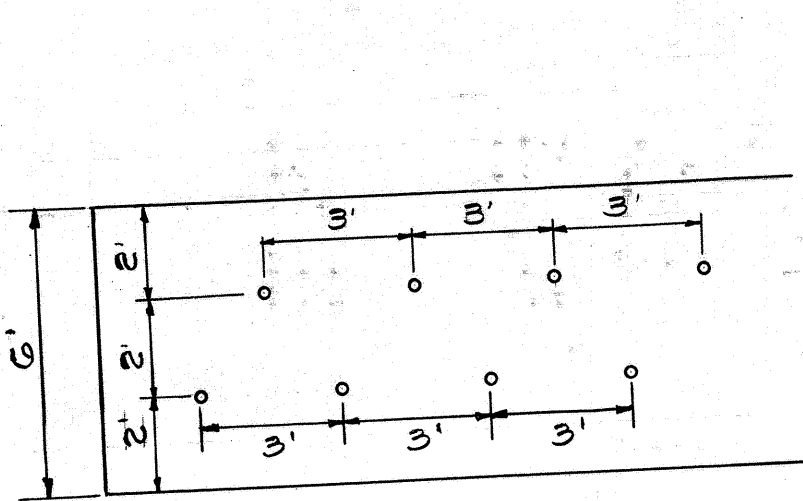


FED. ROAD DIST. NO.	STATE	FED. AID PROJ. NO.	FISCAL YEAR	SHEET NO	TOTAL SHEETS
HAWAII	HAW.	LSF-063-1(1)	1967	2	16

NOTE: Proj. No. LSF-063-1(1) begins at Sta. -0+87.

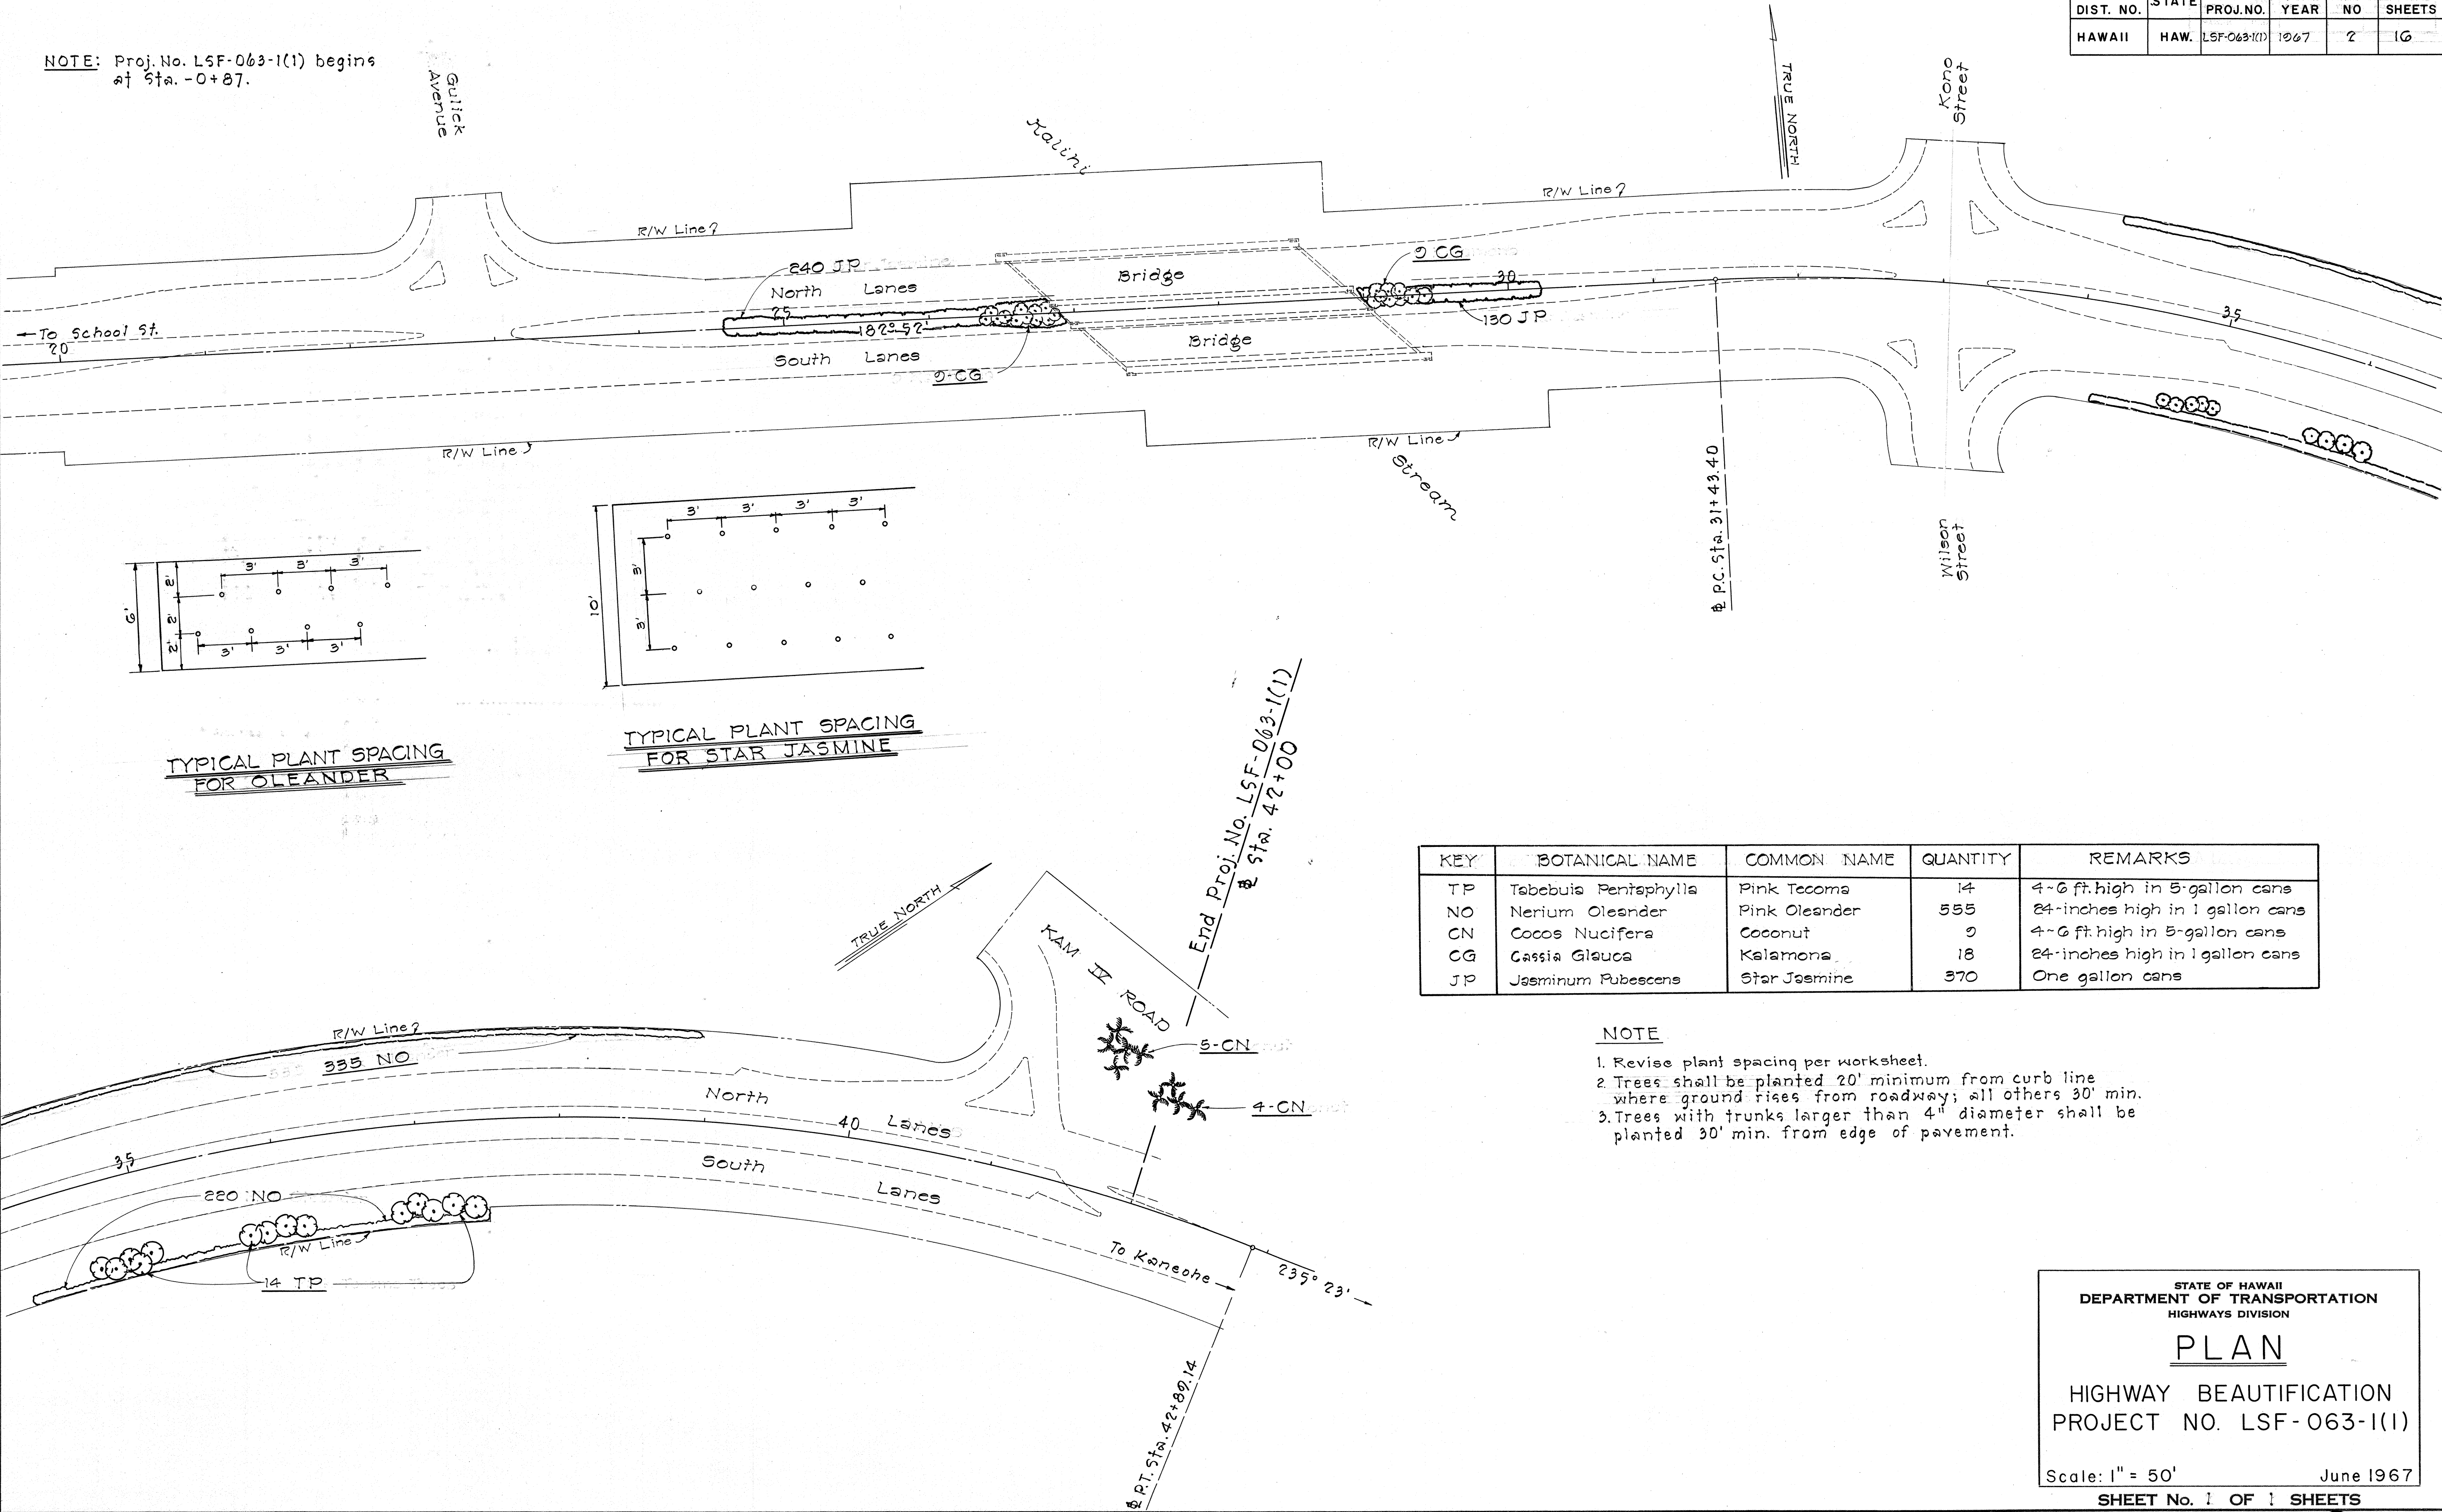

TYPICAL PLANT SPACING FOR OLEANDER

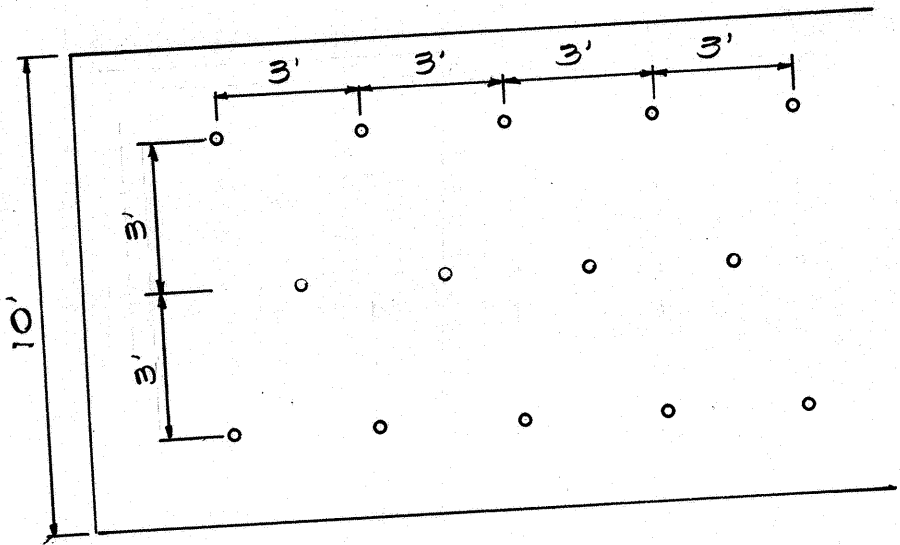

TYPICAL PLANT SPACING FOR STAR JASMINE

KEY	BOTANICAL NAME	COMMON NAME	QUANTITY	REMARKS
TP	Tabebuia Pentaphylla	Pink Tecoma	14	4-6 ft. high in 5-gallon cans
NO	Nerium Oleander	Pink Oleander	555	24-inches high in 1 gallon cans
CN	Cocos Nucifera	Coconut	9	4-6 ft. high in 5-gallon cans
CG	Cassia Glauca	Kalamona	18	24-inches high in 1 gallon cans
JP	Jasminum Pubescens	Star Jasmine	370	One gallon cans

NOTE

1. Revise plant spacing per worksheet.
2. Trees shall be planted 20' minimum from curb line where ground rises from roadway; all others 30' min.
3. Trees with trunks larger than 4" diameter shall be planted 30' min. from edge of pavement.

DATE	_____
DESIGNED BY	_____
CHECKED BY	_____
NOTED BY	_____
NO.	_____

STATE OF HAWAII
DEPARTMENT OF TRANSPORTATION
HIGHWAYS DIVISION

PLAN

HIGHWAY BEAUTIFICATION

PROJECT NO. LSF-063-1(1)

Scale: 1" = 50'
June 1967
SHEET No. 1 OF 1 SHEETS