

FED. ROAD DIST. NO.	STATE	FED. AID PROJ. NO.	FISCAL YEAR	SHEET NO.	TOTAL SHEETS
HAWAII	HAW.	LSF-063-1(1) LSF-099-1(1) LSF-061-1(1) LSF-072-1(1) LSF-072-1(2)	1967	1	16

INDEX TO DRAWINGS	
SHEET NO.	DESCRIPTION
1	TITLE SHEET
2	PROJ. NO. LSF-063-1(1)
3-6	PROJ. NO. LSF-099-1(1)
7-8	PROJ. NO. LSF-061-1(1)
9-11	PROJ. NO. LSF-072-1(1)
12-13	PROJ. NO. LSF-072-1(2)
14-16	DIRECTIONAL AND PROJ. IDENTIFICATION SIGN, AND STANDARD DETAILS

STATE OF HAWAII
DEPARTMENT OF TRANSPORTATION
HIGHWAYS DIVISION

PLANS FOR
HAWAII FEDERAL AID
LANDSCAPING AND SCENIC ENHANCEMENT PROGRAM
LIKELIKE HIGHWAY
H-1 TO KAMEHAMEHA IV ROAD

PROJ. NO. LSF-063-1(1)

KAMEHAMEHA HIGHWAY,
KIPAPA TO WHEELER FIELD


PROJ. NO. LSF-099-1(1)

ROUTE 61:
MAUNAWILI LOOKOUT
PROJ. NO. LSF - 061-1 (1)

ROUTE 72:
KUAPA POND LOOKOUT
PROJ. NO. LSF-072-1(1)

ROUTE 72:
LANAI ISLAND LOOKOUT
PROJ. NO. LSF-072-1(2)

ISLAND OF OAHU

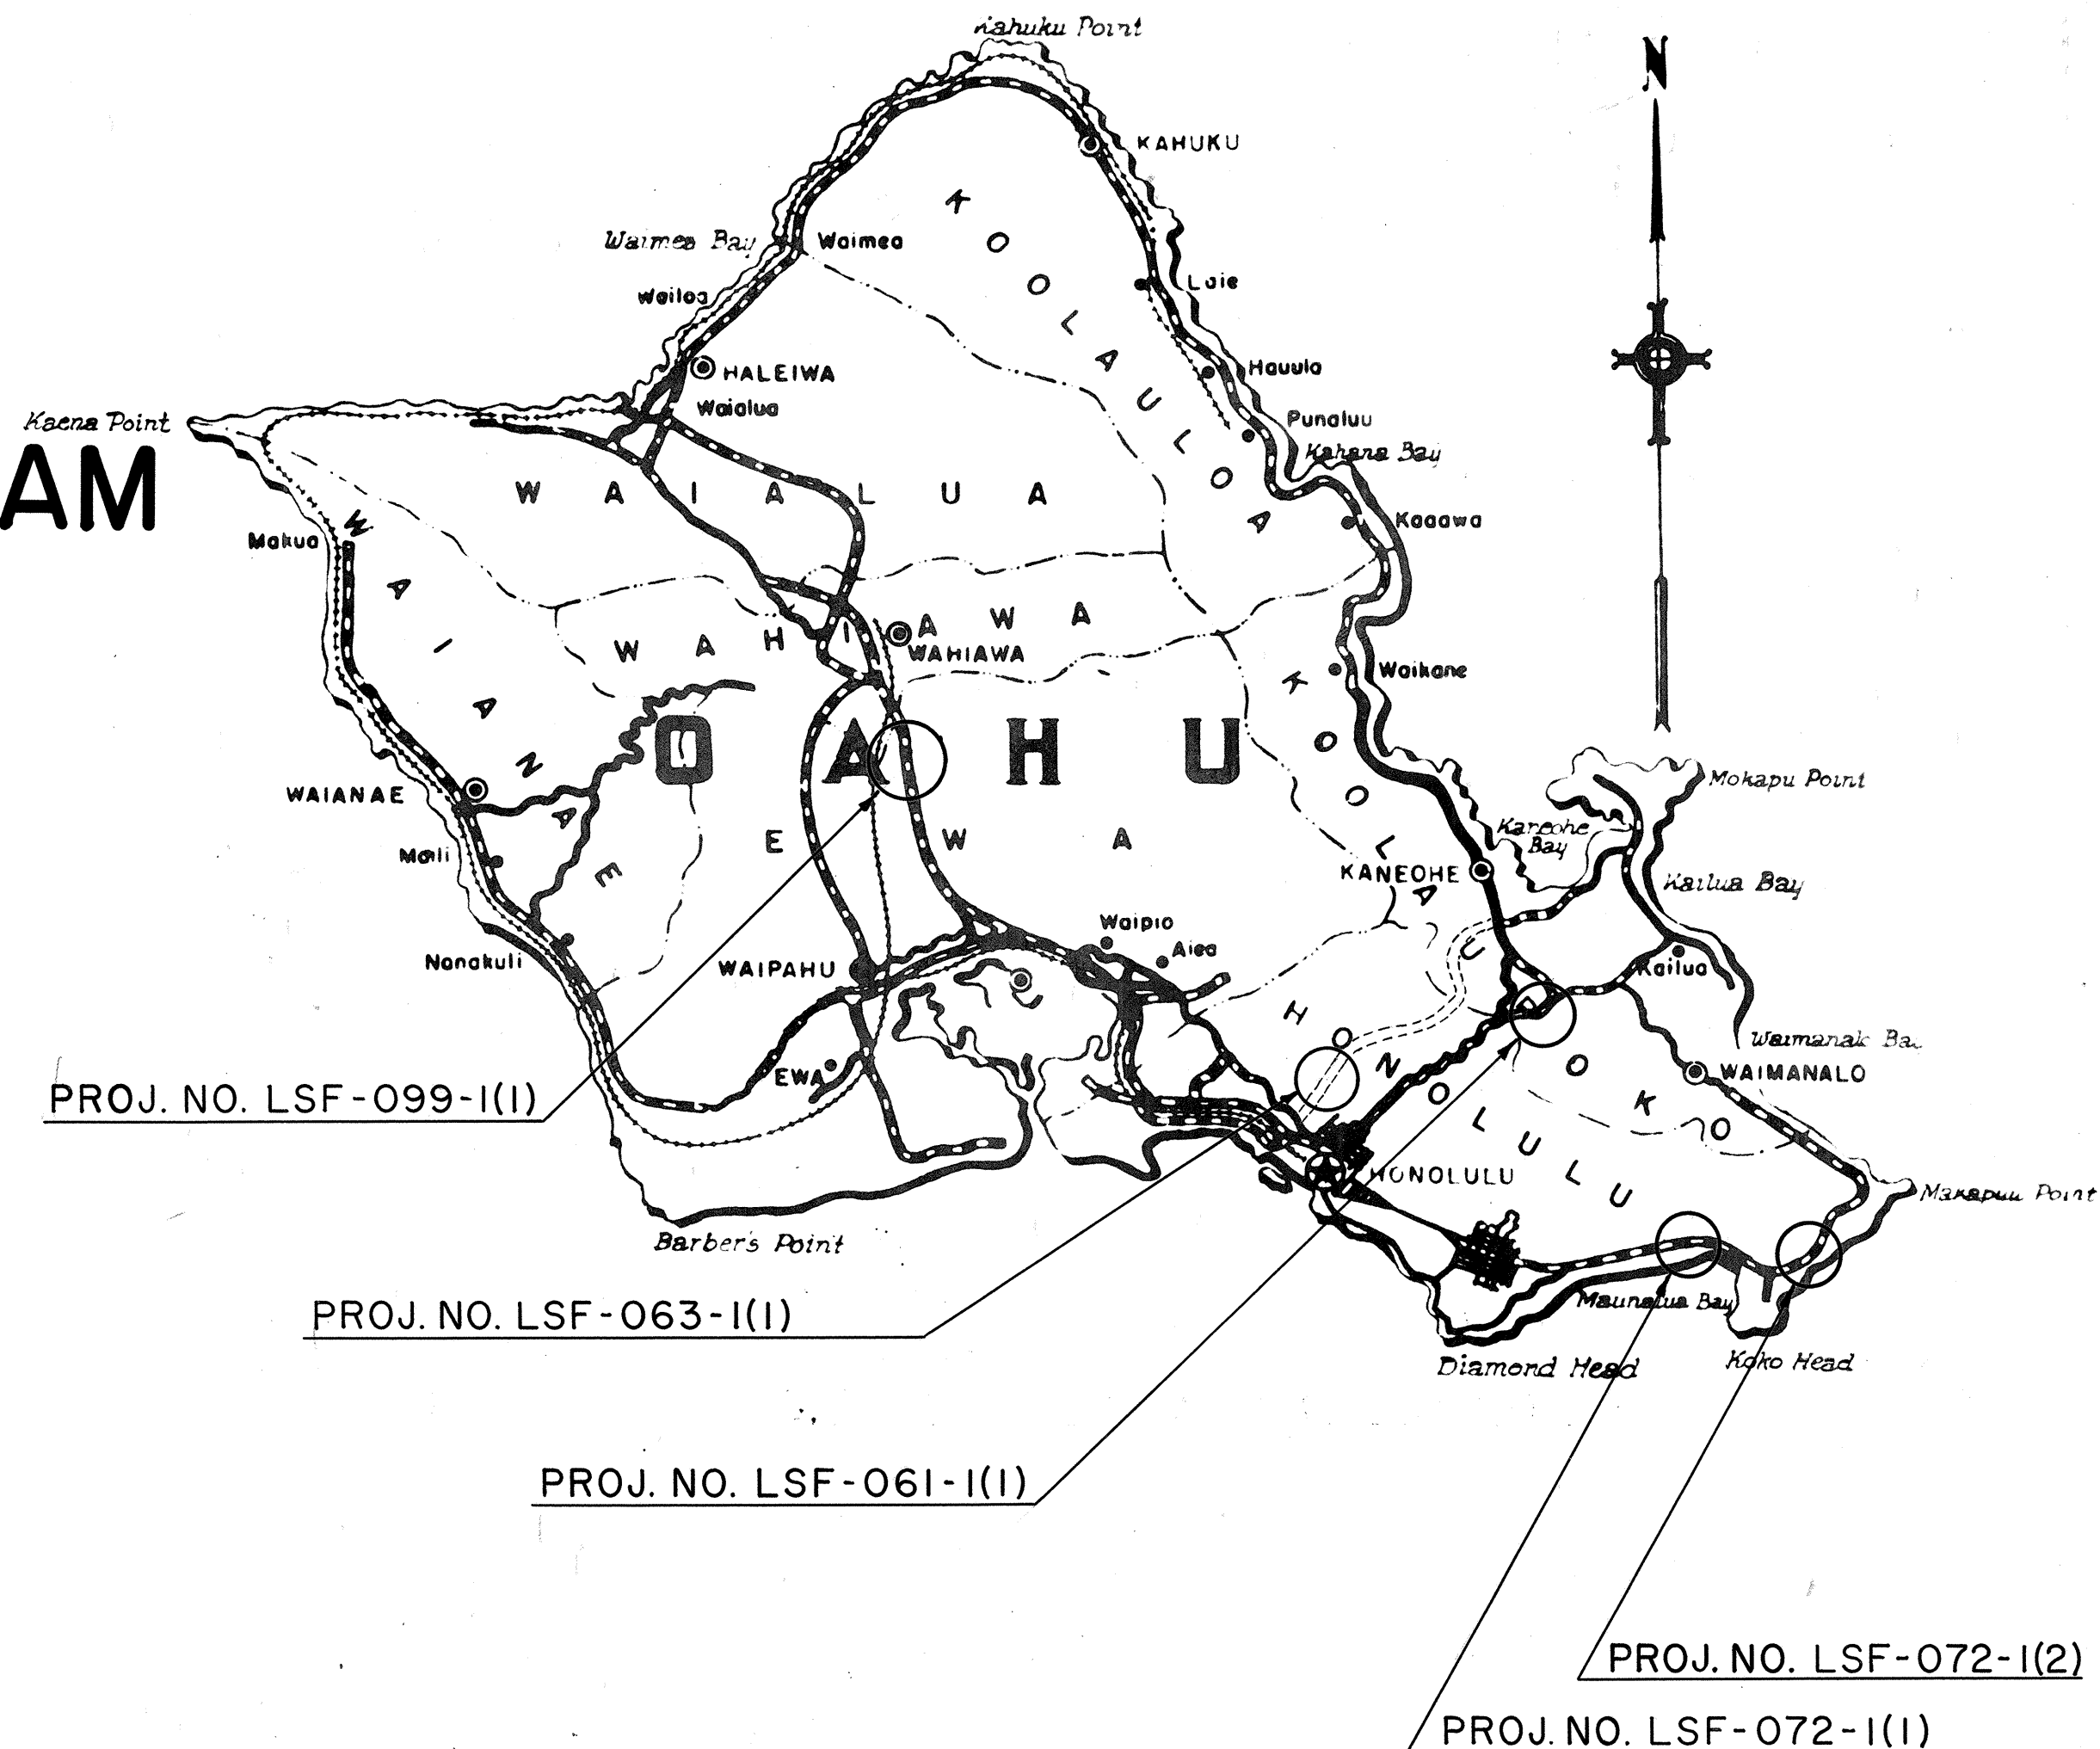

SEE REDUCED PLANS FOR
"AS BUILT" CHANGES.

SURVEY PLANNED BY DATE 6/15/67	DESIGNED BY R. T. P. O. S.
TRACED BY NOTE BOOK	CHECKED BY A. MARUTANI

APPROVED: *John M. Sullivan*
DATE 6-15-67
DIRECTOR OF TRANSPORTATION

DEPARTMENT OF TRANSPORTATION
BUREAU OF PUBLIC ROADS
APPROVED: *John M. Sullivan*
DATE 6-30-67
DIVISION ENGINEER