

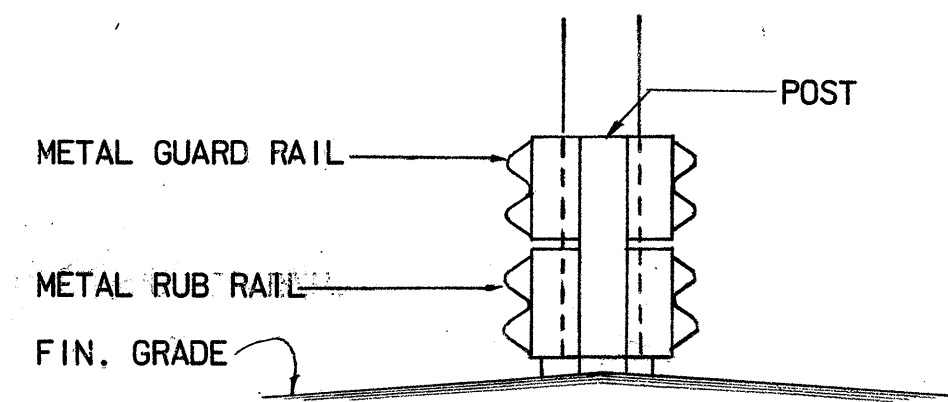
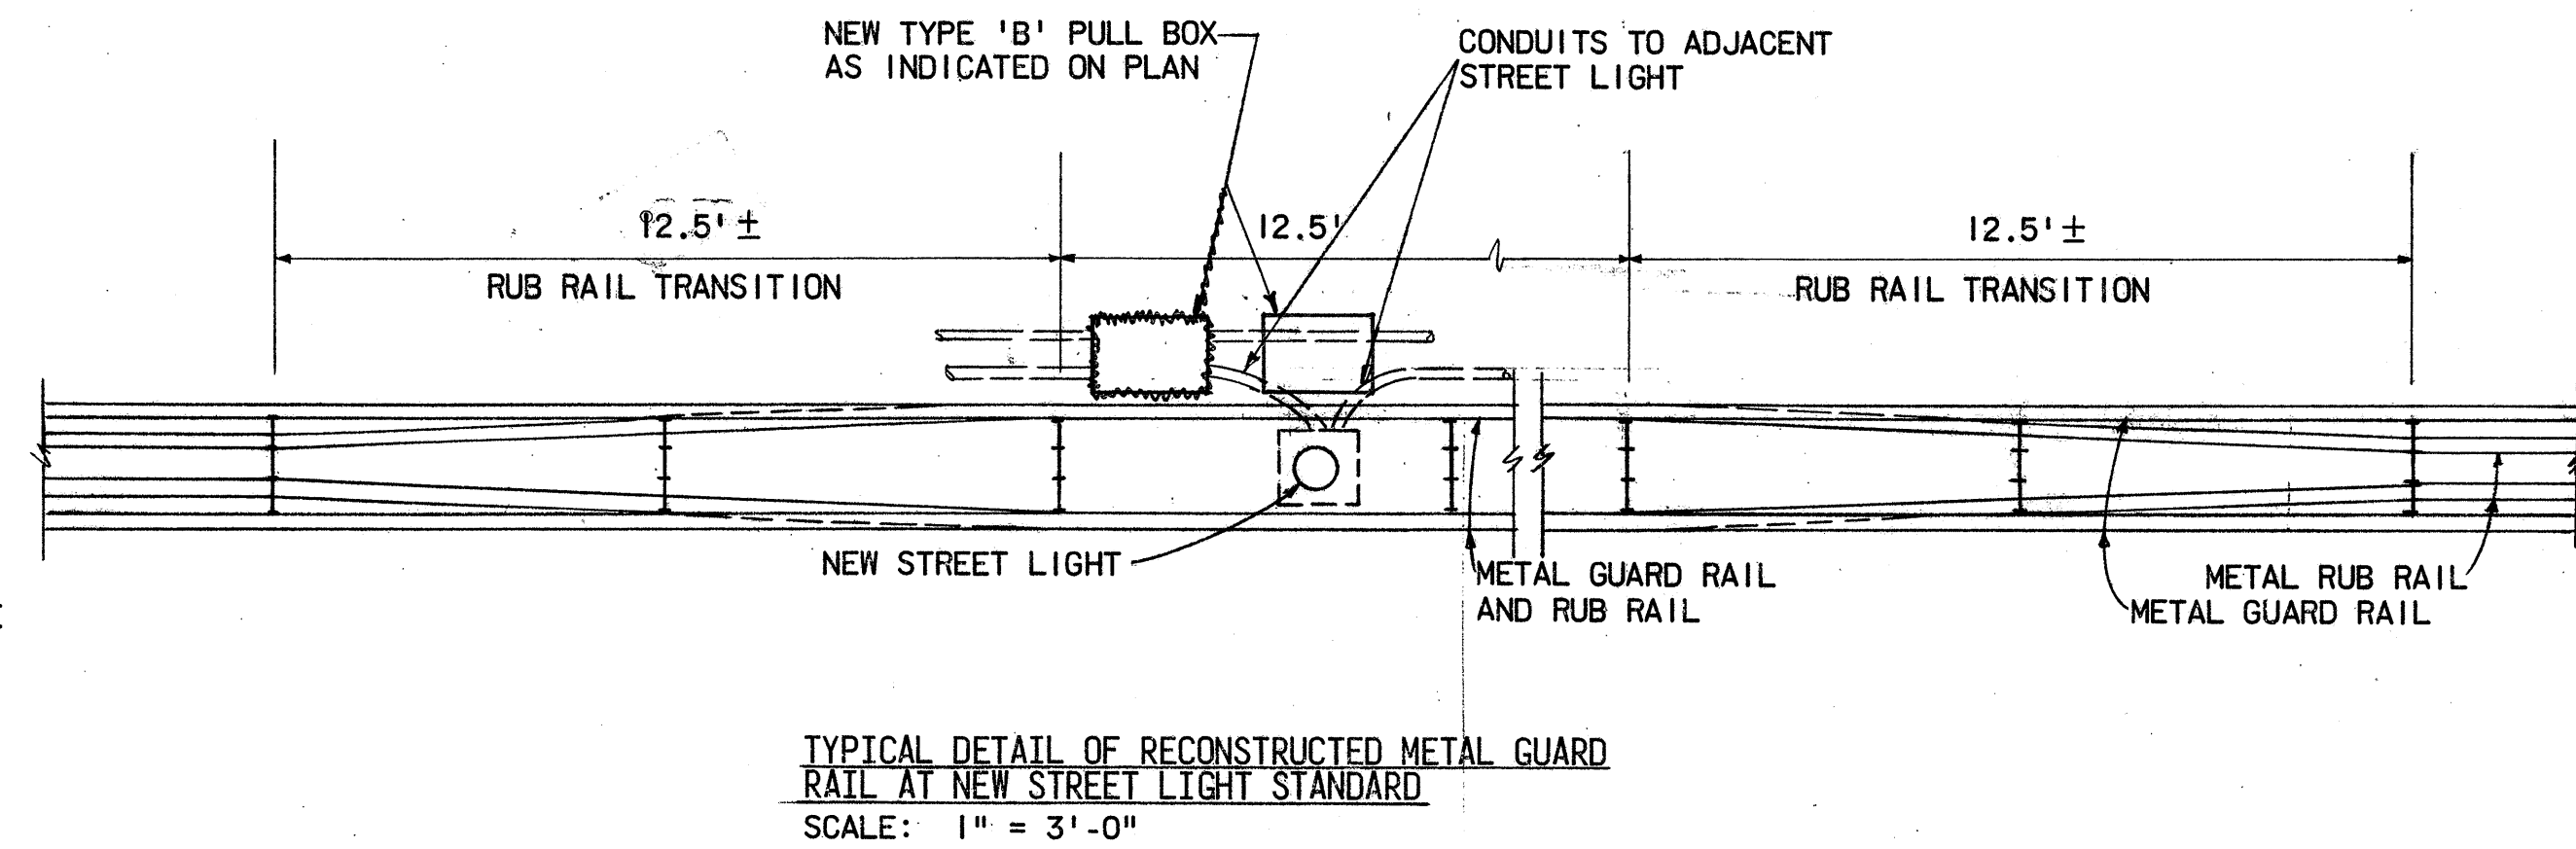
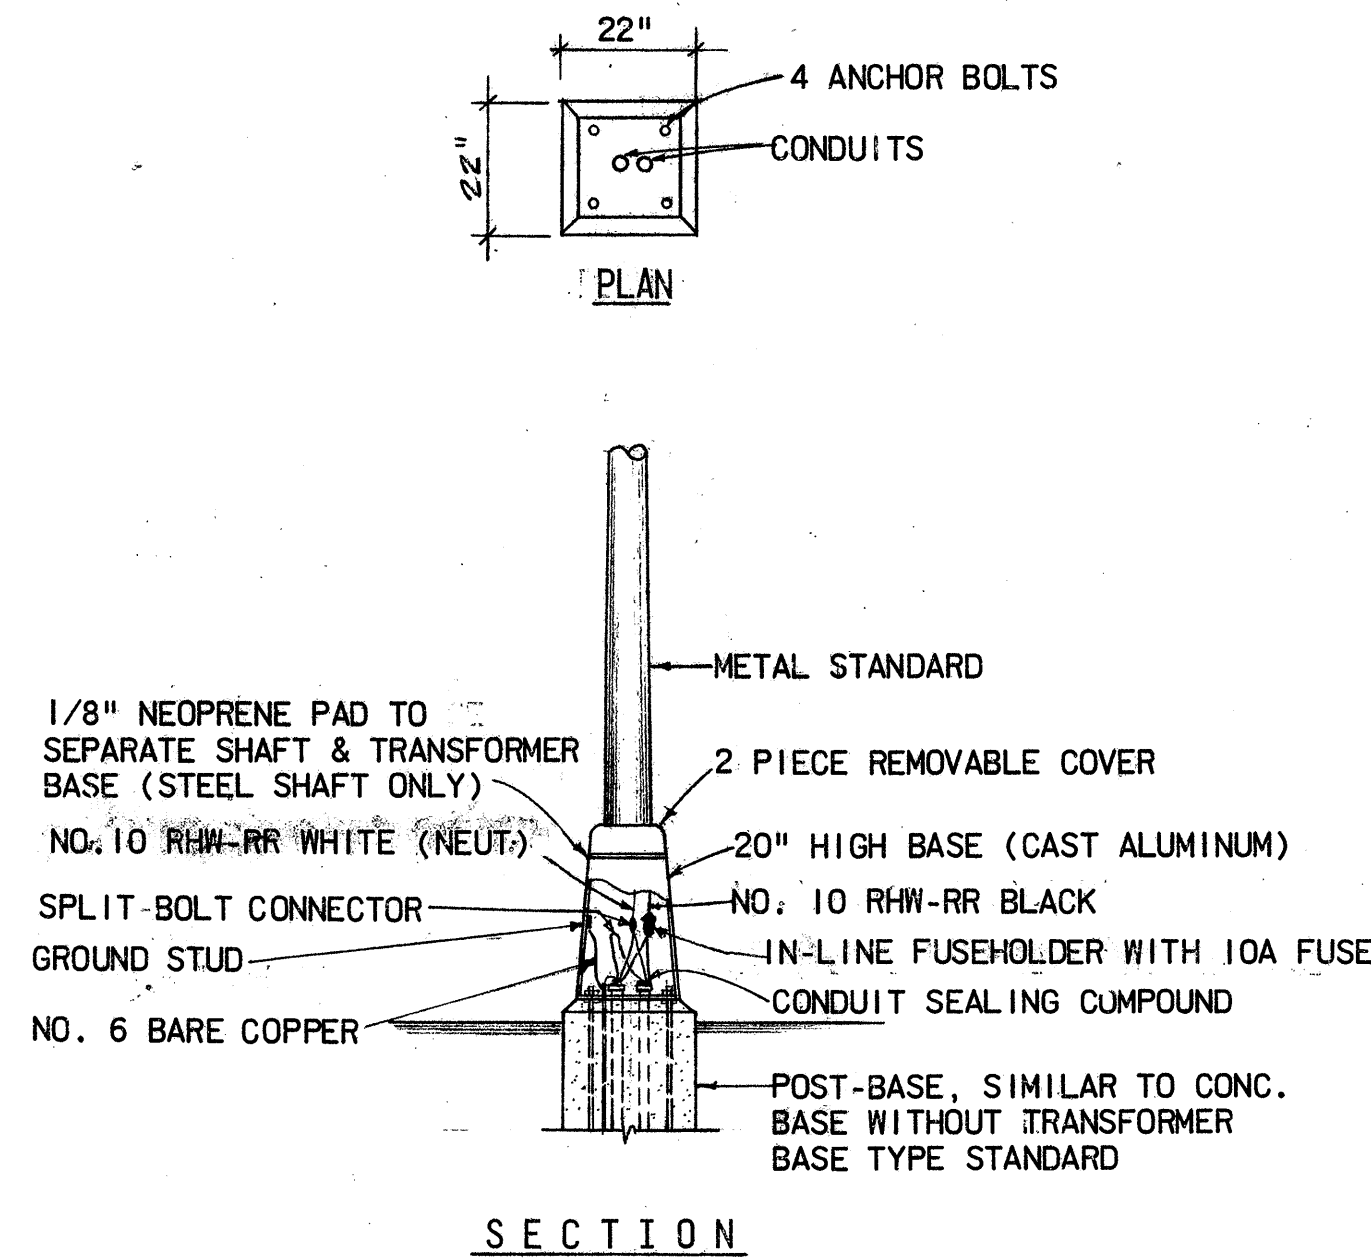
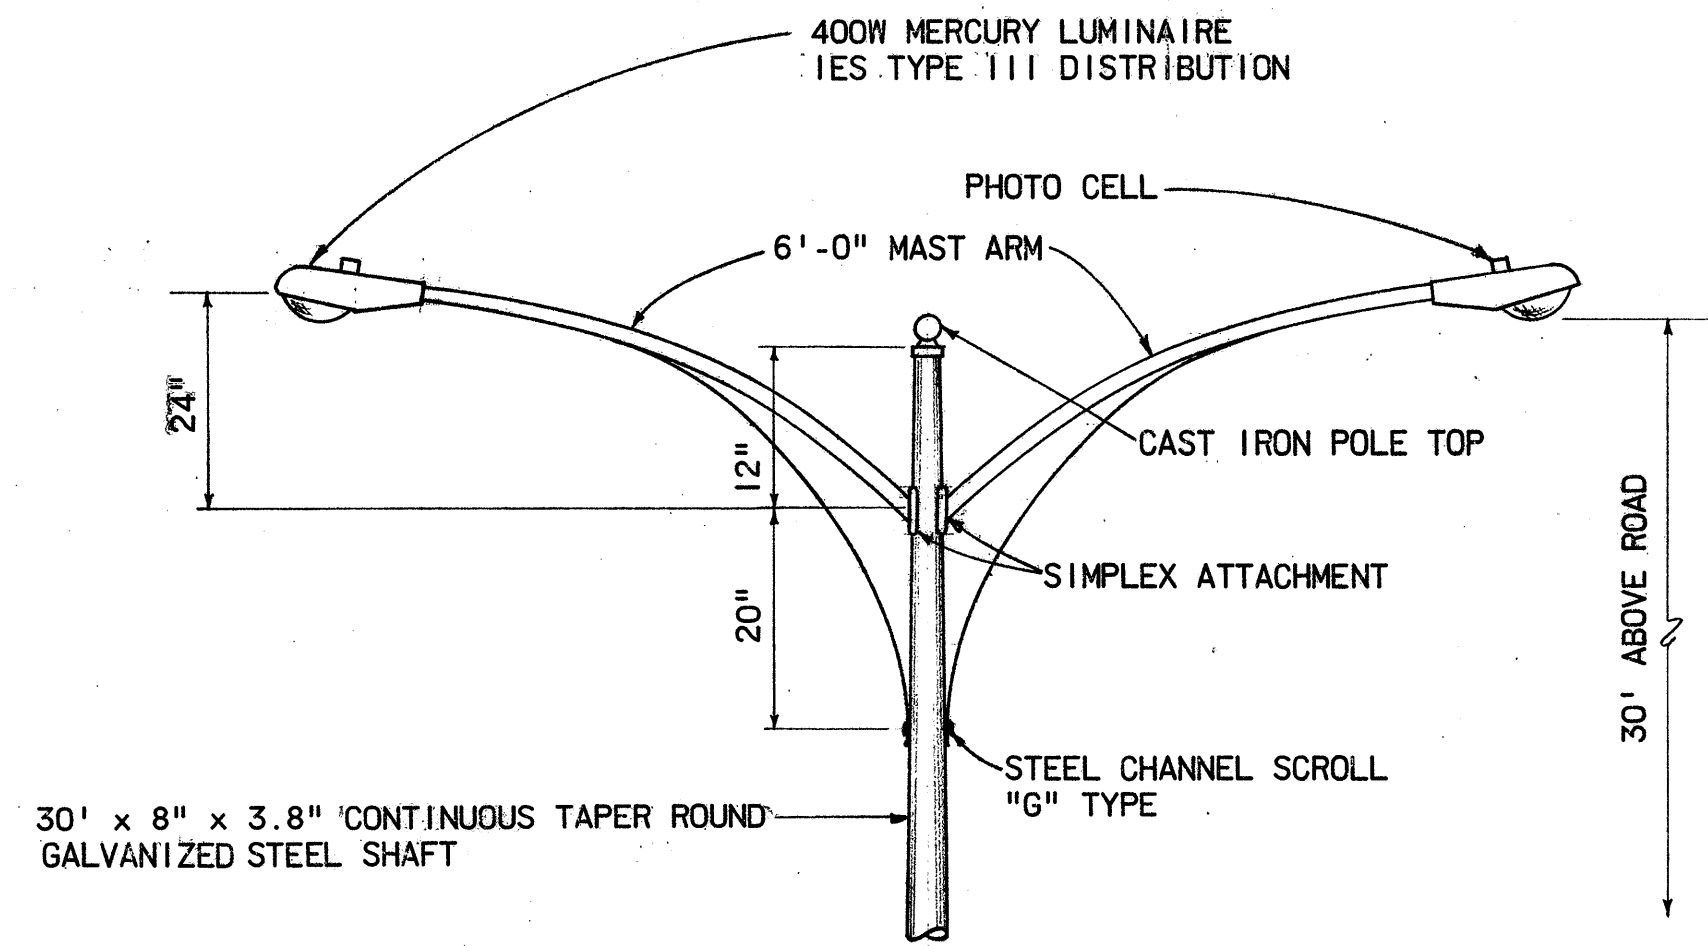
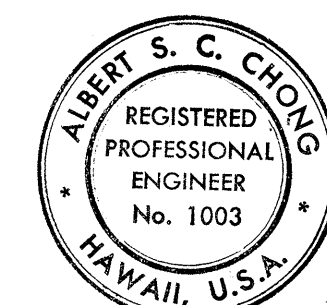
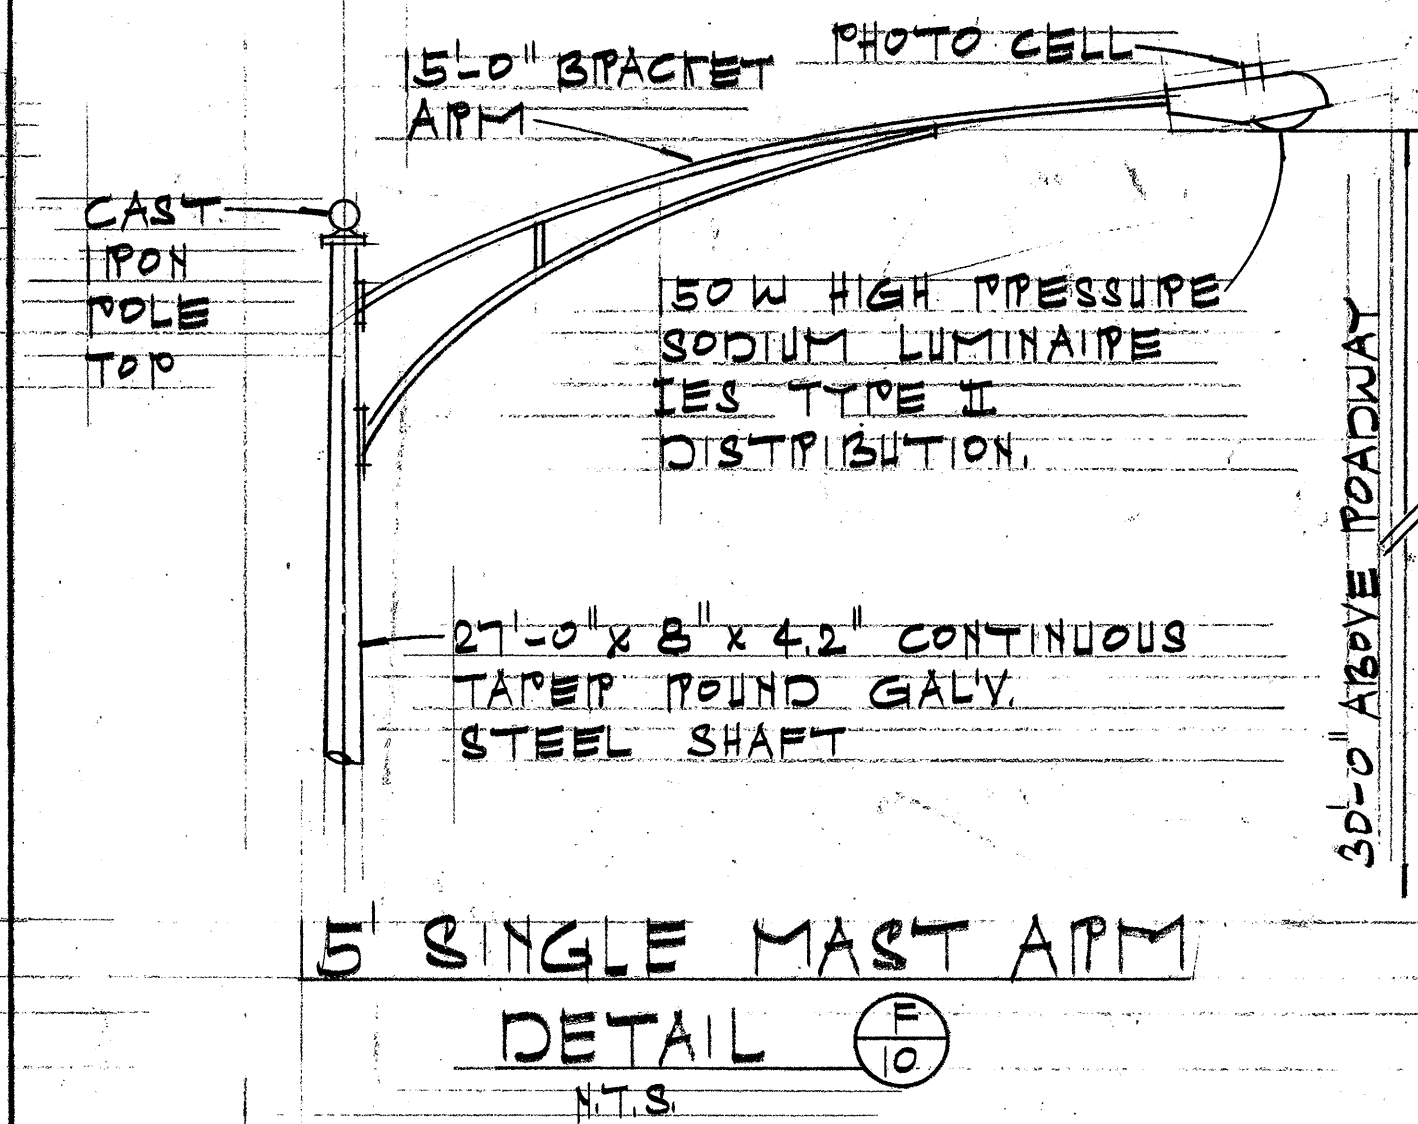
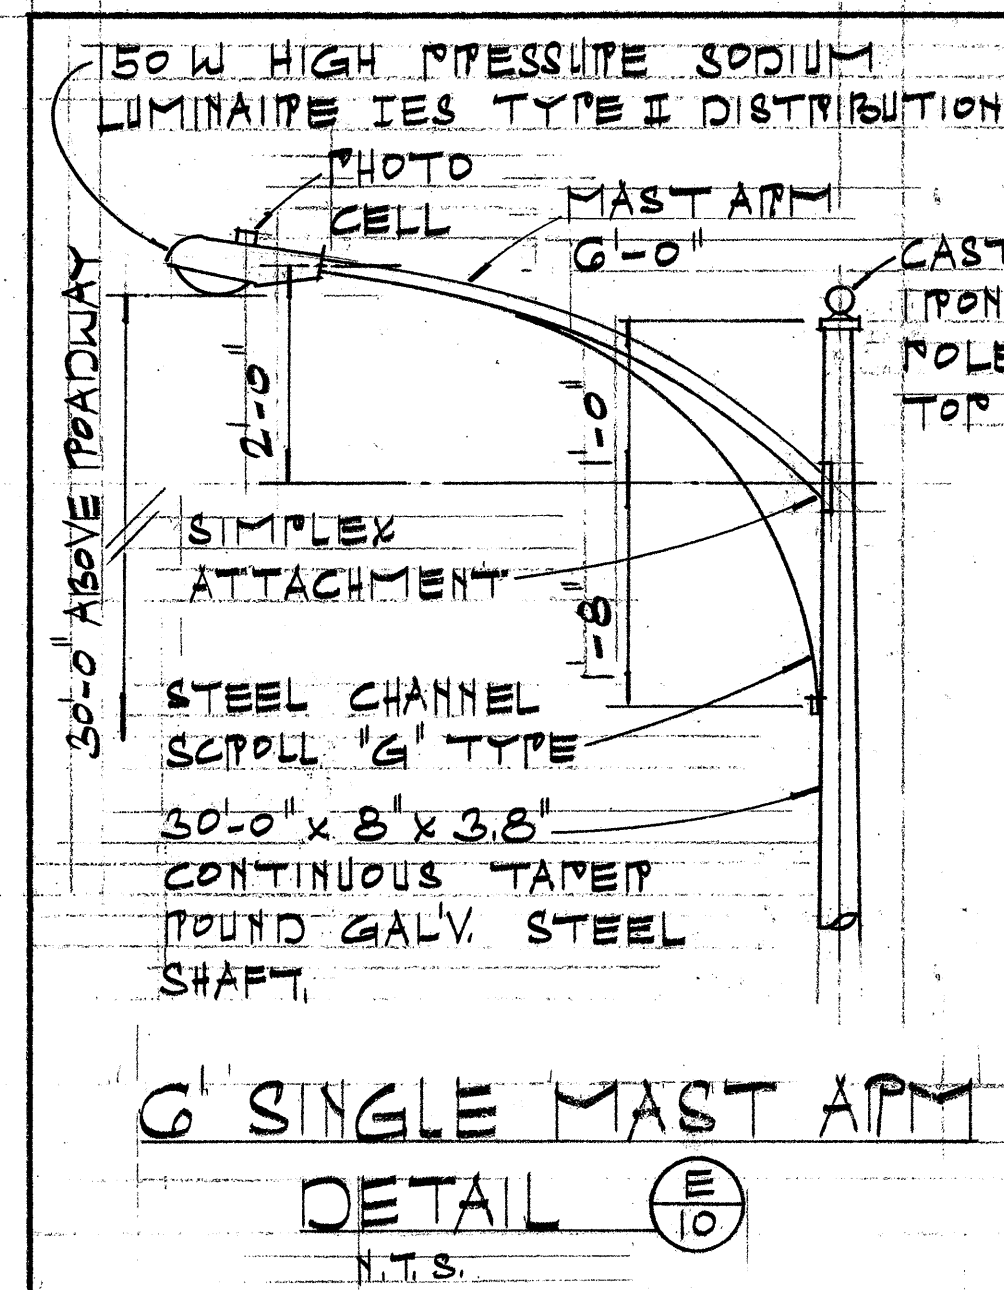


FED. ROAD DIST. NO.	STATE	PROJ. NO.	FISCAL YEAR	SHEET NO.	TOTAL SHEETS
HAWAII	HAW.	63A-01-72 UNIT I	1976	6	8

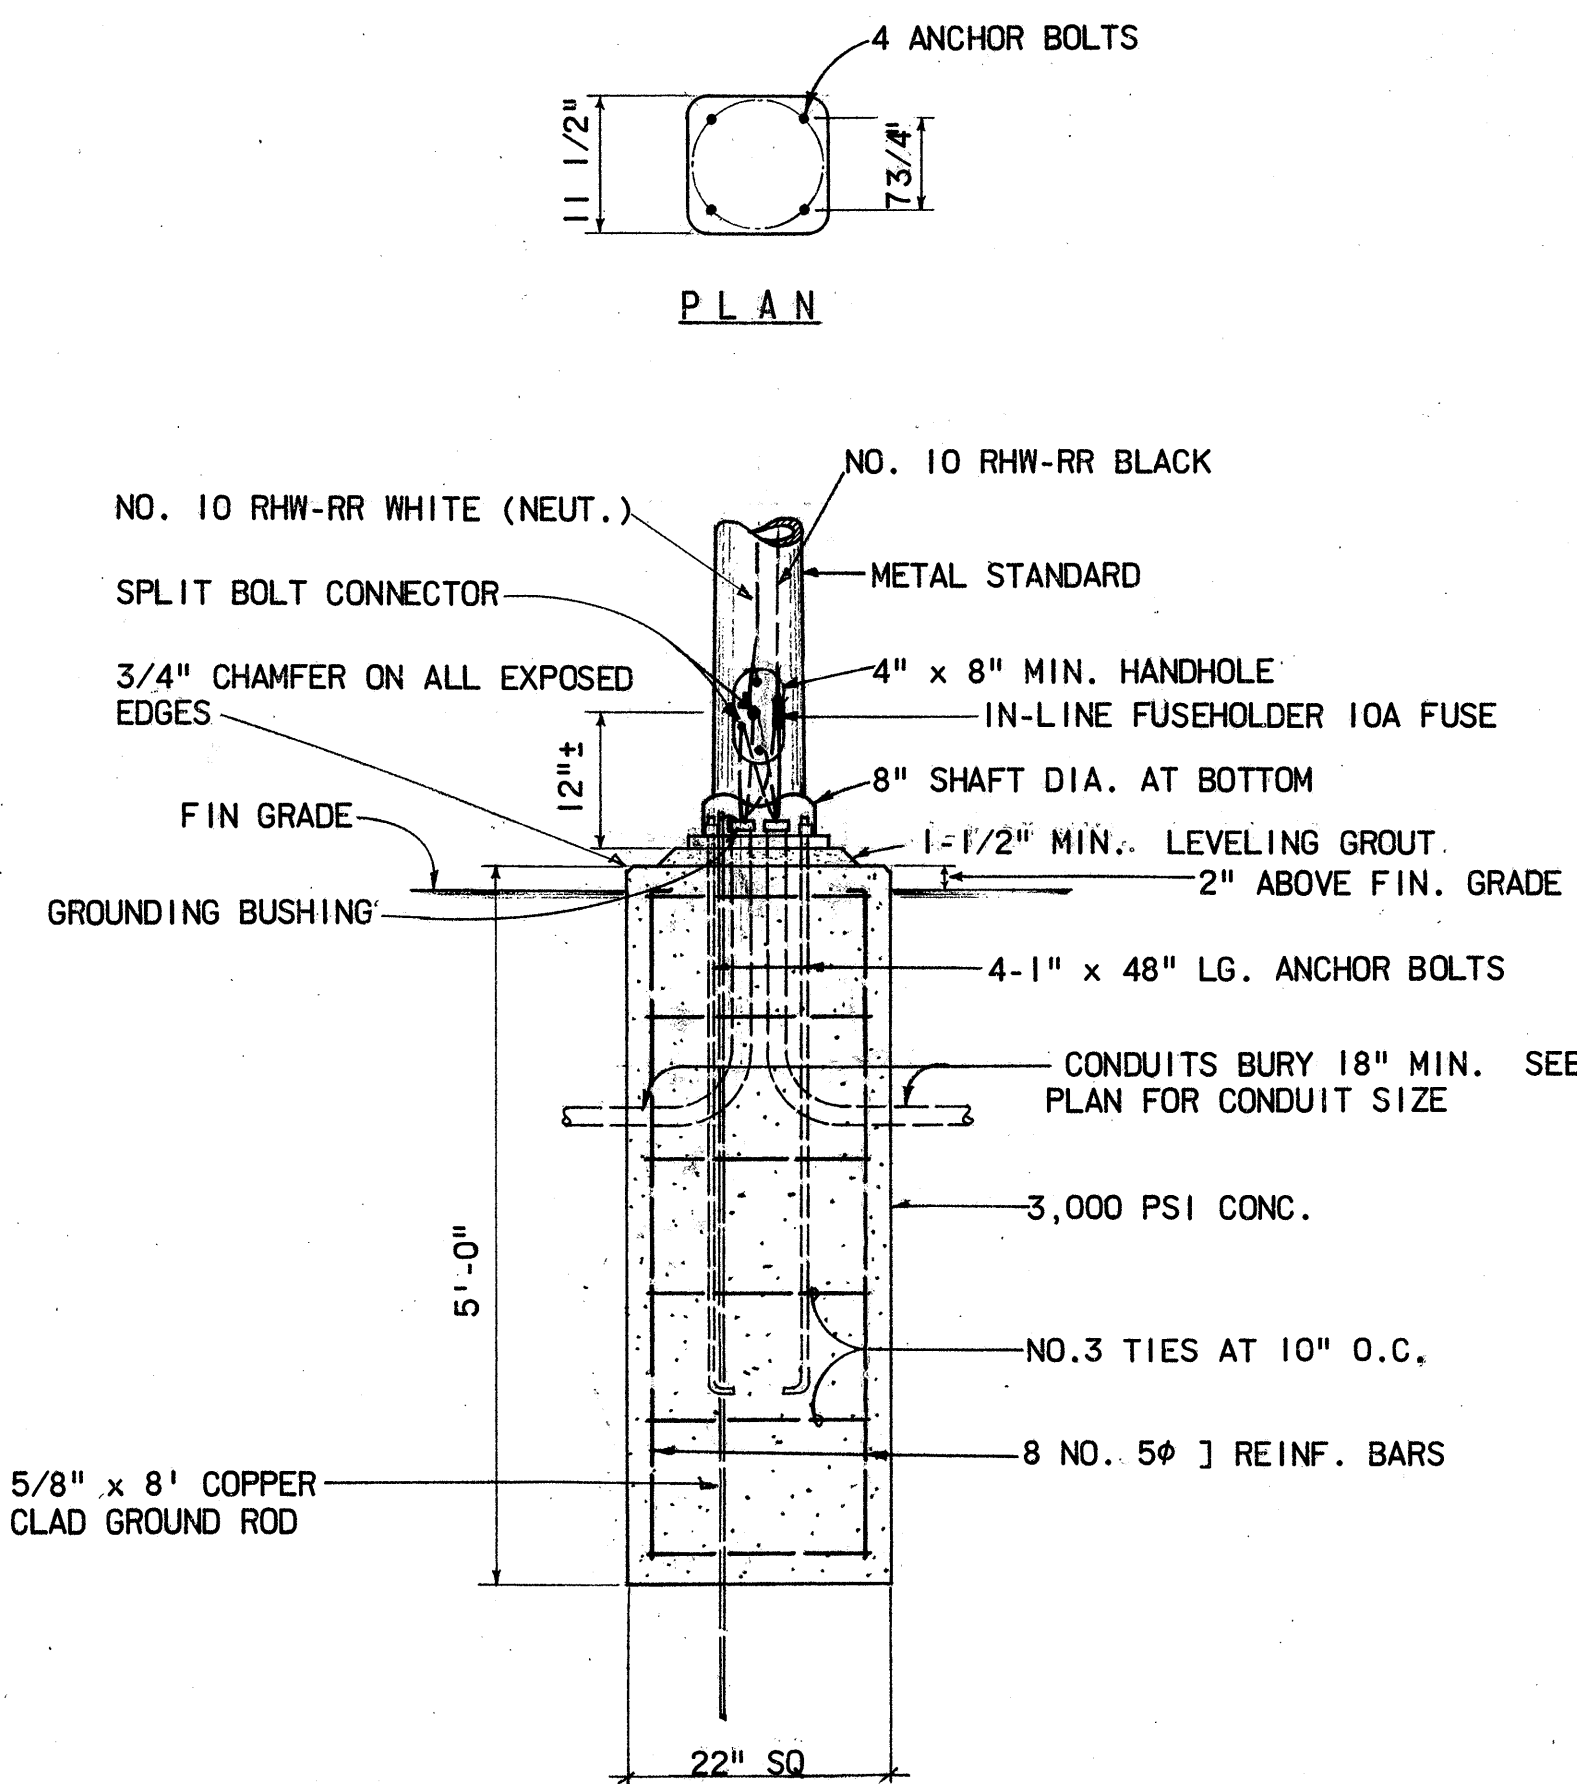

NOTES FOR RECONSTRUCTING GUARD RAILS

- IT IS INTENDED THAT THE CONTRACTOR SHALL MAKE USE OF ALL POST, RAILS, SPACER BLOCKS AND FITTINGS SALVAGED FROM THE EXISTING GUARD RAIL THAT HAVE NOT DETERIORATED, IN THE ENGINEER'S OPINION, TO AN EXTENT PRECLUDING THEIR USE IN THE RECONSTRUCTED GUARD RAIL.
- IF EXISTING POSTS ARE FOUND TO BE DAMAGED OR DEFORMED UPON REMOVAL, THE STATE WILL FURNISH REPLACEMENT POSTS TO BE INSTALLED BY THE CONTRACTOR. HOWEVER, ANY SALVAGEABLE MATERIALS DAMAGED THROUGH THE CONTRACTOR'S NEGLIGENCE, SHALL BE REPLACED AT HIS OWN EXPENSE.

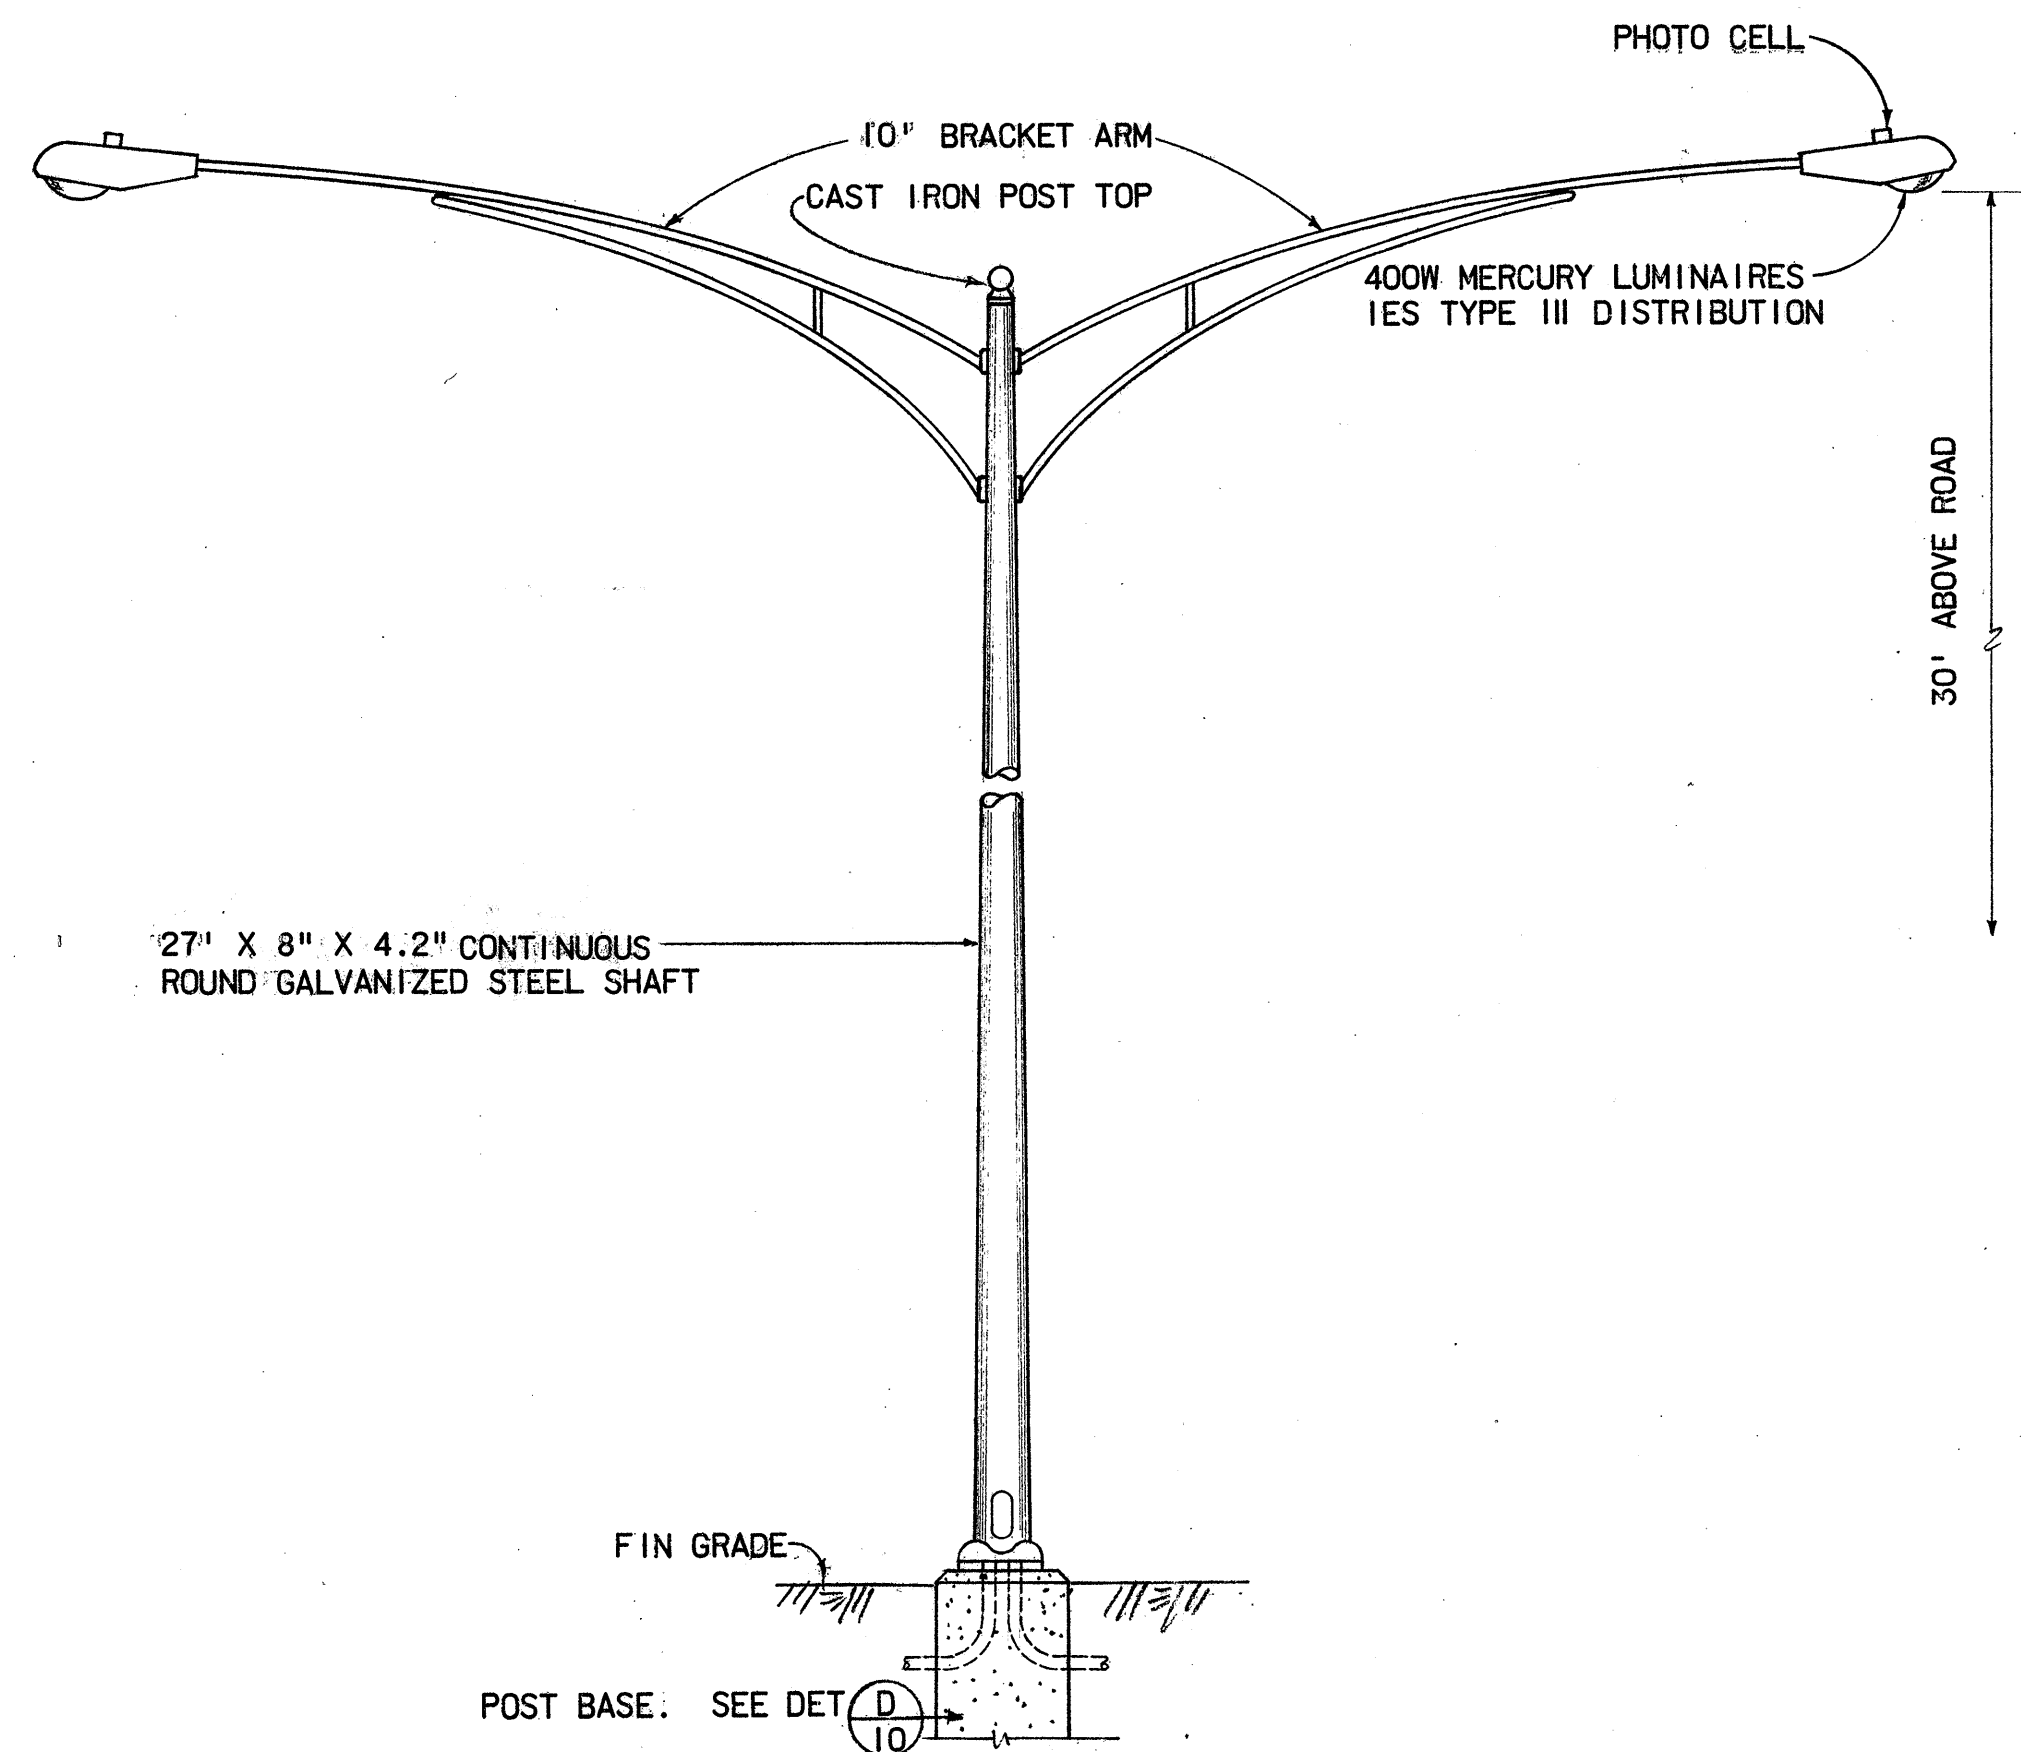

THIS WORK WAS PREPARED BY ME
OR UNDER MY SUPERVISION
Albert S. C. Chong, PE

STATE OF HAWAII DEPARTMENT OF TRANSPORTATION HIGHWAYS DIVISION

HIGHWAY LIGHTING IMPROVEMENT
ON LIKELIKE HIGHWAY
BETWEEN WILSON TUNNEL AND KAMEHAMEHA HIGHWAY
PROJECT NO. 63A-01-72
UNIT I

SHEET No. 1 OF 1 SHEETS

C.O. 6

SURVEY PLATTED BY	DATE
DRAWN BY	
DESIGNED BY	
NOTED BY	
CHECKED BY	
NO.	