



FED. ROAD DIST. NO.	STATE	PROJ. NO.	FISCAL YEAR	SHEET NO.	TOTAL SHEETS
HAWAII	HAW.	HWY-0-05-06M	2006	ADD. 25	50

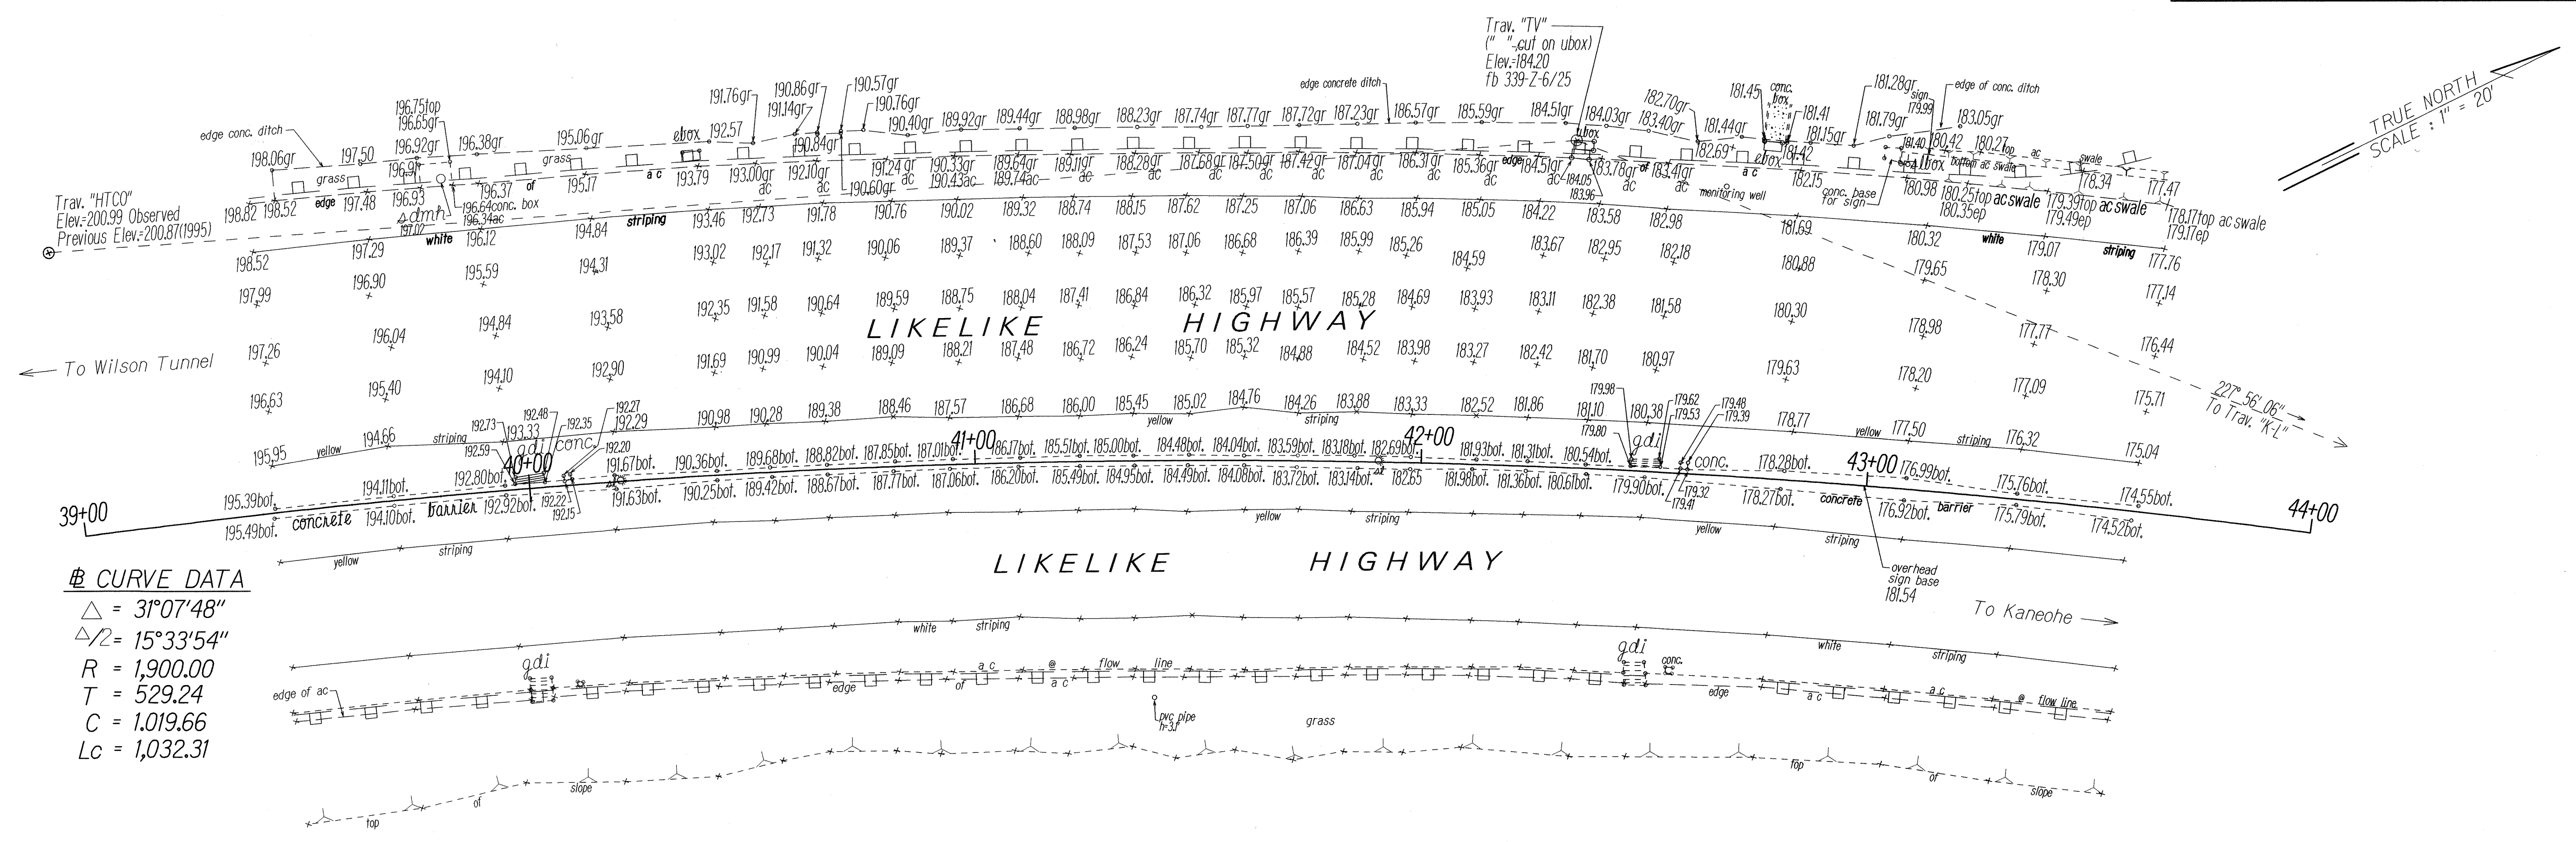

CURVE DATA
 $\Delta = 31^{\circ}07'48''$
 $\Delta/2 = 15^{\circ}33'54''$
 $R = 1,900.00$
 $T = 529.24$
 $C = 1.019.66$
 $L_c = 1,032.31$

GRADING PLAN
Scale: 1"=20'

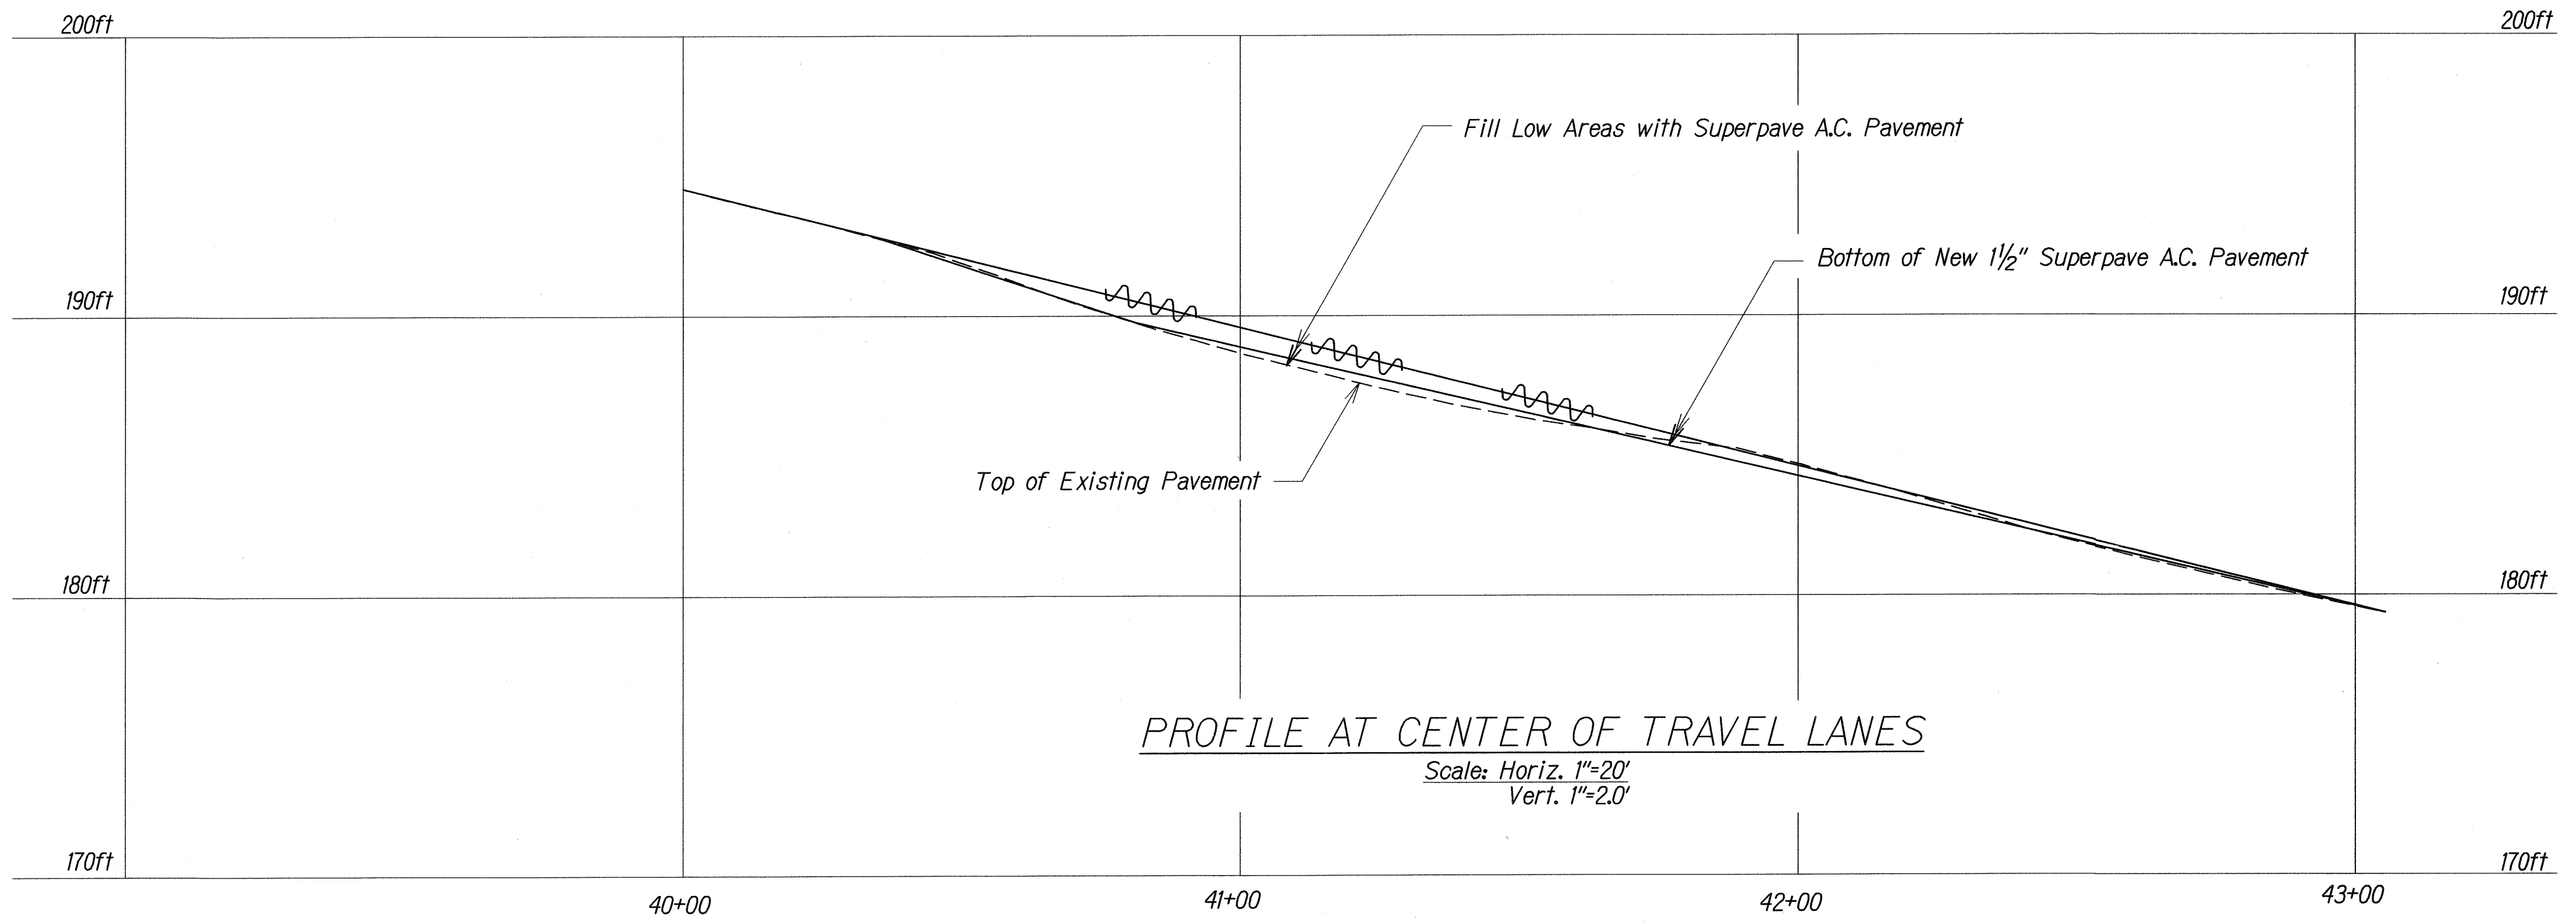

PROFILE AT CENTER OF TRAVEL LANES
Scale: Horiz. 1"=20'
Vert. 1"=2.0'

LEGEND FOR AS-BUILT POSTINGS	
	Squiggly line for as-built deletion
	Double line for as-built deletion
Roadway	Text for as-built posting

6/07/06	Added Title Block and Changed Notes.
DATE	REVISION
STATE OF HAWAII DEPARTMENT OF TRANSPORTATION HIGHWAYS DIVISION GRADING PLAN LIKELINE HIGHWAY PAVEMENT PREVENTATIVE MAINTENANCE End of Wilson Tunnel to Kamehameha Highway Project No. HWY-0-05-06M	
Scale: As Shown Date: May, 2006	
SHEET No. 1 OF 1 SHEETS	

DESIGNED BY	DATE
TRACED BY	
QUANTITIES BY	
CHECKED BY	