


FED. ROAD DIST. NO.	STATE	PROJ. NO.	FISCAL YEAR	SHEET NO.	TOTAL SHEETS
HAWAII	HAW.	HWY-0-05-06M	2006	12	50

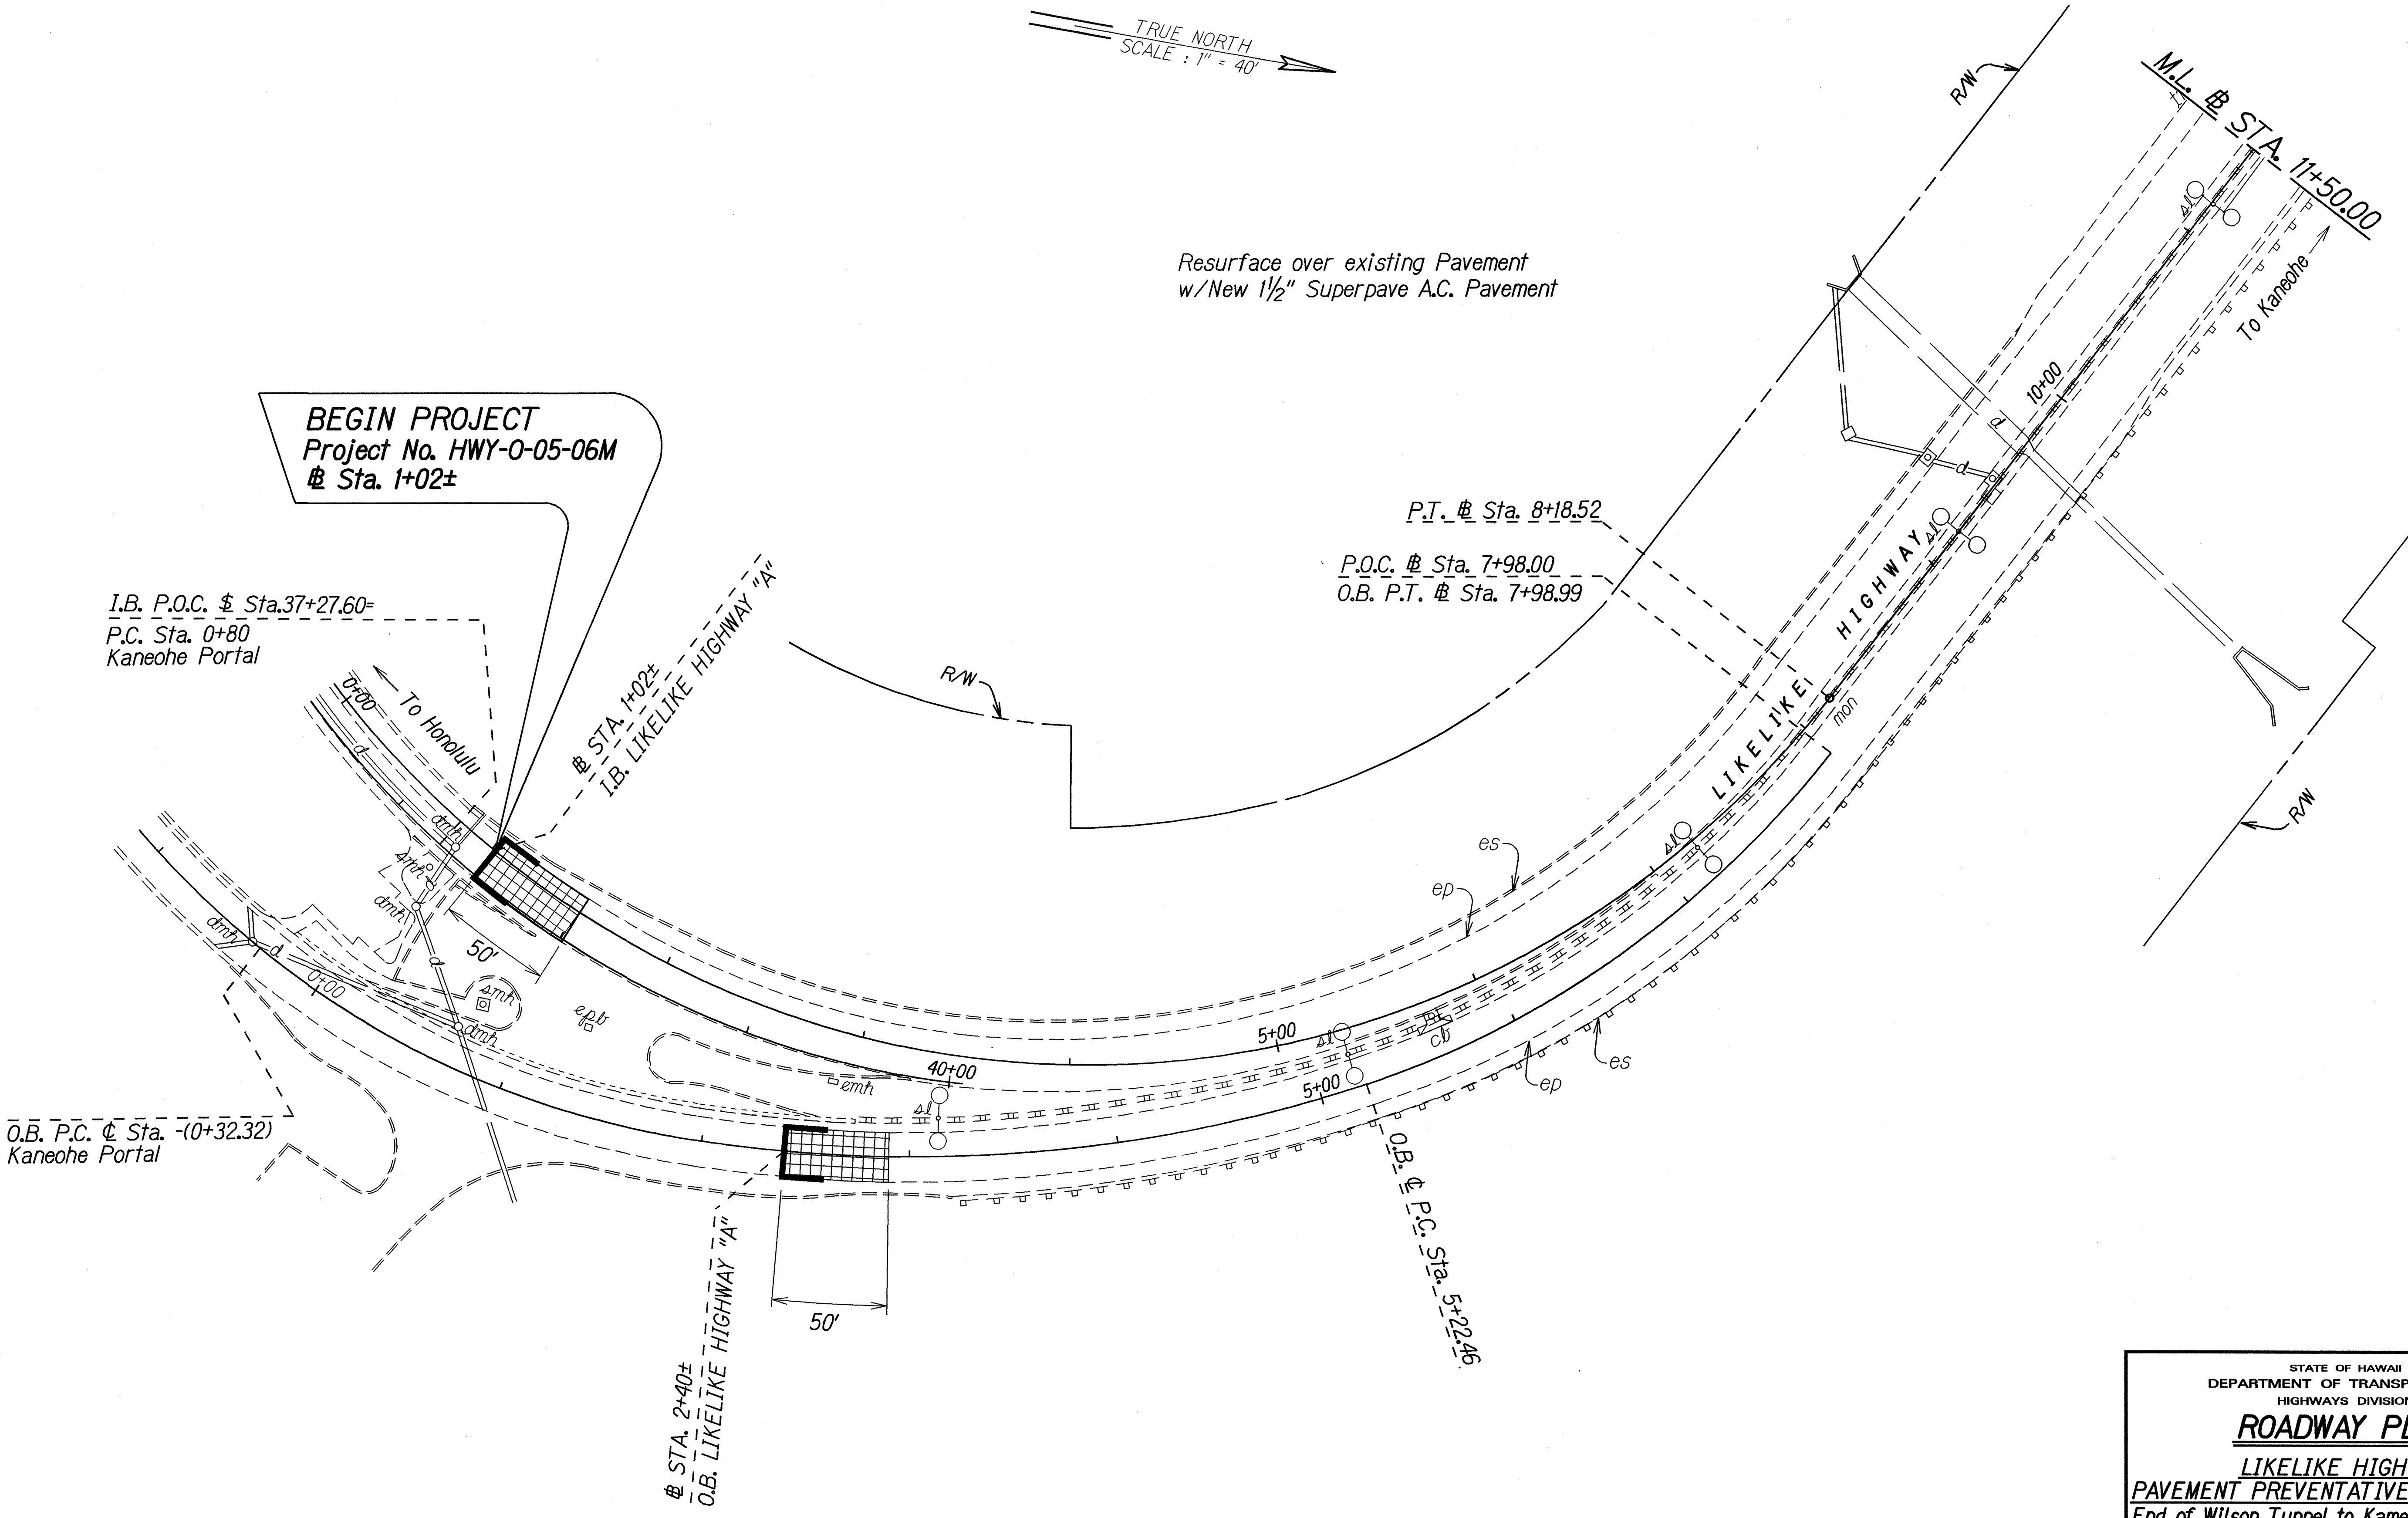


SURVEY PLOTTED BY	DATE
DRAWN BY	1/24/06
DESIGNED BY	
QUANTITIES BY	
CHECKED BY	
ORIGINAL PLAN	
NOTE BOOK	
5/16/06/06gn	
NA	

STATE OF HAWAII
DEPARTMENT OF TRANSPORTATION
HIGHWAYS DIVISION

ROADWAY PLAN
LIKELIKE HIGHWAY
PAVEMENT PREVENTATIVE MAINTENANCE
End of Wilson Tunnel to Kamehameha Highway
Project No. HWY-0-05-06M
Scale: 1"=40'


Date: May, 2006
SHEET No. 1 OF 13 SHEETS

FED. ROAD DIST. NO.	STATE	PROJ. NO.	FISCAL YEAR	SHEET NO.	TOTAL SHEETS
HAWAII	HAW.	HWY-0-05-06M	2006	13	50

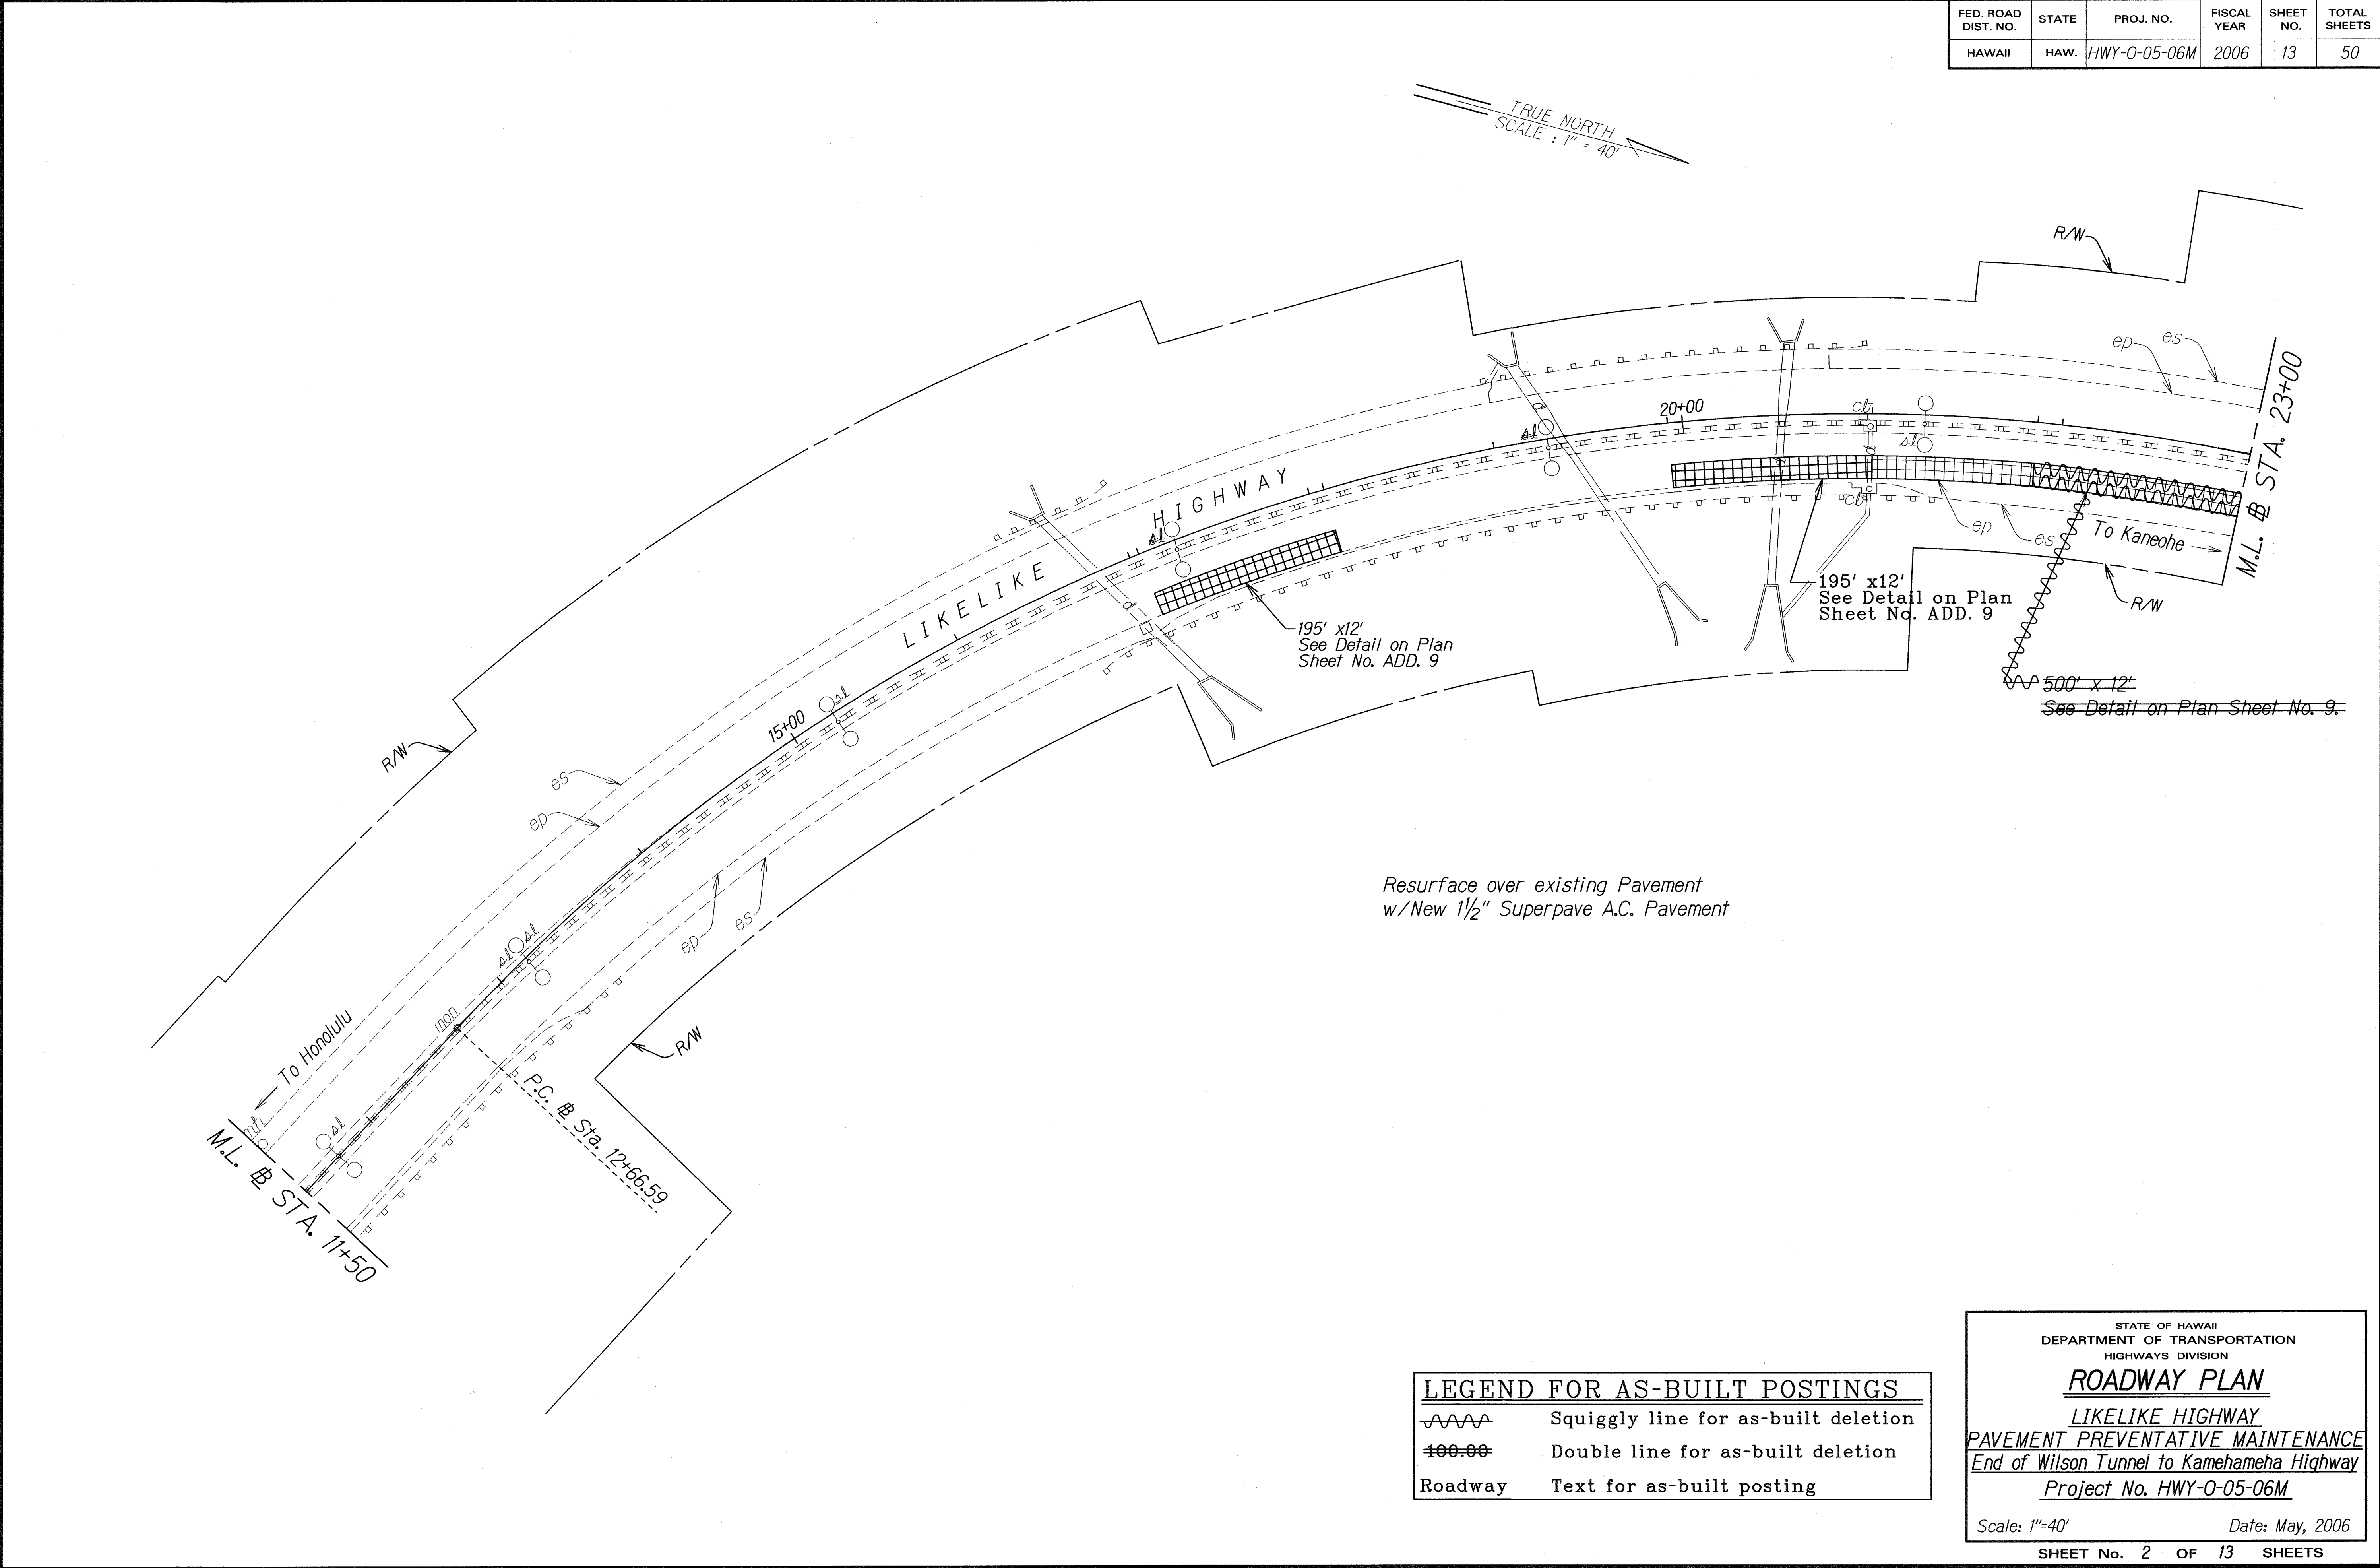

ORIGINAL PLAN	SURVEY PLOTTED BY	DATE
NOTE BOOK	DRAWN BY	
5/16/02 (gpn)	DESIGNED BY	
	QUANTITIES BY	
	CHECKED BY	

FED. ROAD DIST. NO.	STATE	PROJ. NO.	FISCAL YEAR	SHEET NO.	TOTAL SHEETS
HAWAII	HAW.	HWY-0-05-06M	2006	14	50

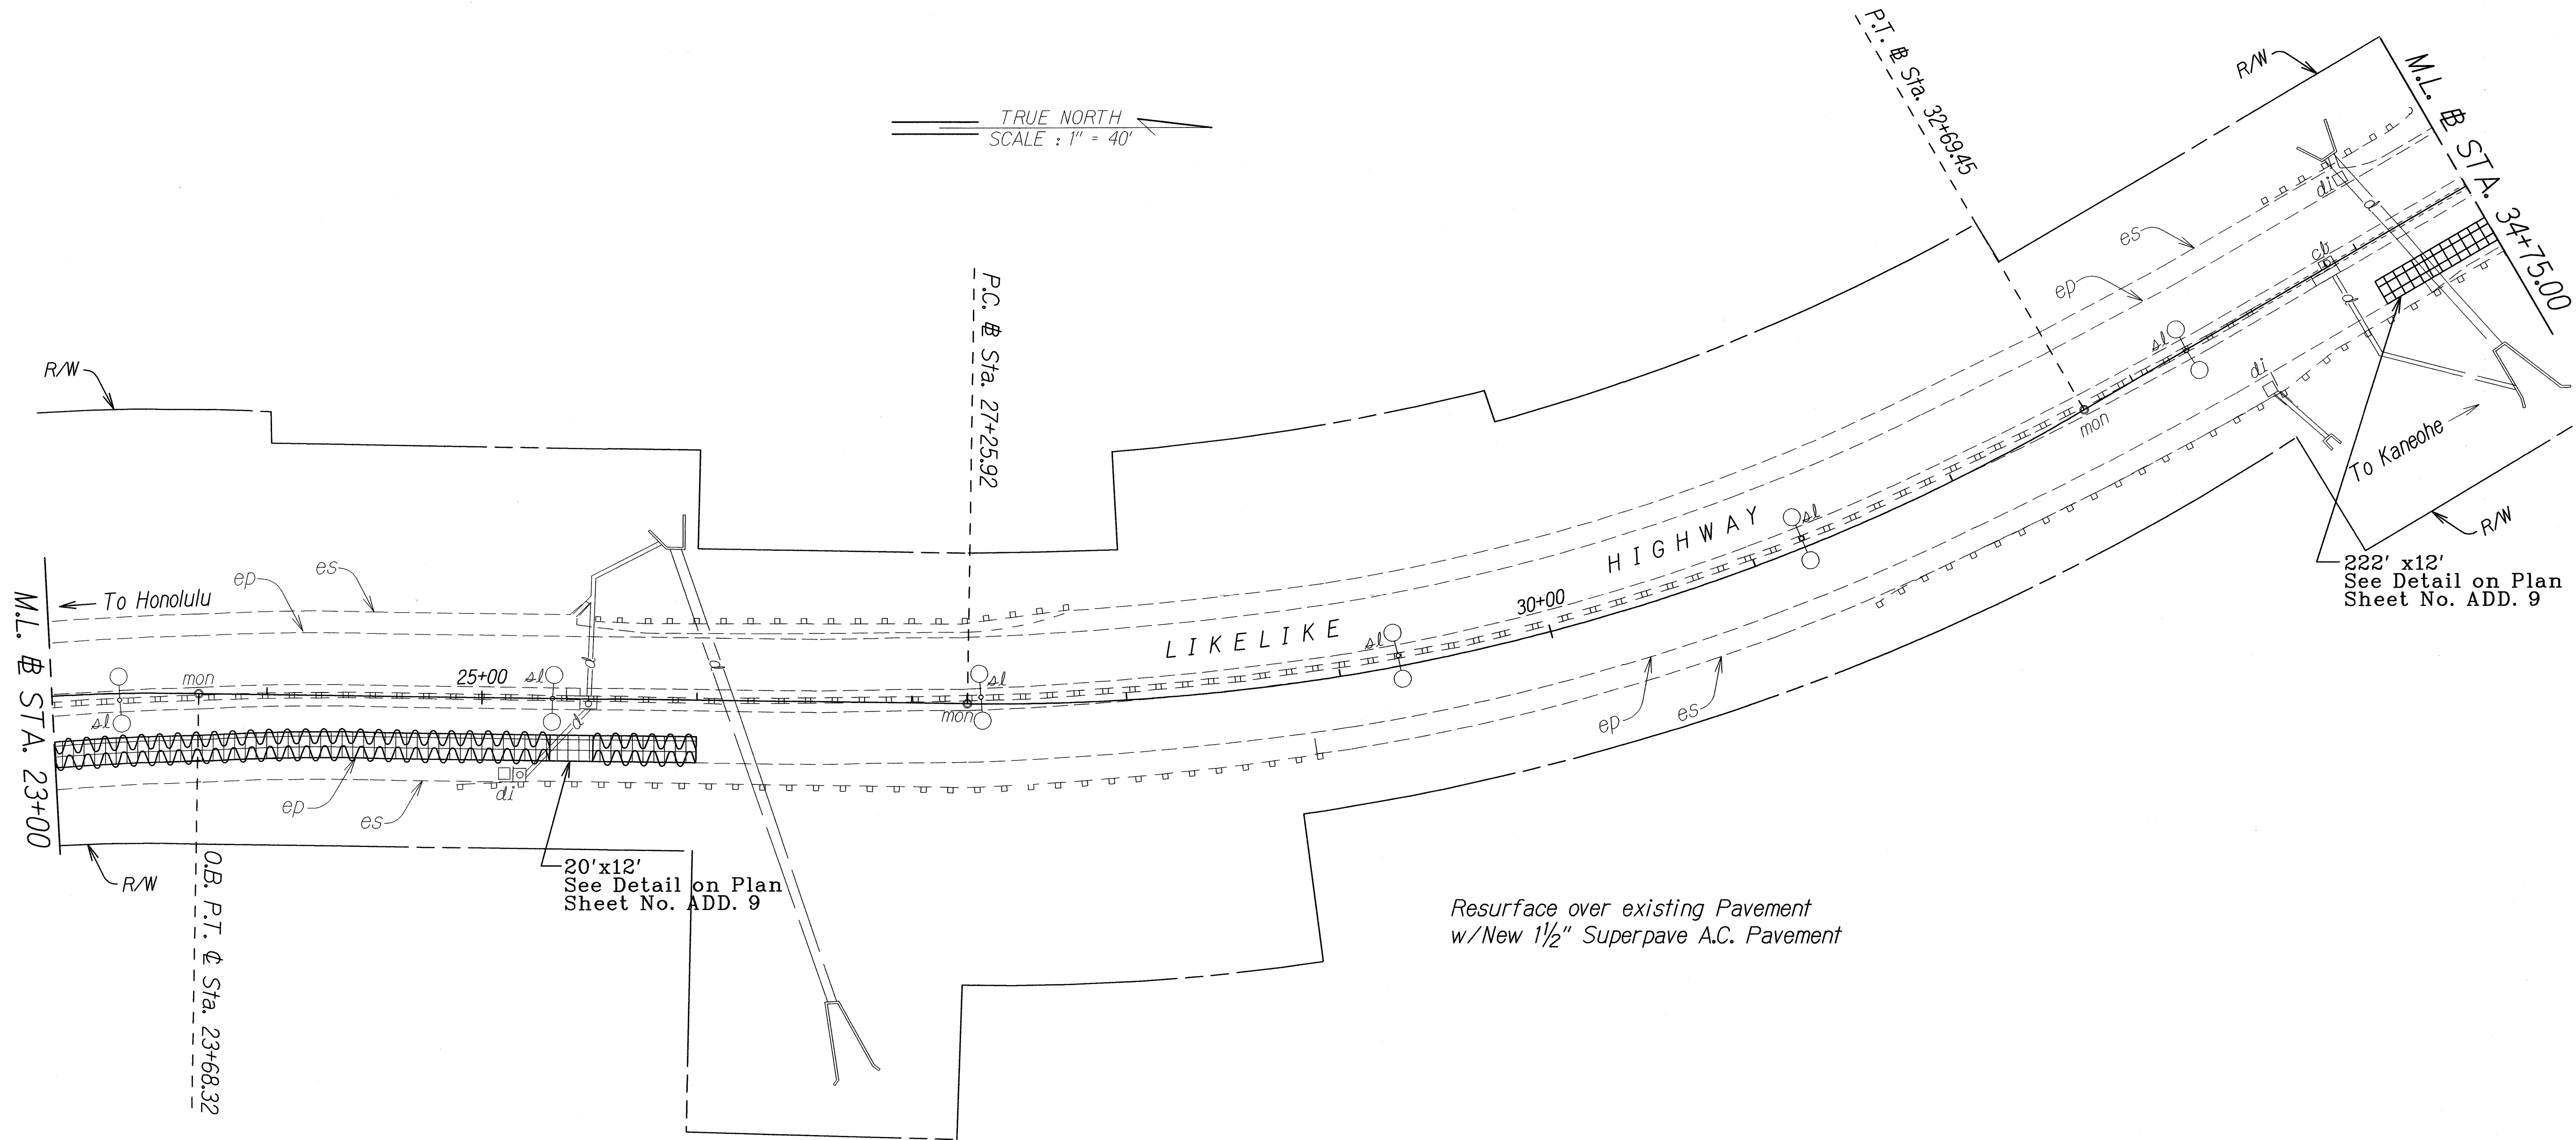

ORIGINAL PLAN	DATE
SURVEY PLOTTED BY	
DRAWN BY	
DESIGNED BY	
QUANTITIES BY	
CHECKED BY	
NOTE BOOK	
5/16/03	
N.	

LEGEND FOR AS-BUILT POSTINGS	
	Squiggly line for as-built deletion
	Double line for as-built deletion
Roadway	Text for as-built posting


STATE OF HAWAII
DEPARTMENT OF TRANSPORTATION
HIGHWAYS DIVISION

ROADWAY PLAN
LIKELINE HIGHWAY
PAVEMENT PREVENTATIVE MAINTENANCE
End of Wilson Tunnel to Kamehameha Highway
Project No. HWY-0-05-06M

Scale: 1"=40'
Date: May, 2006


SHEET No. 3 OF 13 SHEETS

FED. ROAD DIST. NO.	STATE	PROJ. NO.	FISCAL YEAR	SHEET NO.	TOTAL SHEETS
HAWAII	HAW.	HWY-0-05-06M	2006	ADD. 15	50

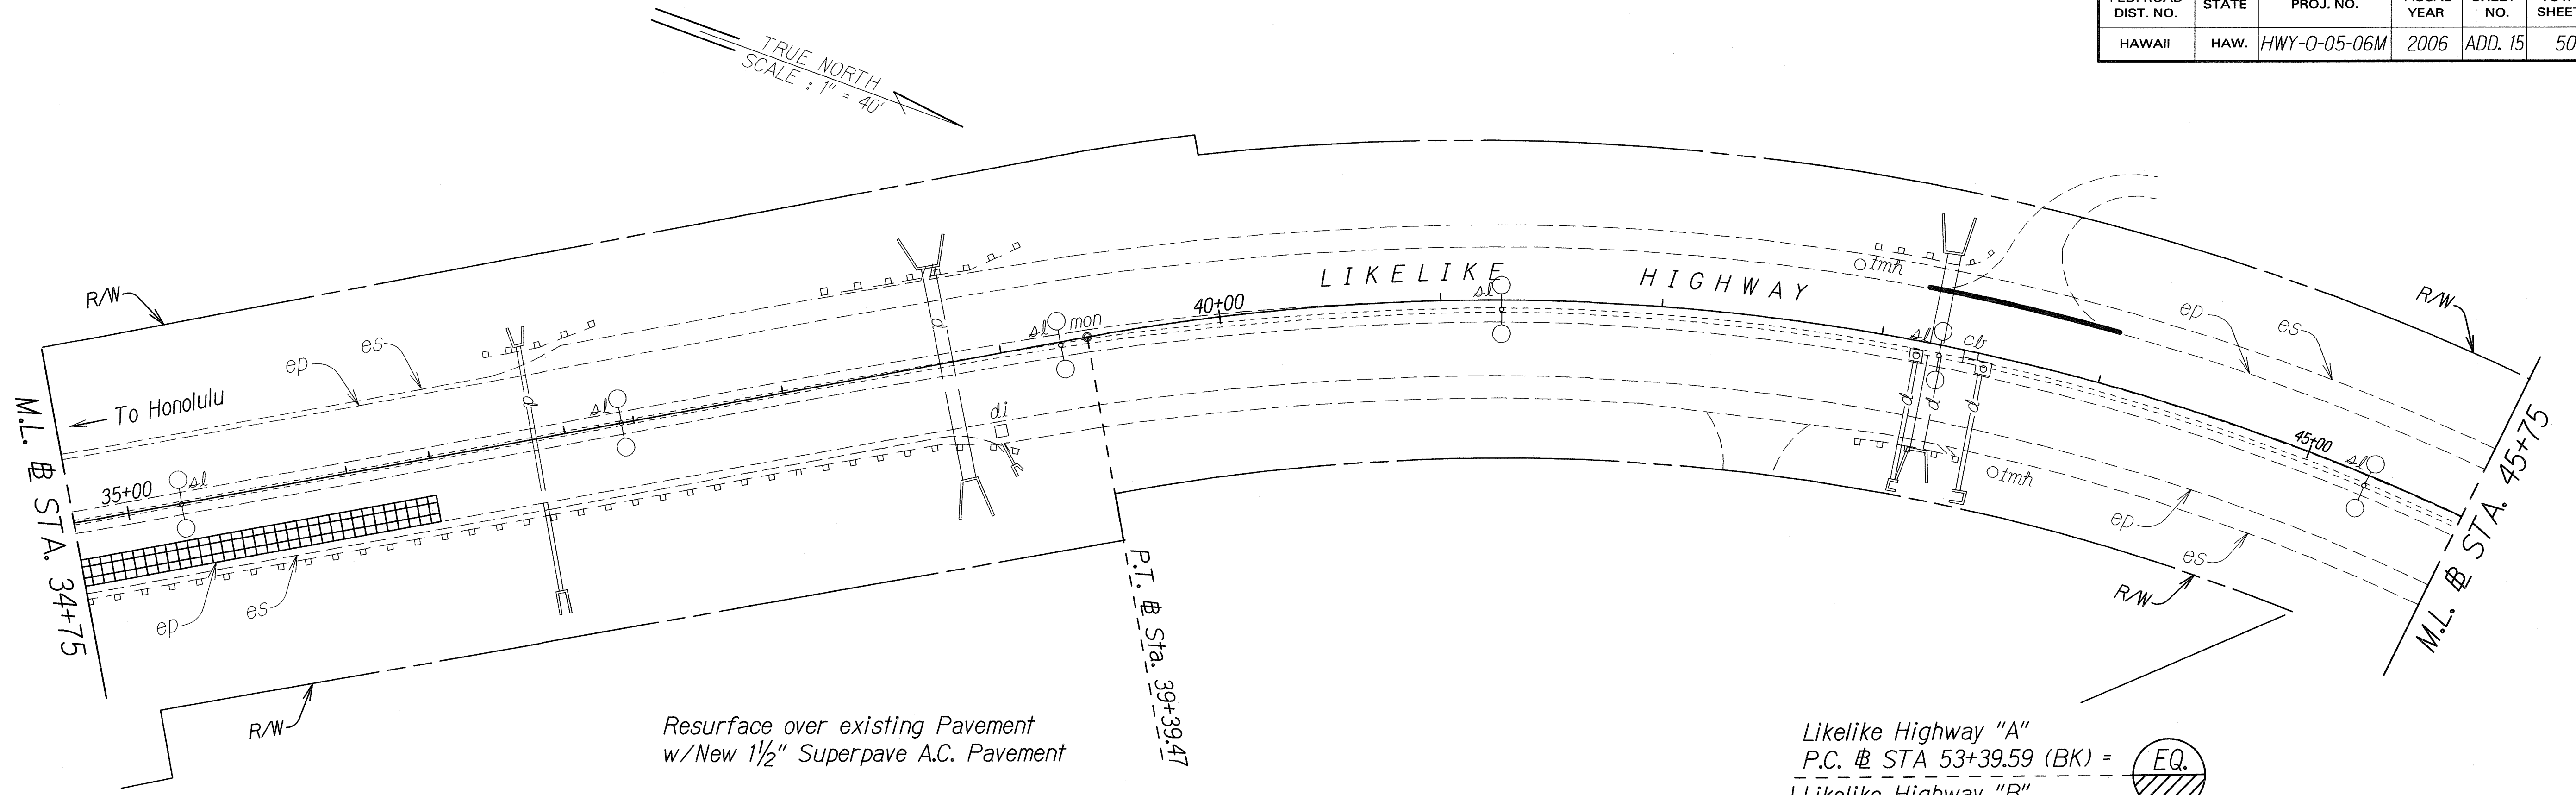

Resurface over existing Pavement
w/New 1 1/2" Superpave A.C. Pavement

Likeline Highway "A"
P.C. # Sta. 53+39.59 (BK) = EQ.
Likeline Highway "B"
Sta. 0+00 (AH) =
o/s 4.97', Rt.

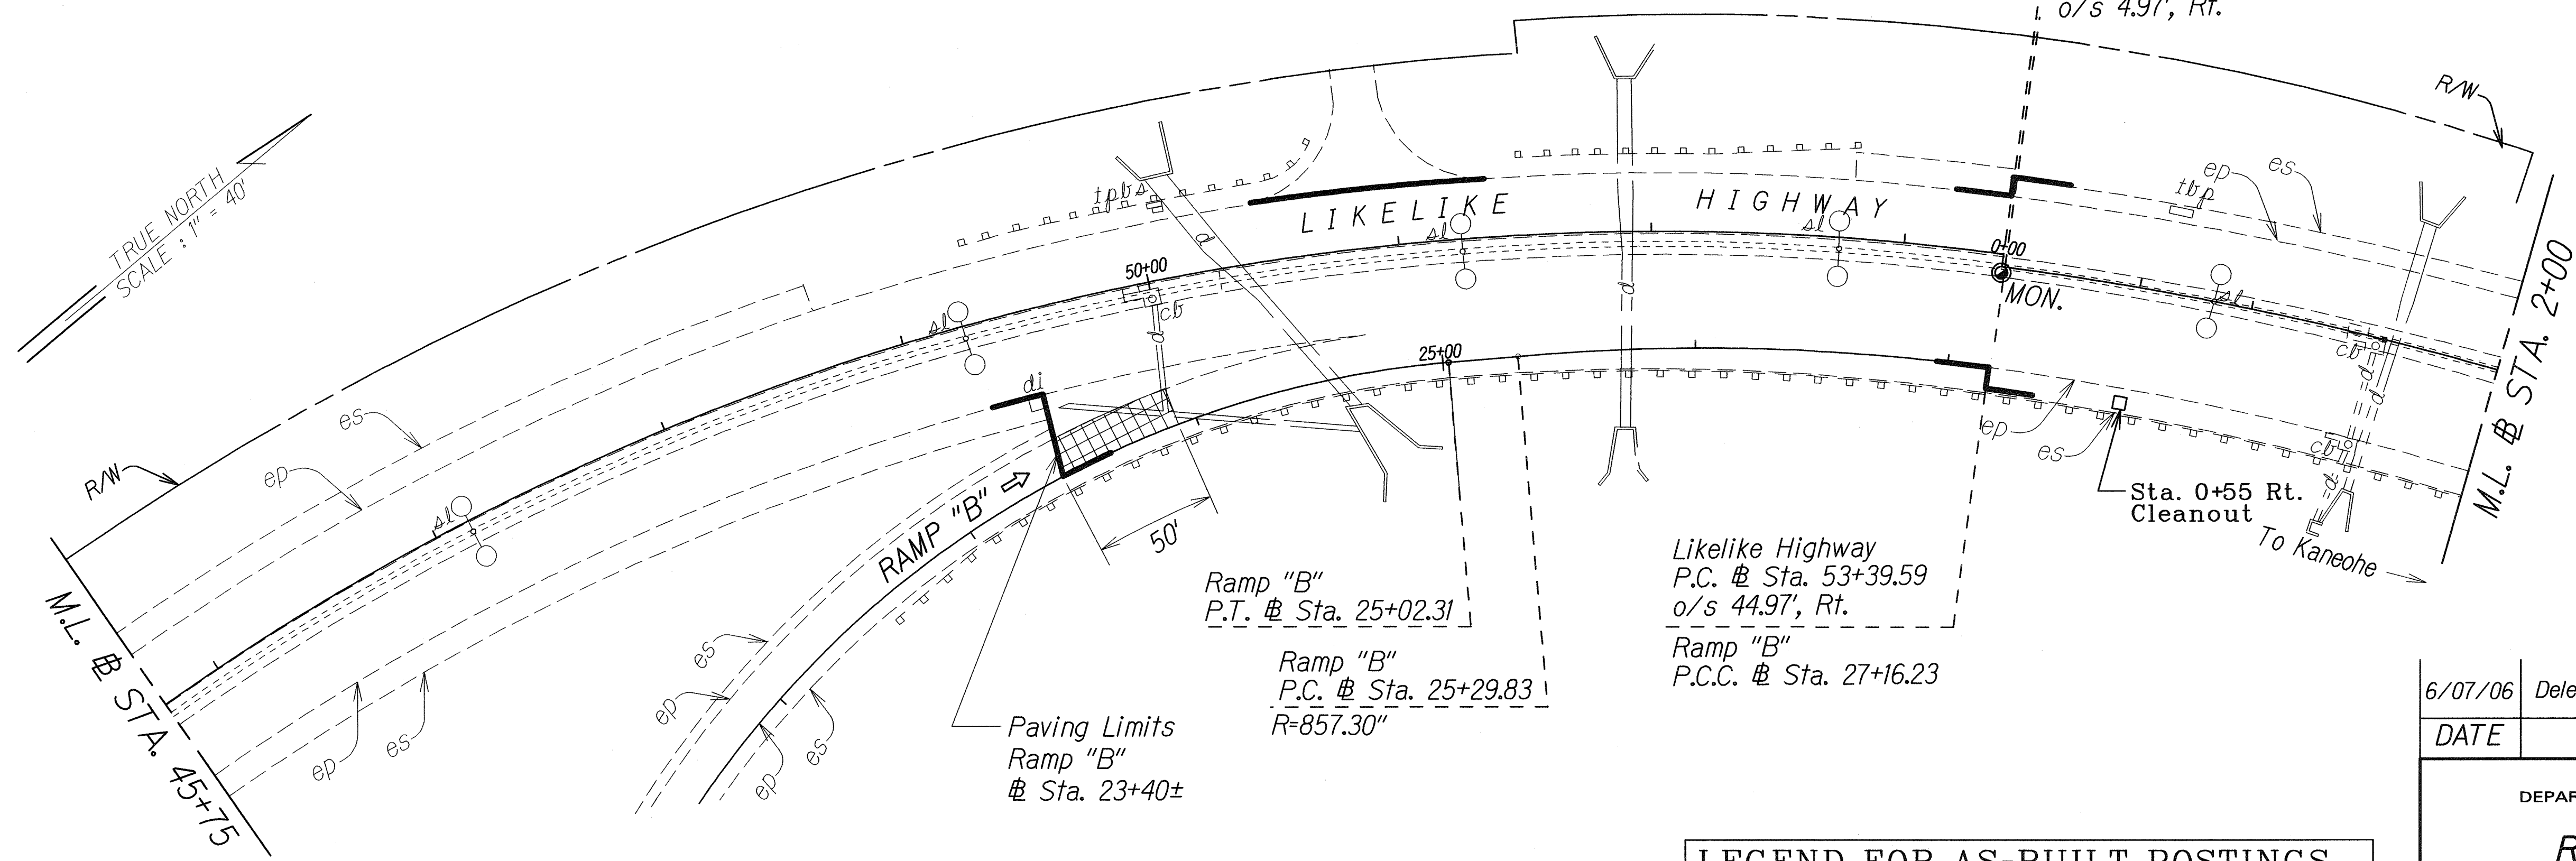

Ramp "B"
P.T. # Sta. 25+02.31

Ramp "B"
P.C. # Sta. 25+29.83
R=857.30"

Paving Limits
Ramp "B"
Sta. 23+40±

Likeline Highway
P.C. # Sta. 53+39.59
o/s 44.97', Rt.
Ramp "B"
P.C.C. # Sta. 27+16.23

Sta. 0+55 Rt.
Cleanout
To Kaneohe

LEGEND FOR AS-BUILT POSTINGS	
	Squiggly line for as-built deletion
	Double line for as-built deletion
Roadway	Text for as-built posting


6/07/06	Deleted Cleanouts.
DATE	REVISION
STATE OF HAWAII DEPARTMENT OF TRANSPORTATION HIGHWAYS DIVISION	
ROADWAY PLAN	
LIKELINE HIGHWAY	
PAVEMENT PREVENTATIVE MAINTENANCE	
End of Wilson Tunnel to Kamehameha Highway	
Project No. HWY-0-05-06M	
Scale: 1"=40'	Date: May, 2006
SHEET No. 4 OF 13 SHEETS	

ORIGINAL PLAN	DATE
SURVEY PLOTTED BY	
DESIGNED BY	
QUANTITIES BY	
CHECKED BY	

AS-BUILT

ADD. 15

FED. ROAD DIST. NO.	STATE	PROJ. NO.	FISCAL YEAR	SHEET NO.	TOTAL SHEETS
HAWAII	HAW.	HWY-0-05-06M	2006	ADD. 16	50

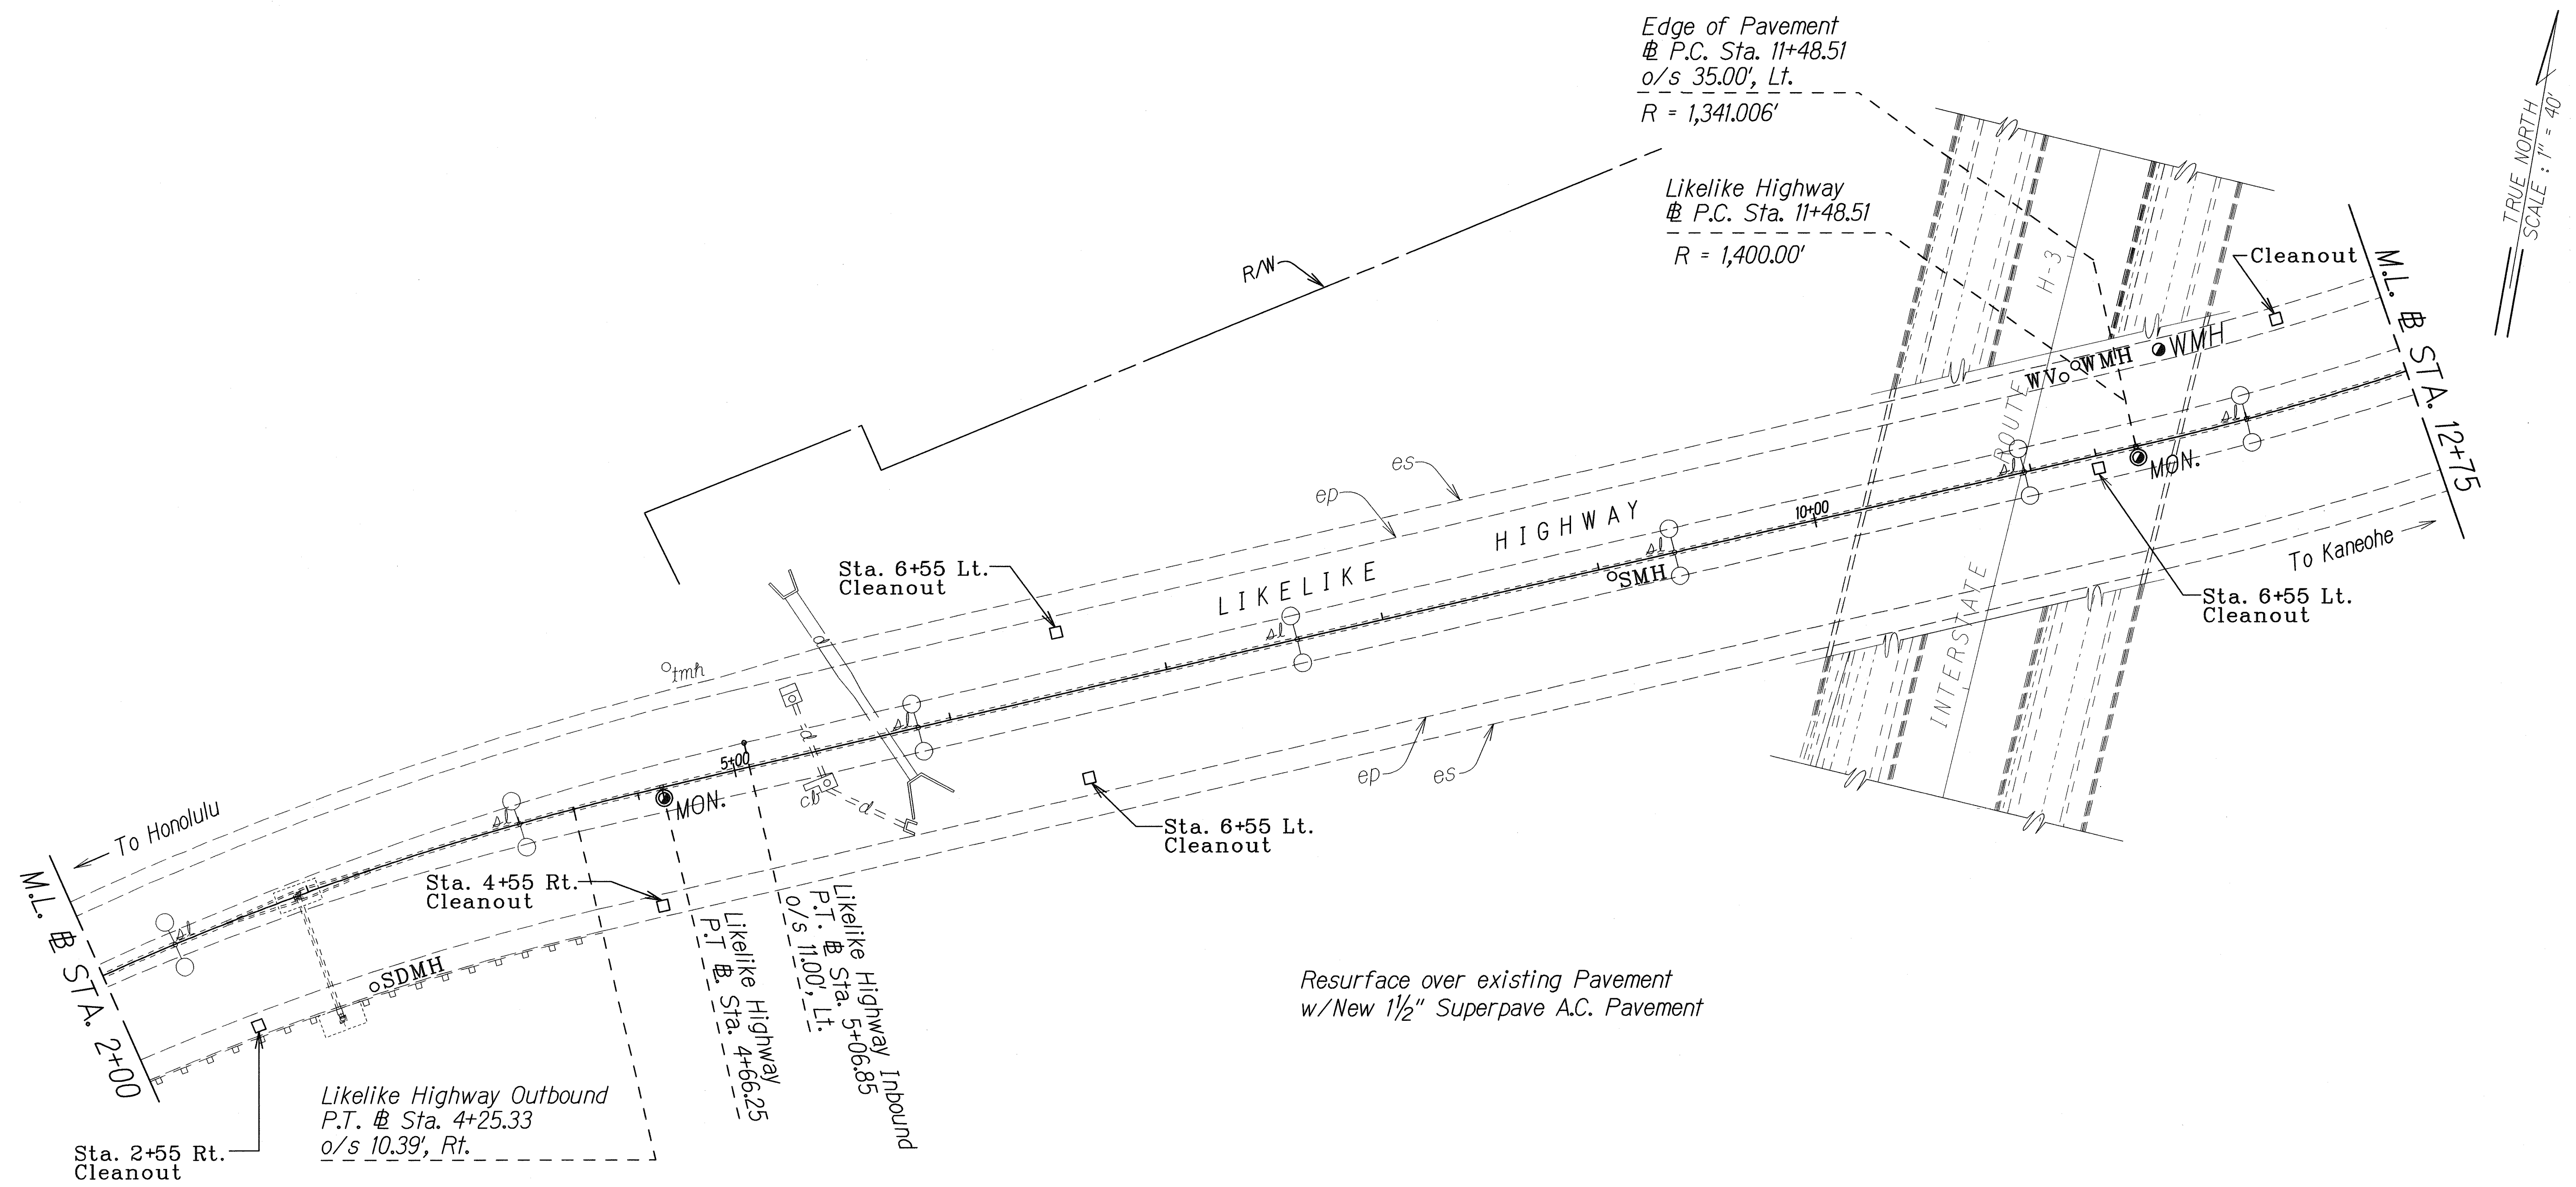

SURVEY PLANNED BY	DATE
DESIGNED BY	
QUANTITIES BY	
CHECKED BY	
NOTED BY	
DATE	


LEGEND FOR AS-BUILT POSTINGS	
	Squiggly line for as-built deletion
	Double line for as-built deletion
Roadway	Text for as-built posting

6/08/06	Deleted Cleanouts.
DATE	REVISION
STATE OF HAWAII DEPARTMENT OF TRANSPORTATION HIGHWAYS DIVISION ROADWAY PLAN LIKELIKE HIGHWAY PAVEMENT PREVENTATIVE MAINTENANCE End of Wilson Tunnel to Kamehameha Highway Project No. HWY-0-05-06M	
Scale: 1"=40'	Date: May, 2006
SHEET No. 5 OF 13 SHEETS	

AS-BUILT

ADD. 16

FED. ROAD DIST. NO.	STATE	PROJ. NO.	FISCAL YEAR	SHEET NO.	TOTAL SHEETS
HAWAII	HAW.	HWY-0-05-06M	2006	ADD. 17	50

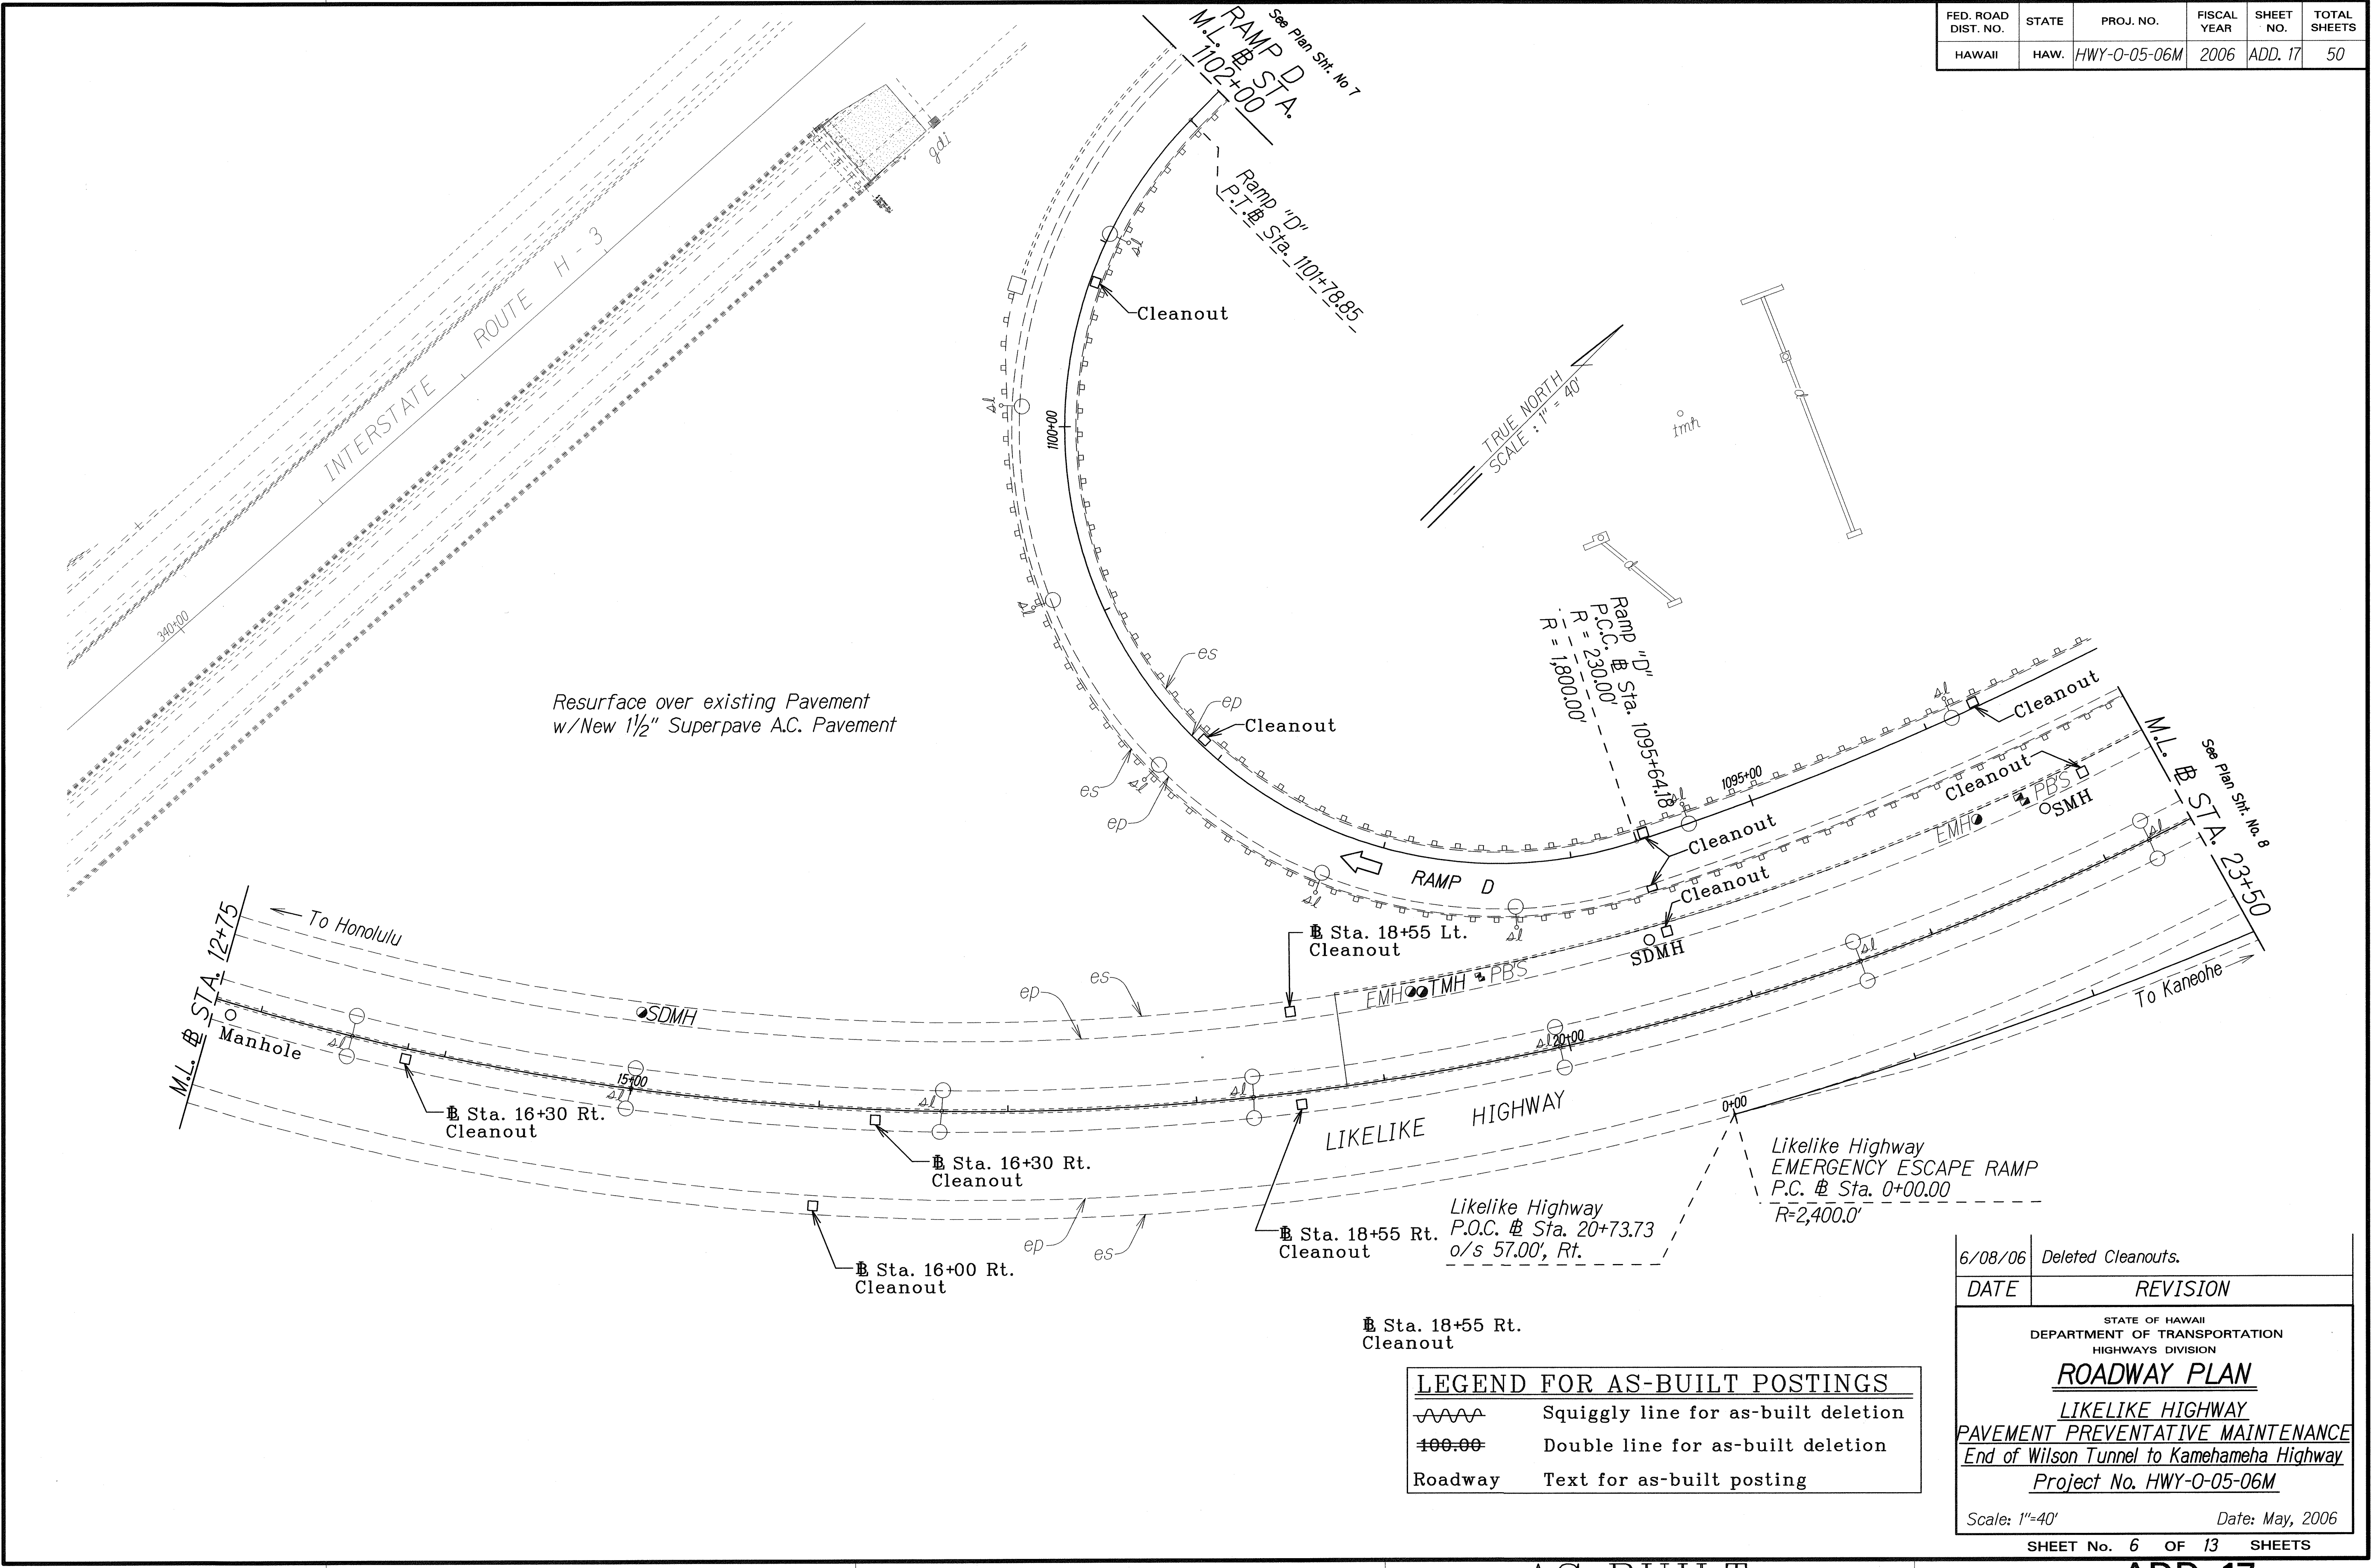


ORIGINAL PLAN	DATE
DESIGNED BY	
TRACED BY	
QUANTITIES BY	
CHECKED BY	

LEGEND FOR AS-BUILT POSTINGS	
	Squiggly line for as-built deletion
	Double line for as-built deletion
Roadway	Text for as-built posting

6/08/06	Deleted Cleanouts.
DATE	REVISION
STATE OF HAWAII DEPARTMENT OF TRANSPORTATION HIGHWAYS DIVISION	
ROADWAY PLAN	
LIKELINE HIGHWAY	
PAVEMENT PREVENTATIVE MAINTENANCE	
End of Wilson Tunnel to Kamehameha Highway	
Project No. HWY-0-05-06M	
Scale: 1"=40'	Date: May, 2006
SHEET No. 6 OF 13 SHEETS	

FED. ROAD DIST. NO.	STATE	PROJ. NO.	FISCAL YEAR	SHEET NO.	TOTAL SHEETS
HAWAII	HAW.	HWY-0-05-06M	2006	18	50

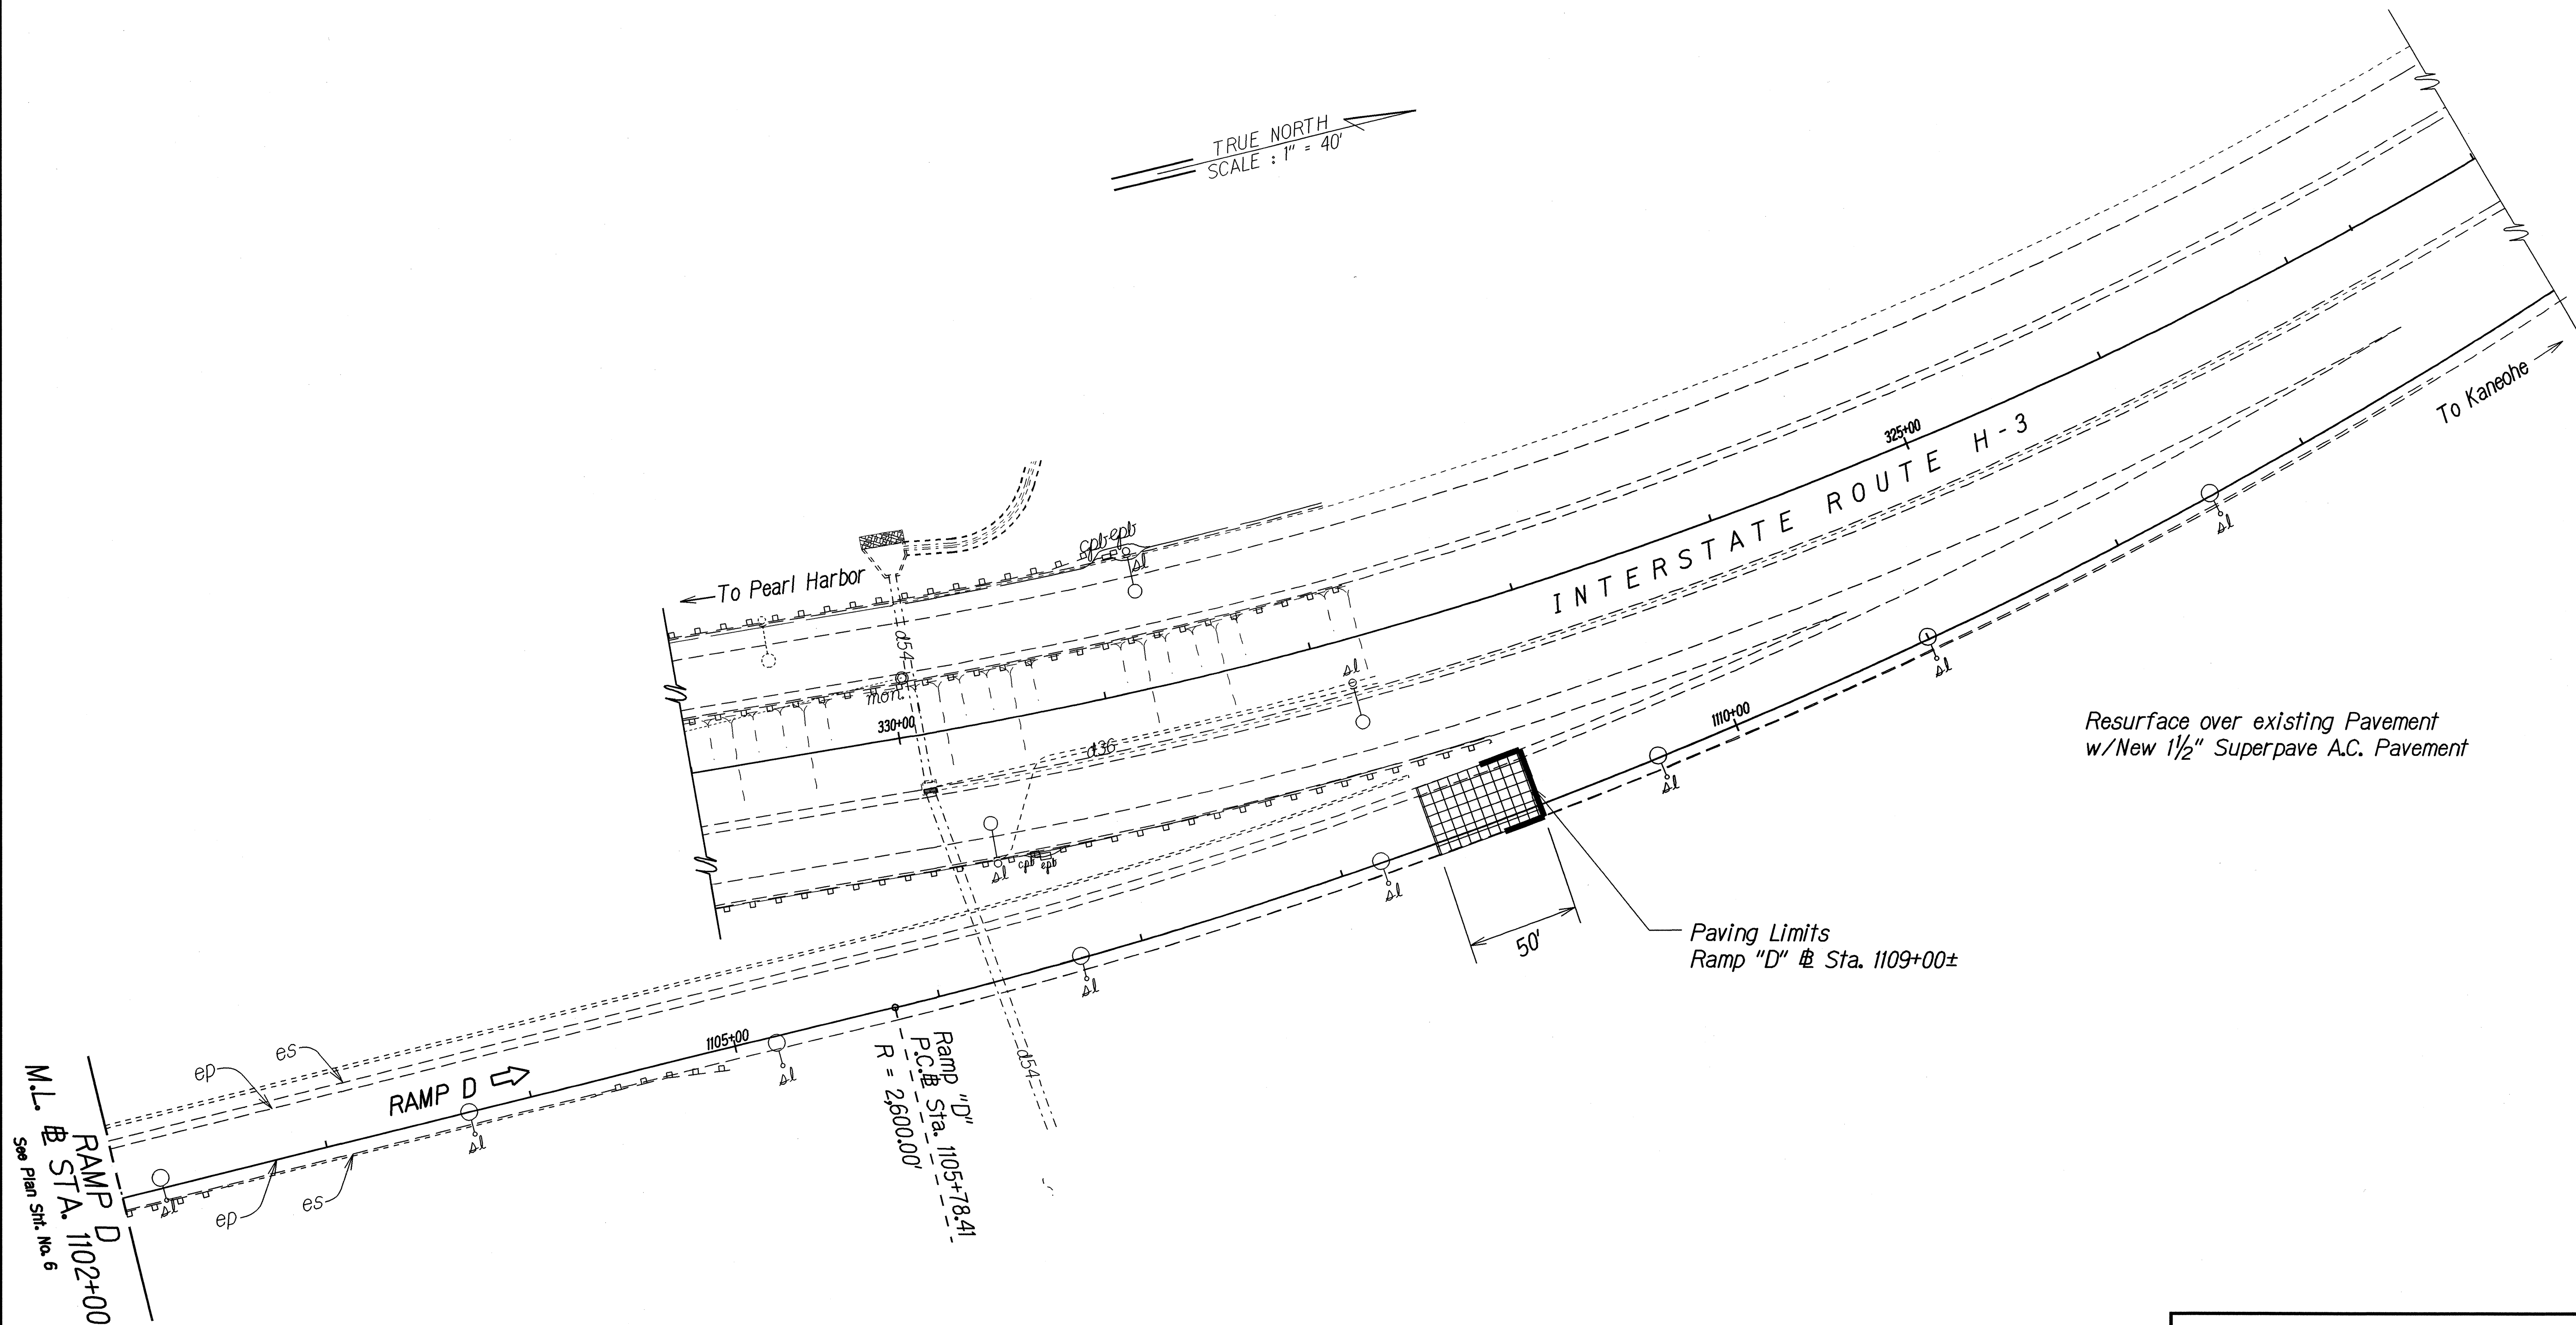


SURVEY PLOTTED BY	DATE
DRAWN BY	
DESIGNED BY	
QUANTITIES BY	
CHECKED BY	
ORIGINAL PLAN	
NOTE BOOK	
5/16/07	
N	

STATE OF HAWAII
DEPARTMENT OF TRANSPORTATION
HIGHWAYS DIVISION

ROADWAY PLAN
LIKELIKE HIGHWAY
PAVEMENT PREVENTATIVE MAINTENANCE
End of Wilson Tunnel to Kamehameha Highway
Project No. HWY-0-05-06M
Scale: 1"=40'

Date: May, 2006
SHEET No. 7 OF 13 SHEETS

FED. ROAD DIST. NO.	STATE	PROJ. NO.	FISCAL YEAR	SHEET NO.	TOTAL SHEETS
HAWAII	HAW.	HWY-0-05-06M	2006	ADD. 19	50

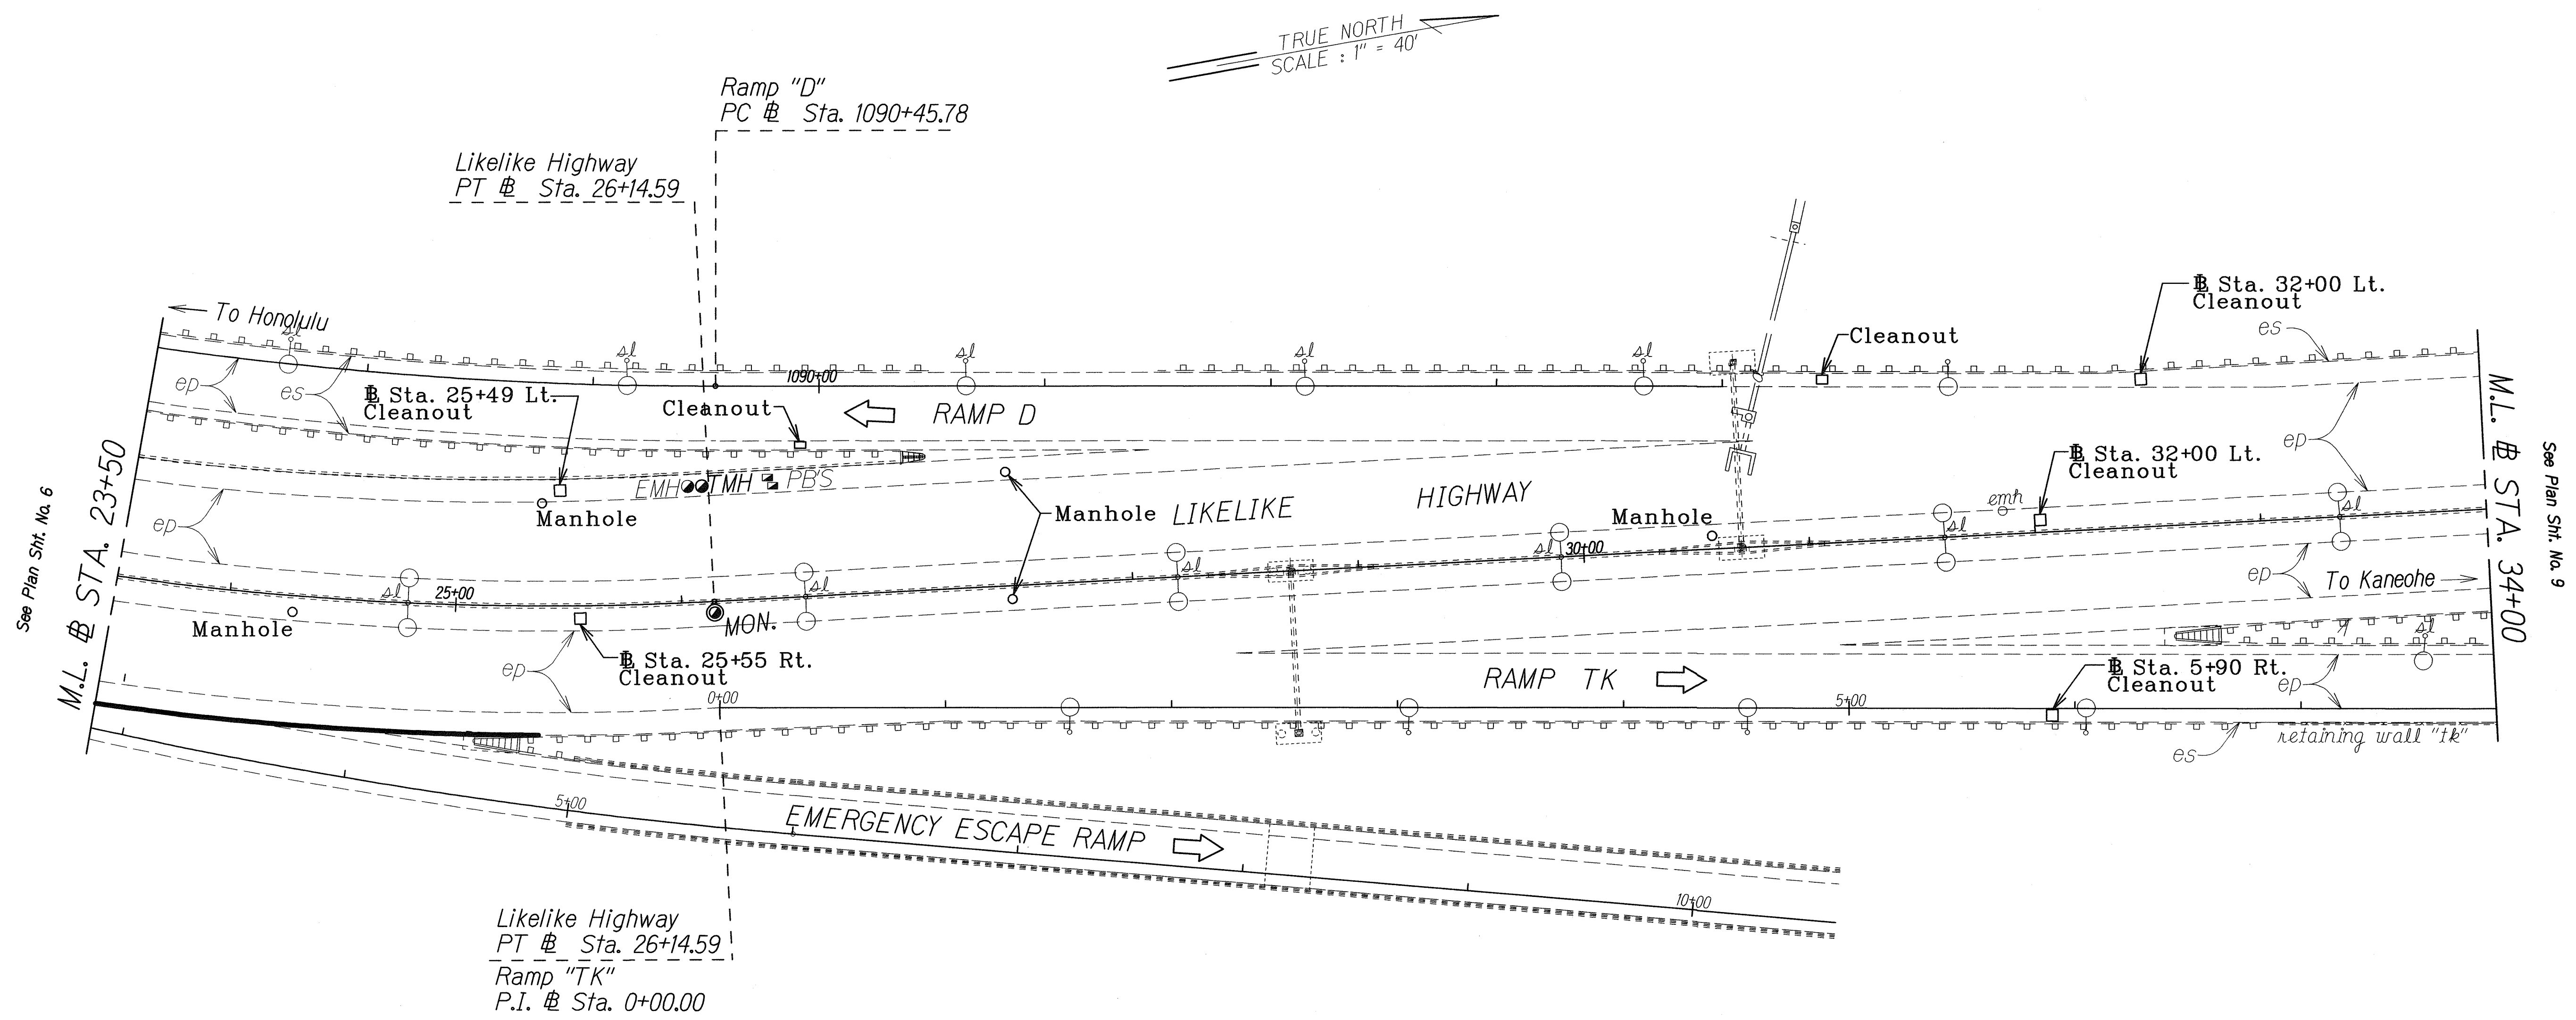

Likeline Highway
 PT @ Sta. 26+14.59
 Ramp "TK"
 P.I. @ Sta. 0+00.00

Resurface over existing Pavement
 w/New 1 1/2" Superpave A.C. Pavement

ORIGINAL PLAN	DATE
DESIGNED BY	
DRAWN BY	
CHECKED BY	
IN CHARGE	

LEGEND FOR AS-BUILT POSTINGS	
	Squiggly line for as-built deletion
	Double line for as-built deletion
Roadway	Text for as-built posting


6/08/06	Deleted Cleanouts.
DATE	REVISION
STATE OF HAWAII DEPARTMENT OF TRANSPORTATION HIGHWAYS DIVISION ROADWAY PLAN LIKELINE HIGHWAY PAVEMENT PREVENTATIVE MAINTENANCE End of Wilson Tunnel to Kamehameha Highway Project No. HWY-0-05-06M Scale: 1"=40' Date: May, 2006	
SHEET No. 8 OF 13 SHEETS	

AS-BUILT

ADD. 19

FED. ROAD DIST. NO.	STATE	PROJ. NO.	FISCAL YEAR	SHEET NO.	TOTAL SHEETS
HAWAII	HAW.	HWY-0-05-06M	2006	ADD. 20	50

Likeline Hwy @ Sta. 40+00 to @ Sta. 43+00, Lt.
 Fill In Dip in Roadway with New Superpave Pavement.
 See Plan Sheet No. 25 for Existing Grading Plan and Profile.

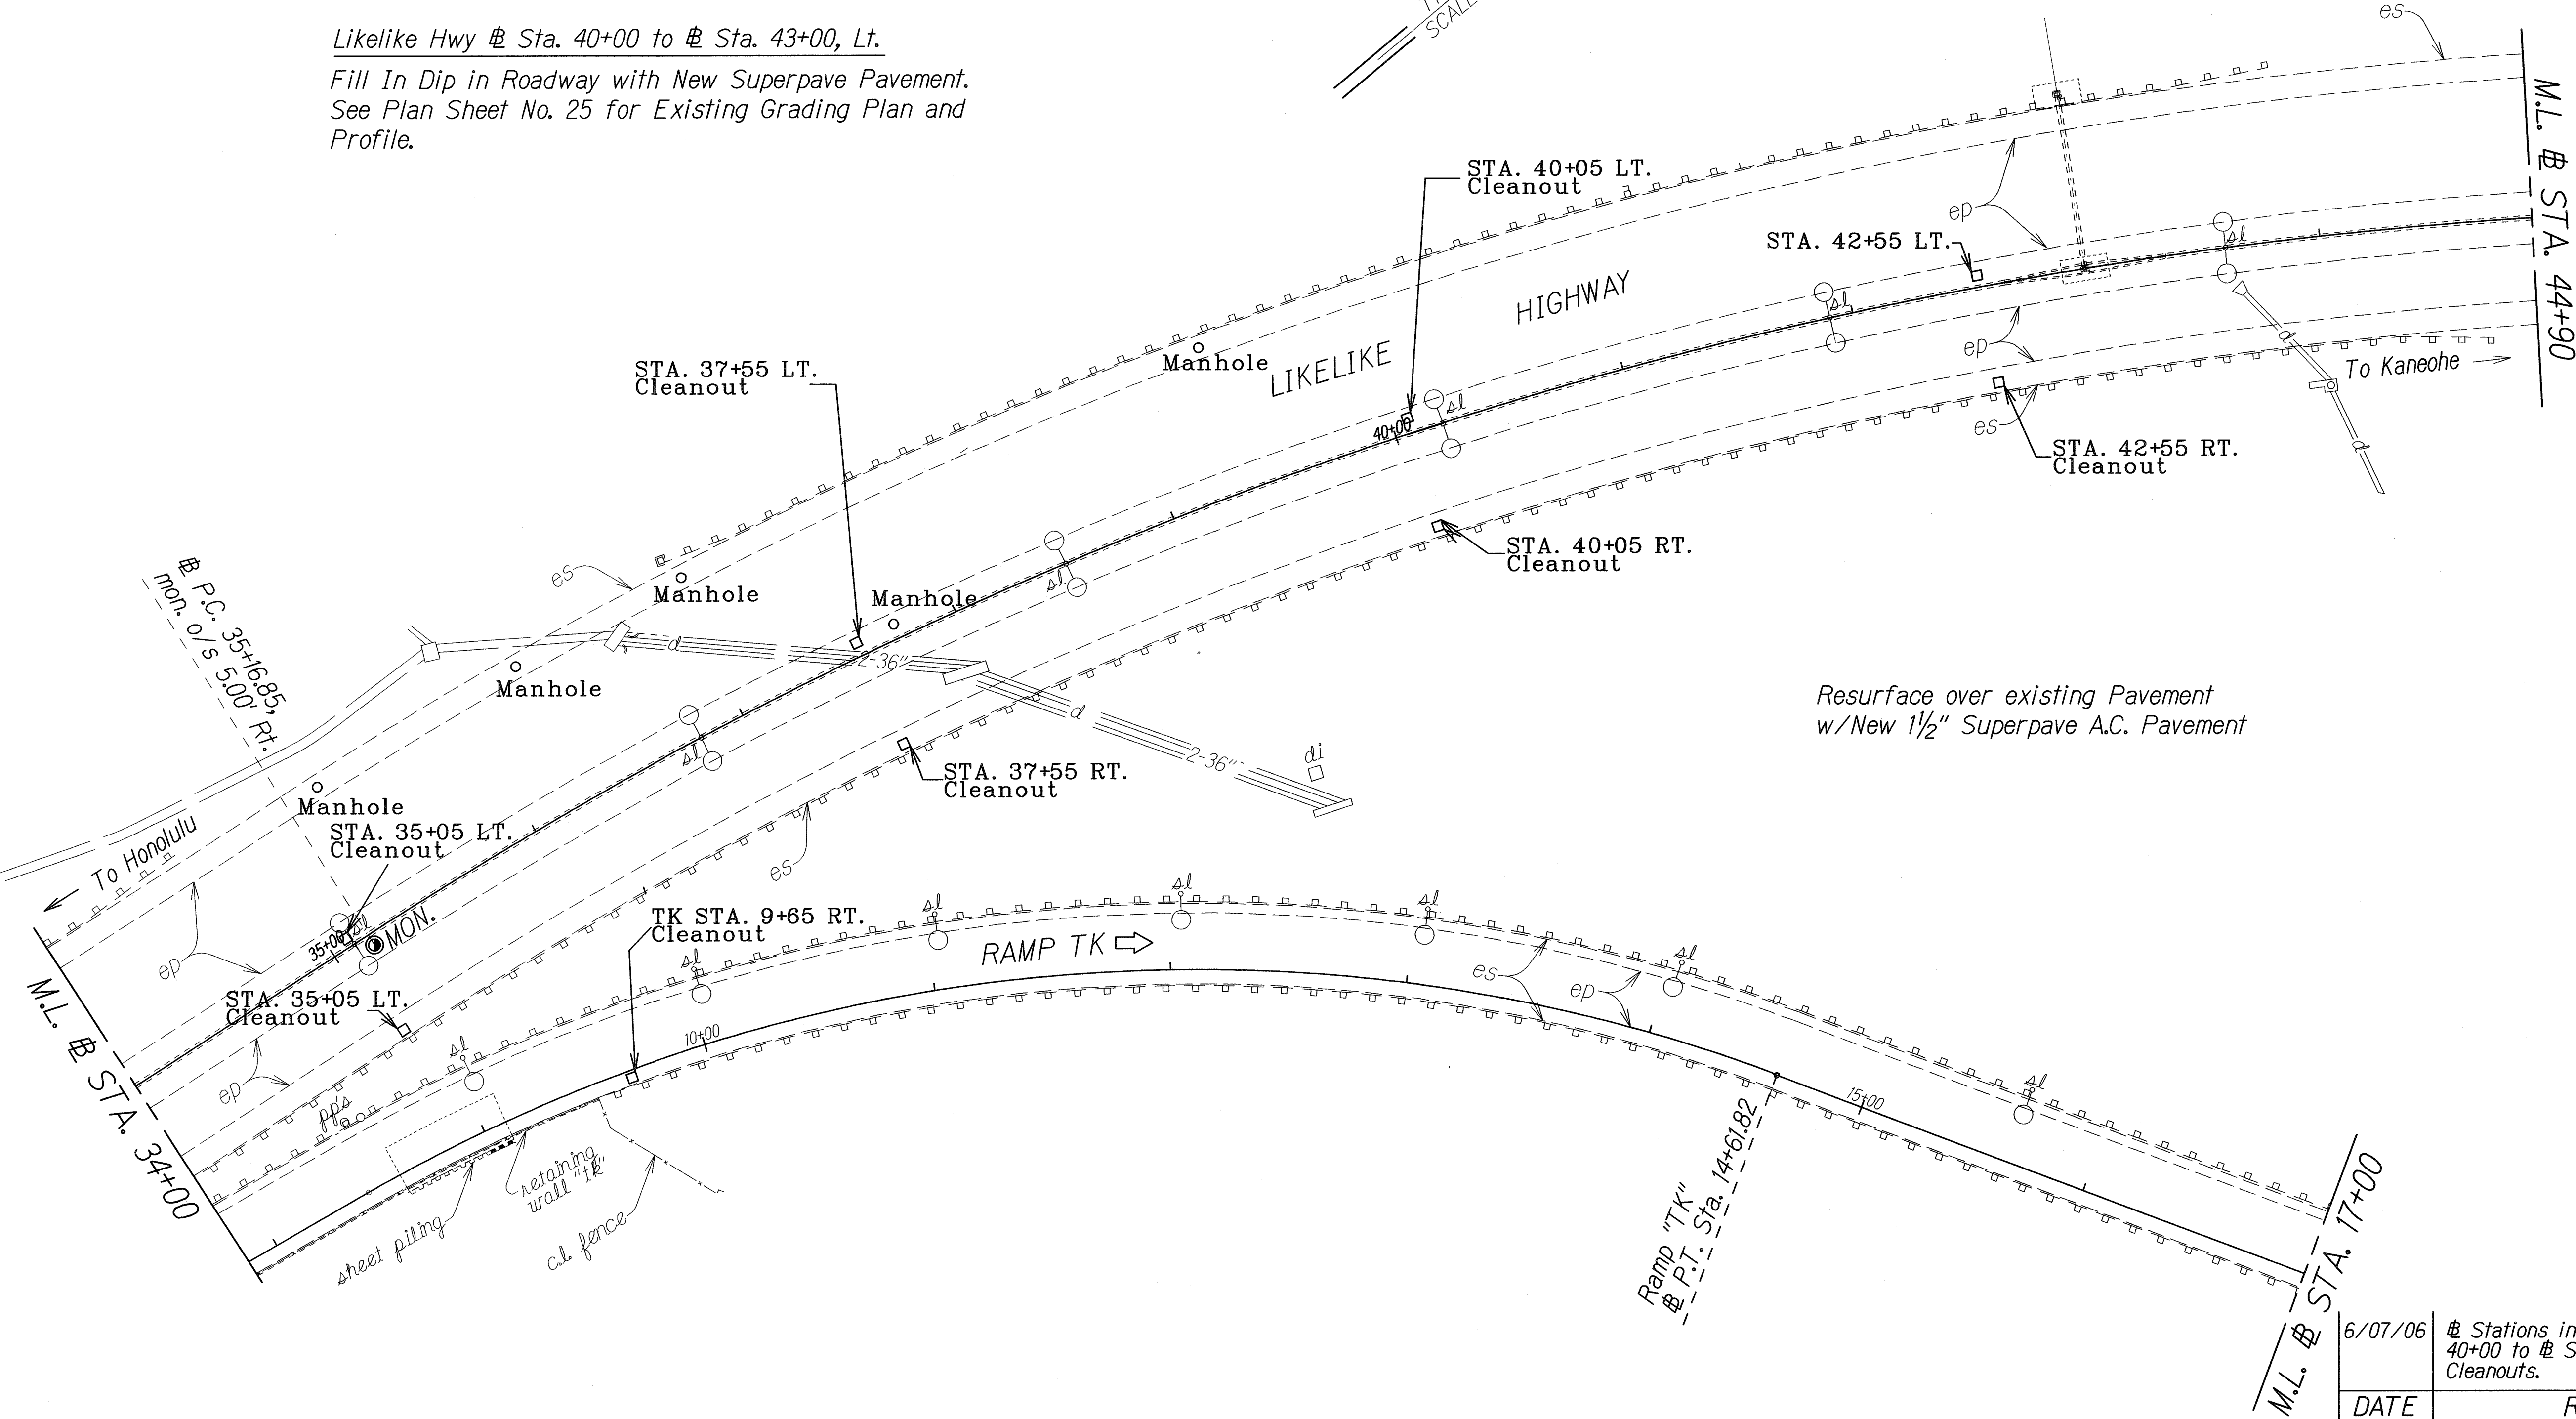

Resurface over existing Pavement
 w/ New 1 1/2" Superpave A.C. Pavement

ORIGINAL PLAN	SURVEY PLOTTED BY	DATE
NOTE BOOK	DRAWN BY	
DESIGNED BY	CHECKED BY	
QUANTITIES BY		
5/16/09 dgm		

LEGEND FOR AS-BUILT POSTINGS	
	Squiggly line for as-built deletion
	Double line for as-built deletion
Roadway	Text for as-built posting

6/07/06	Stations in notes changed to @ Sta. 40+00 to @ Sta. 43+00, and deleted Cleanouts.
---------	---

DATE	REVISION
------	----------

STATE OF HAWAII
 DEPARTMENT OF TRANSPORTATION
 HIGHWAYS DIVISION
ROADWAY PLAN
LIKELIKE HIGHWAY
PAVEMENT PREVENTATIVE MAINTENANCE
End of Wilson Tunnel to Kamehameha Highway
Project No. HWY-0-05-06M


Scale: 1"=40' Date: May, 2006

SHEET No. 9 OF 13 SHEETS

AS-BUILT

ADD. 20

FED. ROAD DIST. NO.	STATE	PROJ. NO.	FISCAL YEAR	SHEET NO.	TOTAL SHEETS
HAWAII	HAW.	HWY-O-05-06M	2006	ADD. 21	50

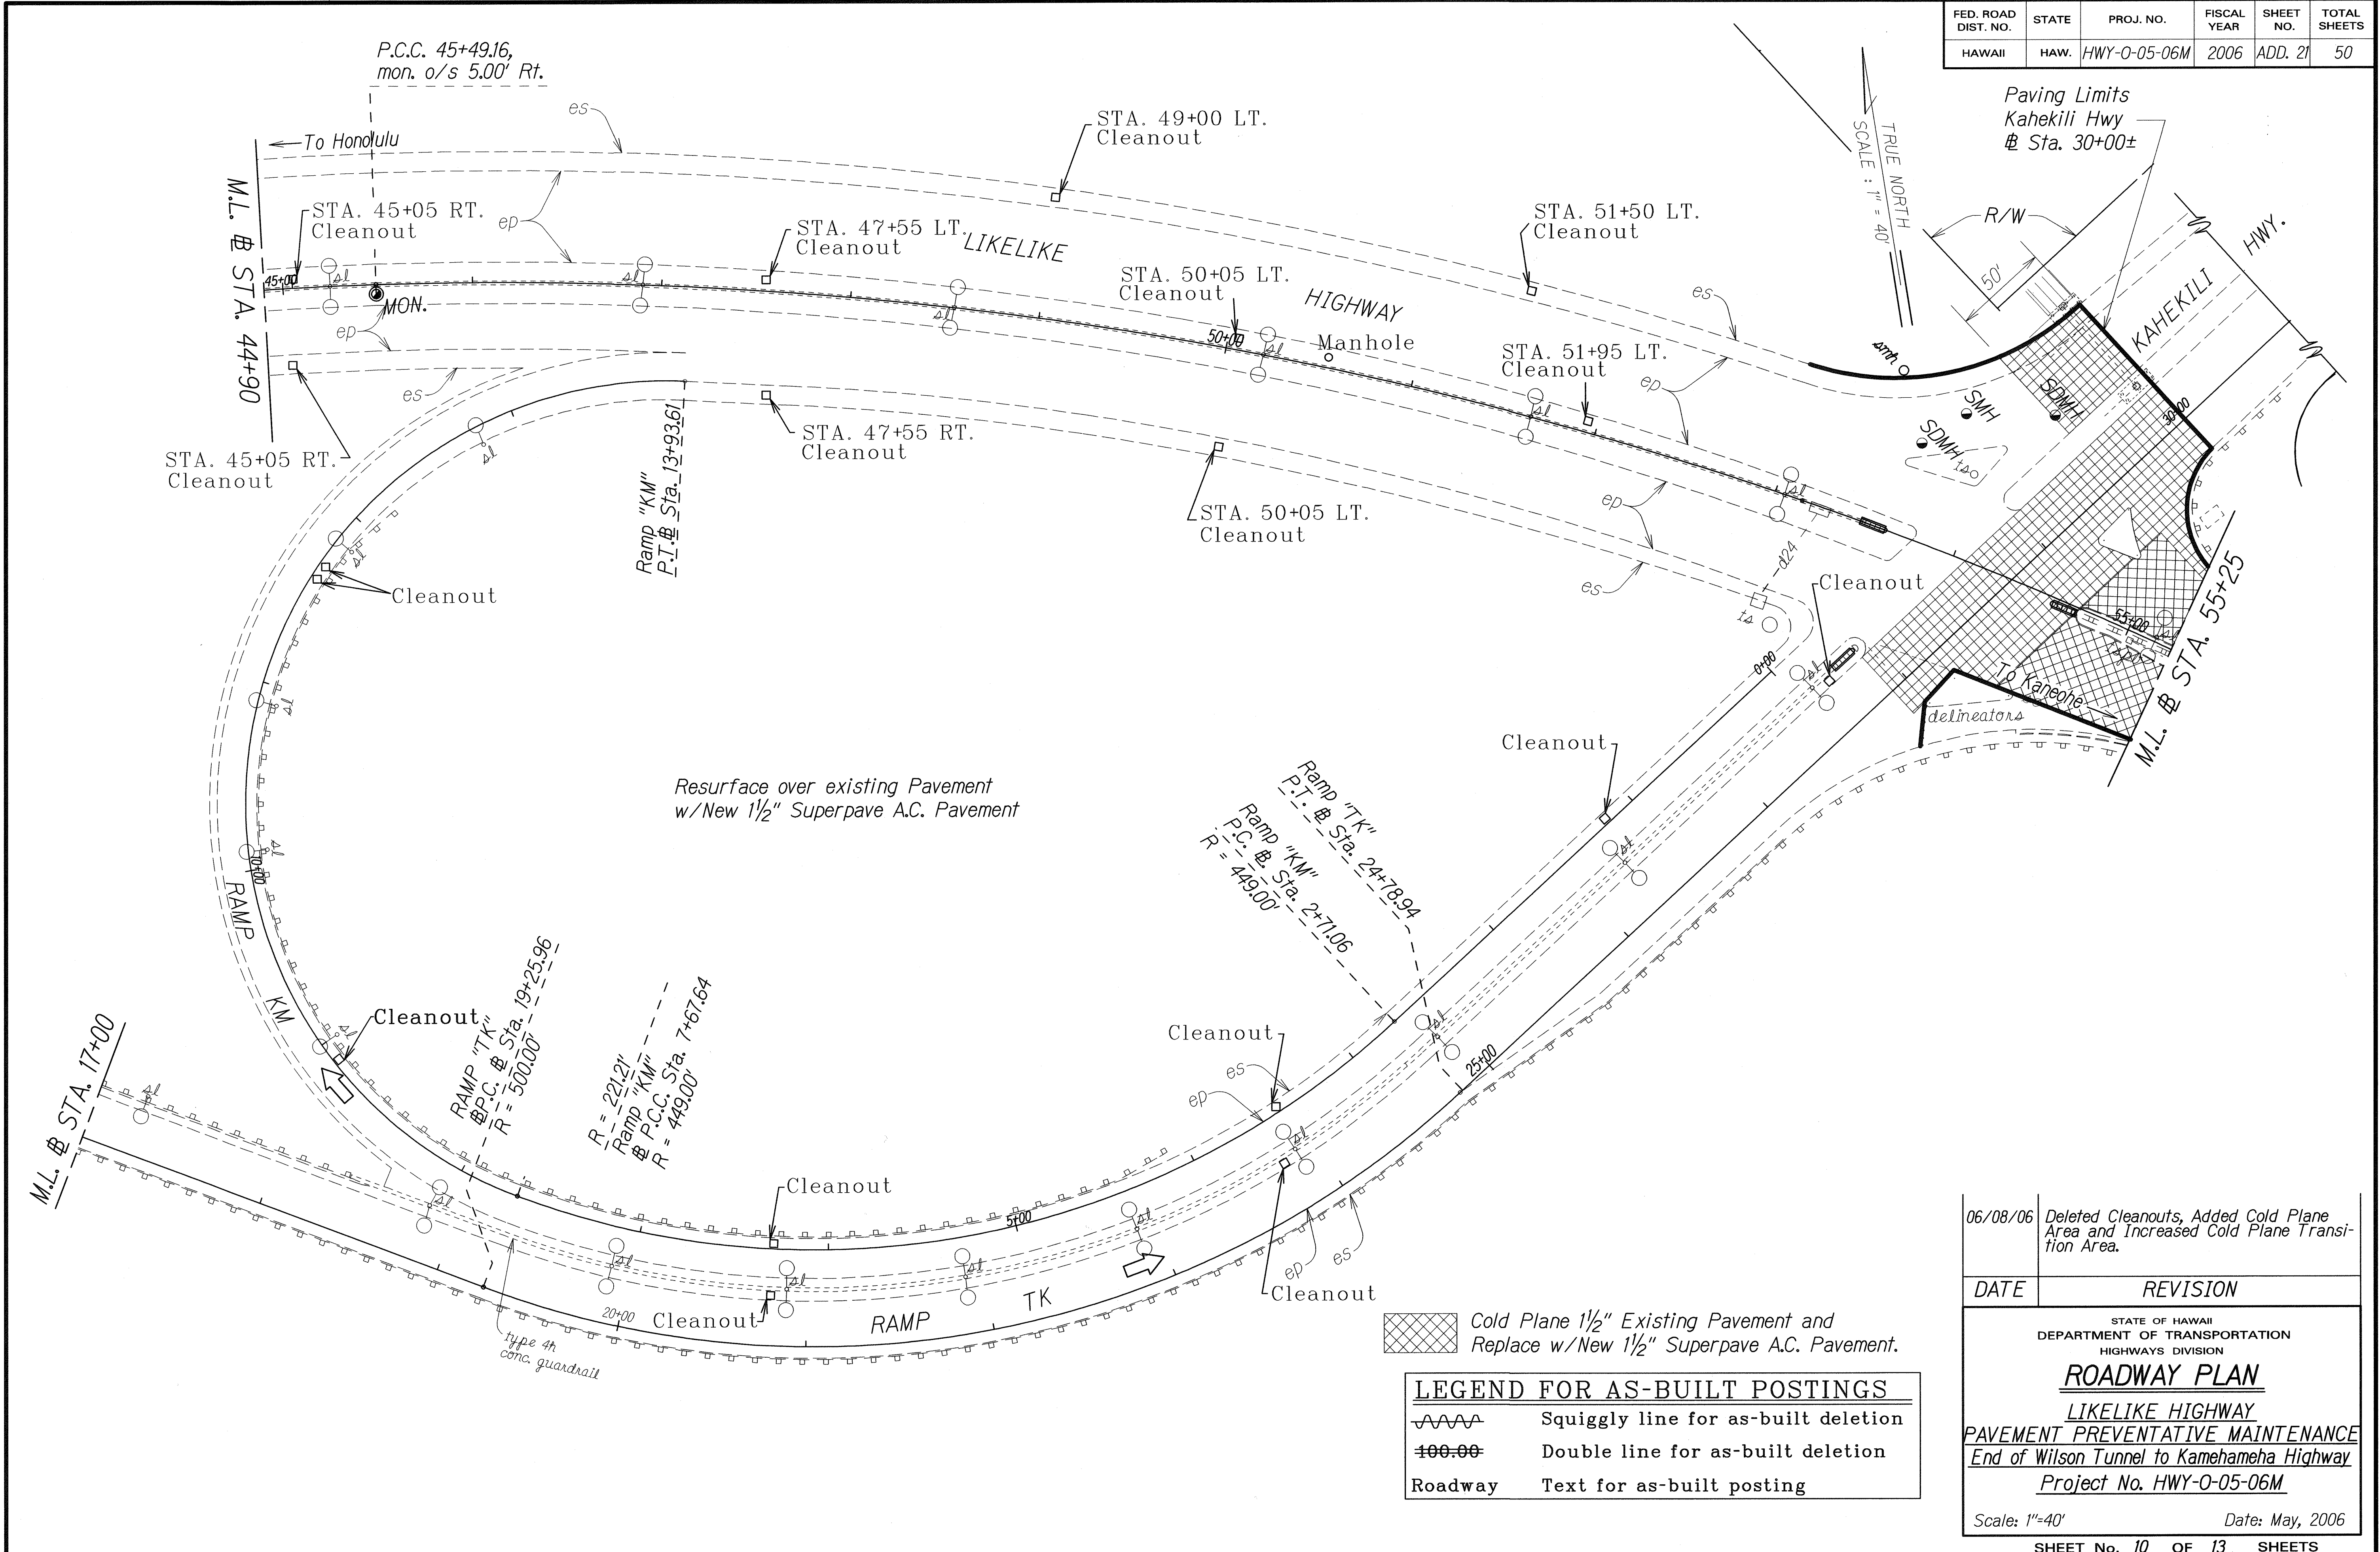

SURVEY PLOTTED BY	DATE
DRAWN BY	
DESIGNED BY	
QUANTITIES BY	
CHECKED BY	


06/08/06	Deleted Cleanouts, Added Cold Plane Area and Increased Cold Plane Transition Area.
DATE	REVISION
STATE OF HAWAII DEPARTMENT OF TRANSPORTATION HIGHWAYS DIVISION ROADWAY PLAN LIKELIKE HIGHWAY PAVEMENT PREVENTATIVE MAINTENANCE End of Wilson Tunnel to Kamehameha Highway Project No. HWY-O-05-06M Scale: 1"=40' Date: May, 2006	
SHEET No. 10 OF 13 SHEETS	

AS-BUILT


ADD. 21



FED. ROAD DIST. NO.	STATE	PROJ. NO.	FISCAL YEAR	SHEET NO.	TOTAL SHEETS
HAWAII	HAW.	HWY-0-05-06M	2006	ADD. 22	50

TRUE NORTH
SCALE: 1" = 40'

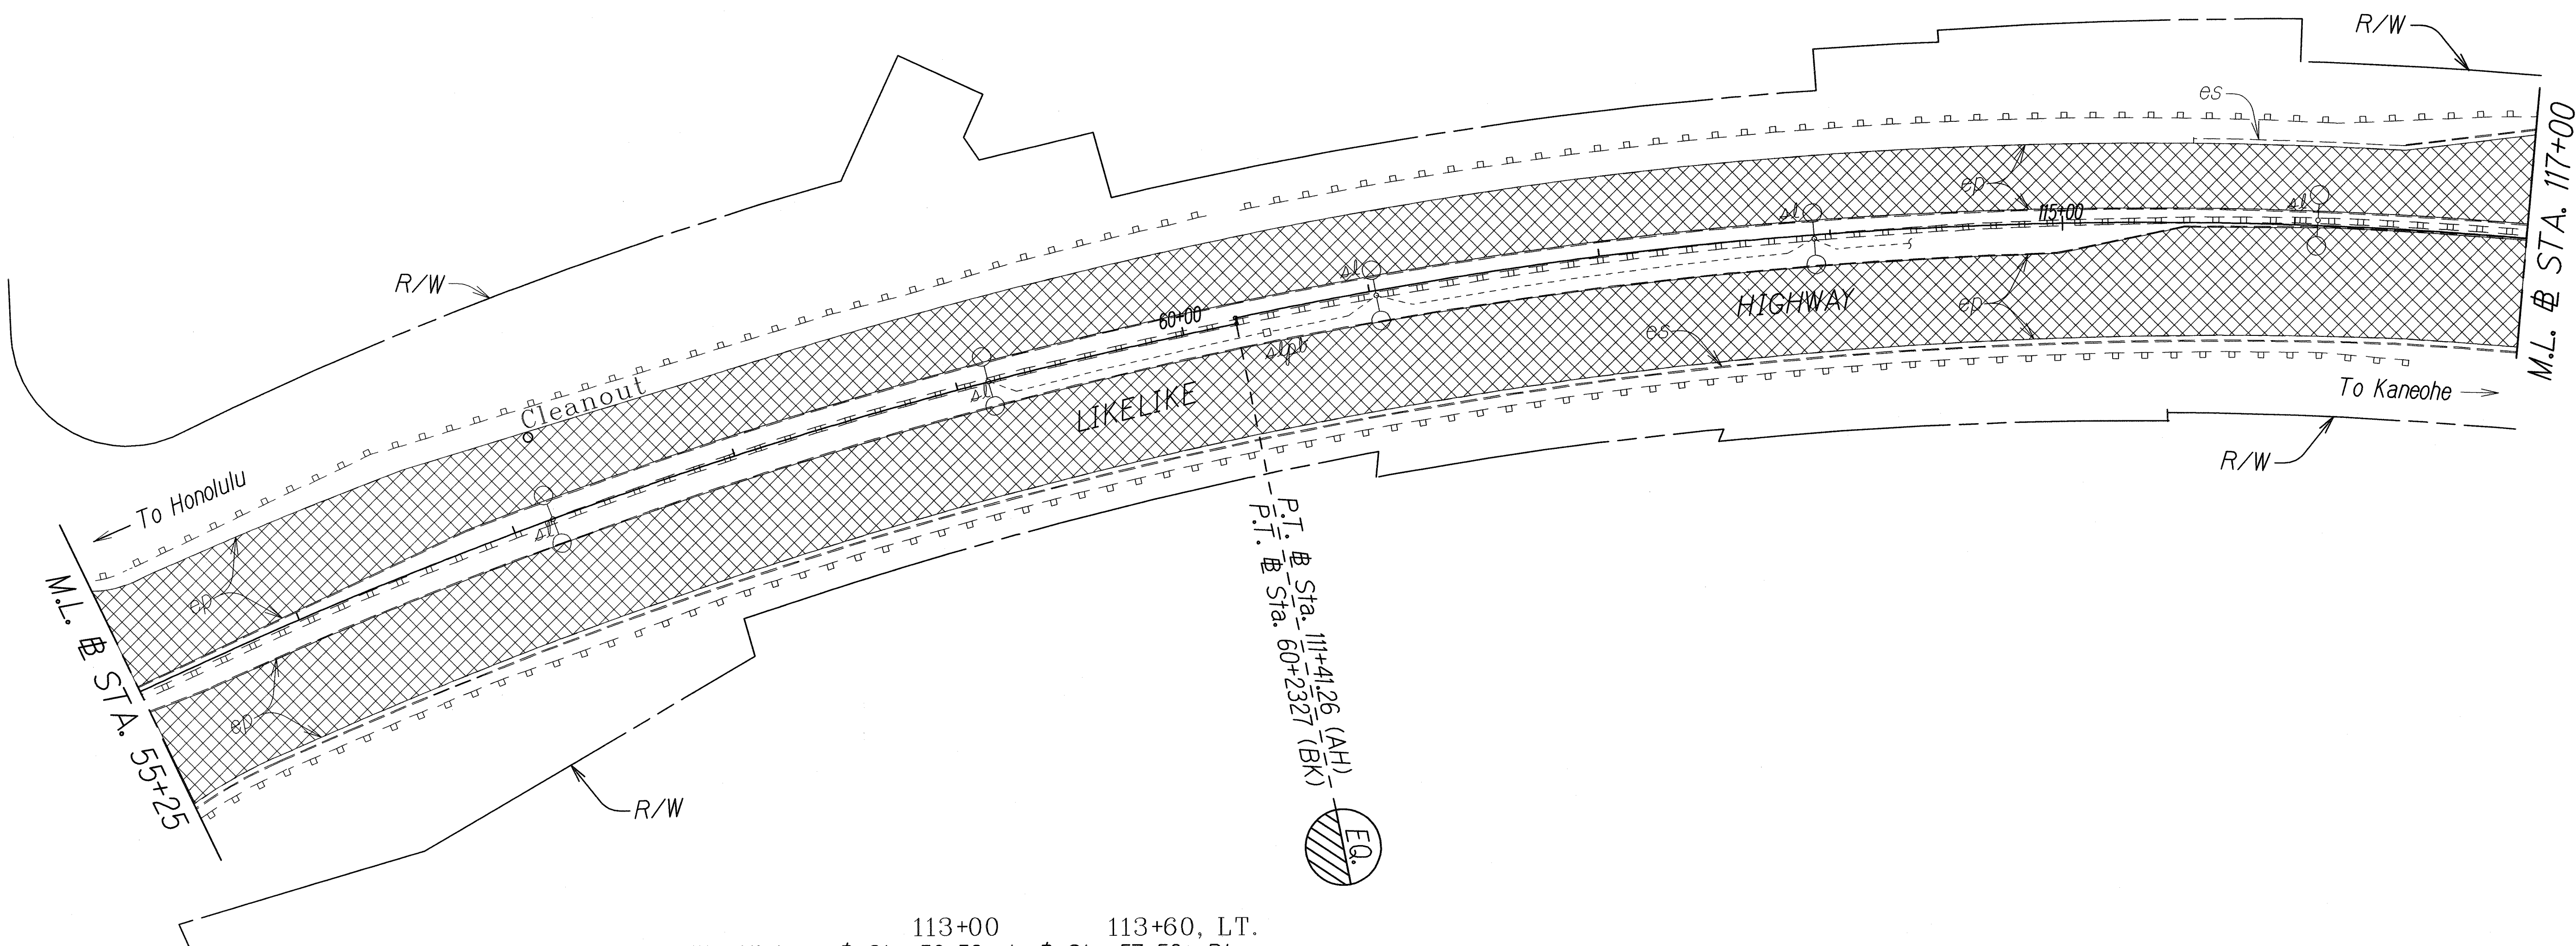

113+00 113+60, LT.
Liklike Highway ~~Sta. 56+50+ to Sta. 57+50+ RT.~~
Cold Plane 3" of Existing Pavement of Middle Lane (12' Wide)
and Replace with 3" Superpave Pavement. See
Detail on Plan Sheet No. 9.

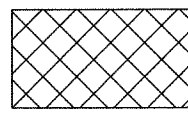 Cold Plane 1 1/2" Existing Pavement and Replace w/ New 1 1/2" Superpave A.C. Pavement.

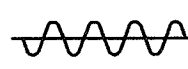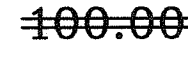LEGEND FOR AS-BUILT POSTINGS	
	Squiggly line for as-built deletion
	Double line for as-built deletion
Roadway	Text for as-built posting

06/08/06 Deleted Cleanouts and Added Cold Plane Area.

DATE REVISION

STATE OF HAWAII
DEPARTMENT OF TRANSPORTATION
HIGHWAYS DIVISION
ROADWAY PLAN
LIKELIKE HIGHWAY
PAVEMENT PREVENTATIVE MAINTENANCE
End of Wilson Tunnel to Kamehameha Highway
Project No. HWY-0-05-06M

Scale: 1"=40' Date: May, 2006


SHEET No. 11 OF 13 SHEETS

AS-BUILT


ADD. 22

DATE	06/08/06
SURVEY PLOTTED BY	SL/SL/SL
DRAWN BY	SL/SL/SL
DESIGNED BY	SL/SL/SL
QUANTITIES BY	SL/SL/SL
CHECKED BY	SL/SL/SL
NOTE BOOK	SL/SL/SL
ORIGINAL PLAN	SL/SL/SL

FED. ROAD DIST. NO.	STATE	PROJ. NO.	FISCAL YEAR	SHEET NO.	TOTAL SHEETS
HAWAII	HAW.	HWY-0-05-06M	2006	23	50

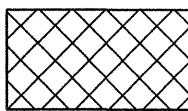 Cold Plane 1½" Existing Pavement
 and Replace w/New 1½" Superpave A.C. Pavement

TRUE NORTH
 SCALE : 1" = 40'

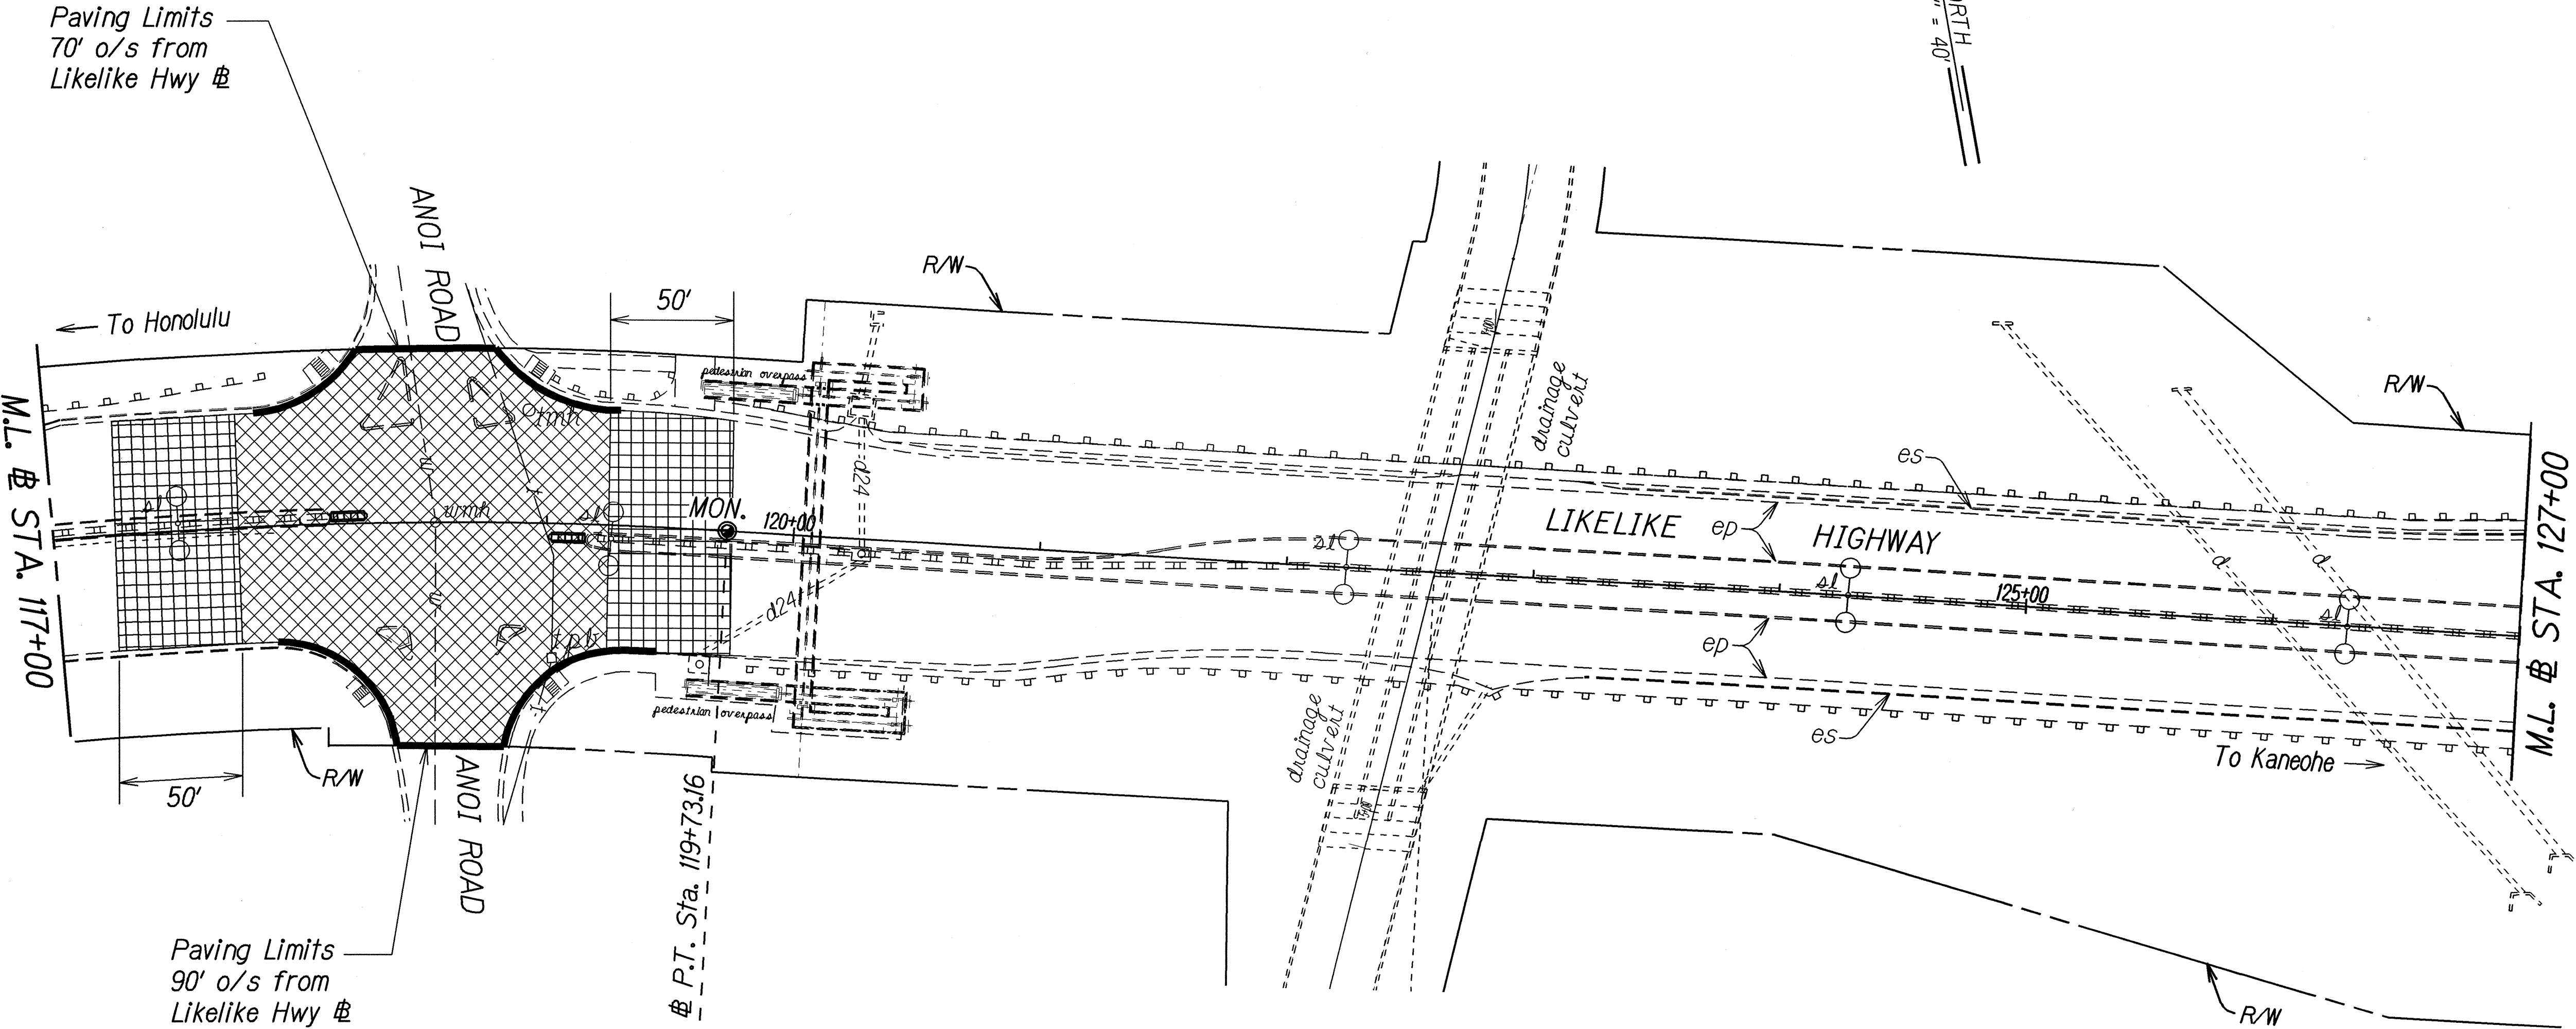

Resurface over existing Pavement
 w/New 1½" Superpave A.C. Pavement

ORIGINAL PLAN	SURVEY PLOTTED BY	DATE
NOTE BOOK	DRAWN BY	
5/16/02	DESIGNED BY	
8/1/02	QUANTITIES BY	
	CHECKED BY	


STATE OF HAWAII
 DEPARTMENT OF TRANSPORTATION
 HIGHWAYS DIVISION

ROADWAY PLAN
 LIKELIKE HIGHWAY
 PAVEMENT PREVENTATIVE MAINTENANCE
 End of Wilson Tunnel to Kanehameha Highway
 Project No. HWY-0-05-06M

Scale: 1"=40'
 Date: May, 2006

SHEET No. 12 OF 13 SHEETS

FED. ROAD DIST. NO.	STATE	PROJ. NO.	FISCAL YEAR	SHEET NO.	TOTAL SHEETS
HAWAII	HAW.	HWY-0-05-06M	2006	24	50

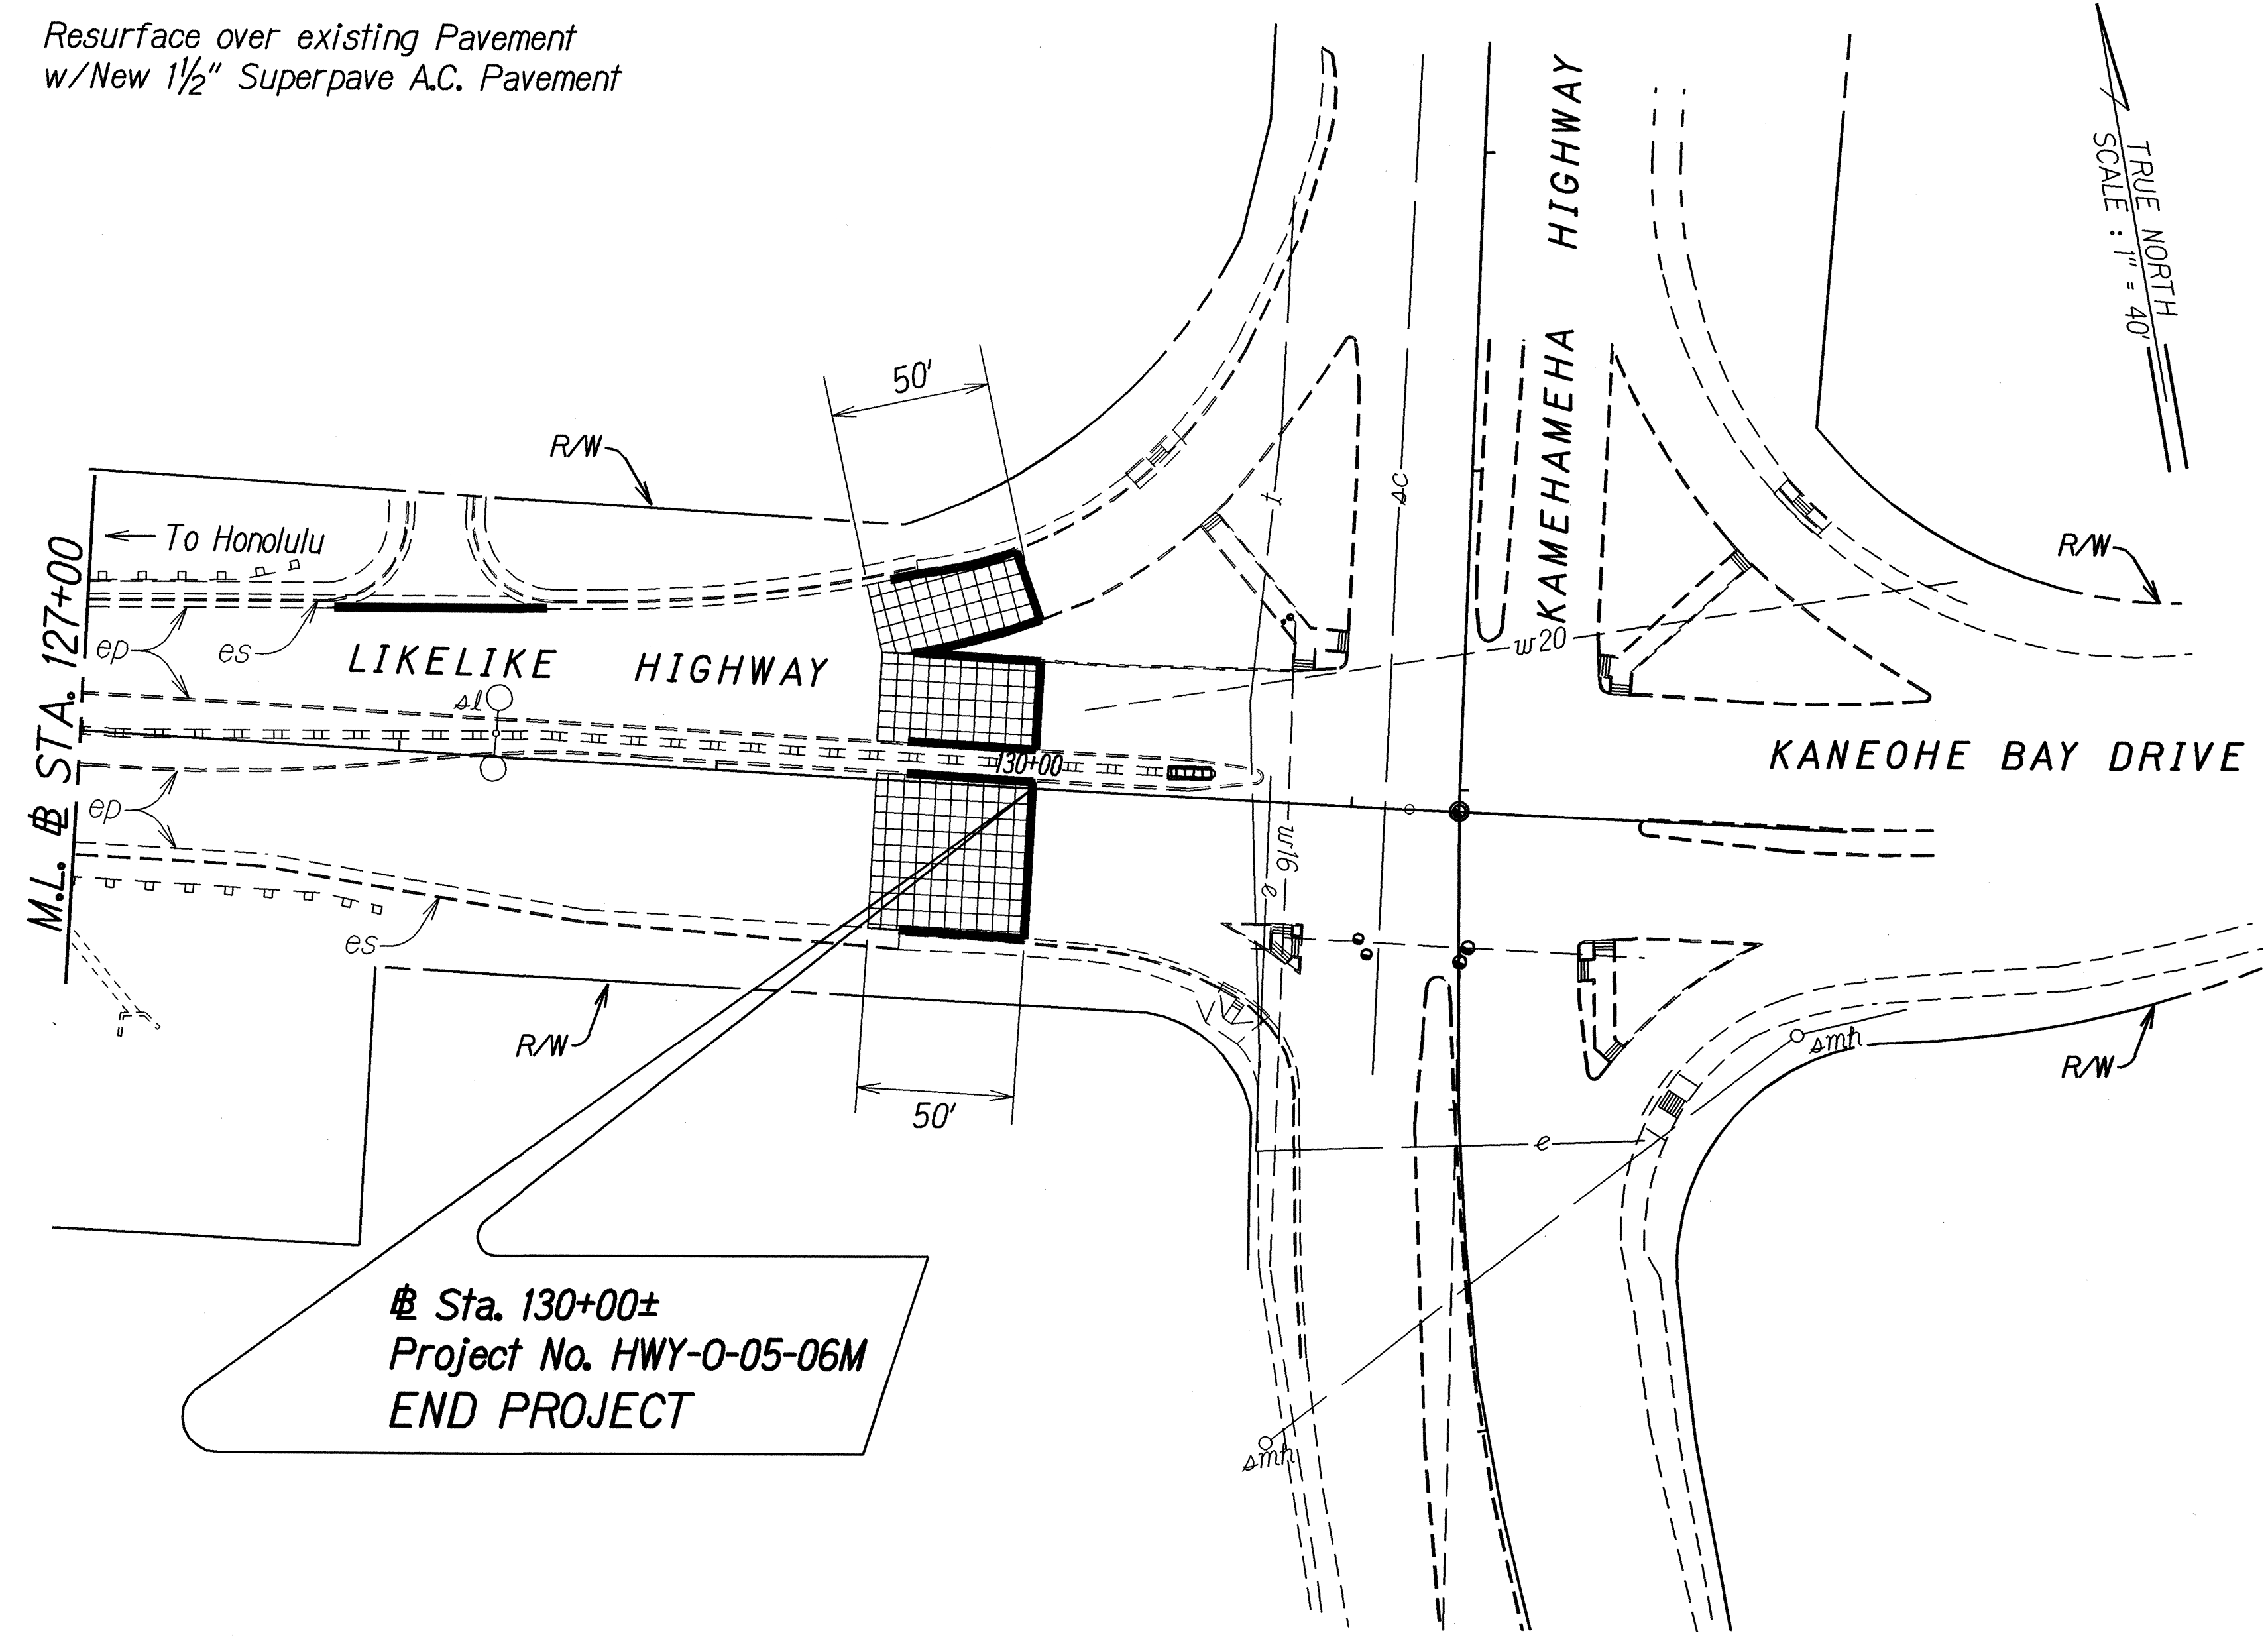

ORIGINAL PLAN	SURVEY PLOTTED BY	DATE
NOTE BOOK	DRAWN BY	
5/16/06/2499	DESIGNED BY	
N	QUANTITIES BY	
	CHECKED BY	

STATE OF HAWAII
DEPARTMENT OF TRANSPORTATION
HIGHWAYS DIVISION

ROADWAY PLAN
LIKELINE HIGHWAY
PAVEMENT PREVENTATIVE MAINTENANCE
End of Wilson Tunnel to Kamehameha Highway
Project No. HWY-0-05-06M

Scale: 1"=40'
Date: May, 2006