



FED. ROAD DIST. NO.	STATE	PROJ. NO.	FISCAL YEAR	SHEET NO.	TOTAL SHEETS
HAWAII	HAW.	HWY-0-05-06M	2006	6	50

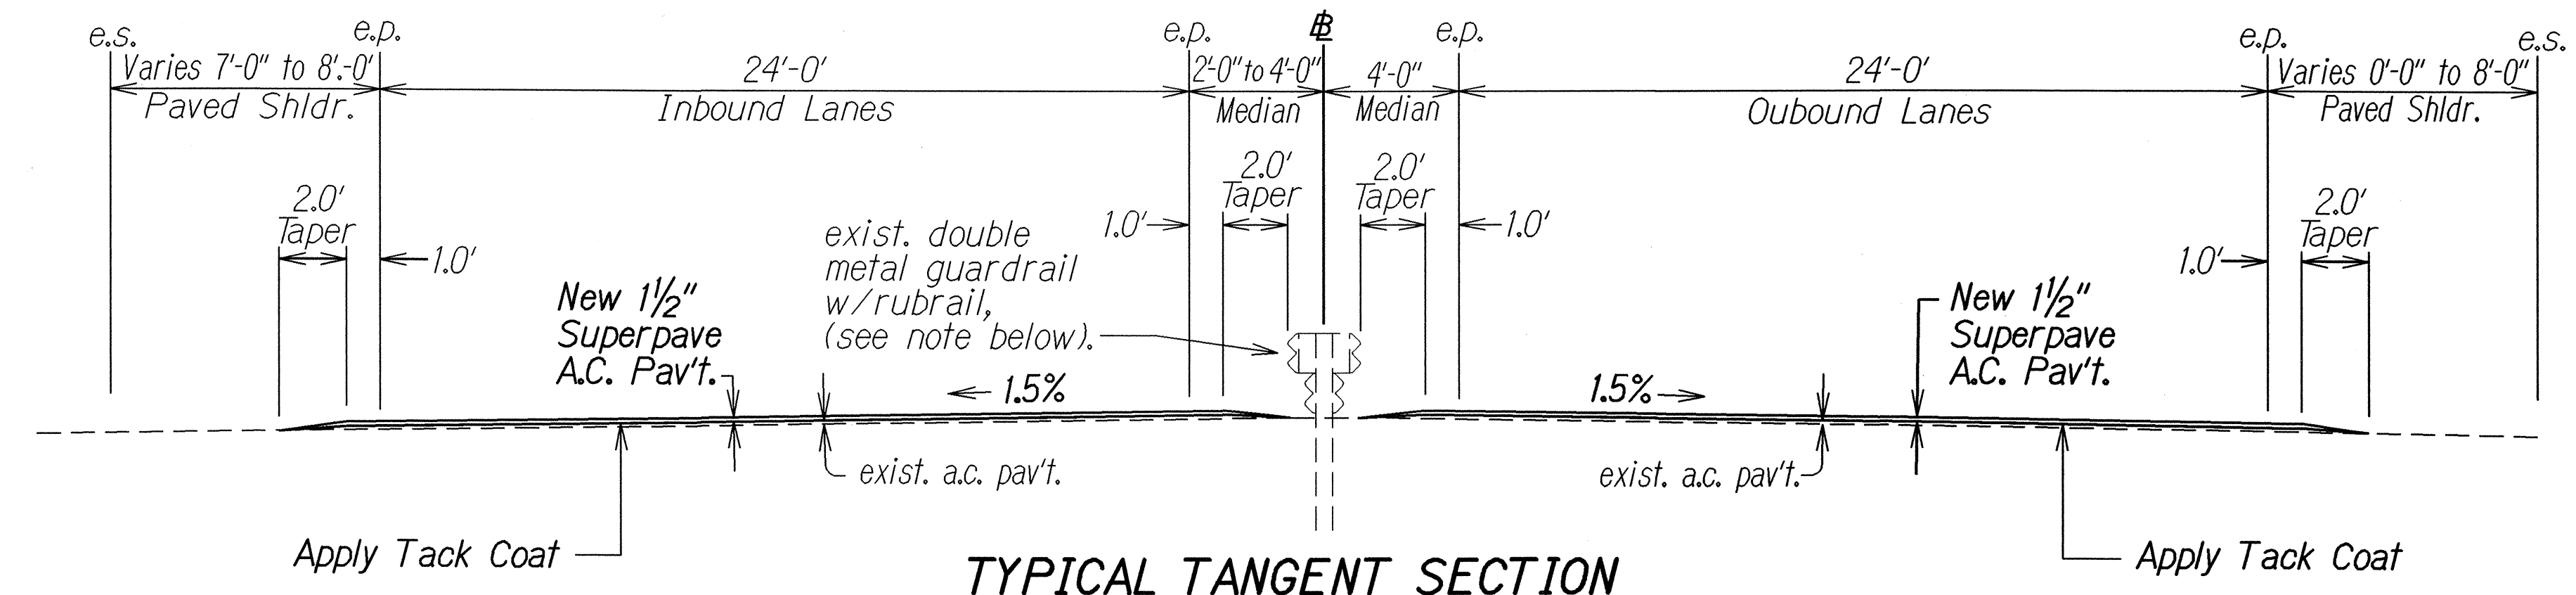

TYPICAL TANGENT SECTION
LIKELIKE HIGHWAY "A" @ STA. 8+18.52± to @ STA. 21+00±
LIKELIKE HIGHWAY "A" @ STA. 26+00± to @ STA. 53+39.59±
 Scale: 1/4" = 1'-0"

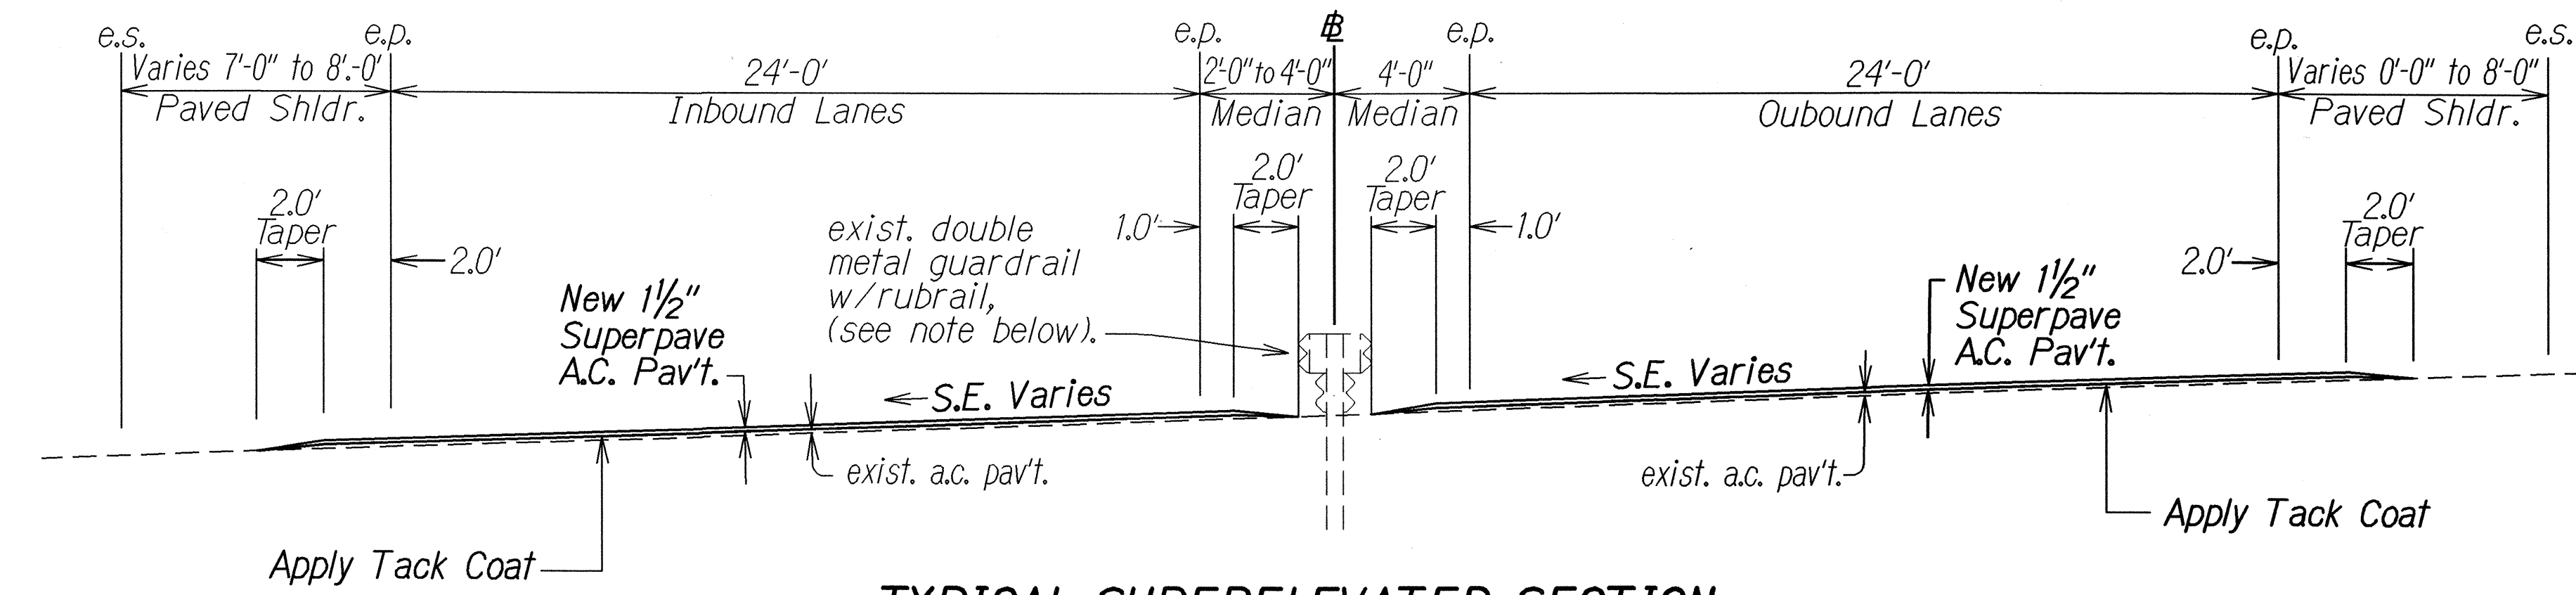

TYPICAL SUPERELEVATED SECTION
LIKELIKE HIGHWAY "A" @ STA. 1+02± to @ STA. 21+00±
LIKELIKE HIGHWAY "A" @ STA. 26+00± to @ STA. 53+39.59±
 Scale: 1/4" = 1'-0"


Note:
 Metal guardrail in median changes to concrete barrier.
 See roadway plans for location.

SURVEY PLOTTED BY	DATE
DRAWN BY	4/2/03
DESIGNED BY	
CHECKED BY	
ORIGINAL PLAN	
NOTE BOOK	
DESIGNED BY	
CHECKED BY	


STATE OF HAWAII
DEPARTMENT OF TRANSPORTATION
HIGHWAYS DIVISION

TYPICAL SECTIONS AND DETAILS
LIKELIKE HIGHWAY PAVEMENT
PREVENTATIVE MAINTENANCE
End of Wilson Tunnel to Kamehameha Highway
Project No. HWY-0-05-06M
Scale: As Noted Date: May 2006
SHEET No. 1 OF 6 SHEETS

FED. ROAD DIST. NO.	STATE	PROJ. NO.	FISCAL YEAR	SHEET NO.	TOTAL SHEETS
HAWAII	HAW.	HWY-0-05-06M	2006	7	50

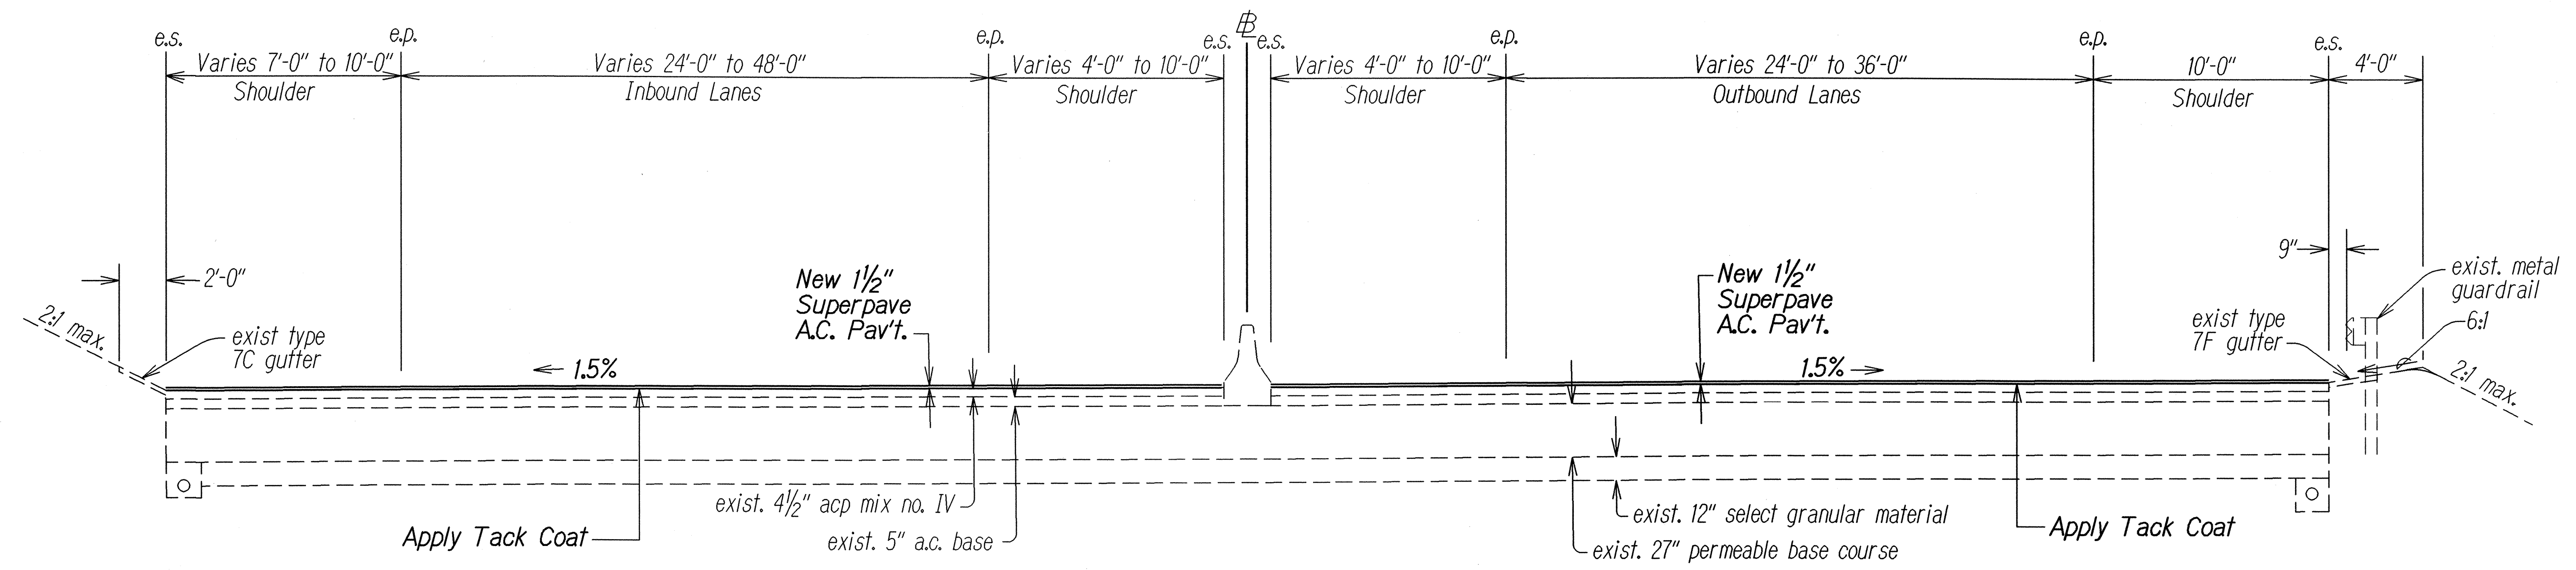

TYPICAL TANGENT SECTION
LIKELIKE HIGHWAY "B" @ STA. 0+00 TO @ STA. 53+80±
 Scale: 1/4" = 1'-0"

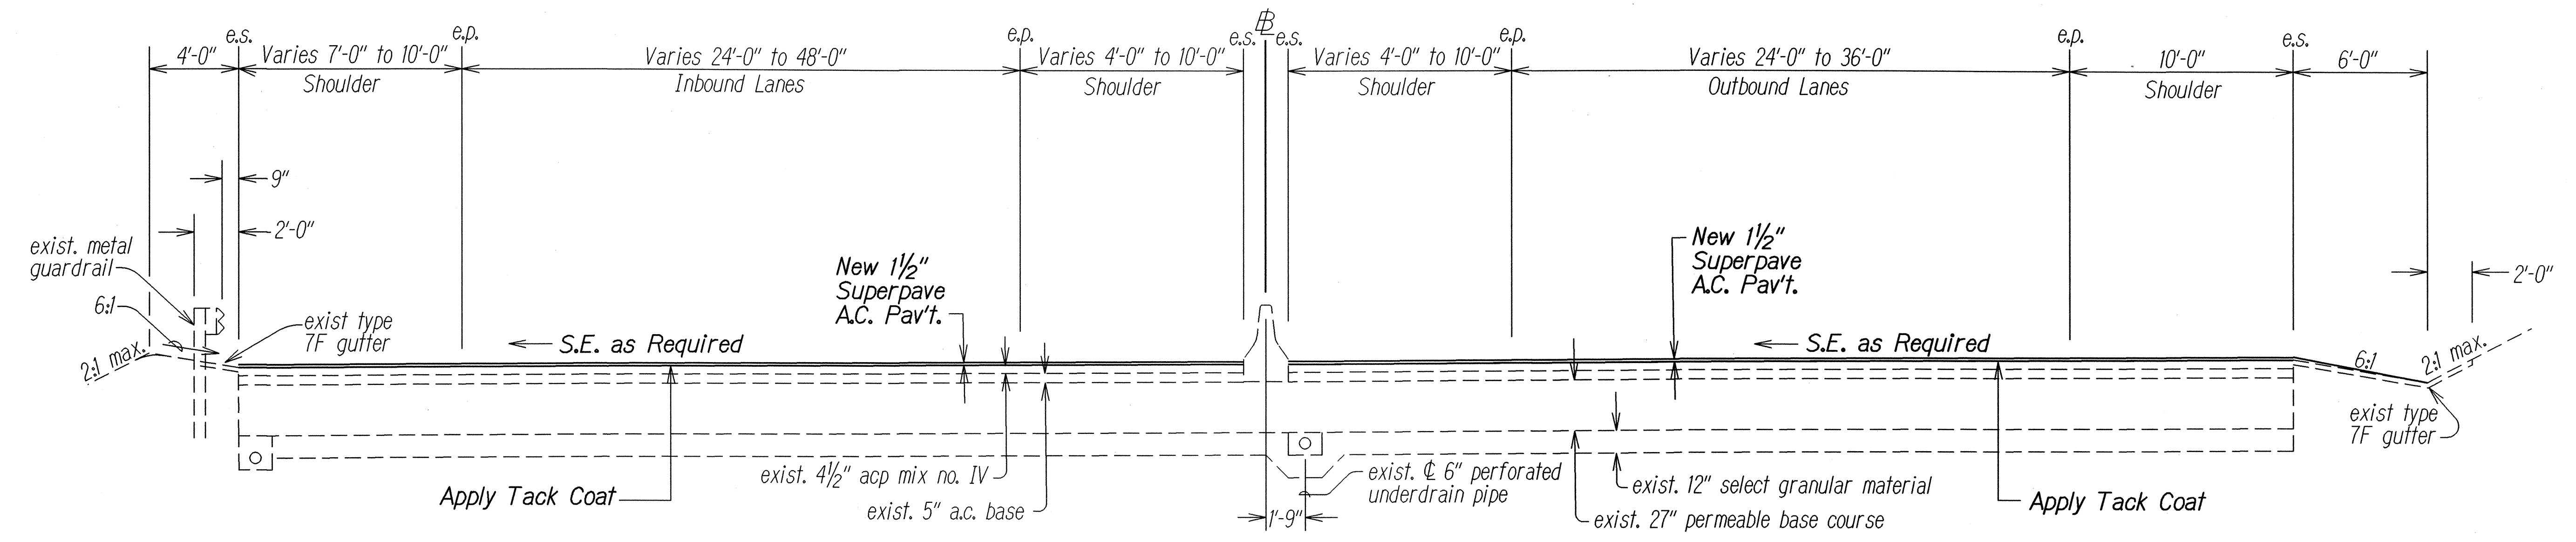


TYPICAL SUPERELEVATED SECTION
LIKELIKE HIGHWAY "B" @ STA. 0+00 TO @ STA. 53+80±
 Scale: 1/4" = 1'-0"

ORIGINAL PLAN	DATE	4/22/03
SURVEY PLOTTED BY		
DRAWN BY		
DESIGNED BY		
CHECKED BY		
NOTED BY		
QUANTITIES BY		
CHECKED BY		


STATE OF HAWAII
DEPARTMENT OF TRANSPORTATION
HIGHWAYS DIVISION

TYPICAL SECTIONS AND DETAILS
LIKELIKE HIGHWAY PAVEMENT PREVENTATIVE MAINTENANCE
End of Wilson Tunnel to Kamehameha Highway
Project No. HWY-0-05-06M
Scale: As Noted Date: May 2006
SHEET No. 2 OF 5 SHEETS

FED. ROAD DIST. NO.	STATE	PROJ. NO.	FISCAL YEAR	SHEET NO.	TOTAL SHEETS
HAWAII	HAW.	HWY-0-05-06M	2006	8	50

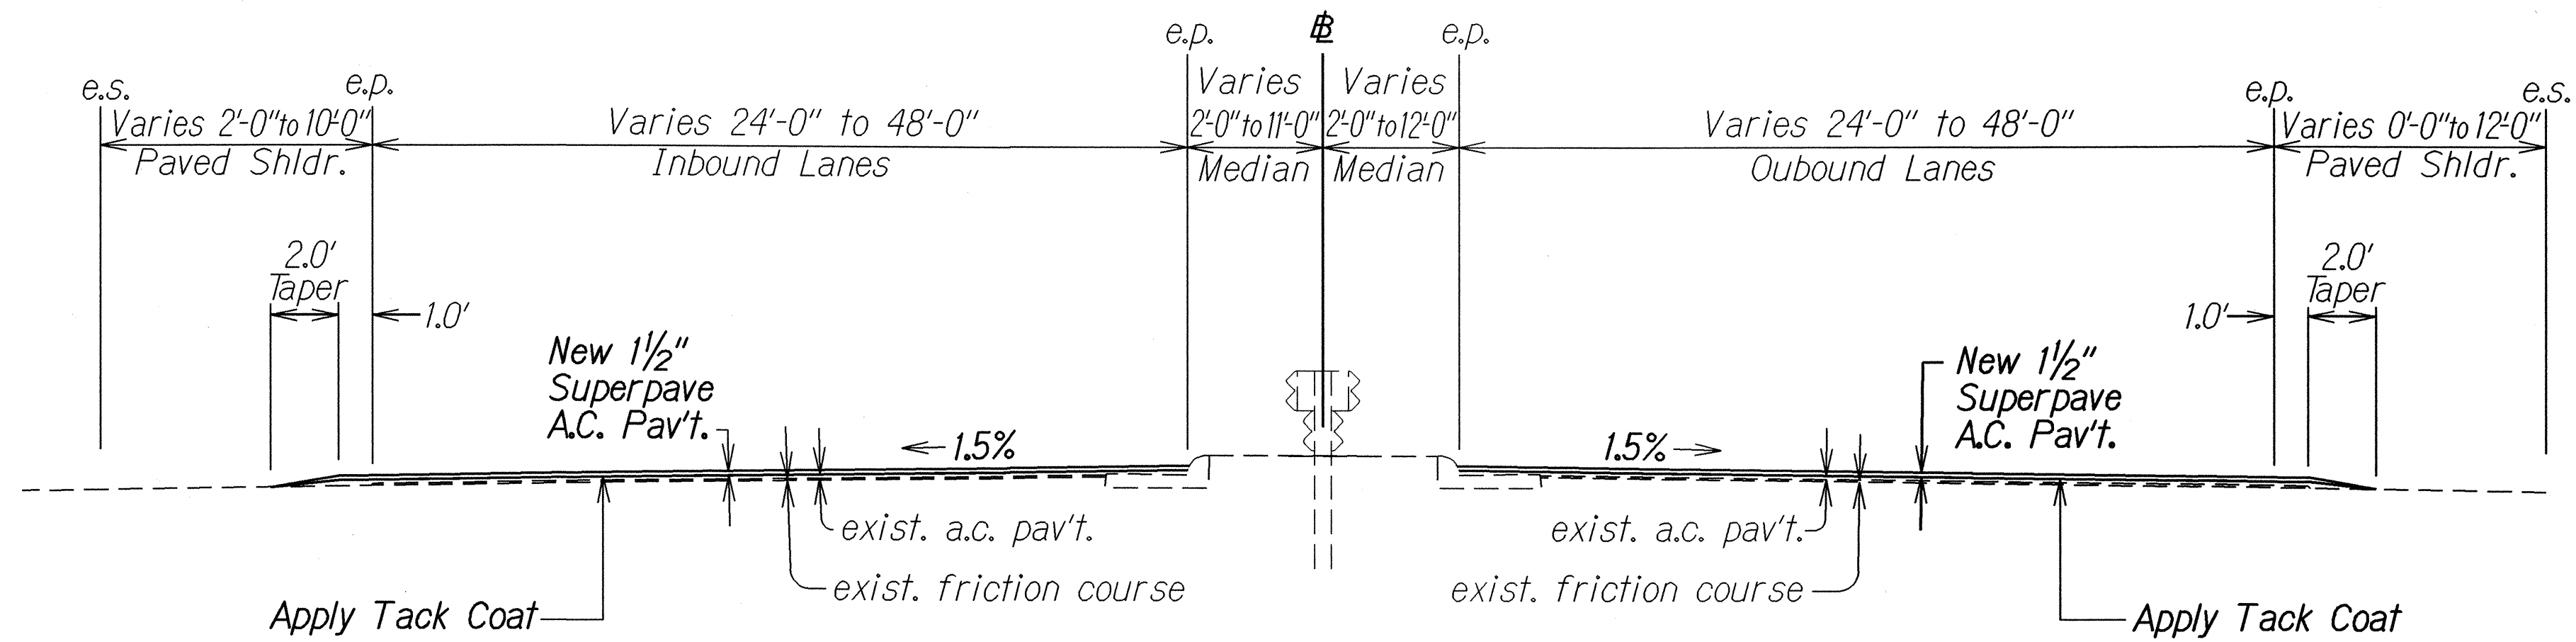

TYPICAL TANGENT SECTION
LIKELIKE HIGHWAY "B" @ STA. 53+80± to @ STA. 56+80±
LIKELIKE HIGHWAY "B" @ STA. 57+50± to @ STA. 130+00±
 Scale: 1/4" = 1'-0"

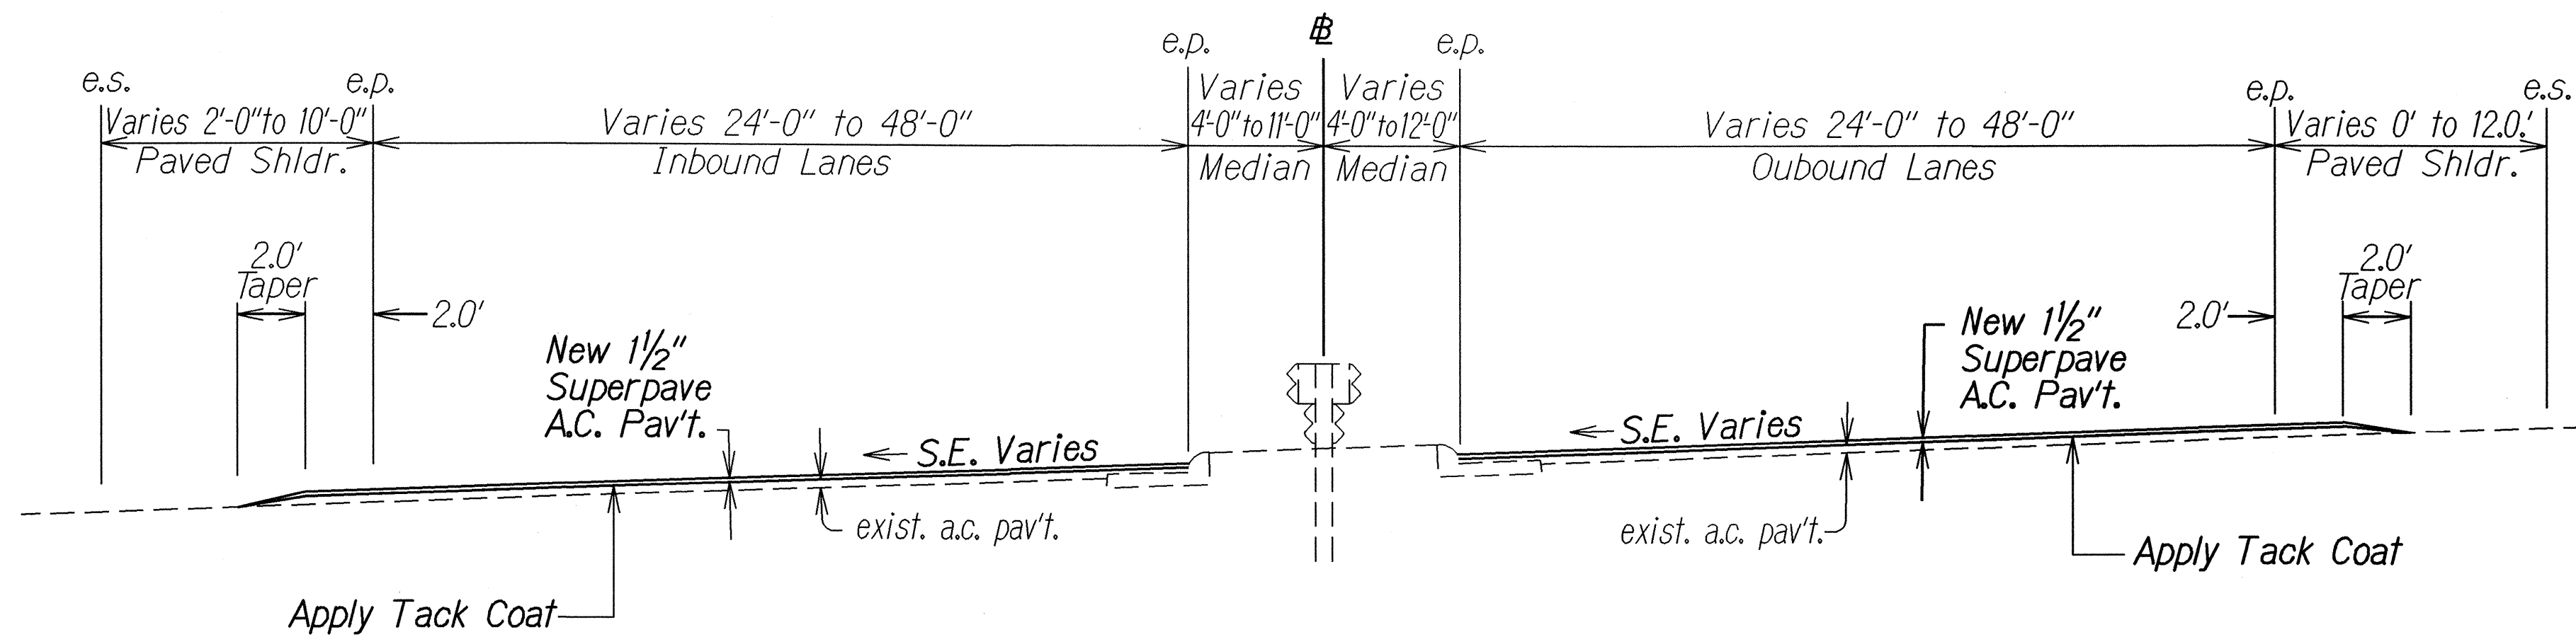

TYPICAL SUPERELEVATED SECTION
LIKELIKE HIGHWAY "B" @ STA. 53+80± TO @ STA. 56+50±
LIKELIKE HIGHWAY "B" @ STA. 57+50± TO @ STA. 130+00±
 Scale: 1/4" = 1'-0"

ORIGINAL PLAN	SURVEY PLOTTED BY	DATE
NOTE BOOK	DRAWN BY	4/22/03
DESIGNED BY	CHECKED BY	
QUANTITIES BY		
CHECKED BY		


STATE OF HAWAII
DEPARTMENT OF TRANSPORTATION
HIGHWAYS DIVISION

TYPICAL SECTIONS AND DETAILS


**LIKELIKE HIGHWAY PAVEMENT
PREVENTATIVE MAINTENANCE**
End of Wilson Tunnel to Kamehameha Highway
Project No. HWY-0-05-06M

Scale: As Noted Date: May 2006
SHEET No. 3 OF 6 SHEETS

FED. ROAD DIST. NO.	STATE	PROJ. NO.	FISCAL YEAR	SHEET NO.	TOTAL SHEETS
HAWAII	HAW.	HWY-0-05-06M	2006	ADD.9	50

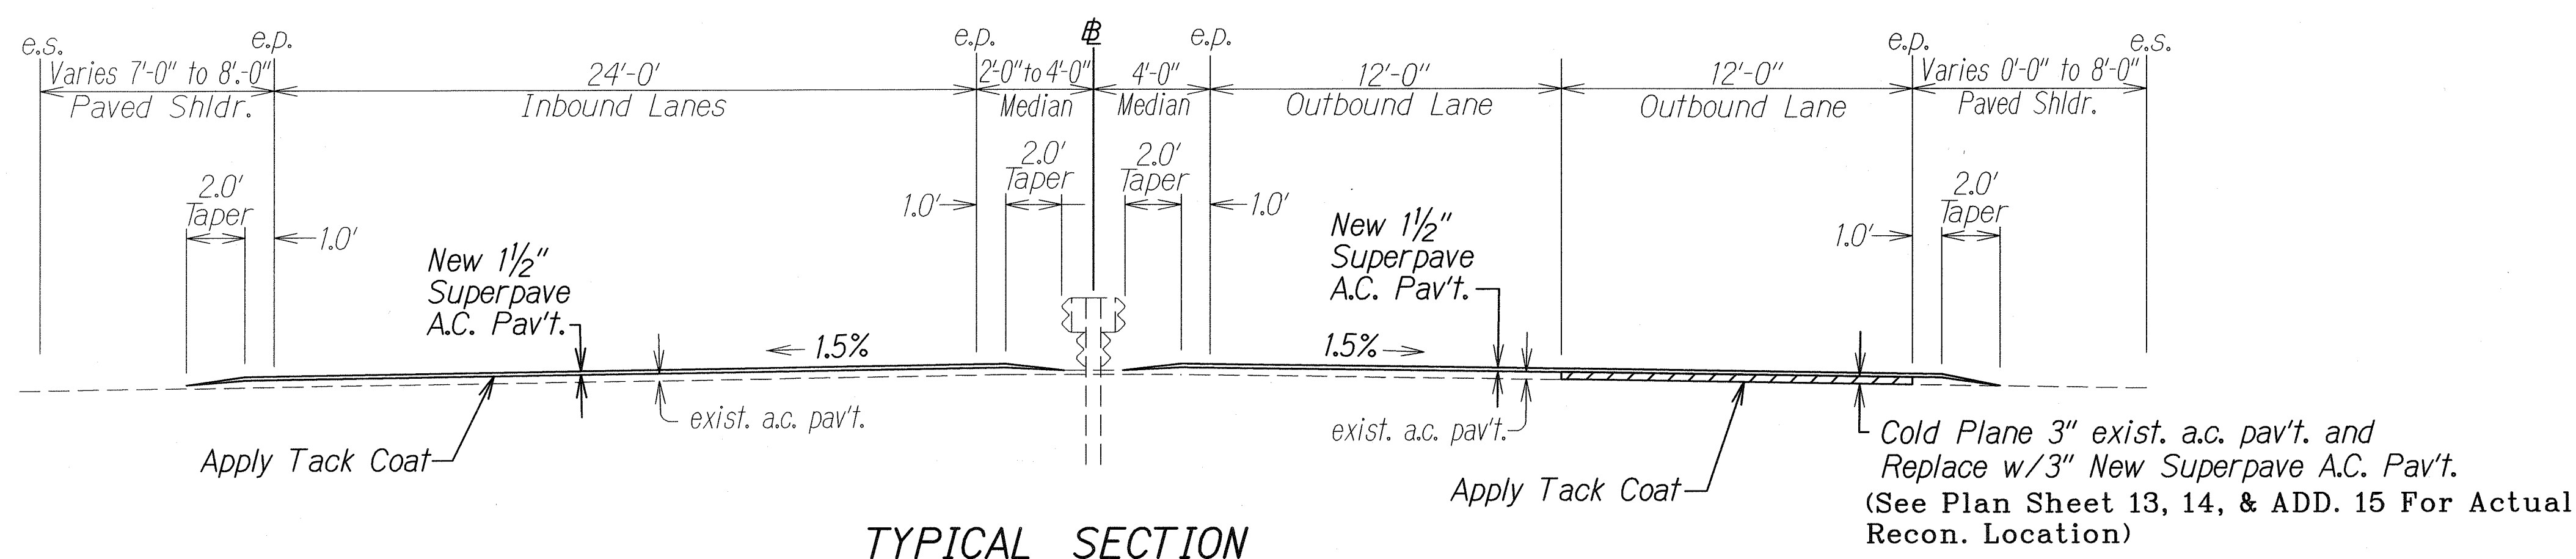

TYPICAL SECTION
LIKELIKE HIGHWAY "A" @ STA. 21+00± to @ STA. 26+00±
 Scale: 1/4" = 1'-0"

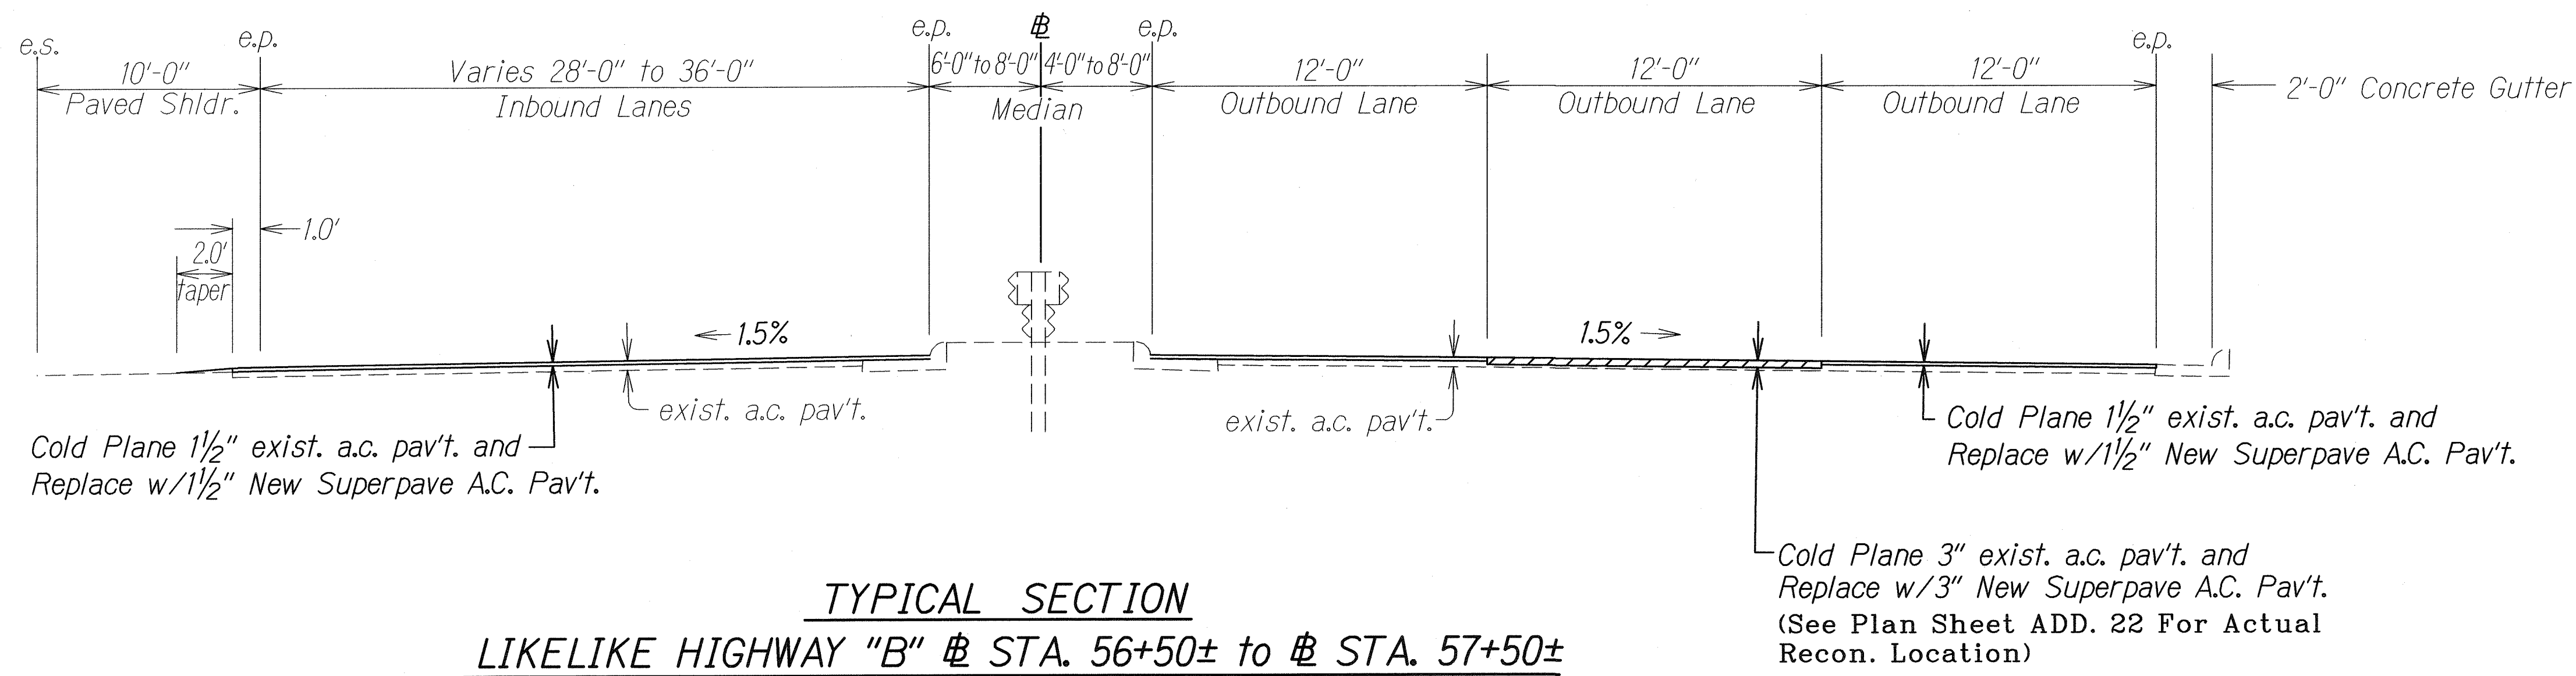

TYPICAL SECTION
LIKELIKE HIGHWAY "B" @ STA. 56+50± to @ STA. 57+50±
 Scale: 1/4" = 1'-0"


Note: For areas with a.c. over gutter, match existing pavement elevation at edge of gutter.

LEGEND FOR AS-BUILT POSTINGS	
	Squiggly line for as-built deletion
	Double line for as-built deletion
Roadway	Text for as-built posting


6/07/06	Revised Typical Section.
DATE	REVISION
STATE OF HAWAII DEPARTMENT OF TRANSPORTATION HIGHWAYS DIVISION	
TYPICAL SECTIONS AND DETAILS	
<u>LIKELIKE HIGHWAY PAVEMENT PREVENTATIVE MAINTENANCE</u> End of Wilson Tunnel to Kamehameha Highway Project No. HWY-0-05-06M	
Scale: As Noted	Date: May 2006
SHEET No. 4 OF 5 SHEETS	

SURVEY PLOTTED BY	DATE
DESIGNED BY	
NOTED BY	
CHECKED BY	
ORIGINAL PLAN	
NOTE BOOK	
QUANTITIES BY	
CHECKED BY	


FED. ROAD DIST. NO.	STATE	PROJ. NO.	FISCAL YEAR	SHEET NO.	TOTAL SHEETS
HAWAII	HAW.	HWY-0-05-06M	2006	10	50

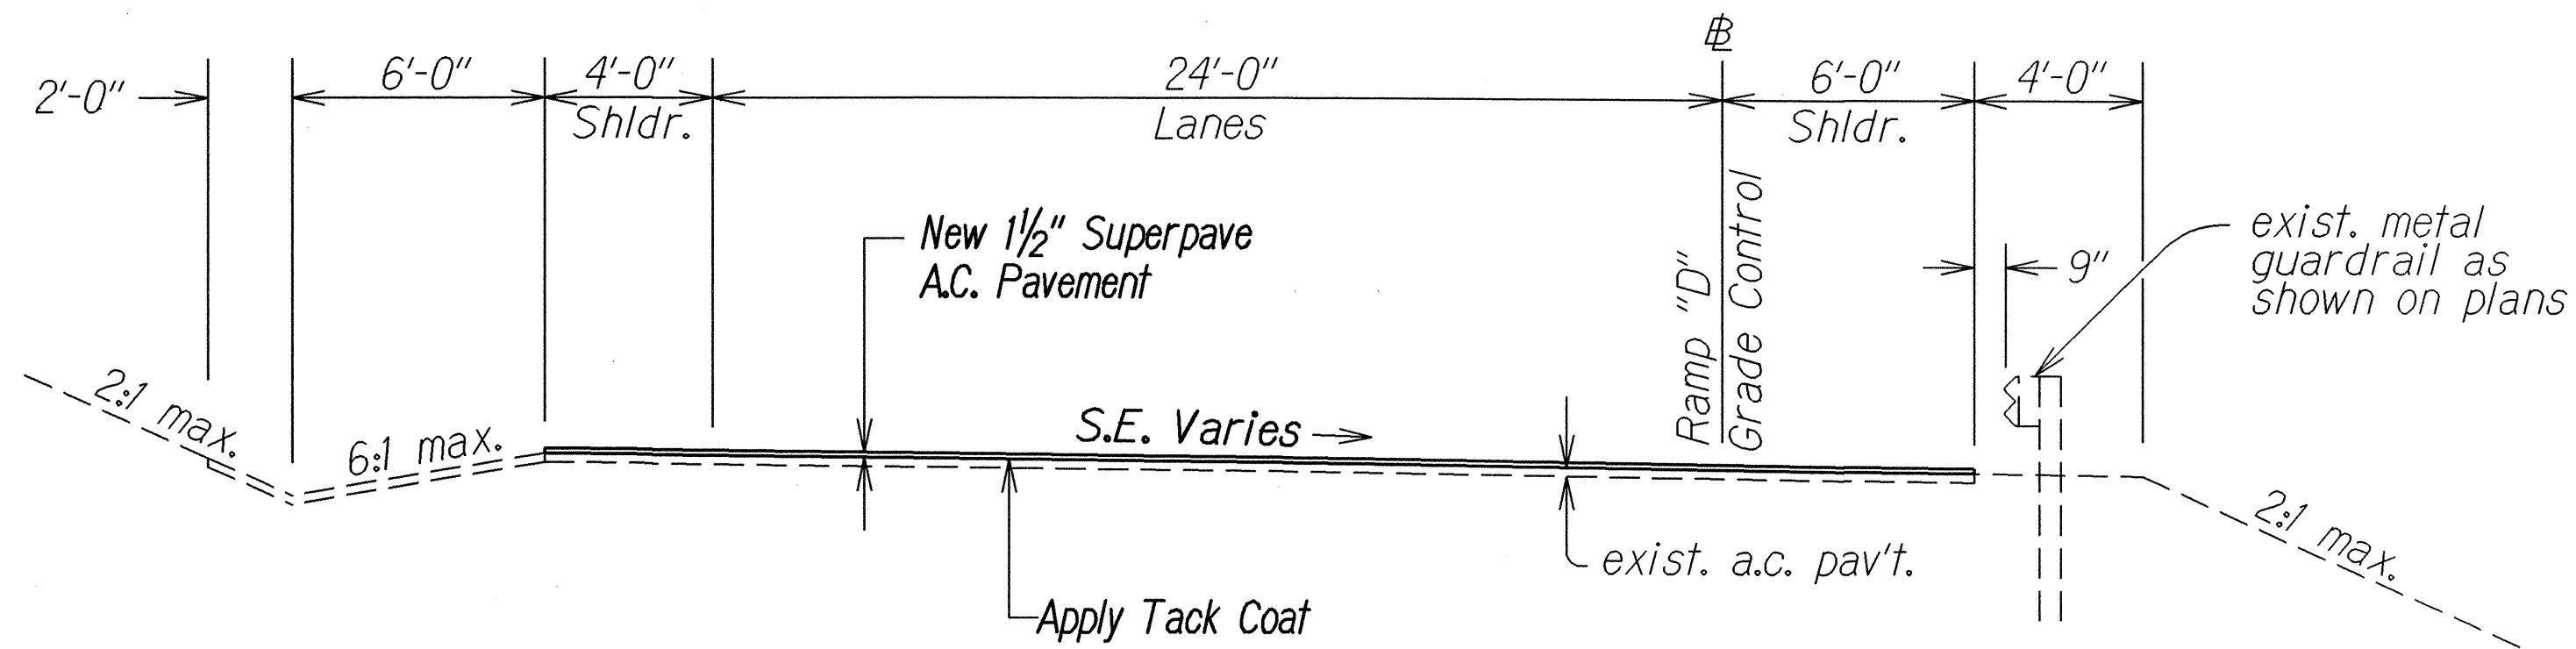


RAMP "D" TYPICAL SECTION
Scale: 1/4" = 1'-0"

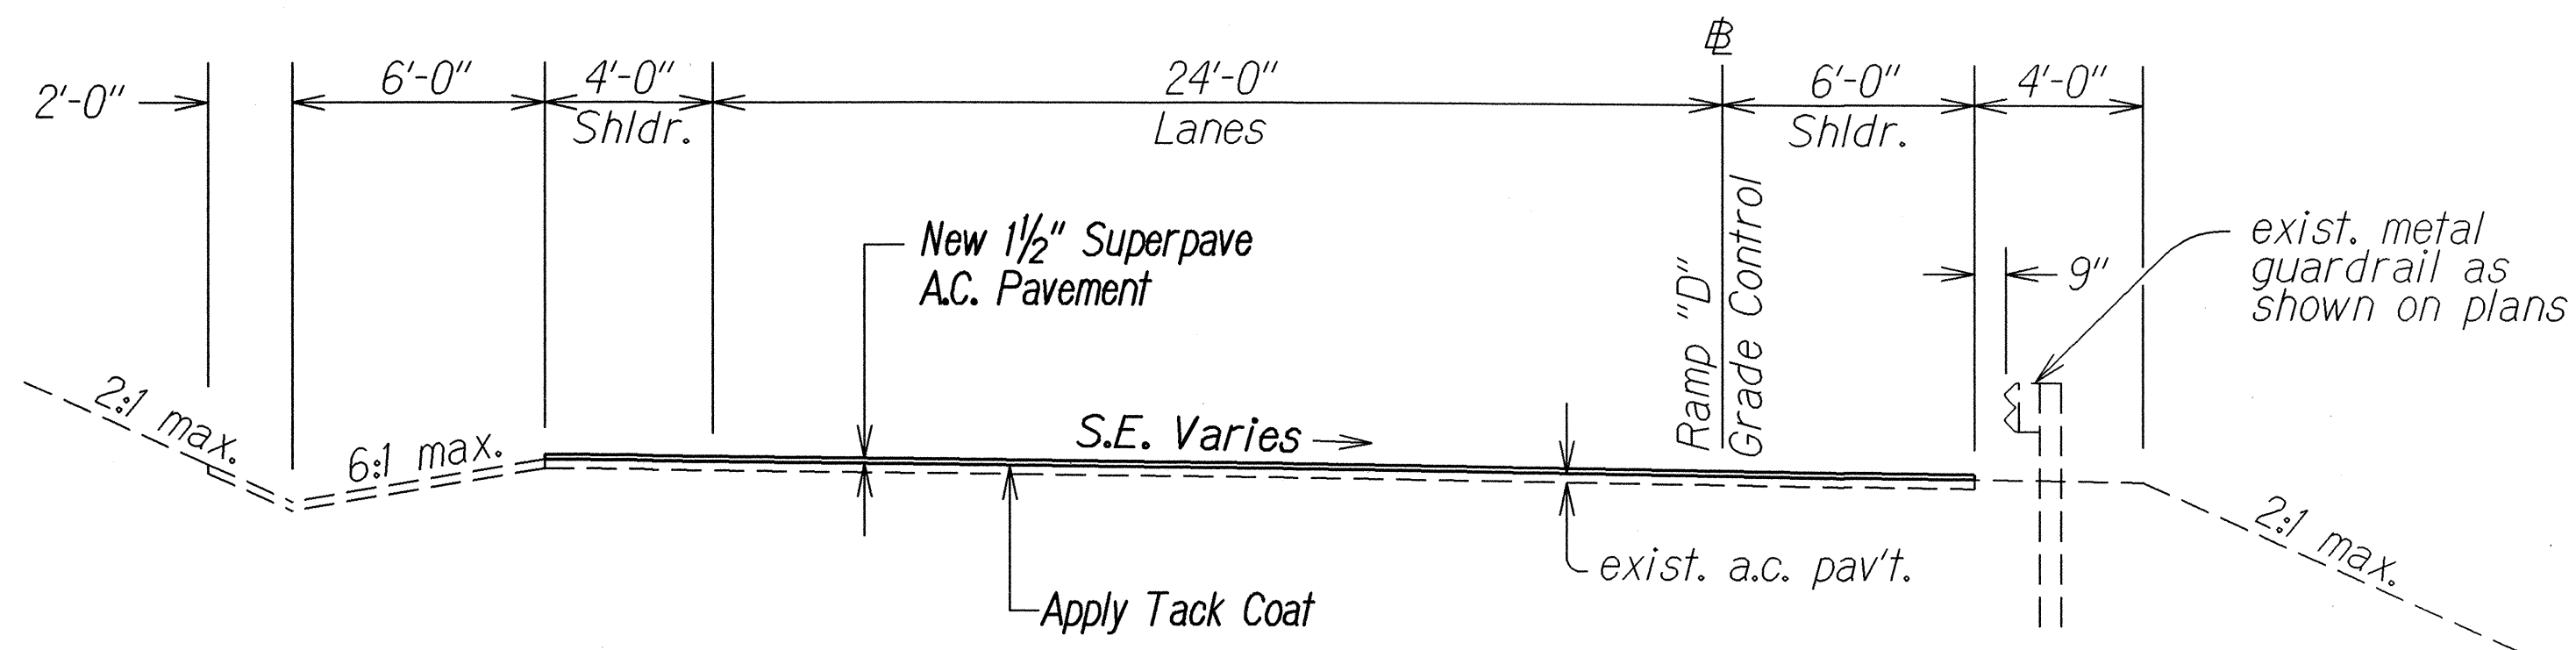

RAMP "TK" TYPICAL SECTION
Scale: 1/4" = 1'-0"

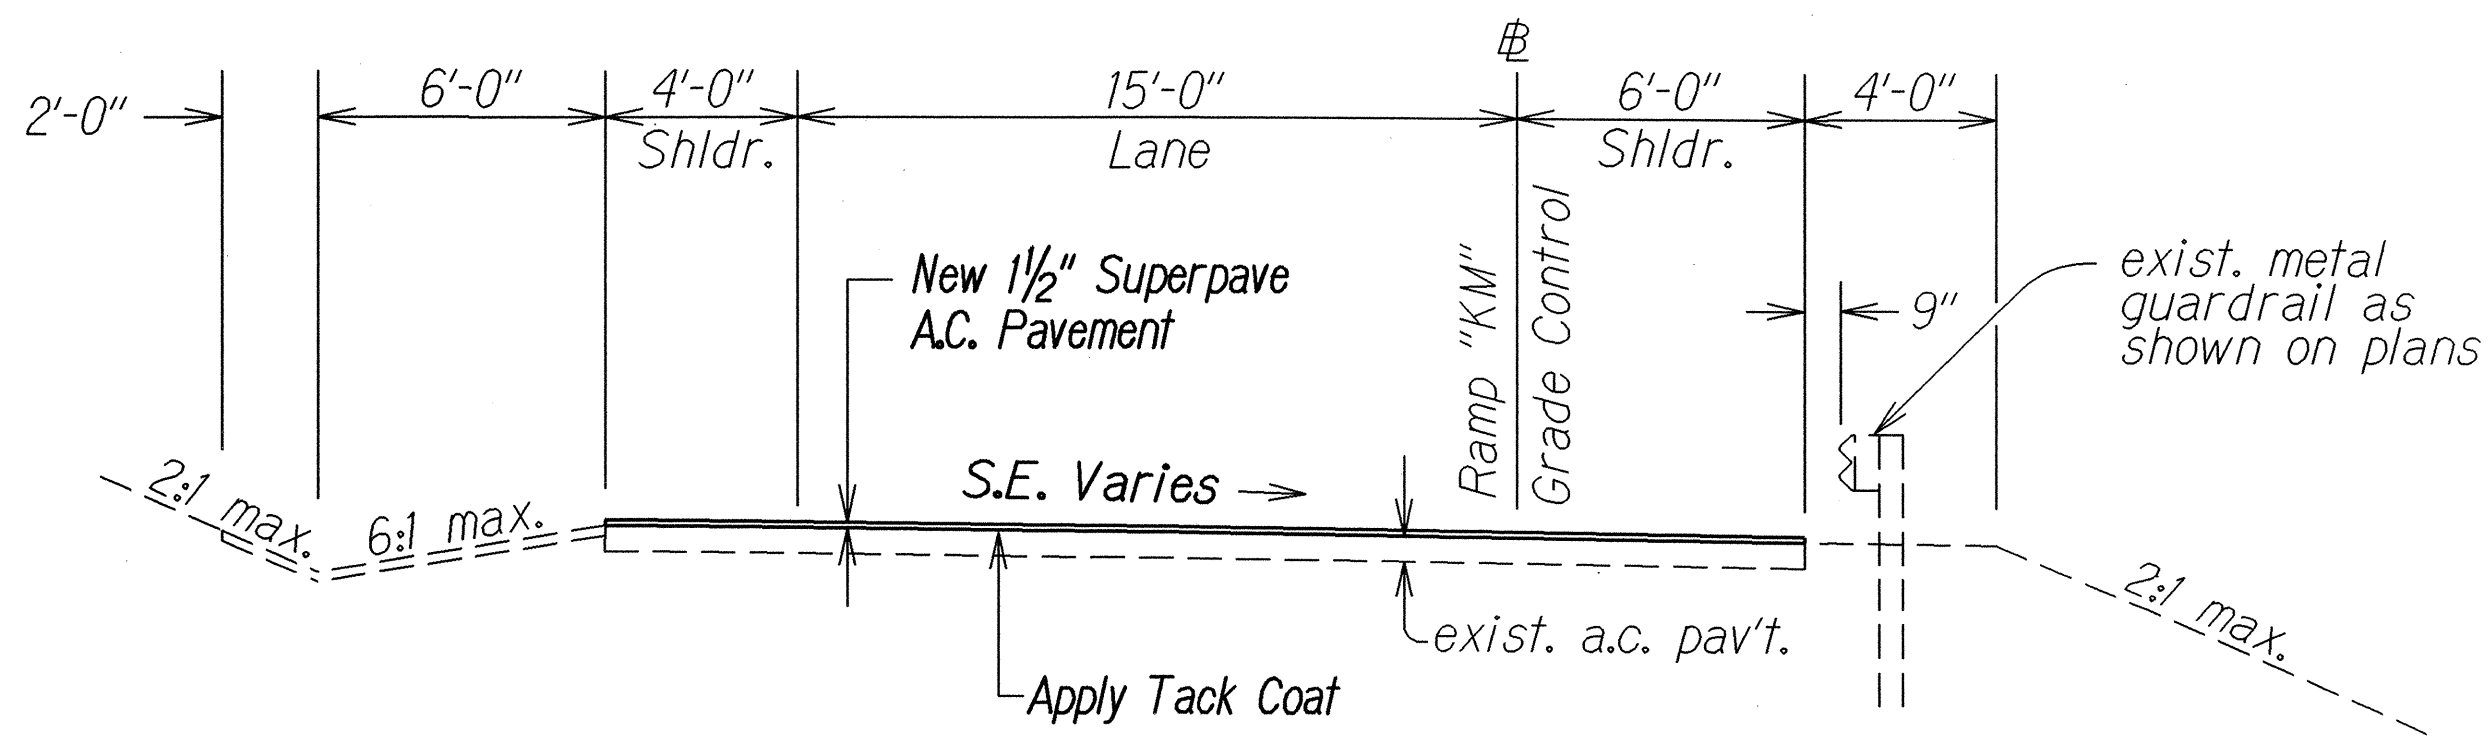

RAMP "KM" TYPICAL SECTION
Scale: 1/4" = 1'-0"

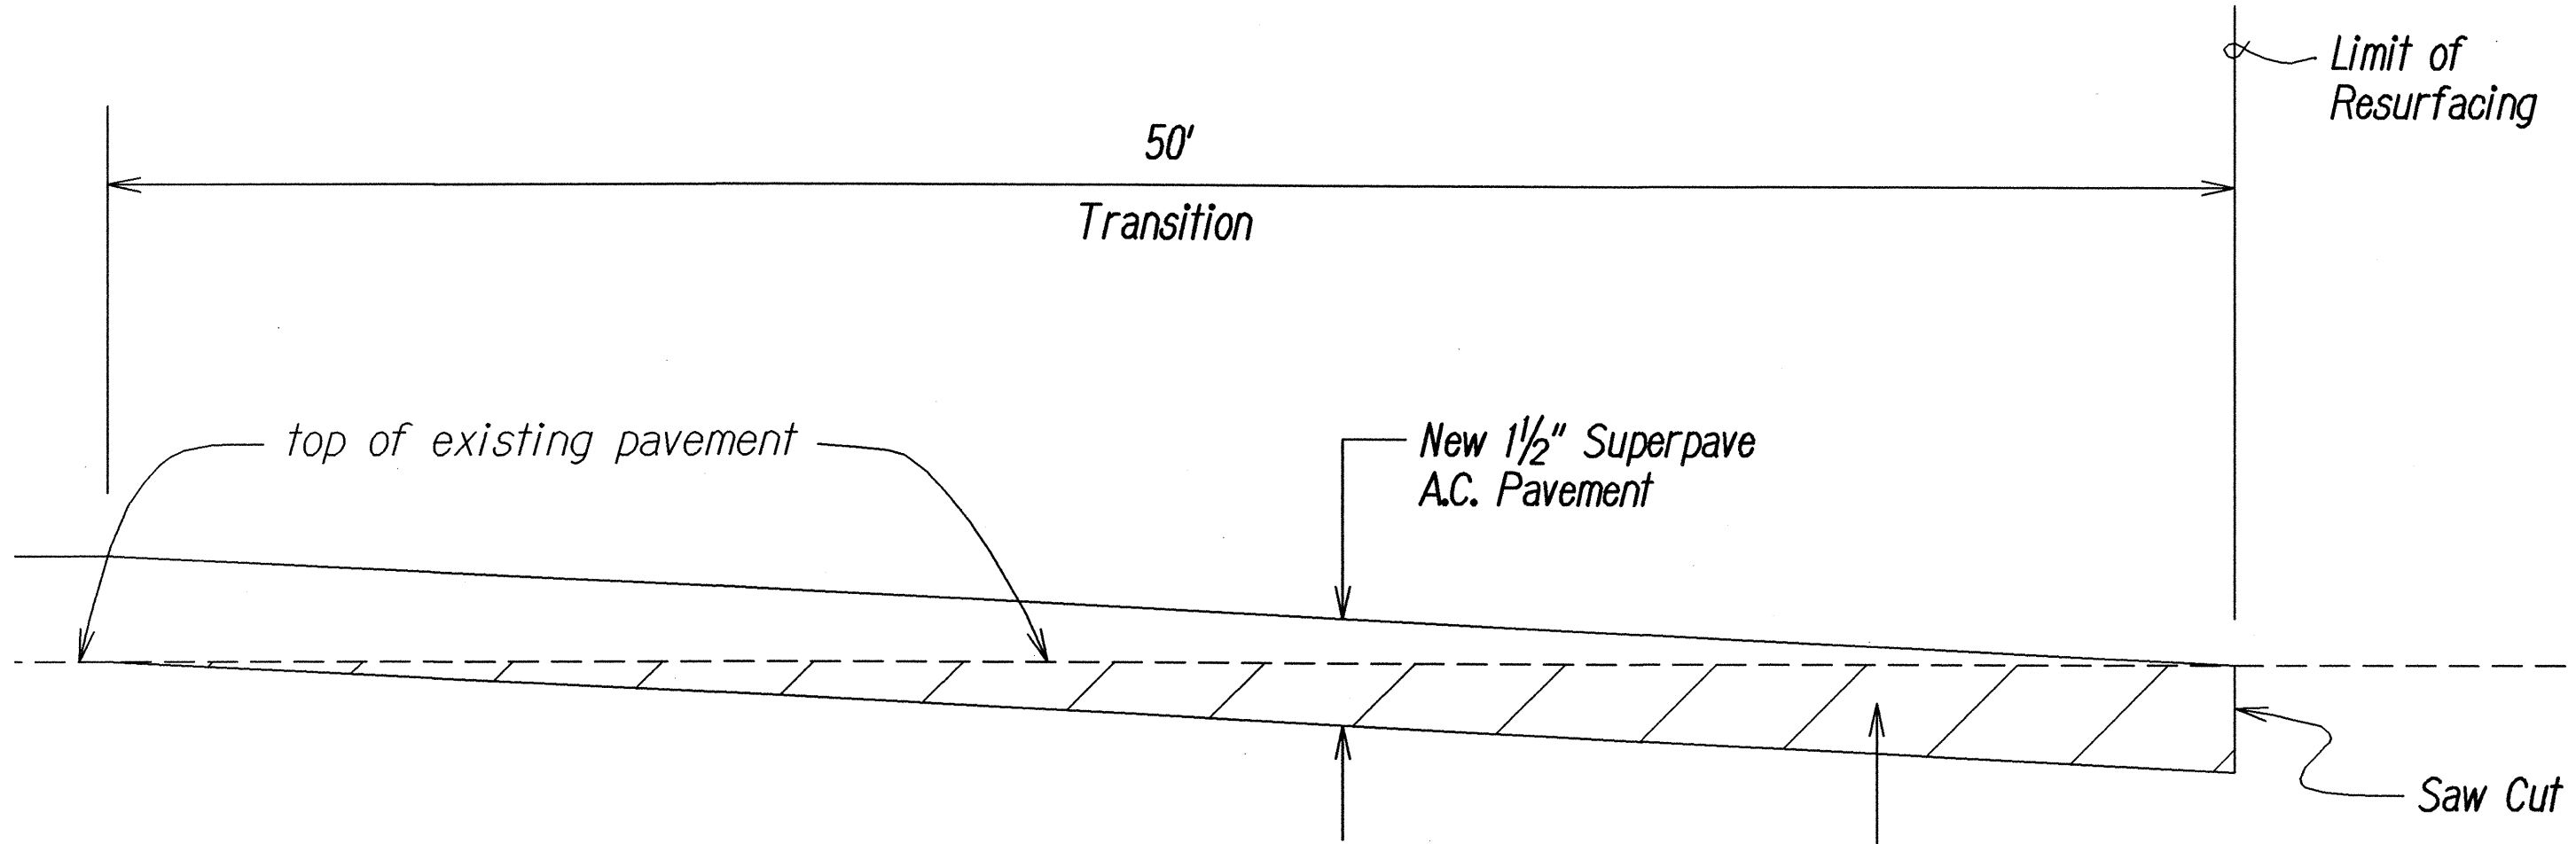

COLD PLANED TRANSITION TO EXISTING A.C. PAVEMENT
Not to Scale

ORIGINAL PLAN	SURVEY PLOTTED BY	DATE
NOTE BOOK	DRAWN BY	4/21/03
DESIGNED BY	DESIGNED BY	
QUANTITIES BY	QUANTITIES BY	
CHECKED BY	CHECKED BY	



STATE OF HAWAII
DEPARTMENT OF TRANSPORTATION
HIGHWAYS DIVISION

TYPICAL SECTIONS AND DETAILS

LIKELIKE HIGHWAY PAVEMENT PREVENTATIVE MAINTENANCE
End of Wilson Tunnel to Kamehameha Highway
Project No. HWY-0-05-06M


Scale: As Noted Date: May 2006
SHEET No. 5 OF 6 SHEETS

FED. ROAD DIST. NO.	STATE	PROJ. NO.	FISCAL YEAR	SHEET NO.	TOTAL SHEETS
HAWAII	HAW.	HWY-0-05-06M	2007	11	0

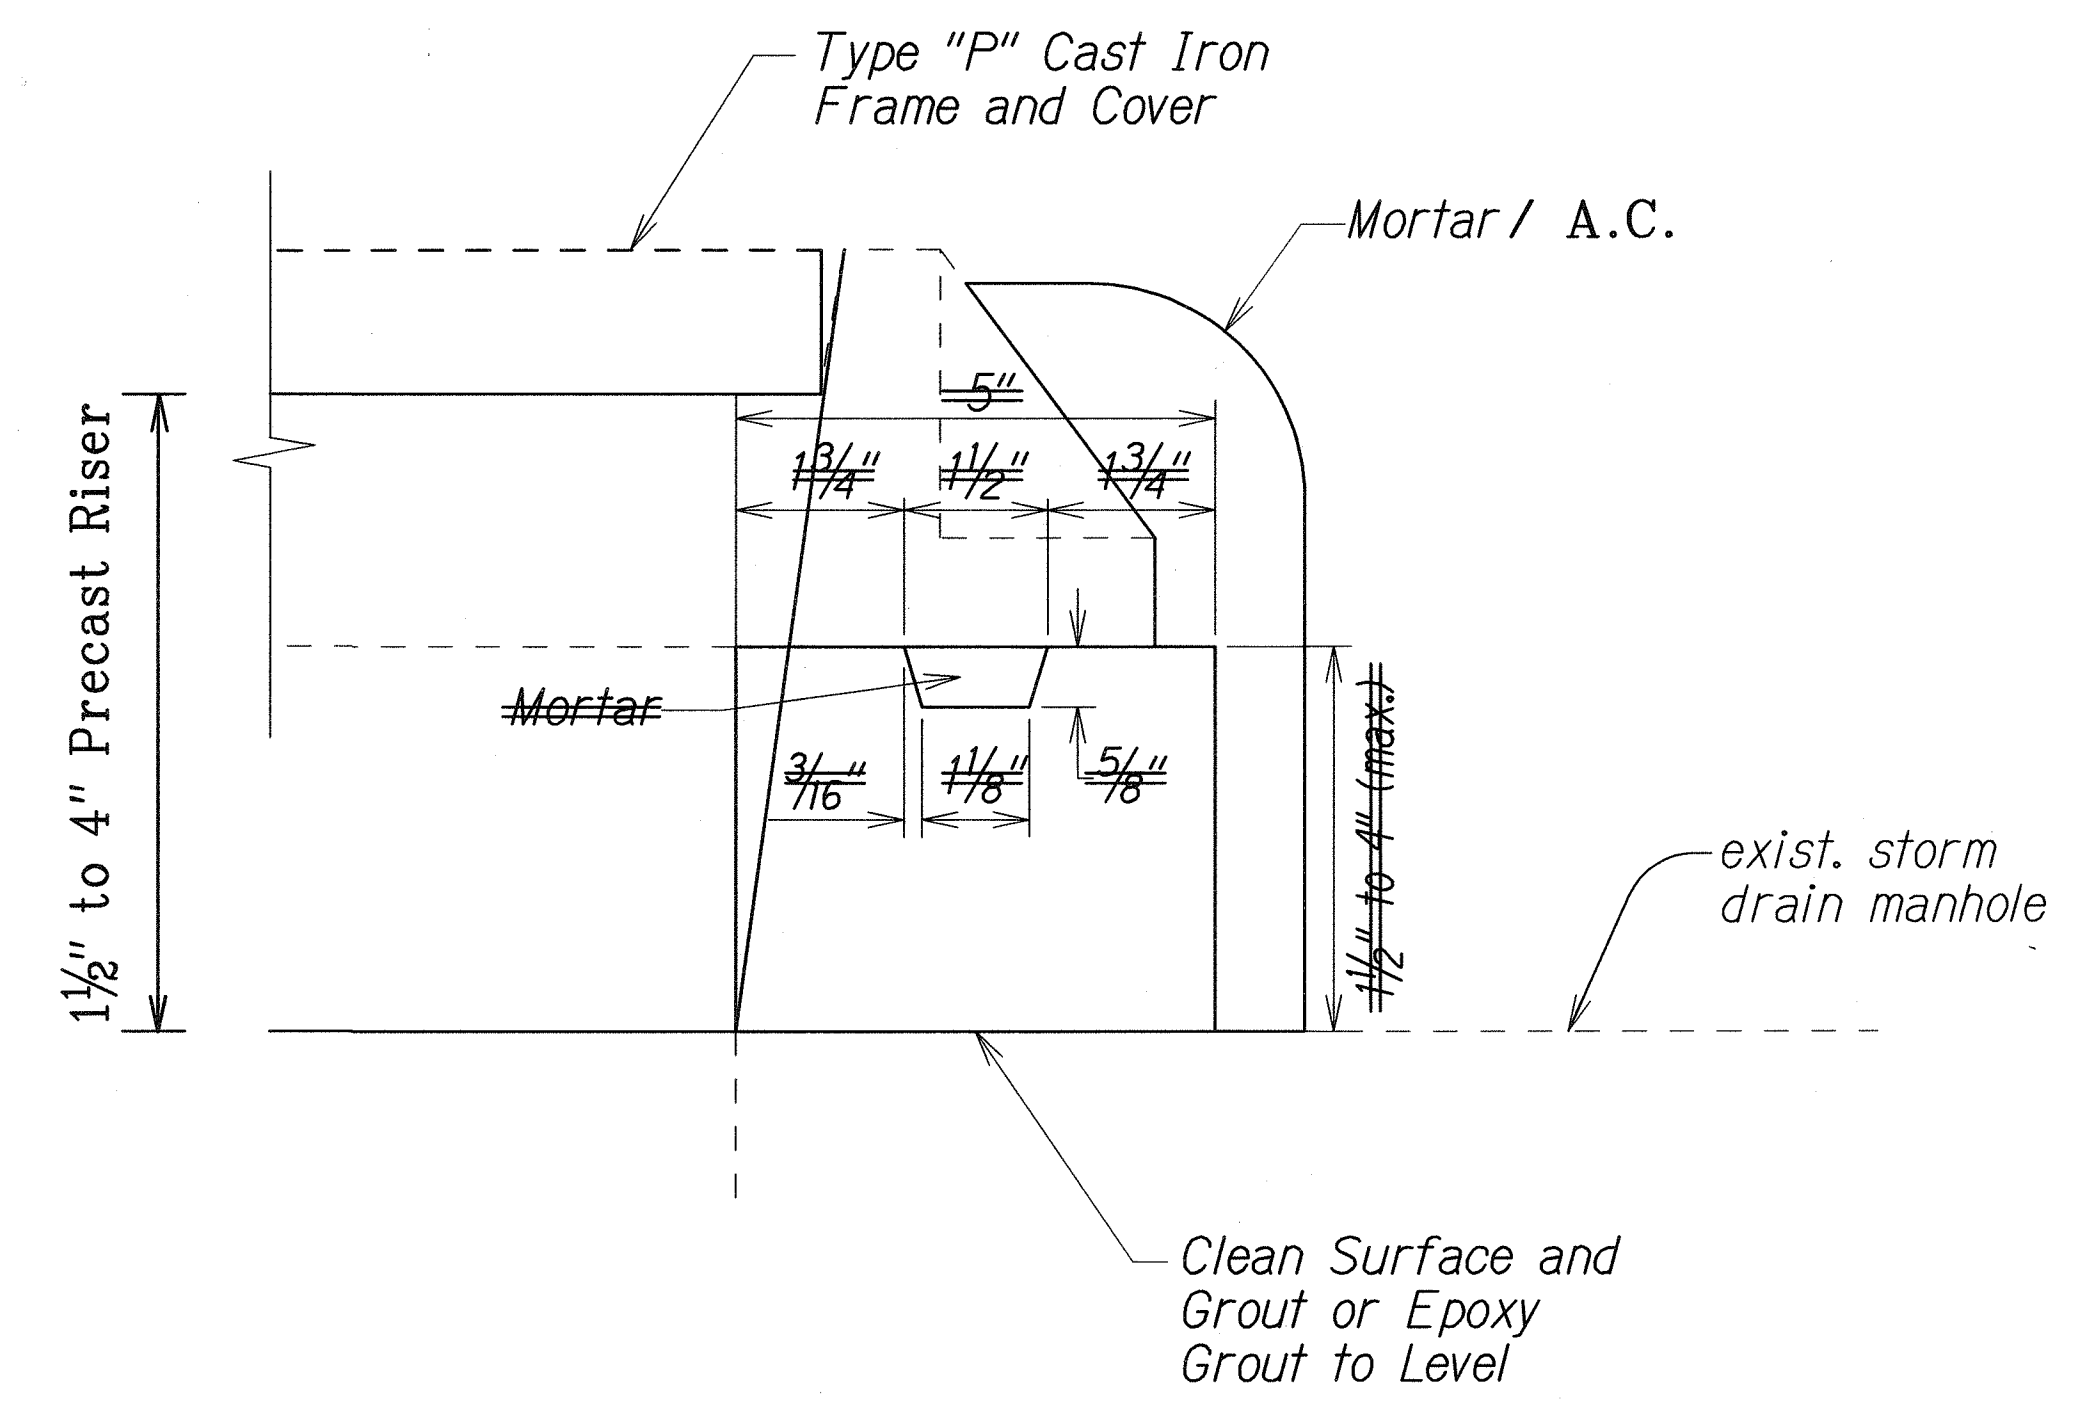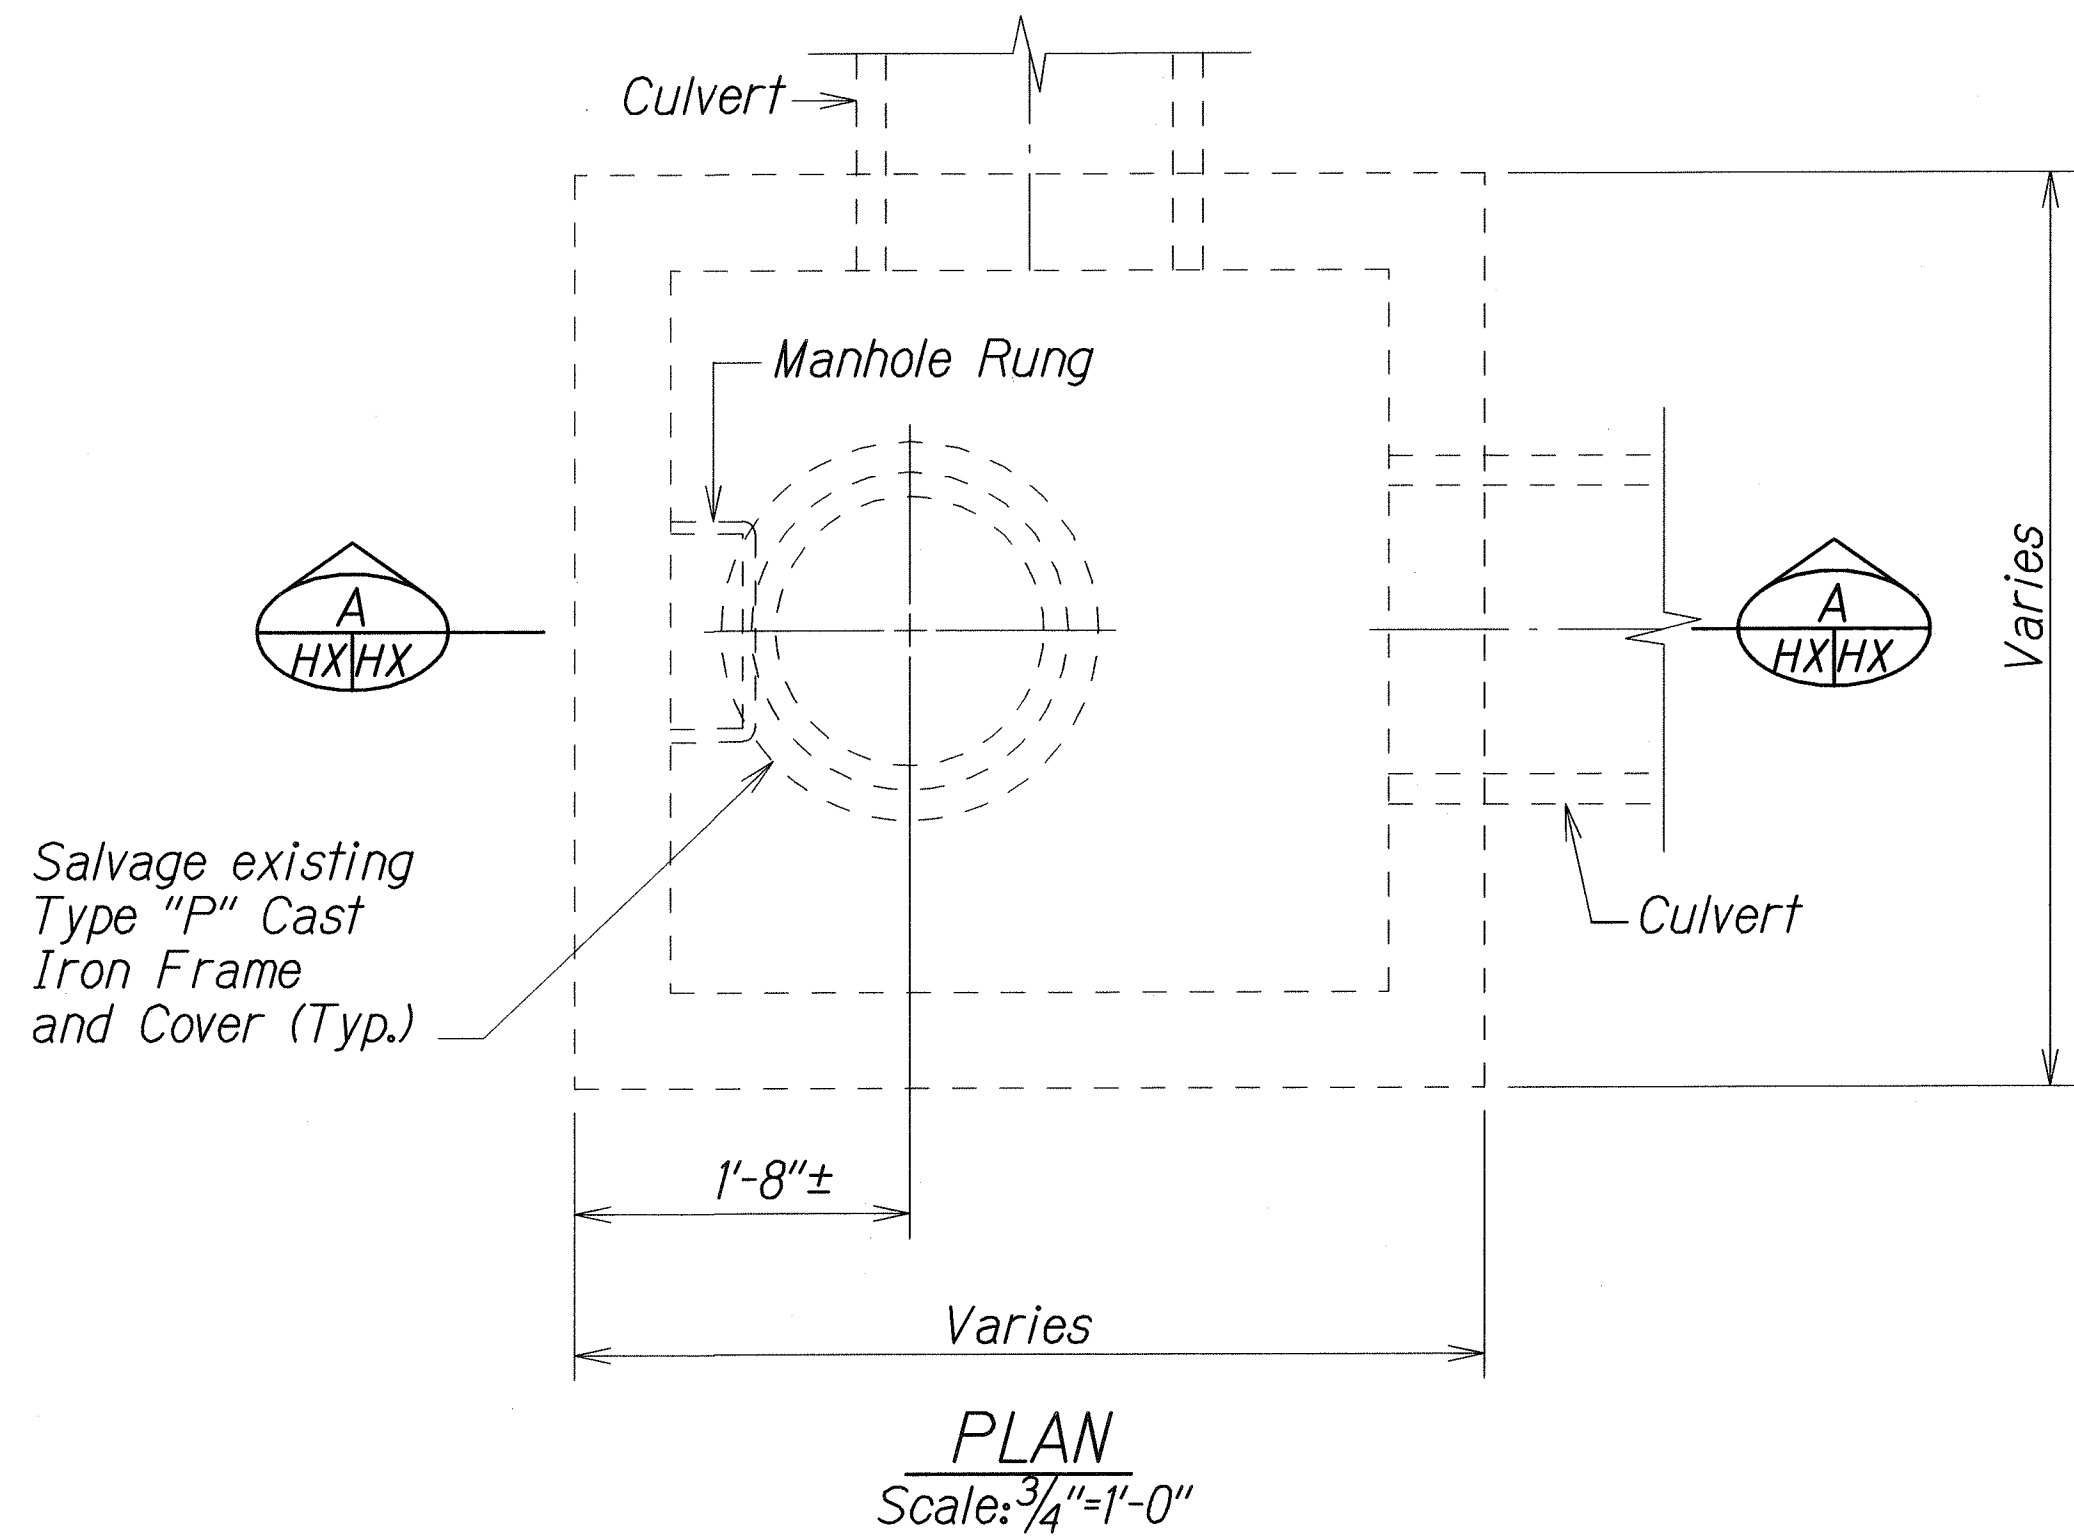

GRADE RING DETAIL
Scale: 6"-1'-0"

Note:
1. Contractor Shall Verify Dimensions in Field Prior to Raising Manhole

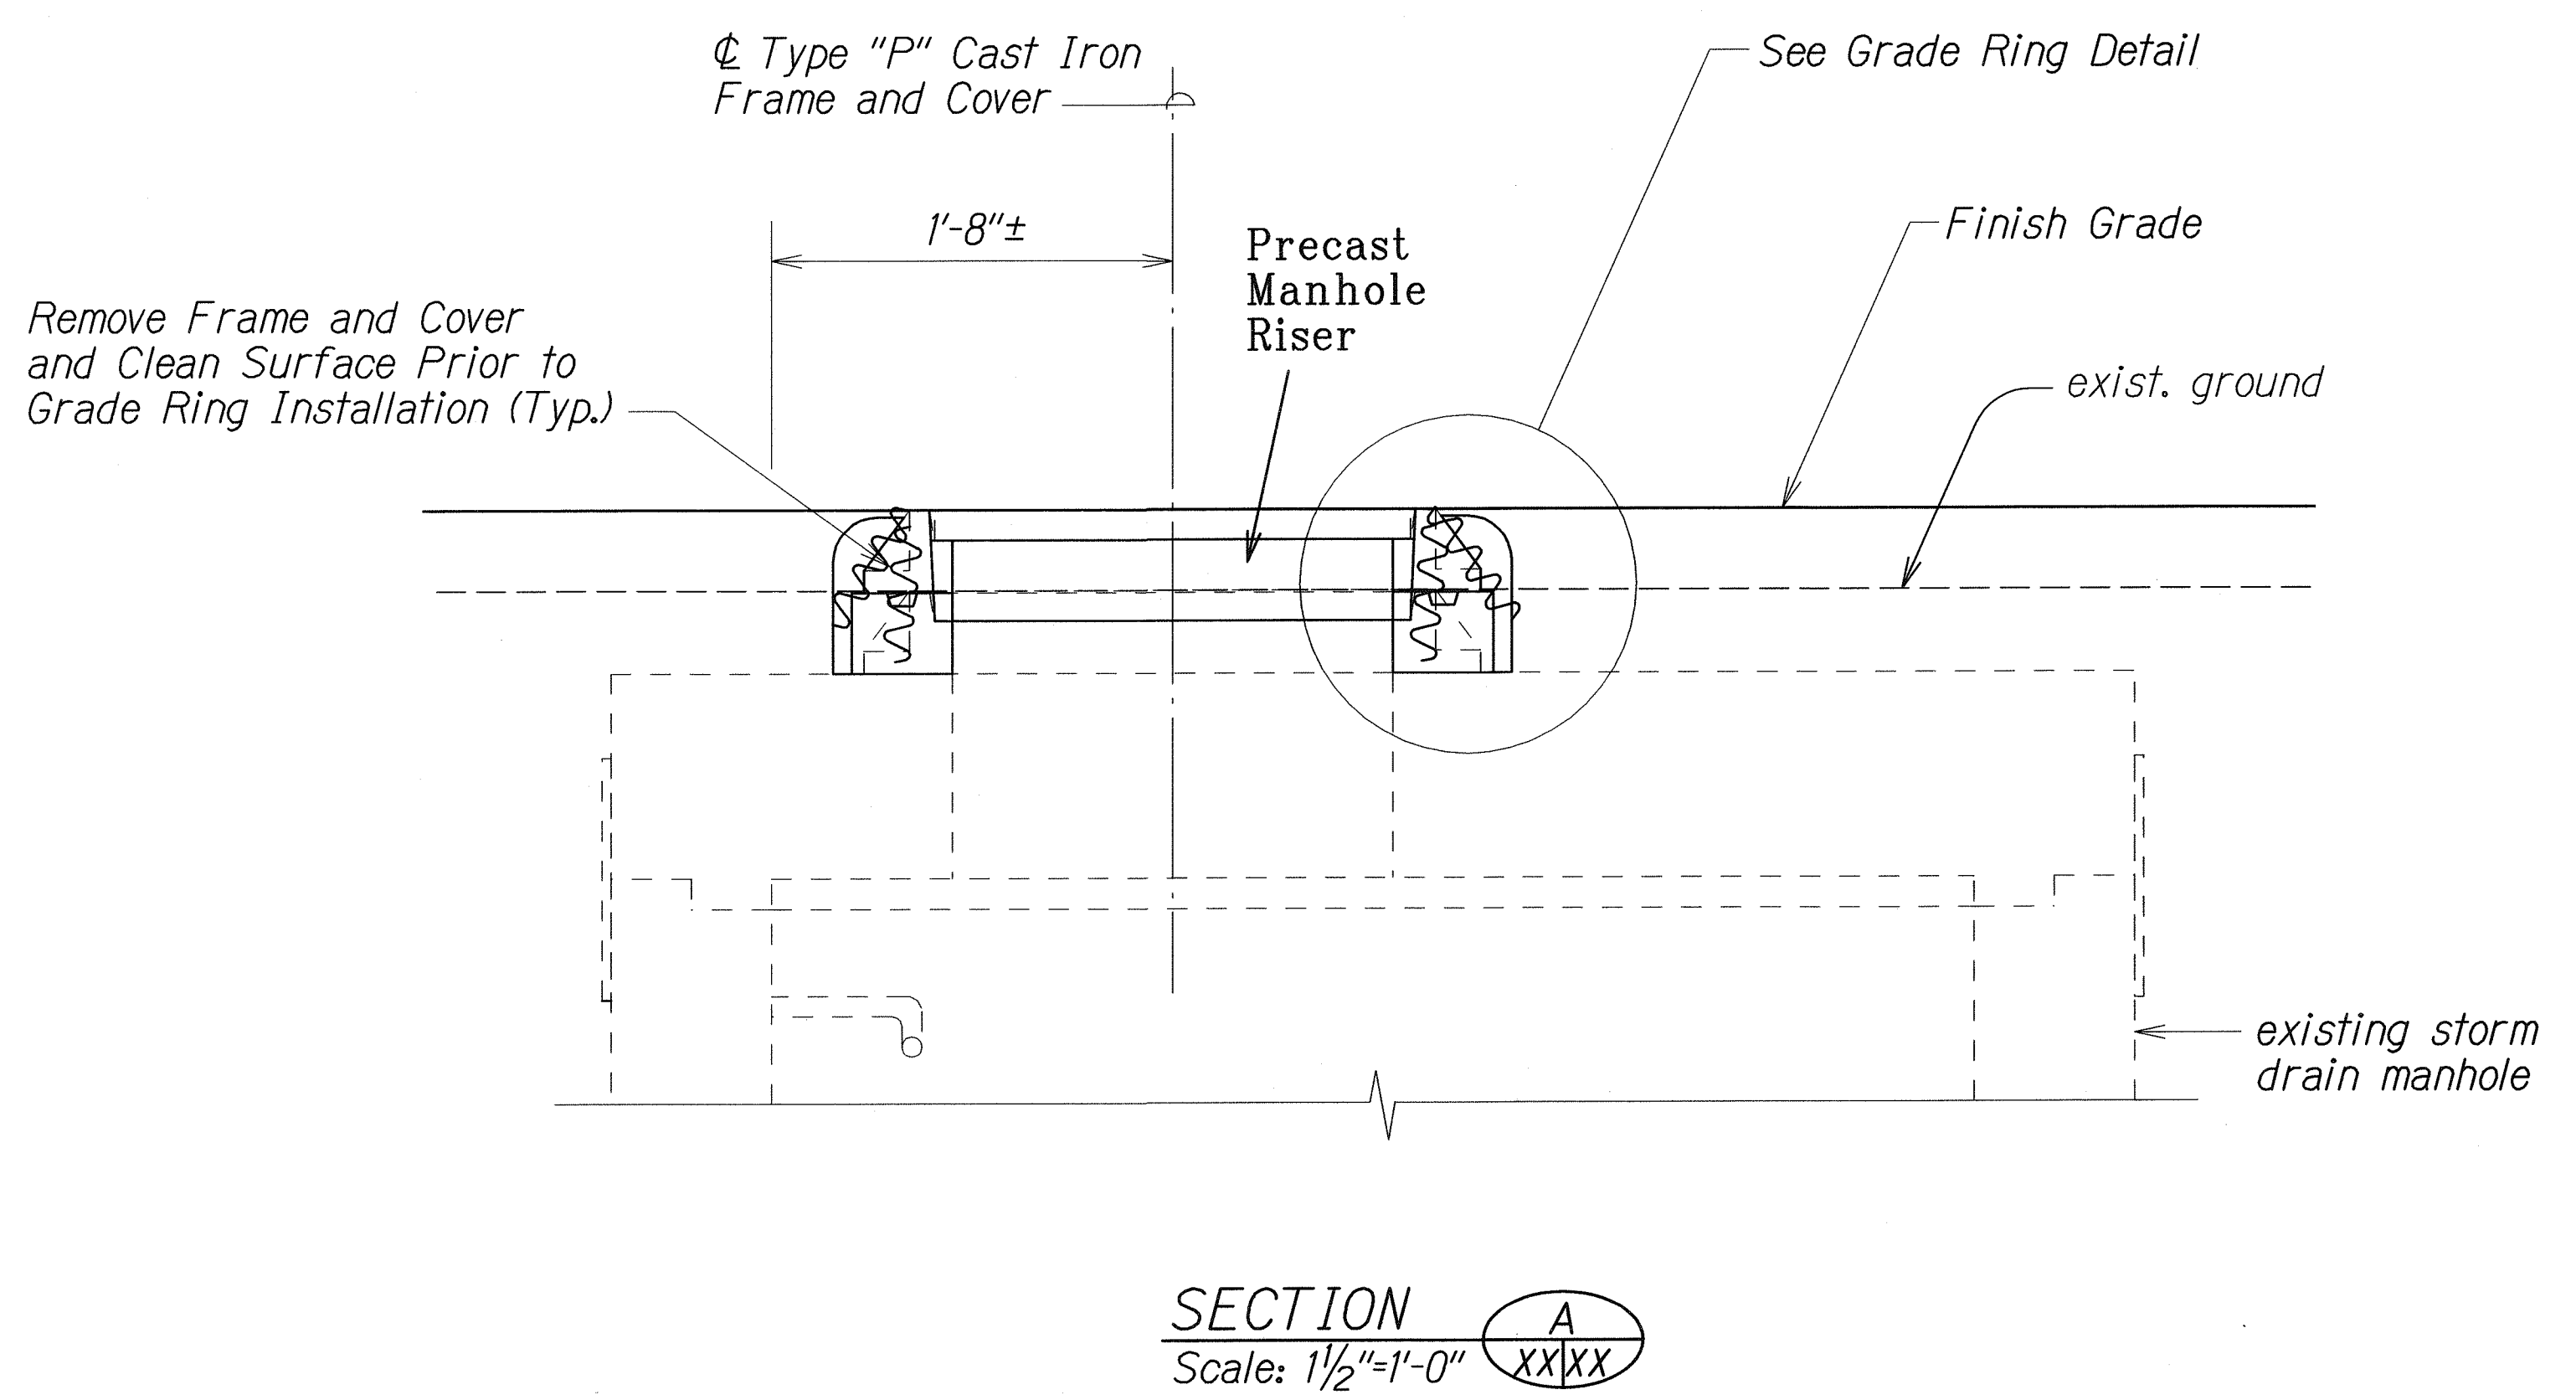

LEGEND FOR AS-BUILT POSTINGS	
	Squiggly line for as-built deletion
	Double line for as-built deletion
	Text for as-built posting

MANHOLE ADJUSTMENT DETAIL FOR TYPE A, B, AND C STORM DRAIN MANHOLES

STATE OF HAWAII
DEPARTMENT OF TRANSPORTATION
HIGHWAYS DIVISION

DRAINAGE DETAIL
LIKELIKE HIGHWAY
PAVEMENT PREVENTATIVE MAINTENANCE
End of Wilson Tunnel to Kamehameha Highway
Project No. HWY-0-05-06M
Scale: As Shown Date: May 2006

SHEET No. 6 OF 6 SHEETS

ORIGINAL PLAN	DATE
DESIGNED BY	
QUANTITIES BY	
CHECKED BY	