

INDEX TO DRAWINGS	
SHEET NO.	DESCRIPTION
1	TITLE SHEET
2-5	INTERSECTION MAPS
6	FOOTING DETAIL (26' STANDARD)
7-12	STANDARD DETAILS
13-14	REGULATORY & WARNING SIGNS
15	TYPE C PULLBOX DETAIL

STATE OF HAWAII
DEPARTMENT OF TRANSPORTATION
DIVISION OF HIGHWAYS
HONOLULU, HAWAII



"AS BUILT"
PLANS FOR
INSTALLATION OF TRAFFIC SIGNAL SYSTEMS
ON
OAHU

PROJECT NUMBERS

A 720 - 01-61
A 720 - 02-61
A 92 - 02-61
C 72 - 01-61

CONVENTIONAL SIGNS

2" STEEL CONDUIT ENCASED IN CONCRETE
2" CEMENT ASBESTOS CONDUIT ENCASED IN CONCRETE
MK OR HR DETECTORS
TYPE "A" PULLBOX
TRAFFIC SIGNAL CONTROLLER
EXISTING POWER POLE
TRAFFIC SIGNAL STANDARD WITH 8" LENS ASSEMBLY
TRAFFIC SIGNAL STANDARD WITH 12" LENS ASSEMBLY
TYPE "C" PRECAST PULLBOX

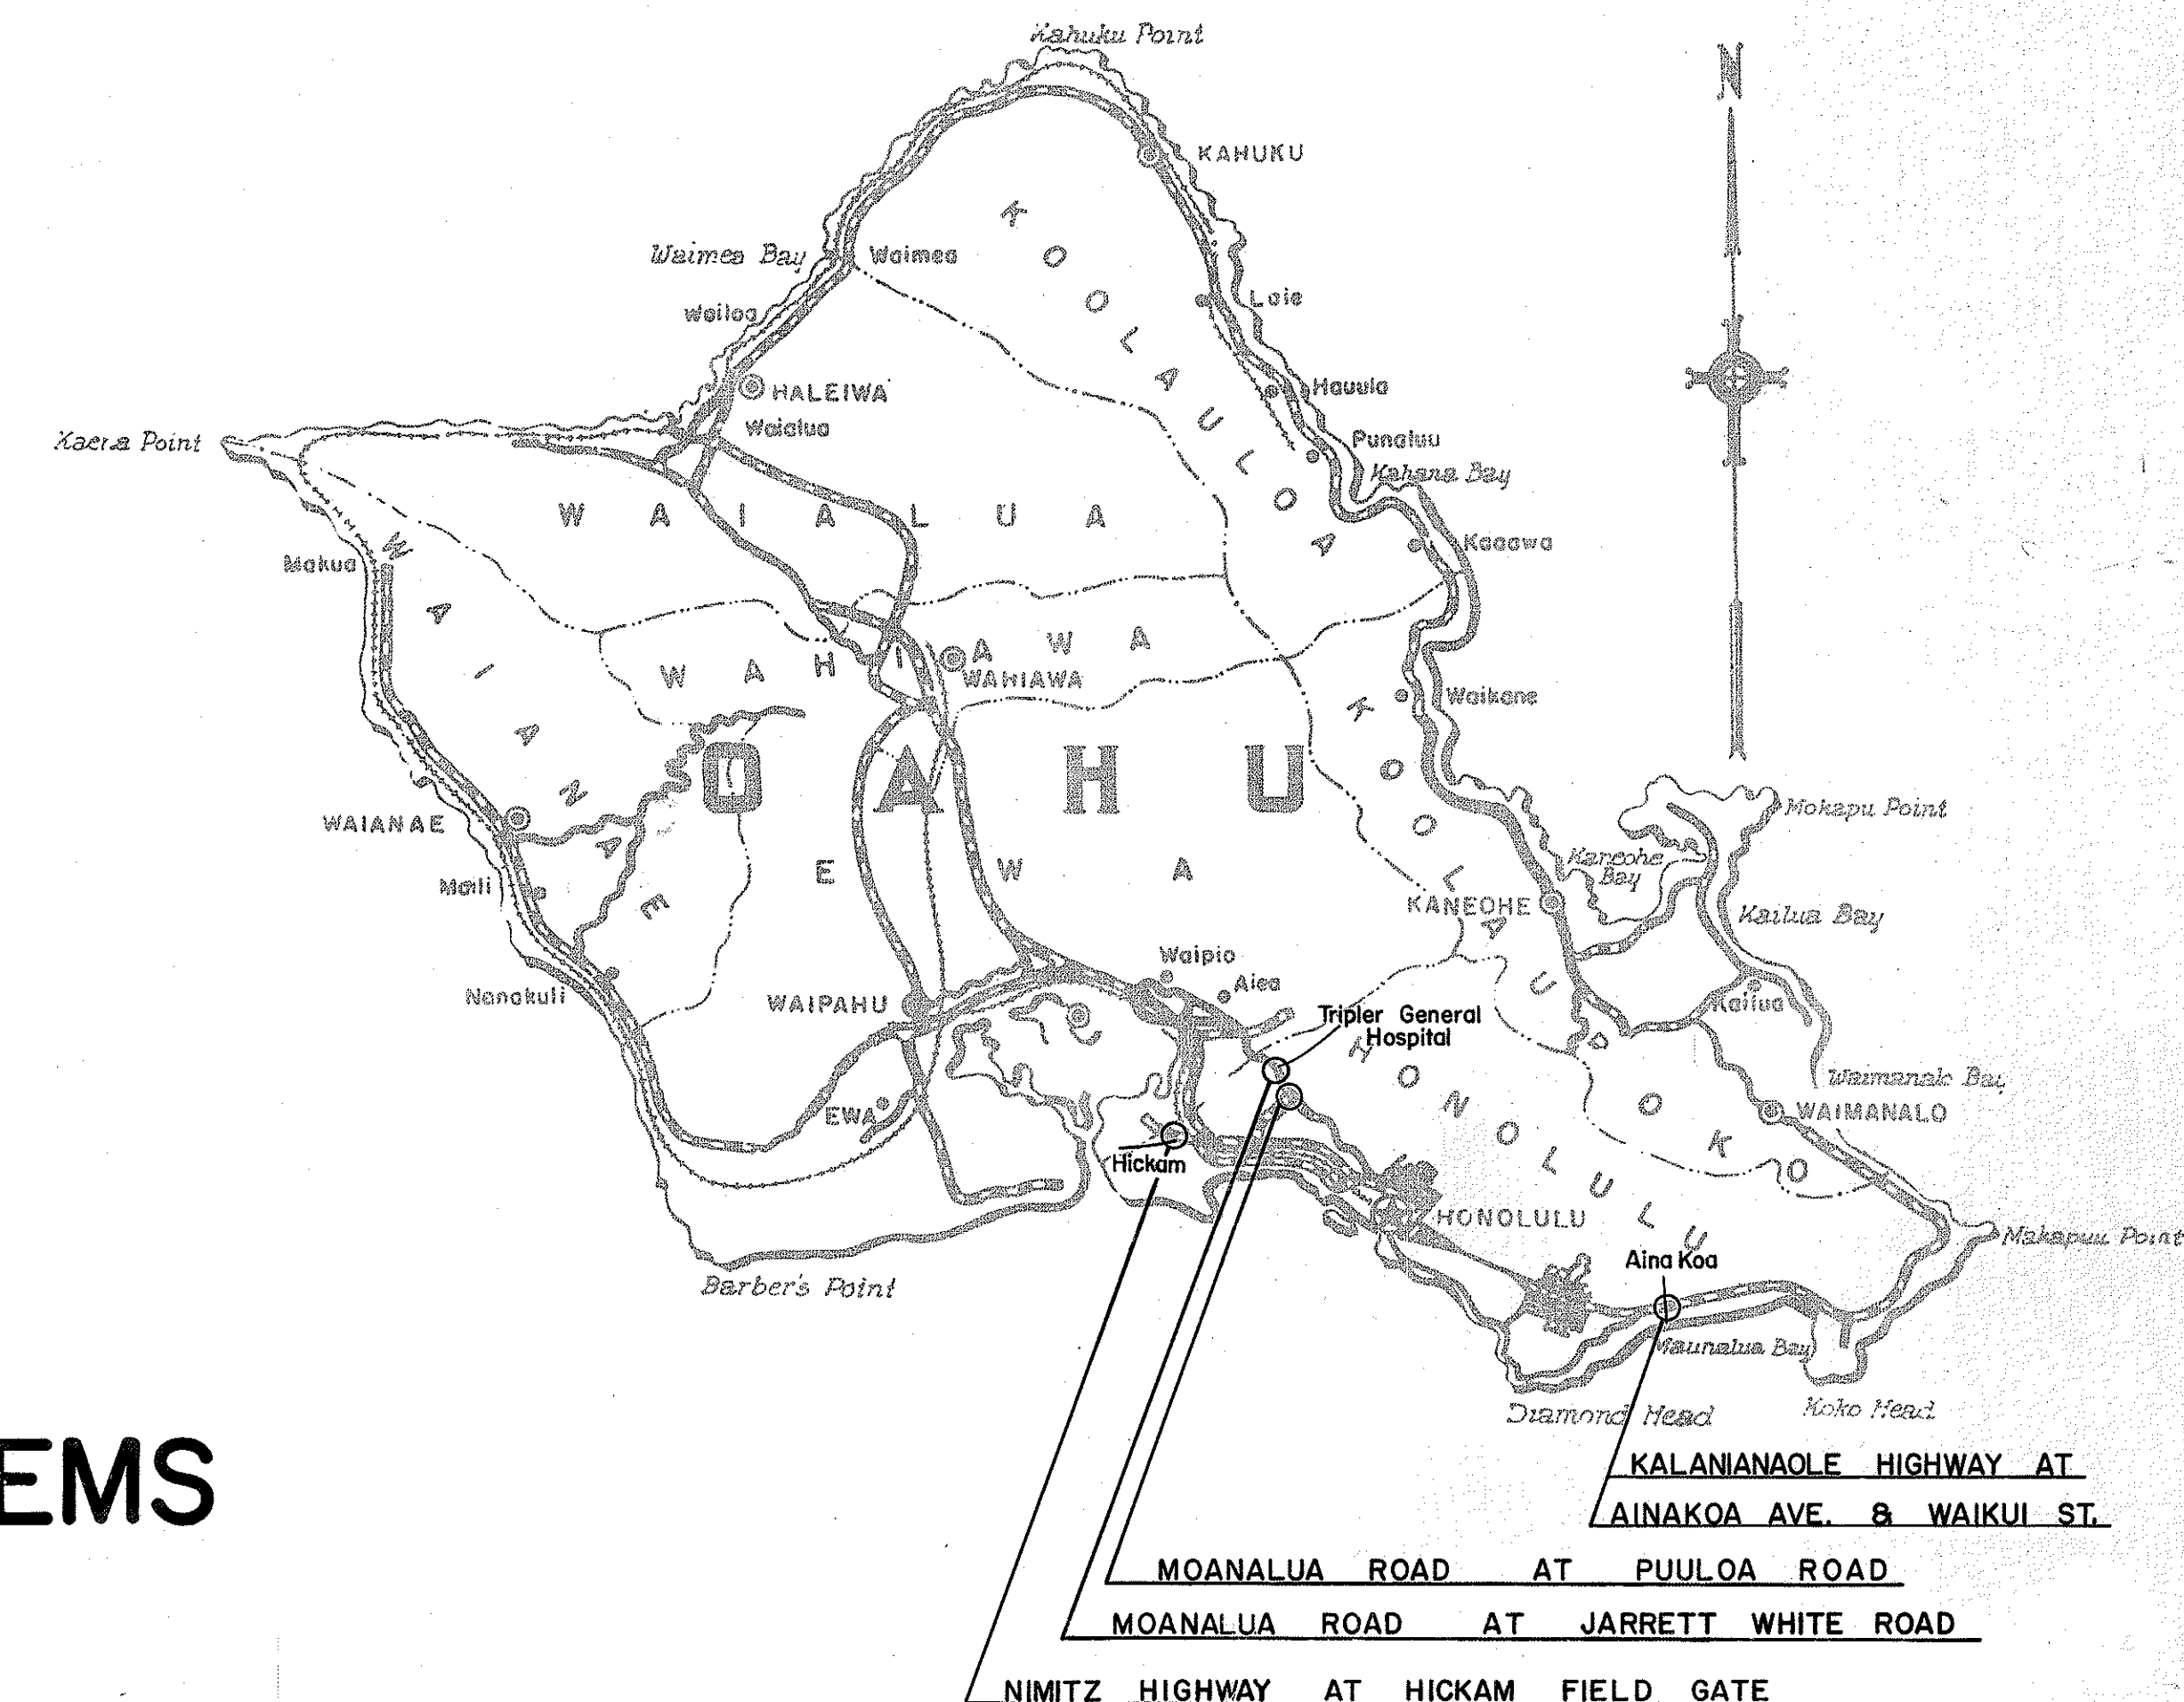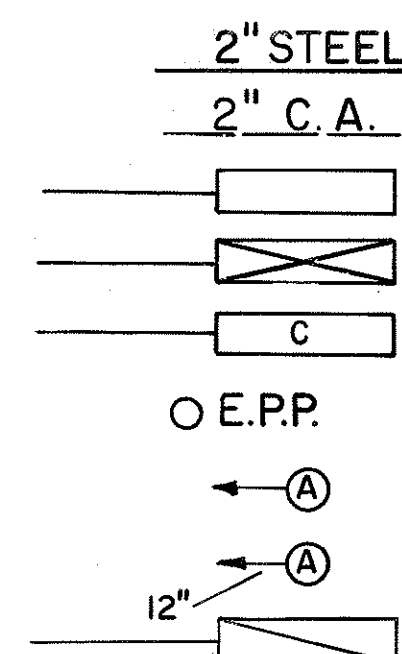

NOTE:
ALL CHANGES MADE DURING CONSTRUCTION
HAVE BEEN NOTED ON THESE TRACINGS
IN RED AND CHECKED BY:




PROJECT ENGINEER

9-15-61

DATE:

APPROVED:
DATE 6-19-61

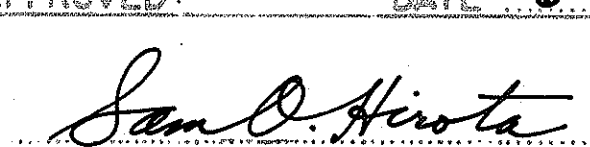

Actg. DIRECTOR OF TRANSPORTATION

SURVEY PLATTED BY	DATE
DESIGNED BY	
TRACED BY	
QUANTITIES BY	
CHECKED BY	
NOTE BOOK	
No.	