
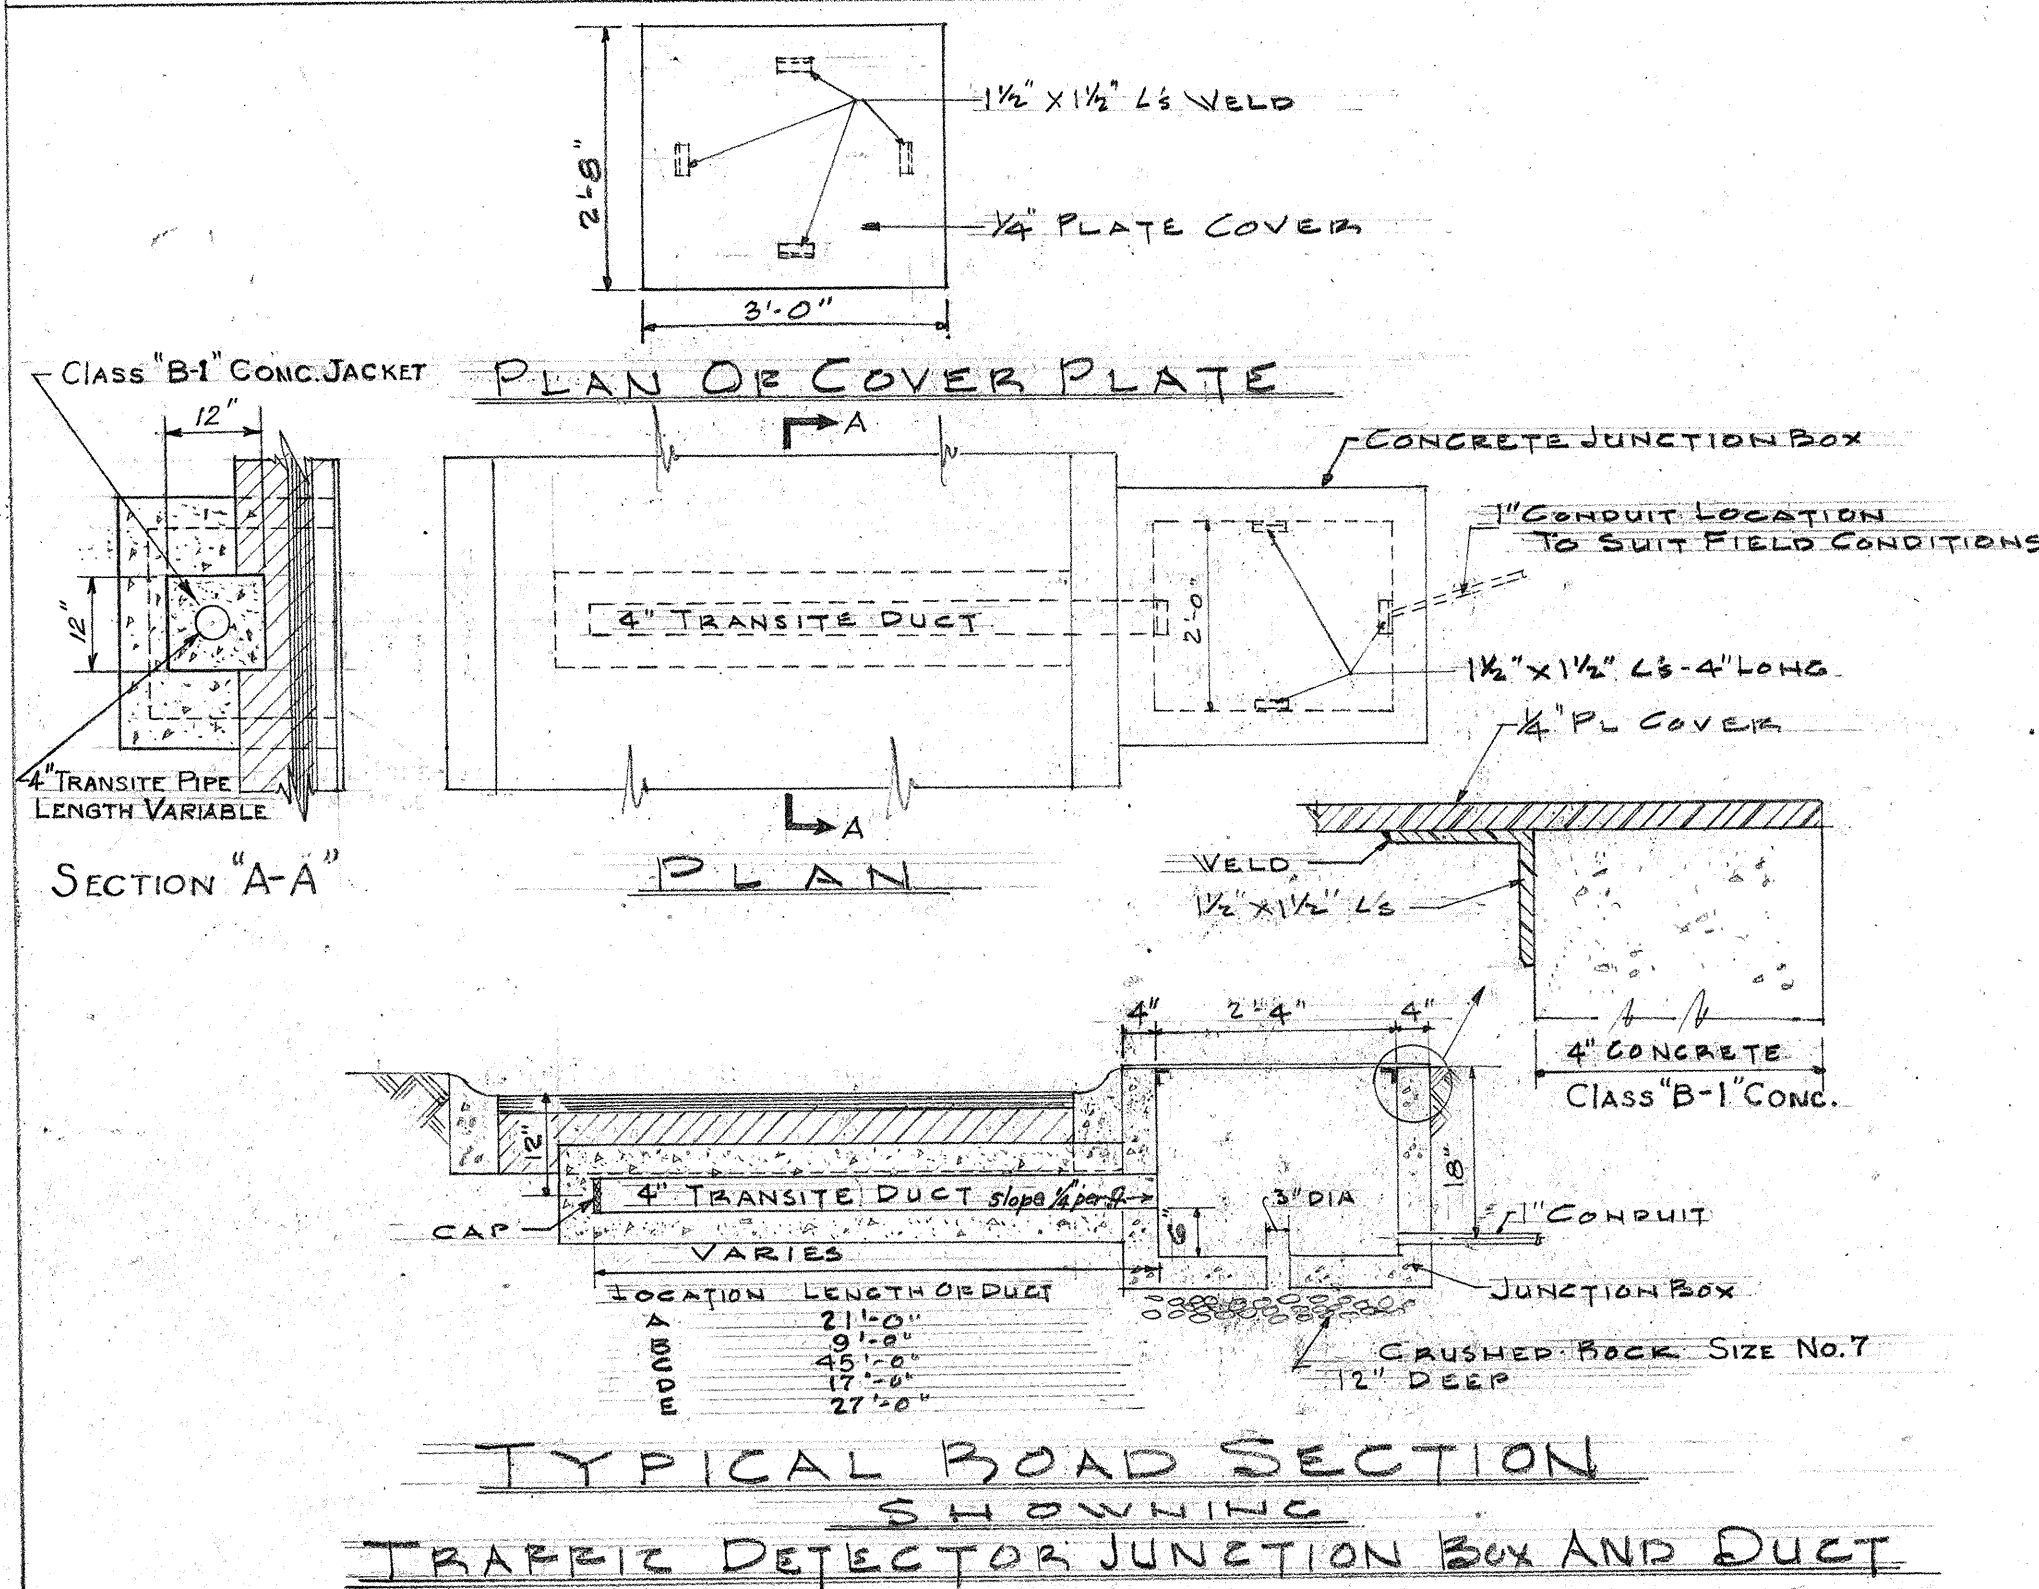
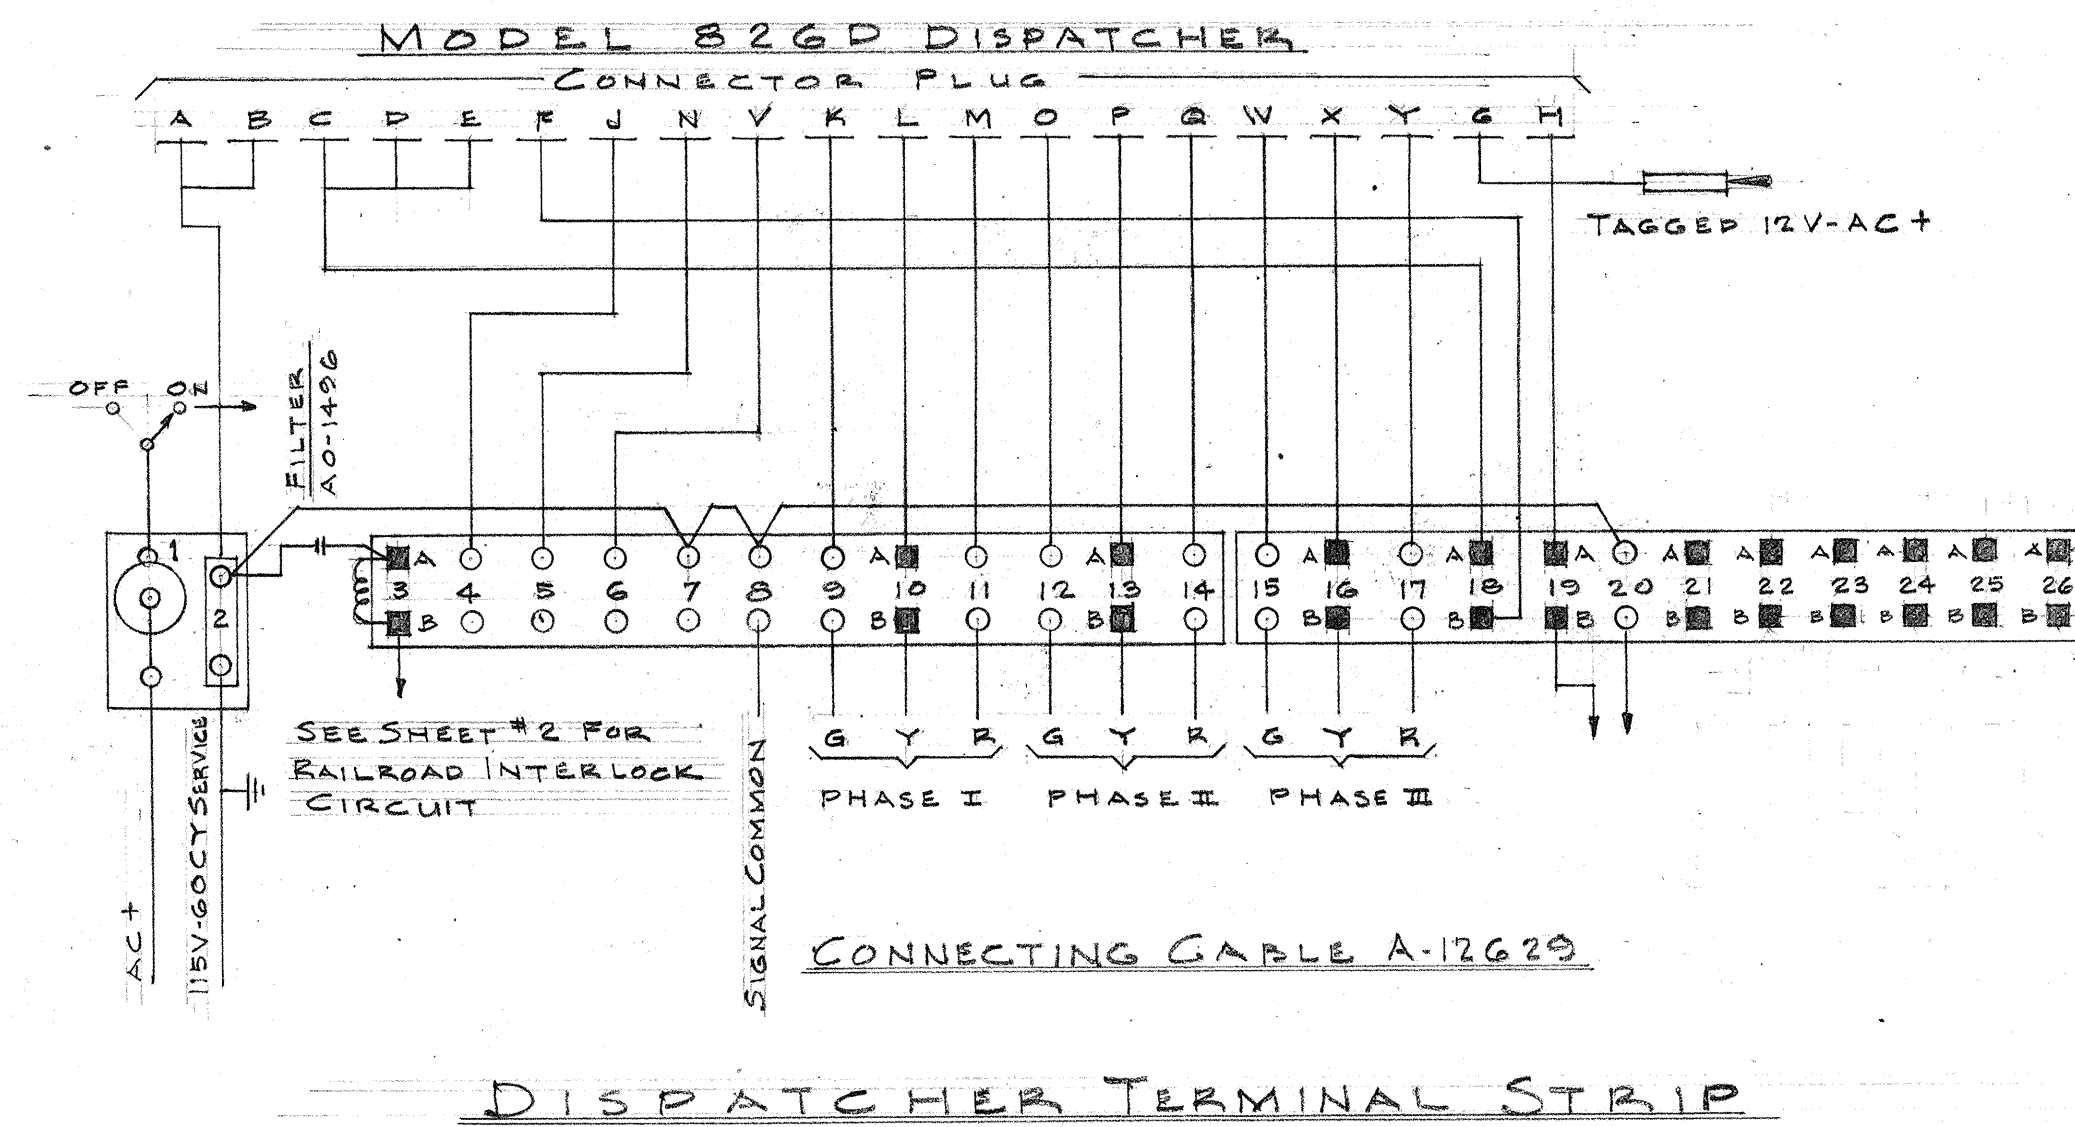
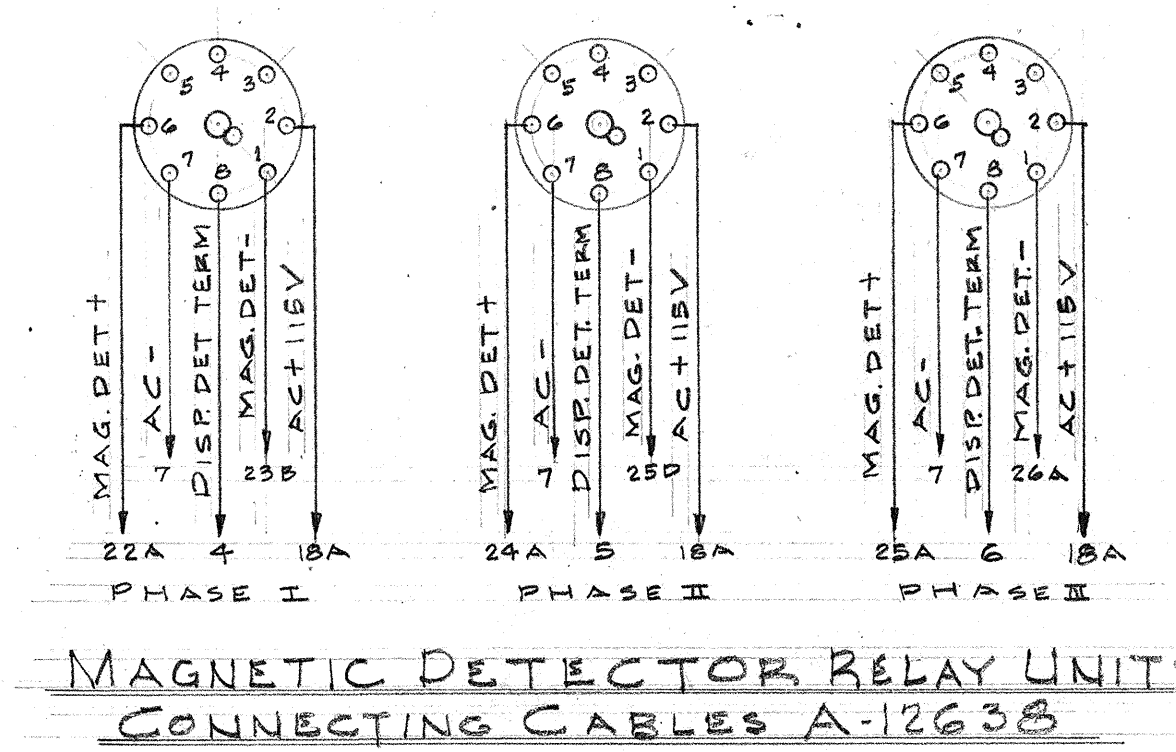
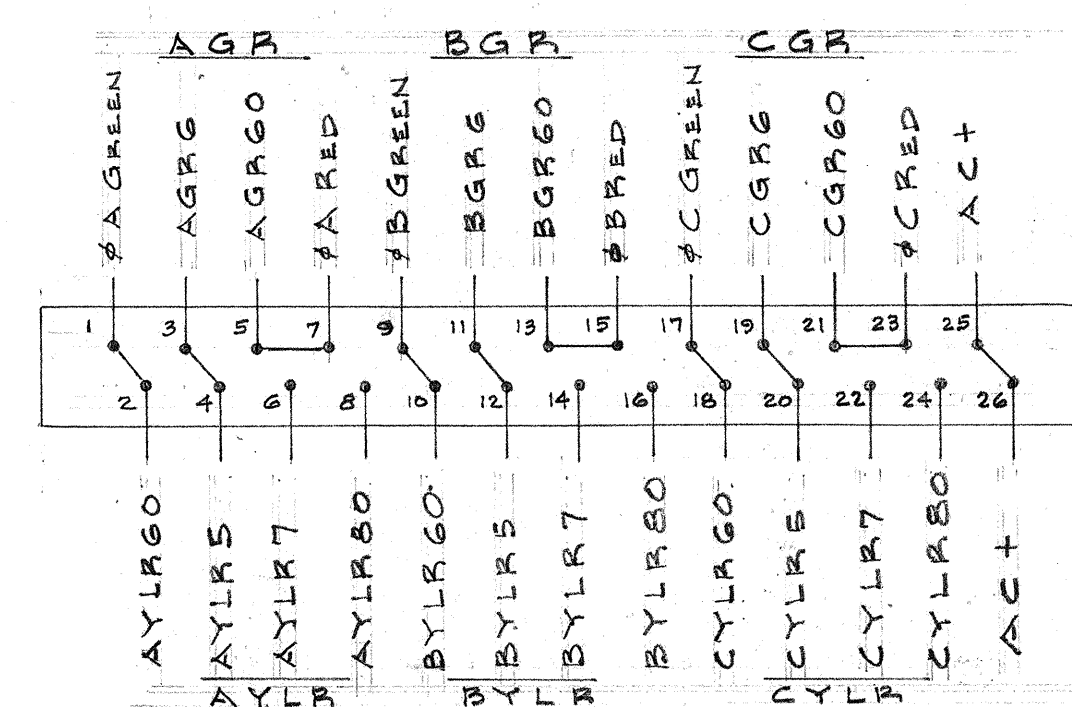
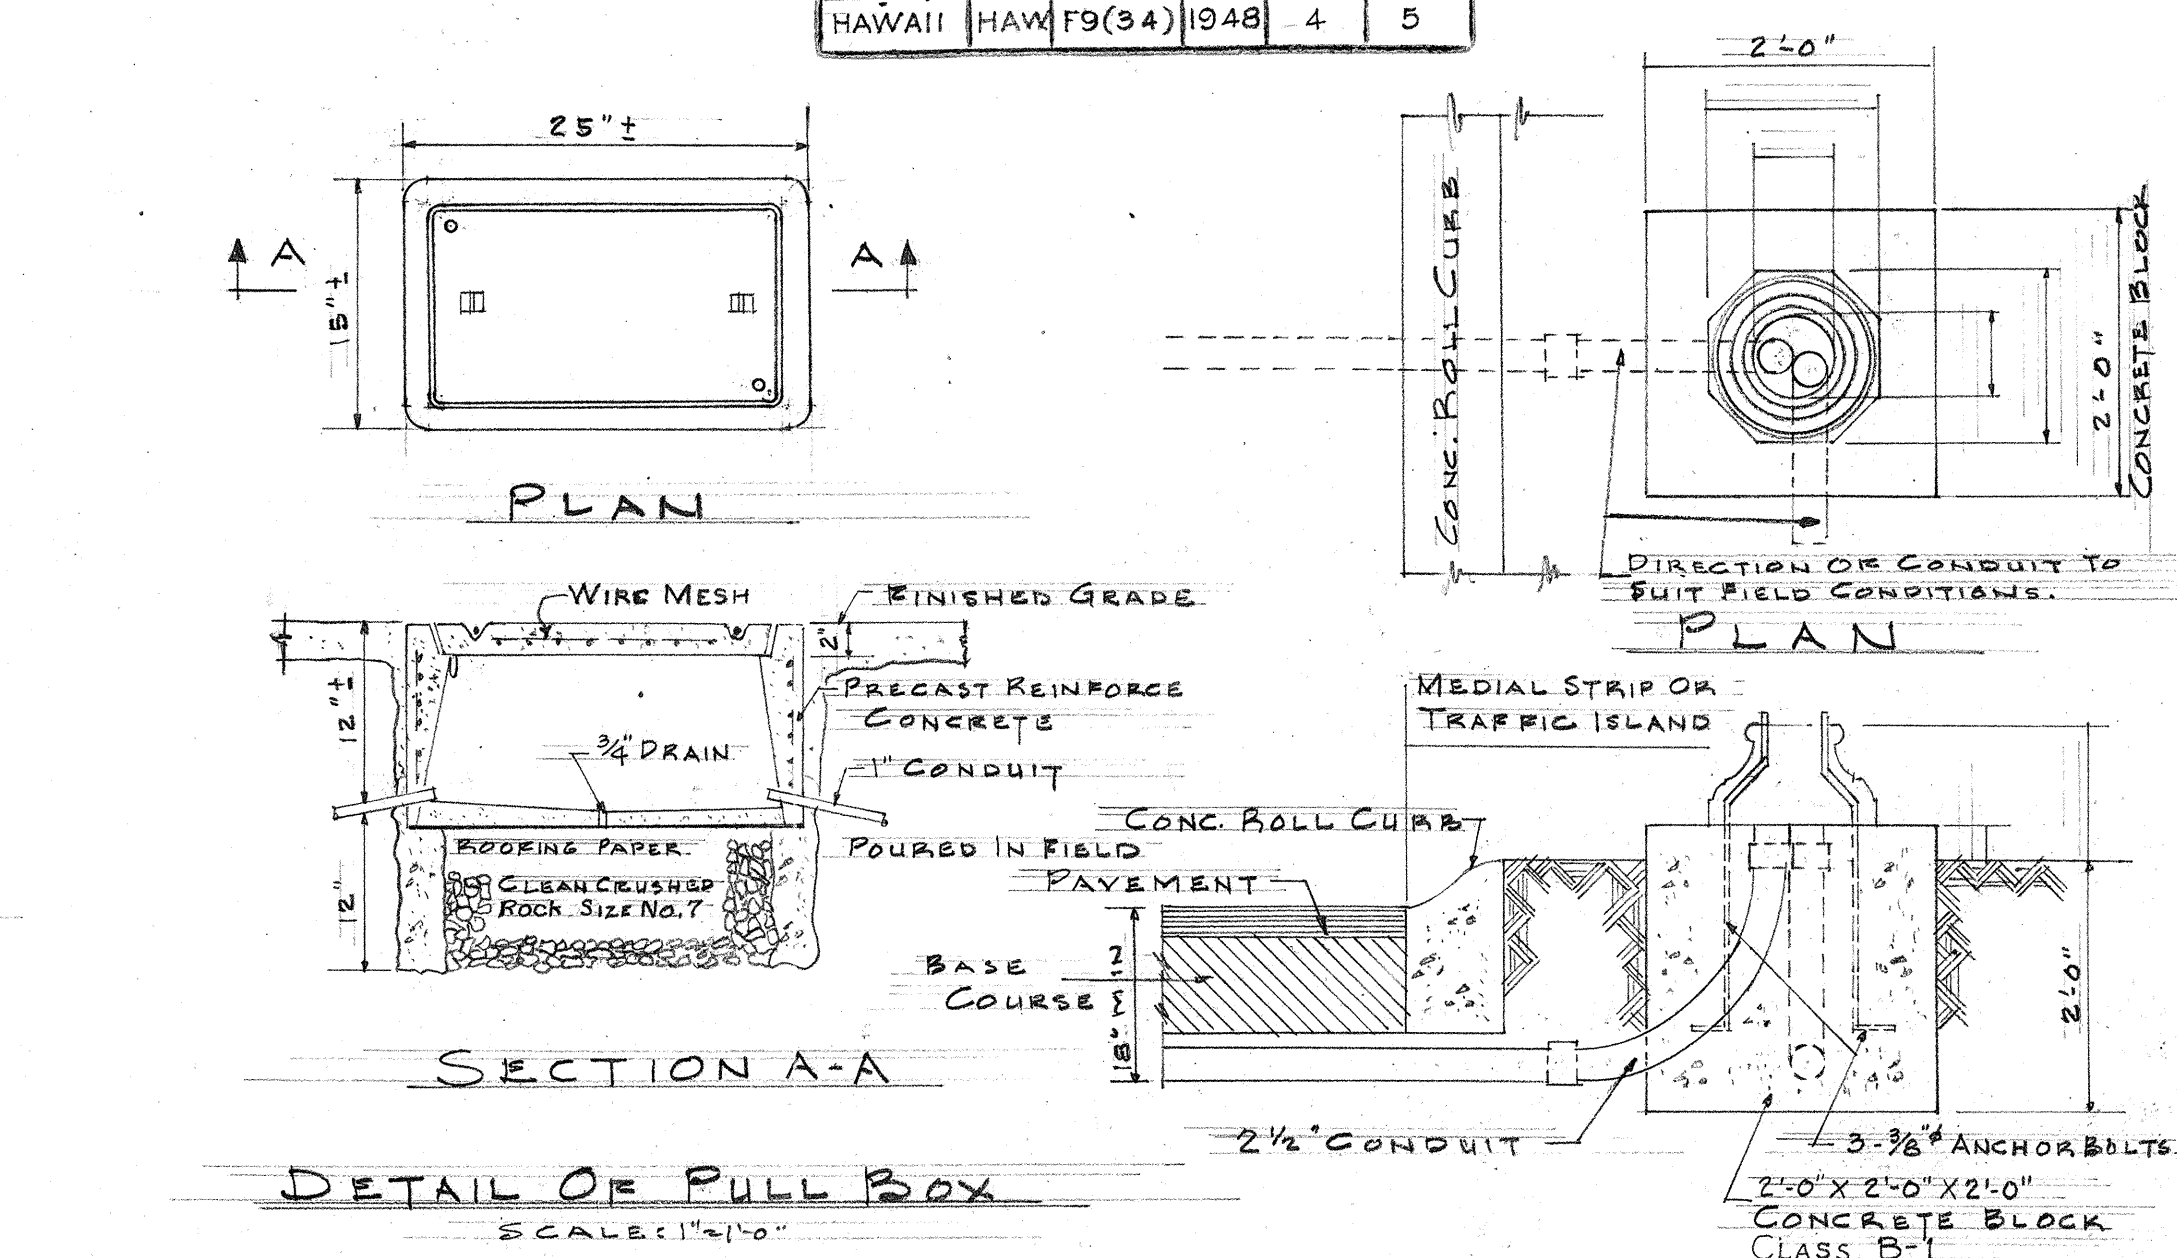
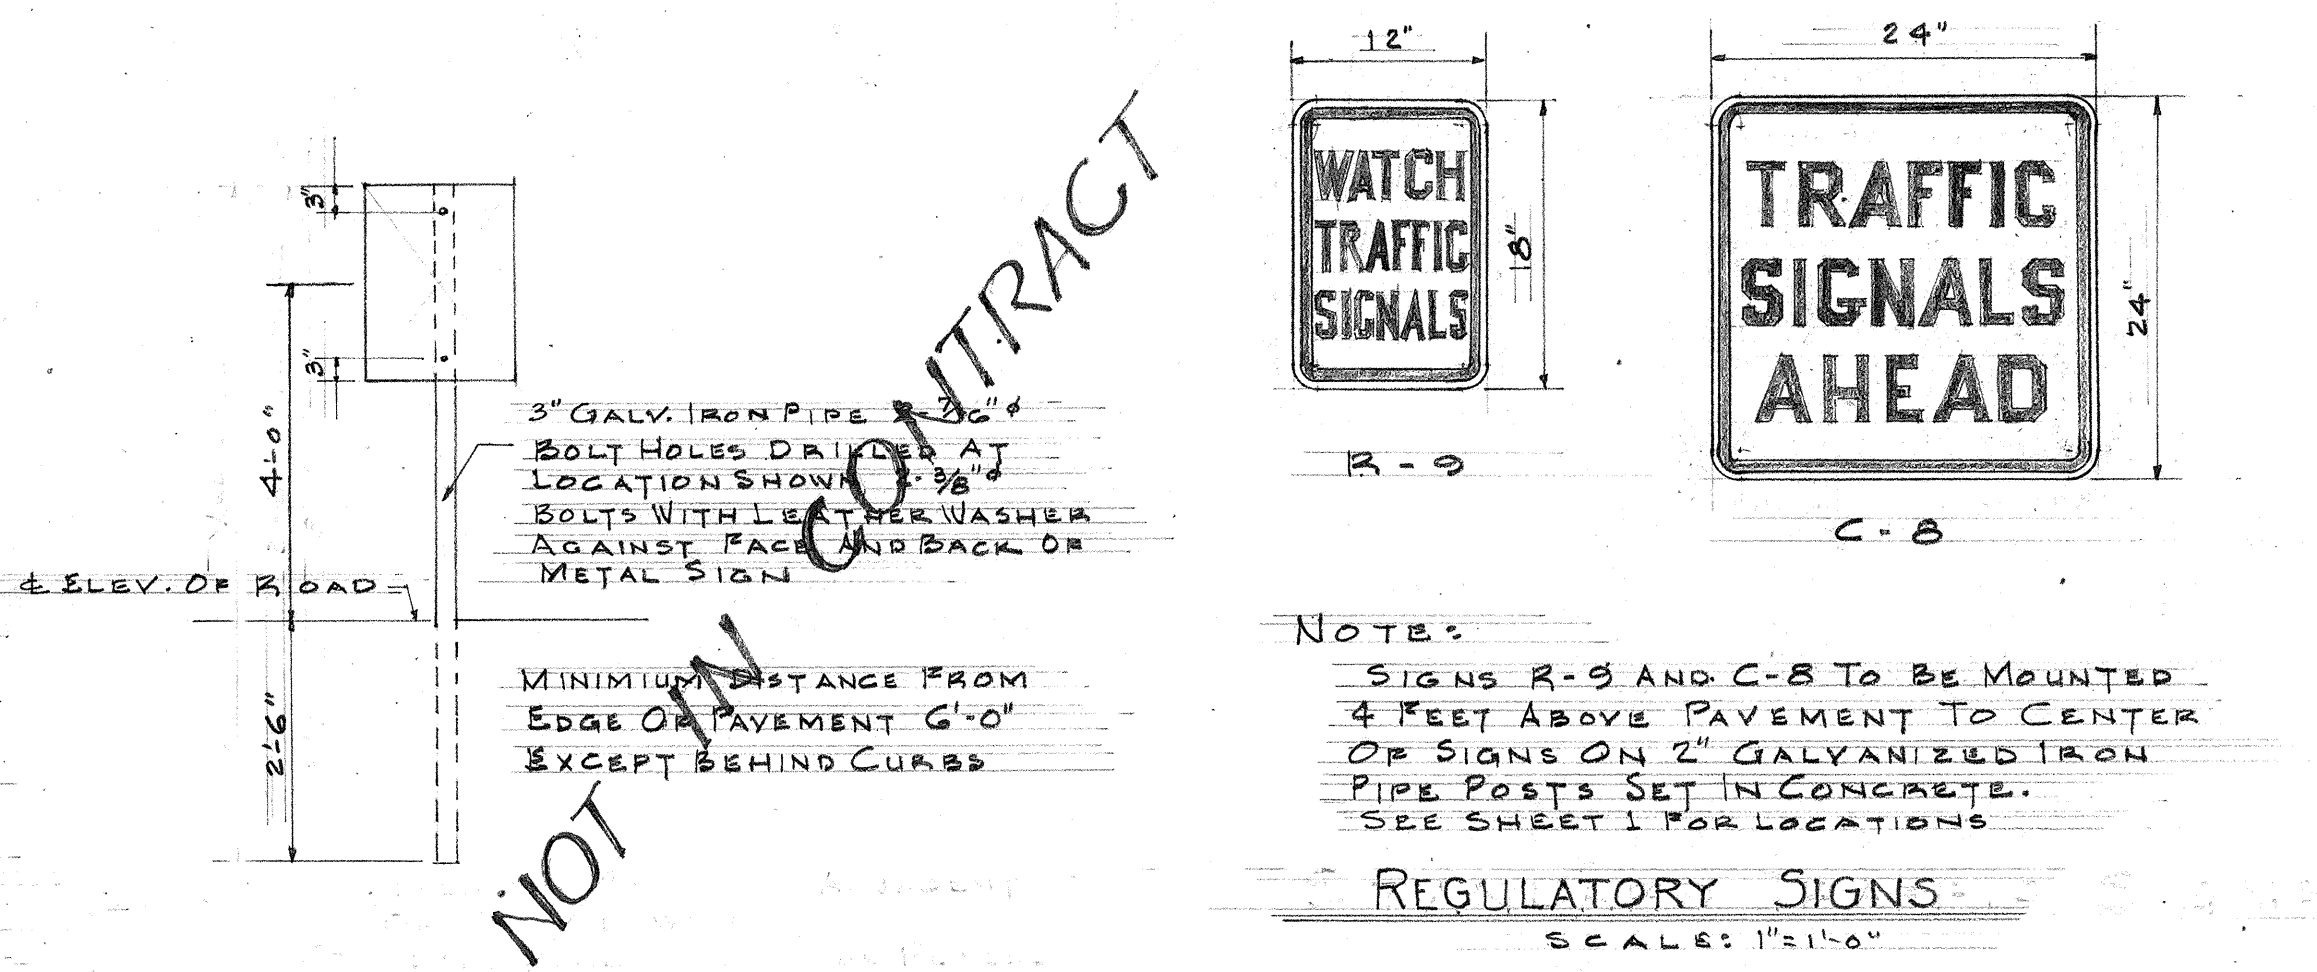


FED. ROAD DIST. NO.	STATE	FED. AID PROJ. NO.	FISCAL YEAR	DIST. NO.	TOTAL SHEETS
HAWAII	HAW	F9(34)	1948	4	5

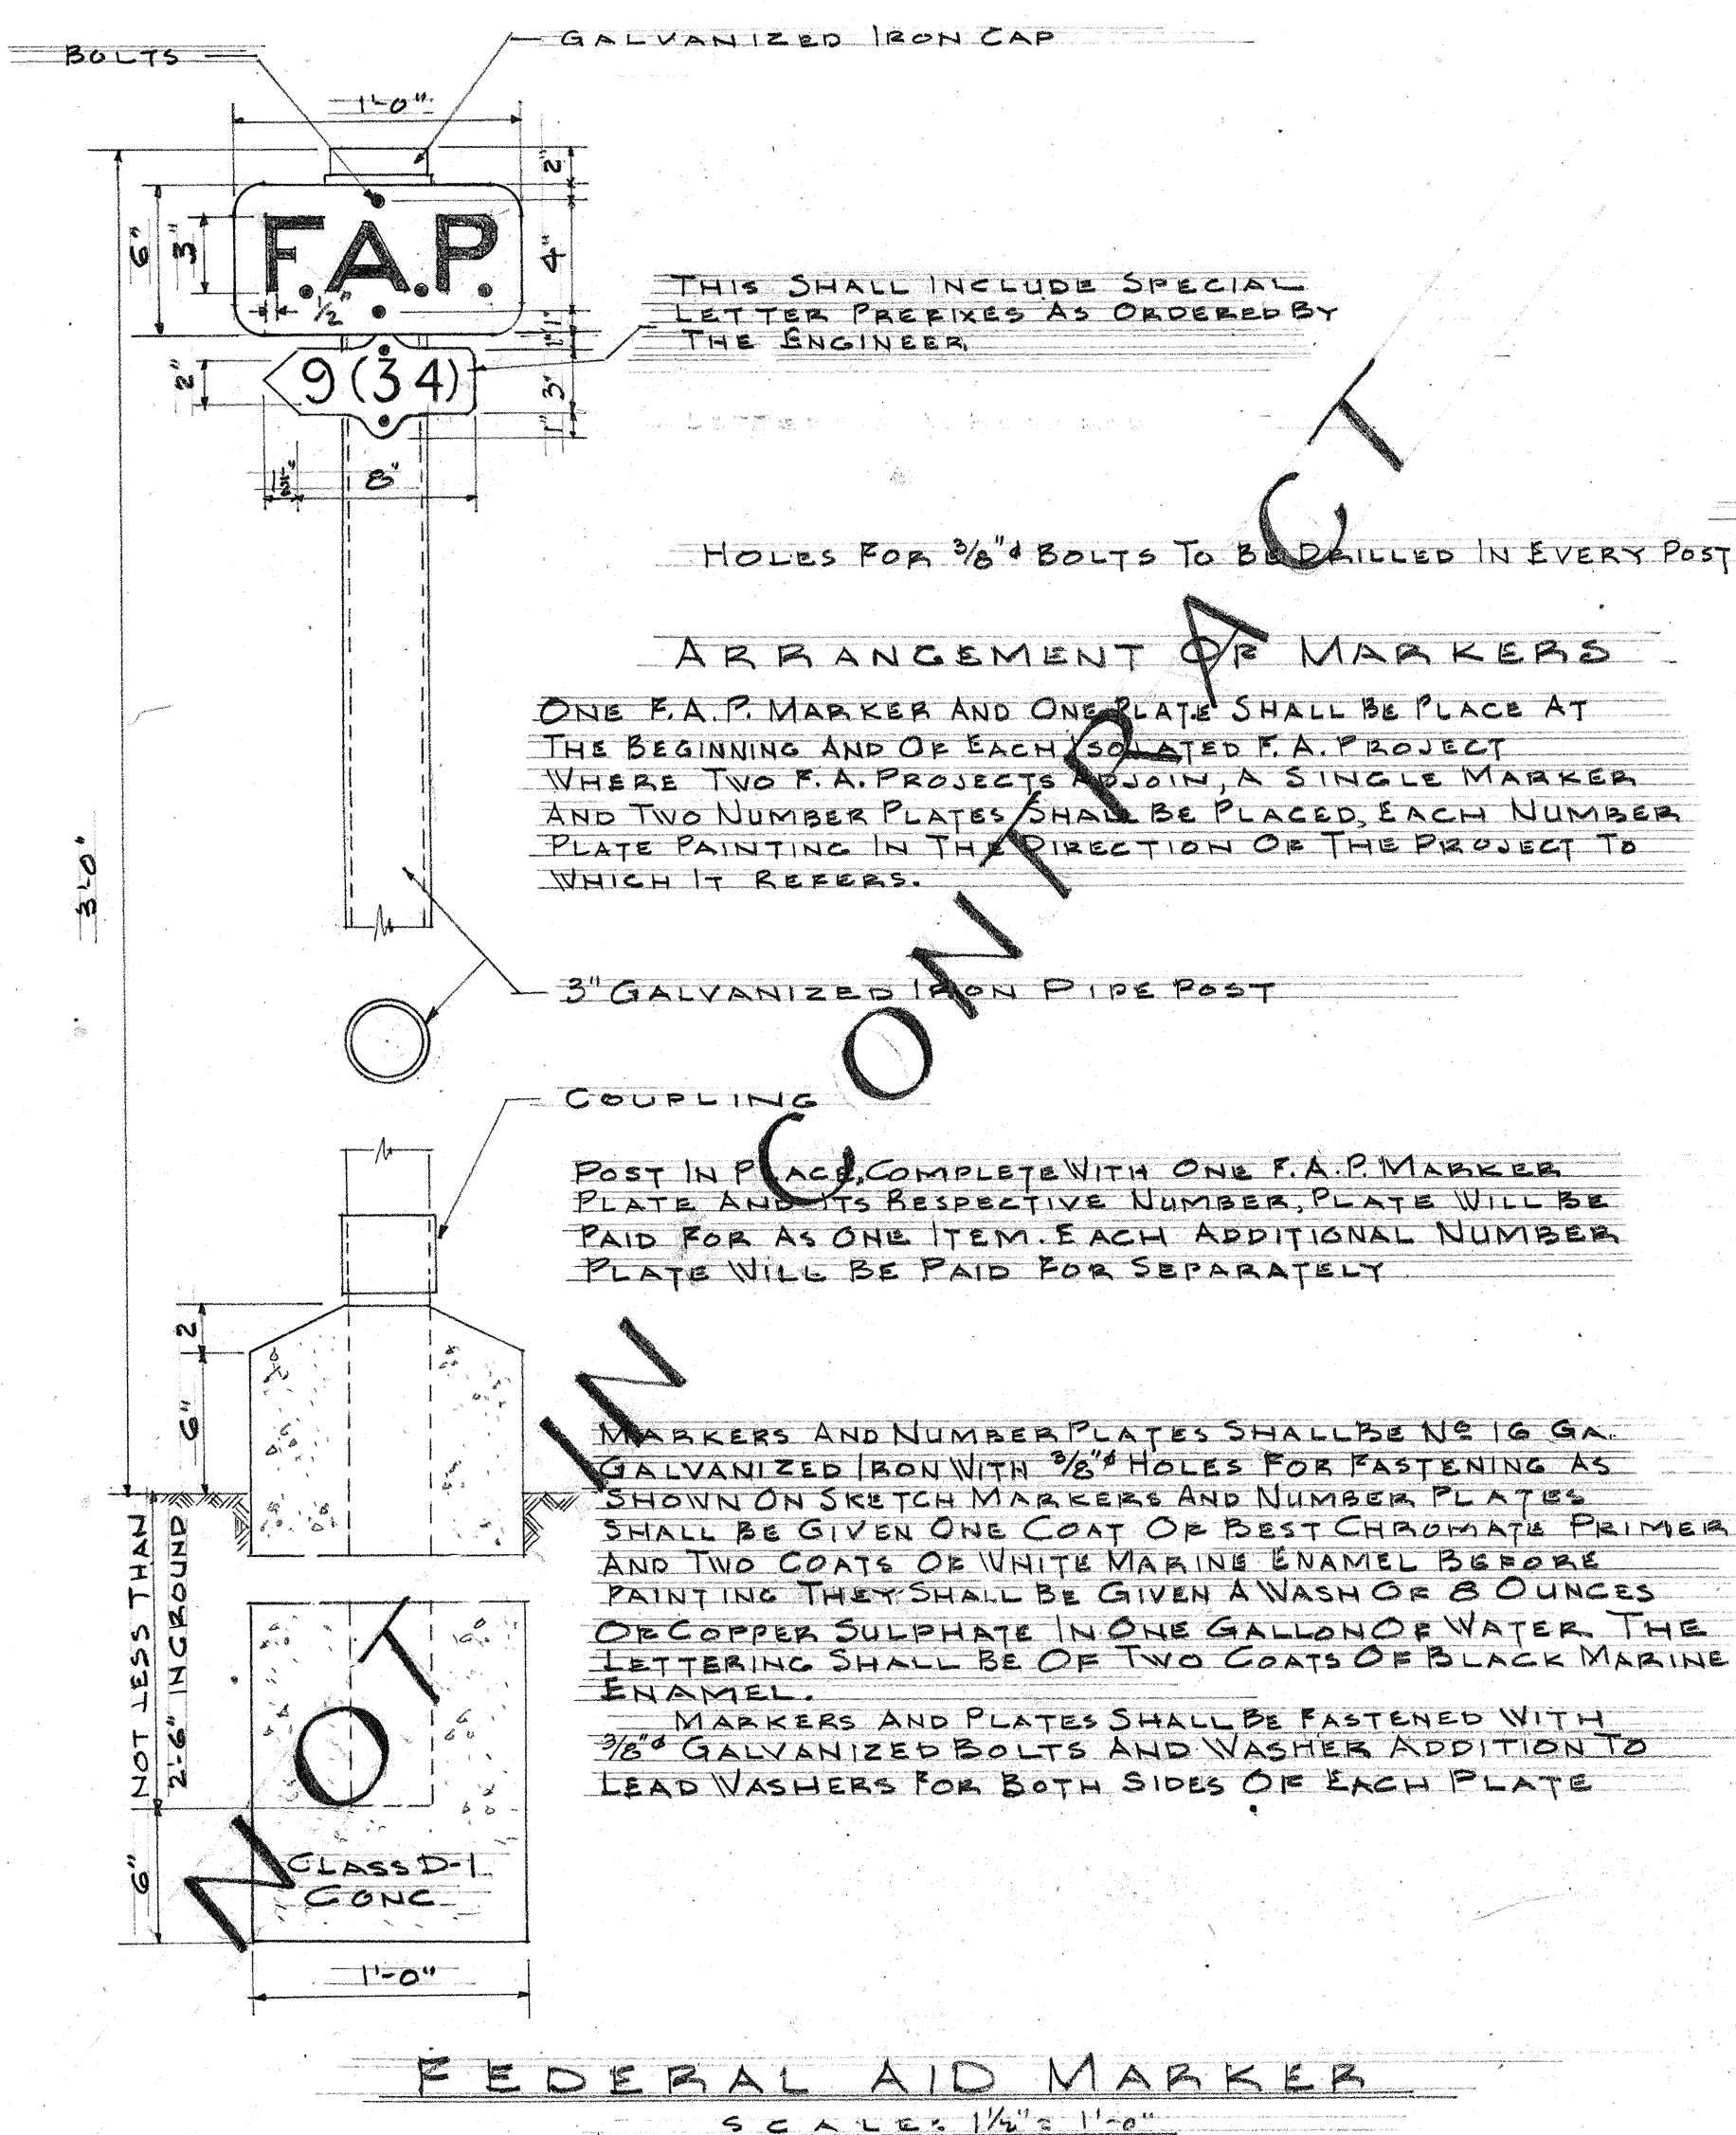

TRAFFIC SIGNAL DETAILS

TERRITORIAL HIGHWAY DEPARTMENT
TERRITORY OF HAWAII

INTERSECTION LIGHTING AND TRAFFIC SIGNAL SYSTEM
MIDDLE ST. AND KAMEHAMEHA HWY
MIDDLE ST. AND NIMITZ HWY

SCALE: AS NOTED
DATE: JUNE 2, 1948 FED. AID PROJ. NO. F9(34)
(1ST UNIT)

SHEET NO. 3 OF 4 SHEETS

5304.4