


FED. ROAD DIST. NO.	STATE	FED. AID PROJ. NO.	FISCAL YEAR	SHEET NO.	TOTAL SHEETS
HAWAII	HAWAII	FD-34	1950	3	4


2nd Unit

MODEL 82GD DISPATCHER CONNECTOR PLUGS CABLE A-12629

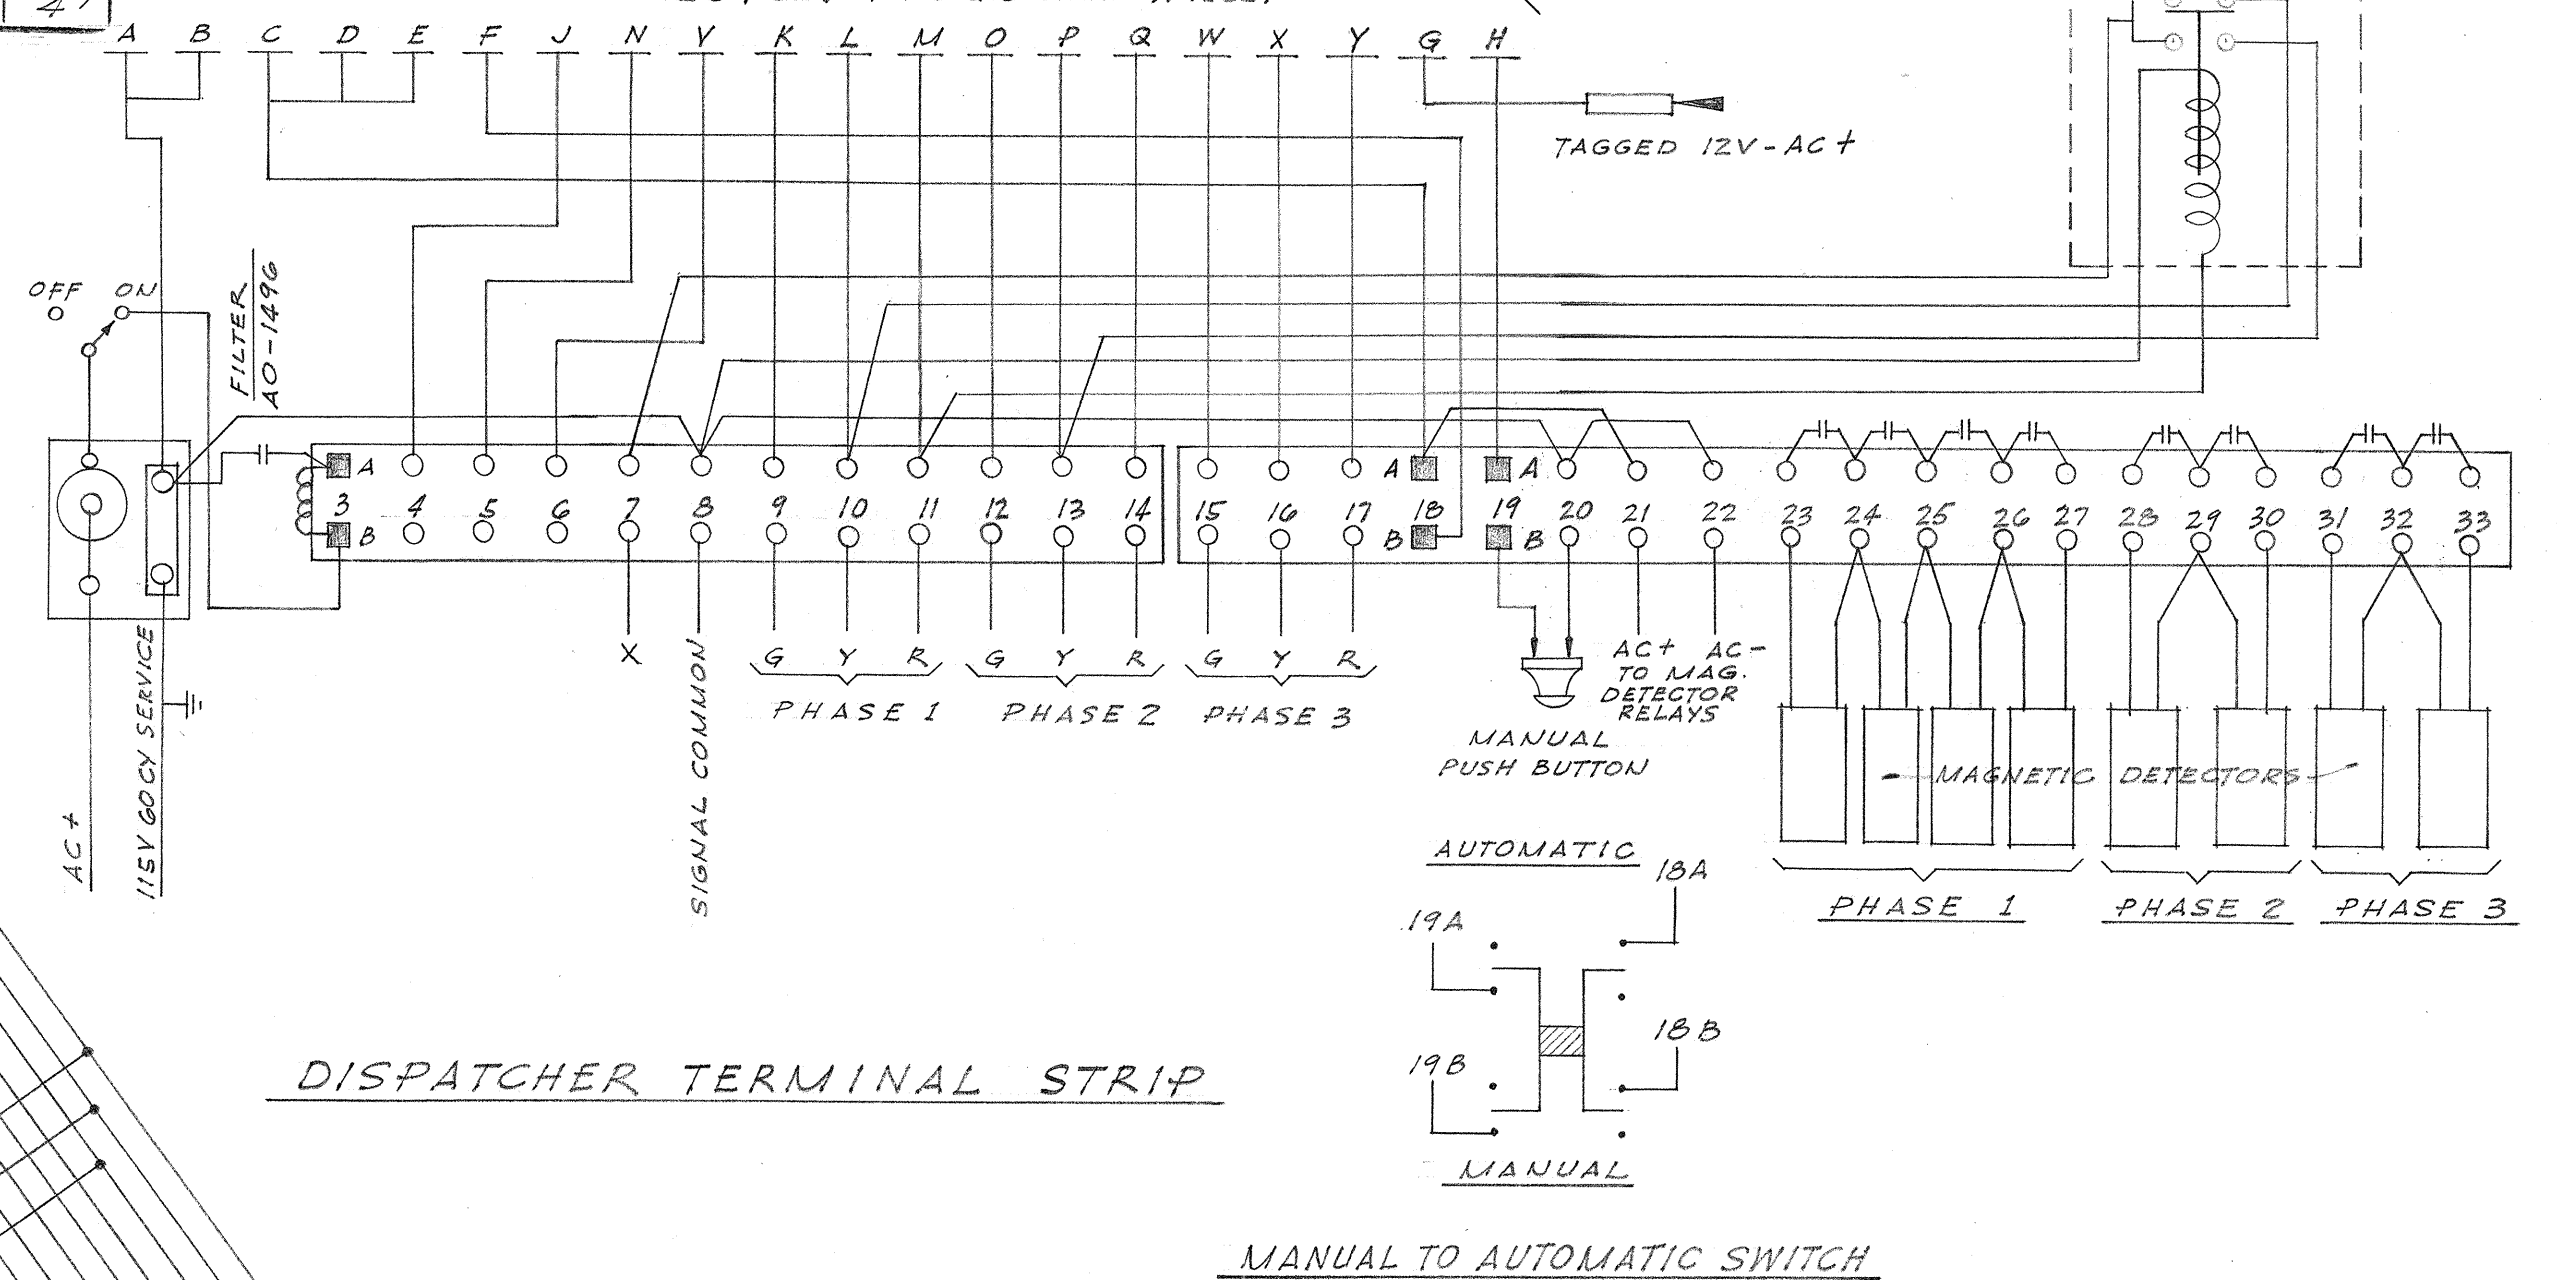


DISPATCHER TERMINAL STRIP

MANUAL TO AUTOMATIC SWITCH

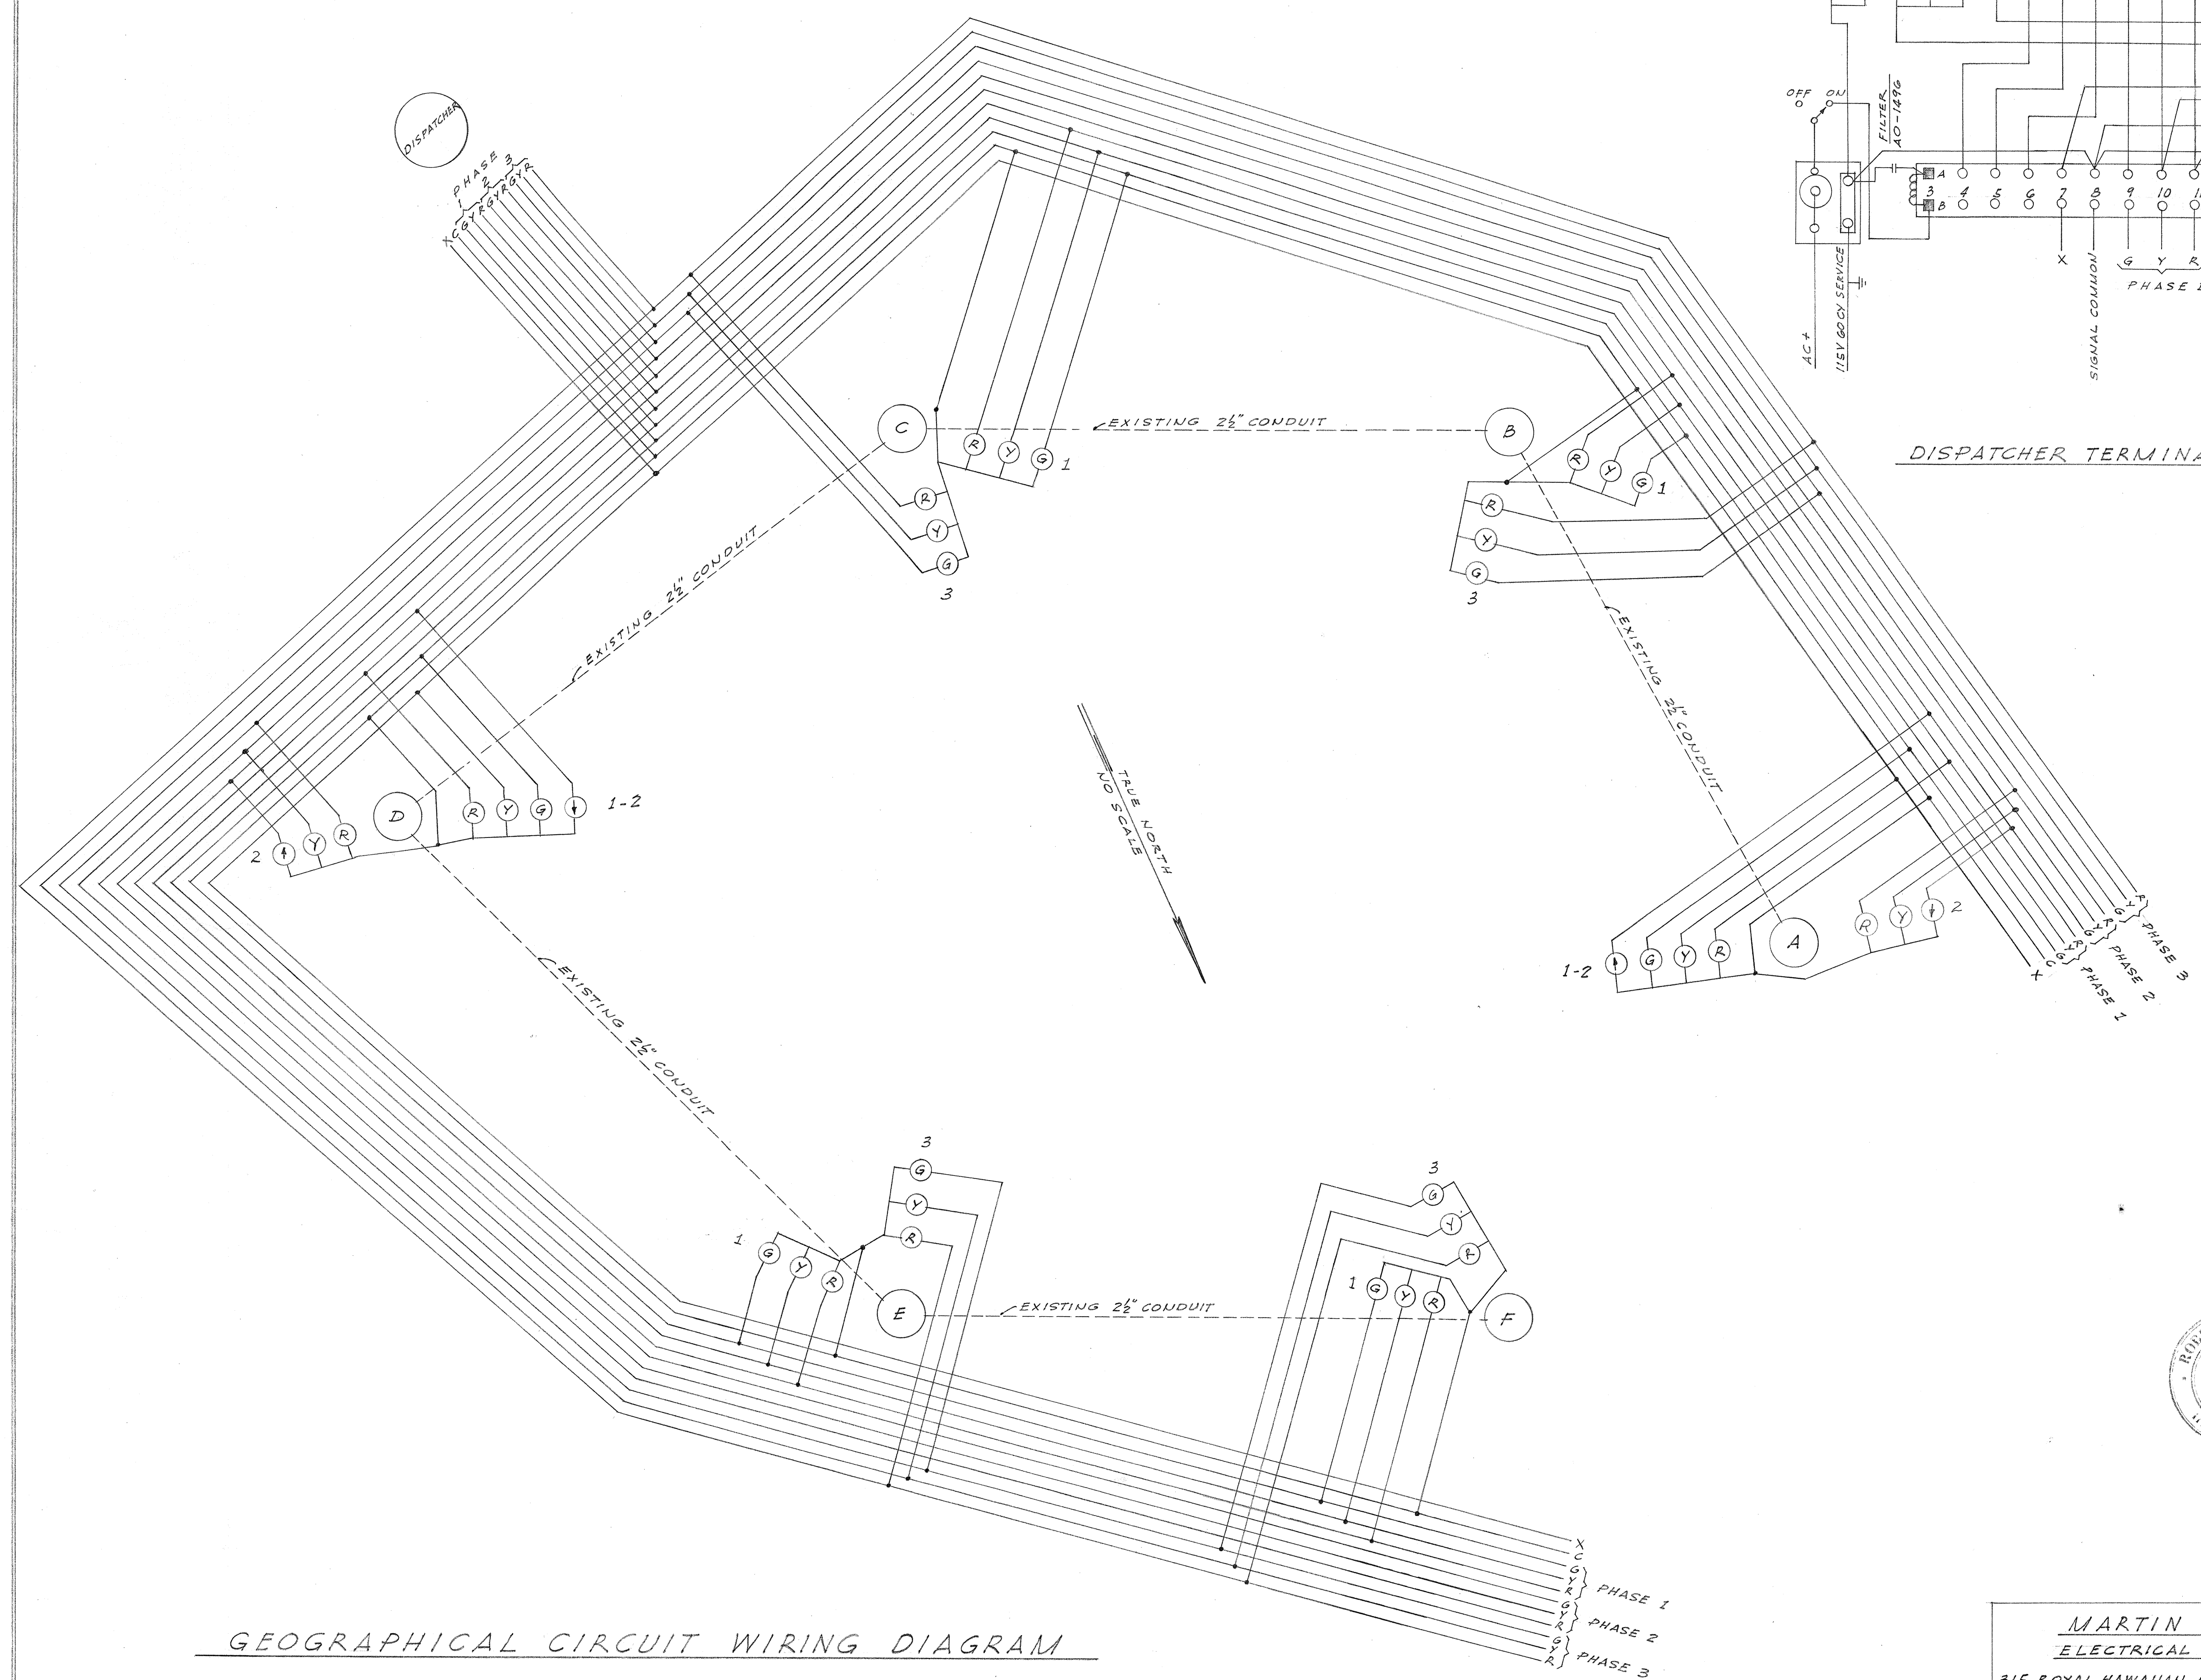

GEOGRAPHICAL CIRCUIT WIRING DIAGRAM

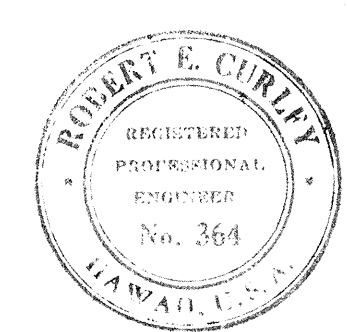

APPROVED: _____ DATE: _____
TERRITORIAL HIGHWAY ENGINEER

MARTIN & CURLEY
ELECTRICAL ENGINEERS
315 ROYAL HAWAIIAN AVE. HONOLULU, T. H.
JAN. 7, 1950

TERRITORIAL HIGHWAY DEPARTMENT
TERRITORY OF HAWAII
TRAFFIC SIGNAL SYSTEM
LEHUA AVE. & KAMEHAMEHA HIGHWAY
SCALE: NONE DATE: JAN. 7, 1950