




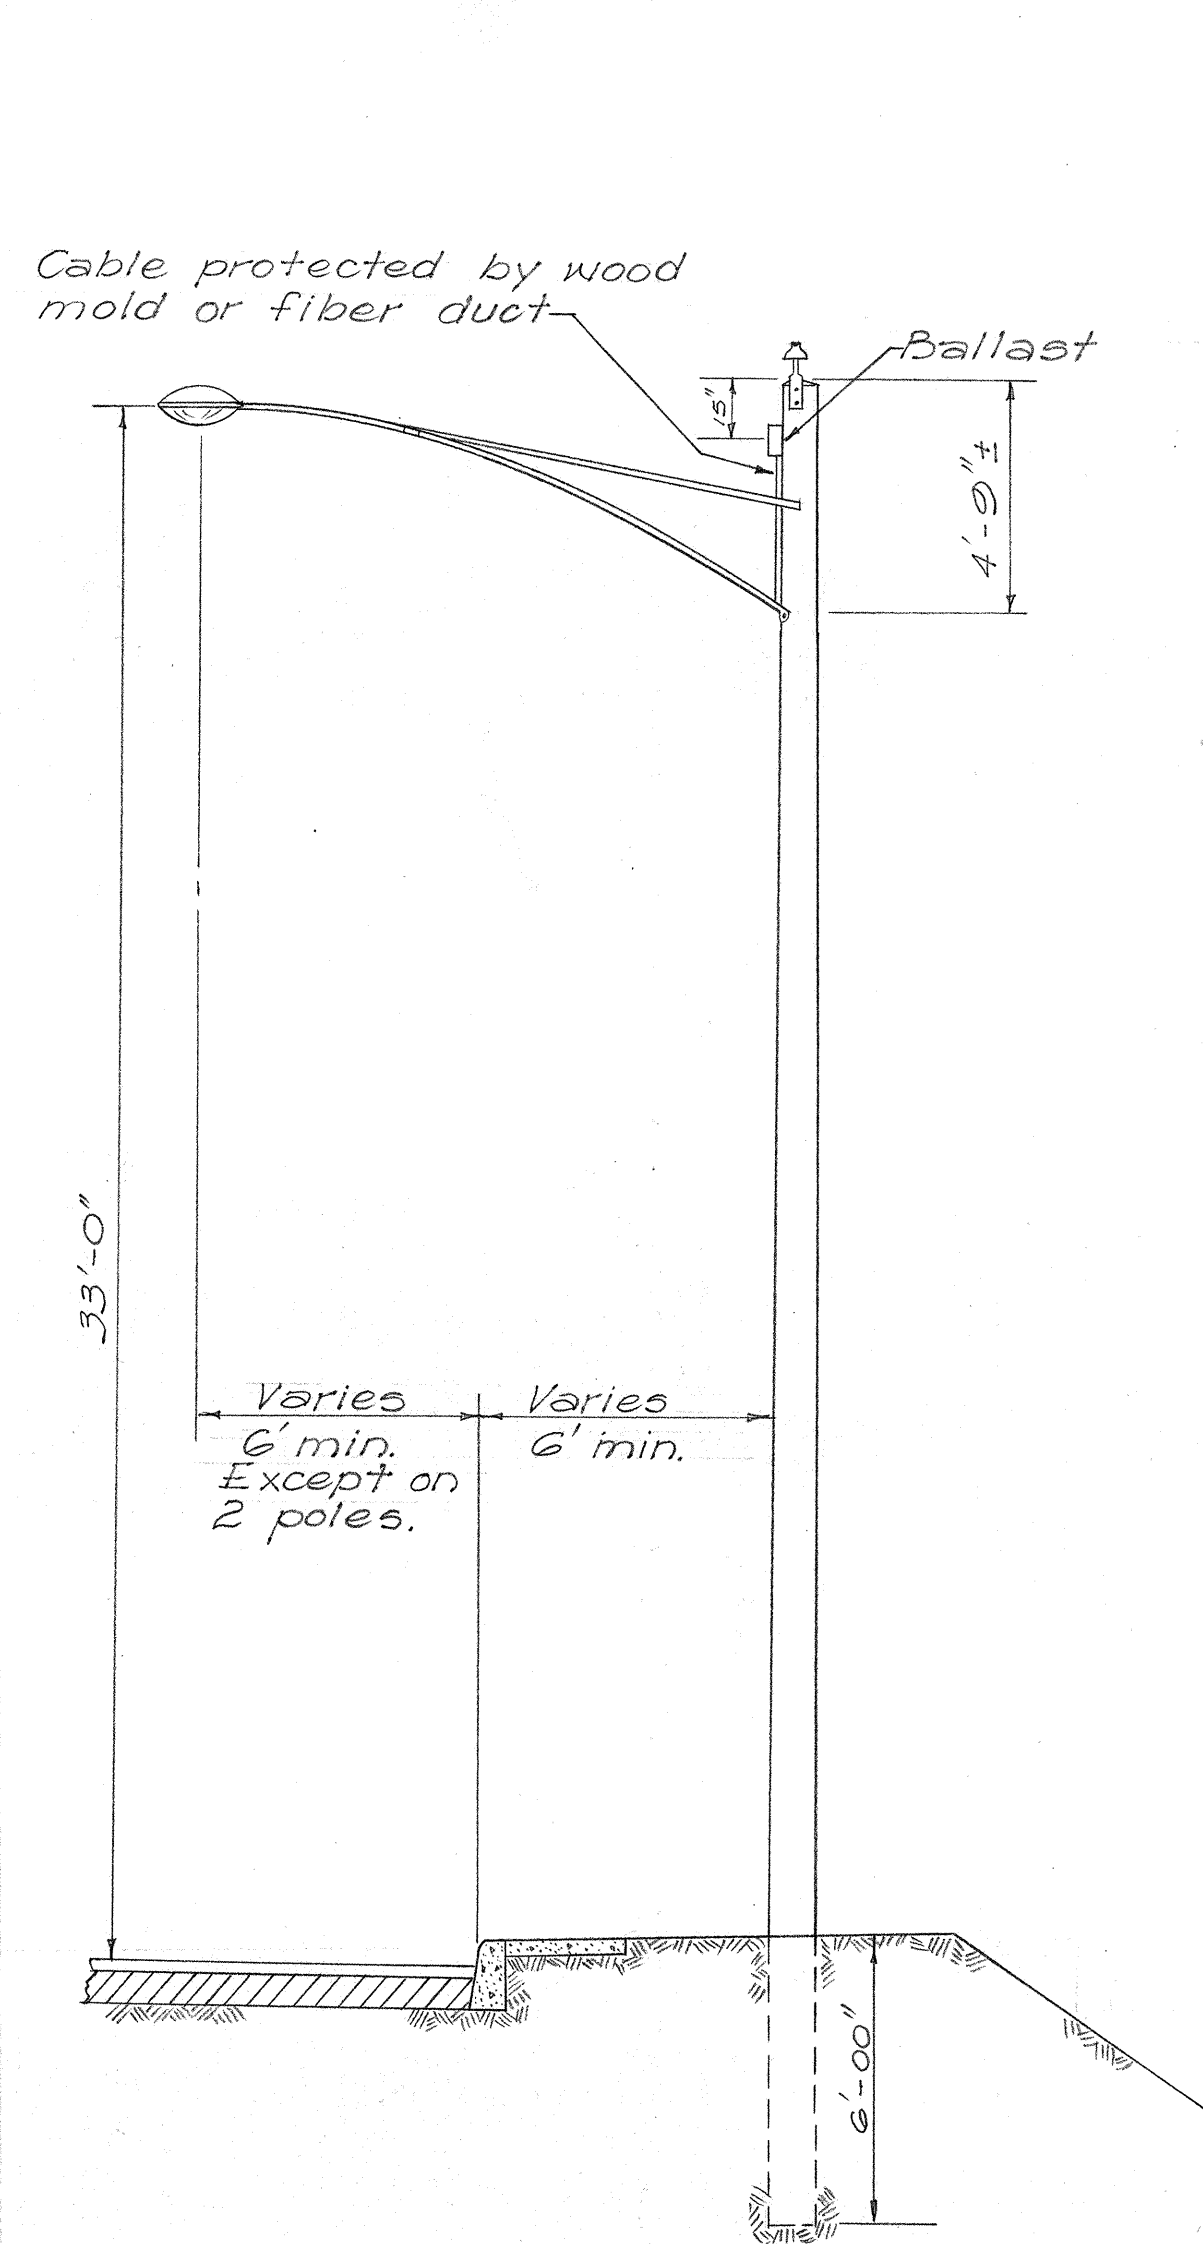


TYPICAL 40' POLE
Scale: 1/4" = 1'-0"

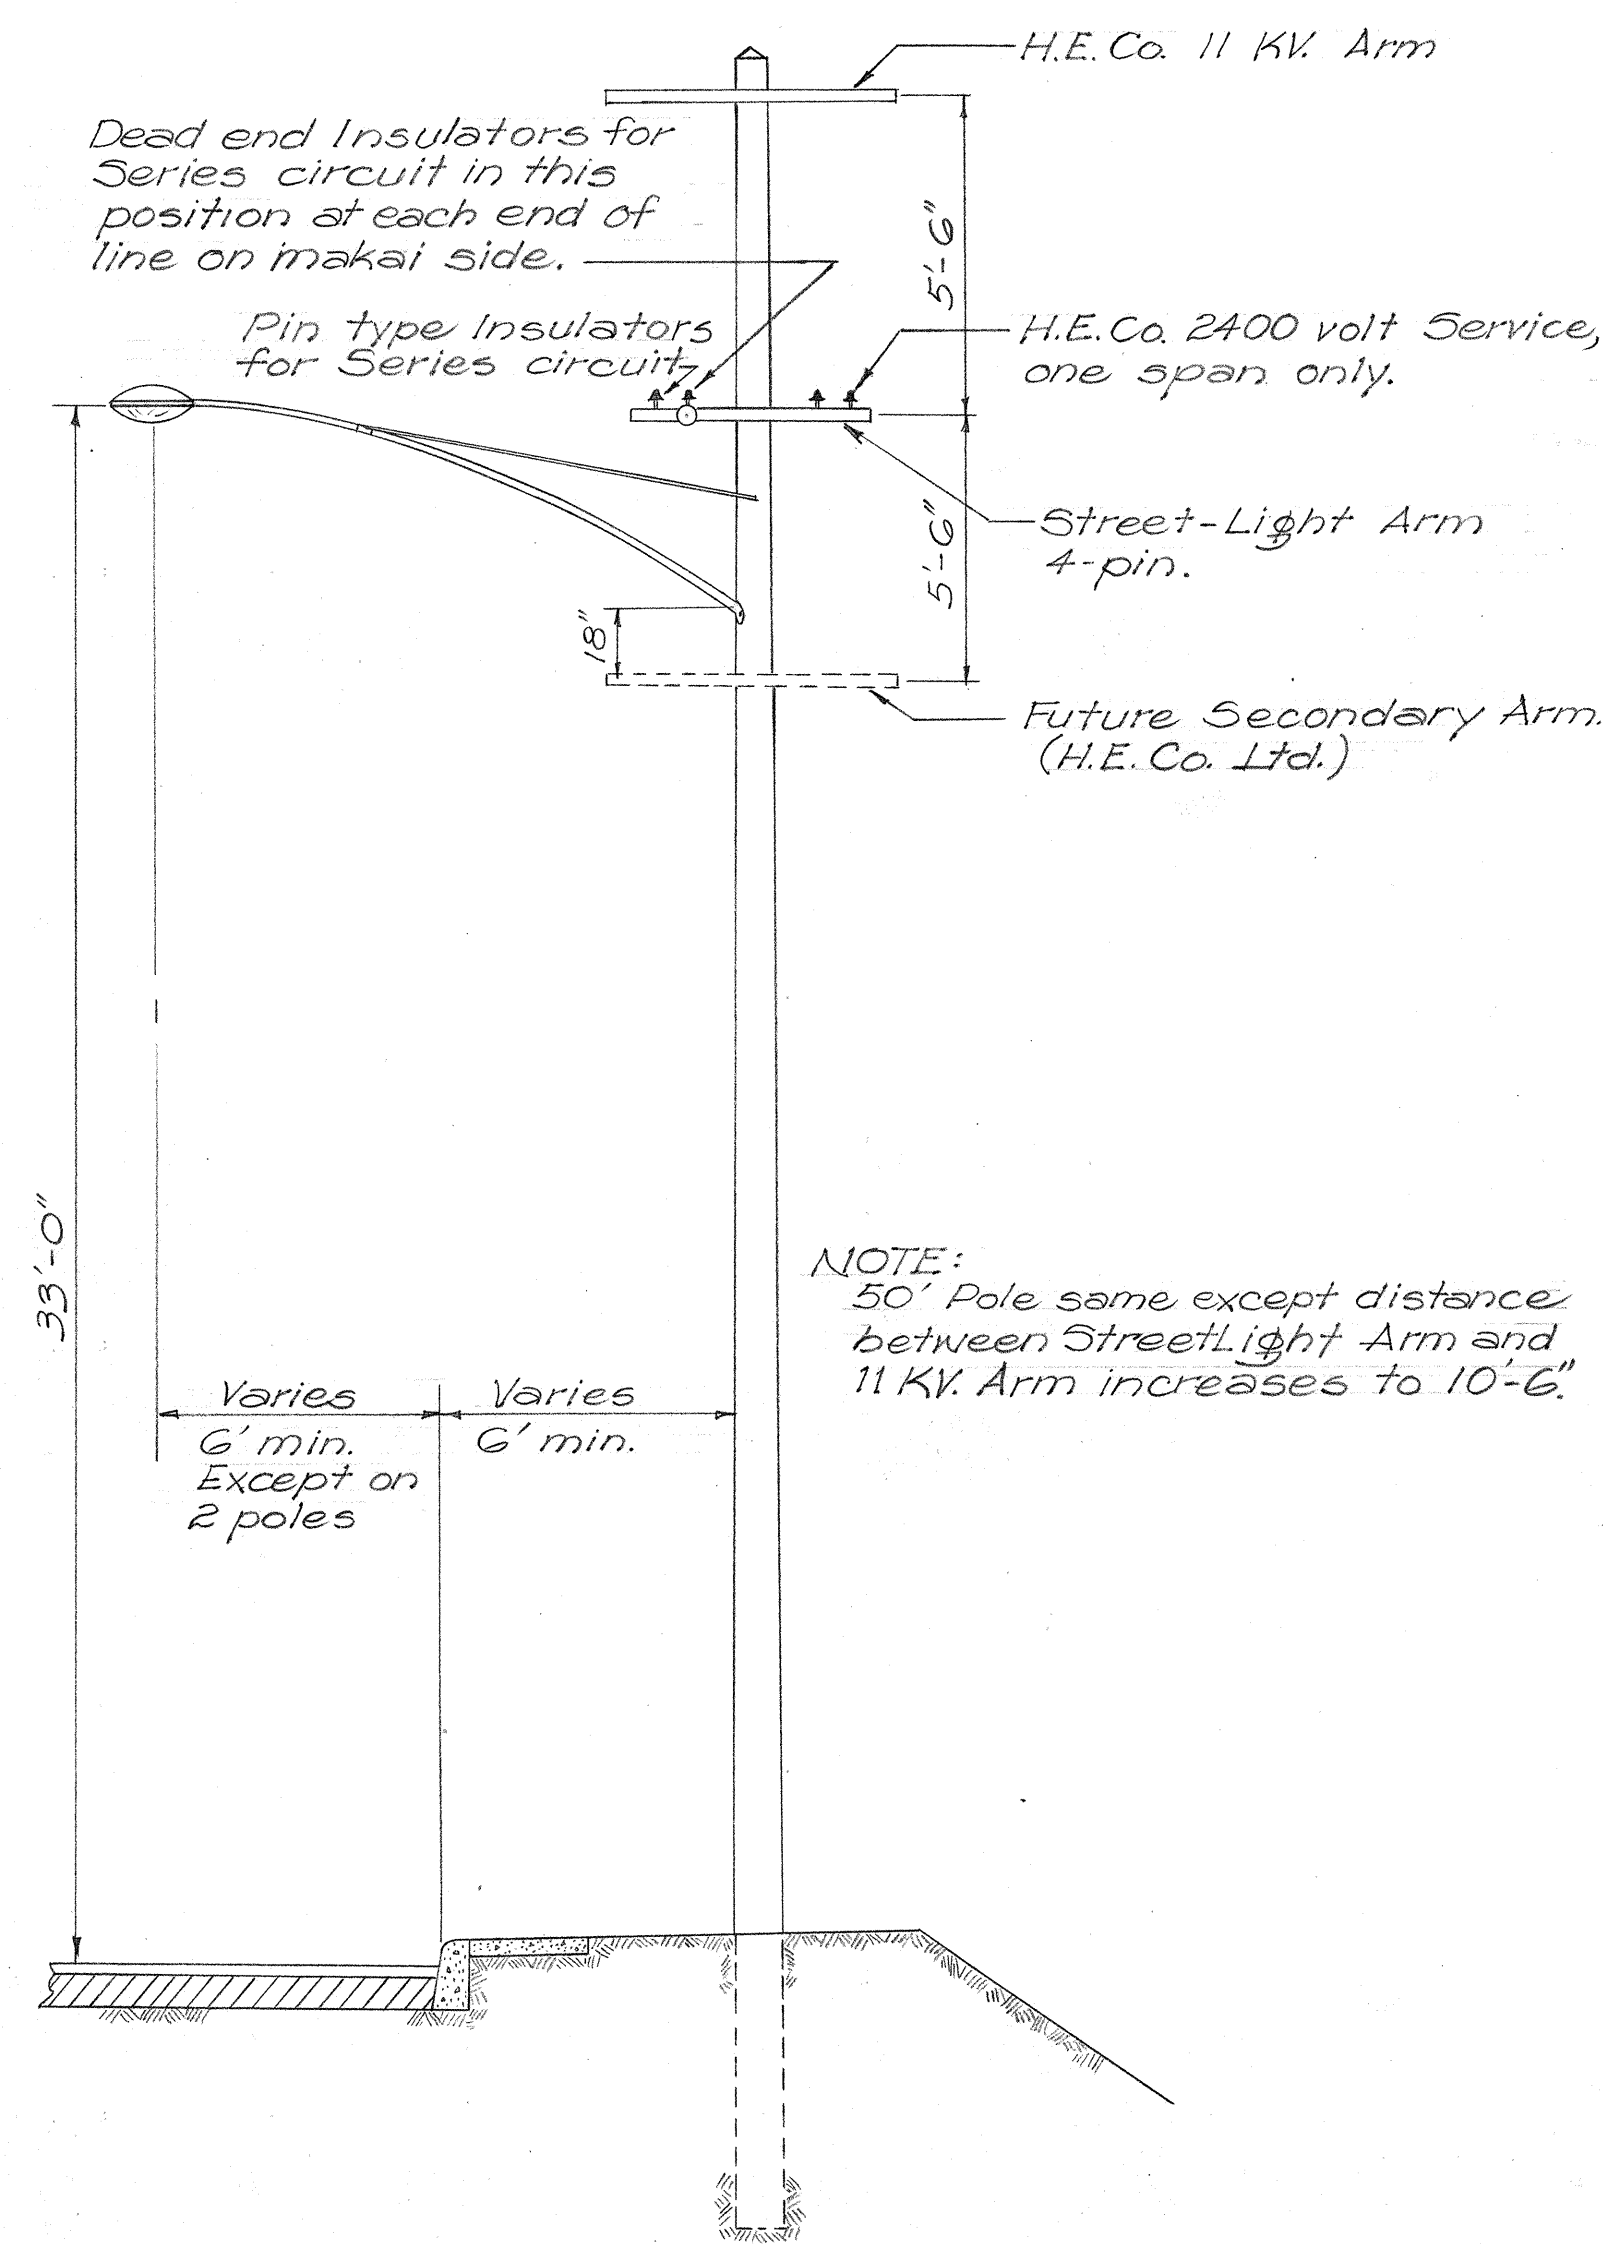

TYPICAL 45' JOINT POLE
Scale: 1/4" = 1'-0"

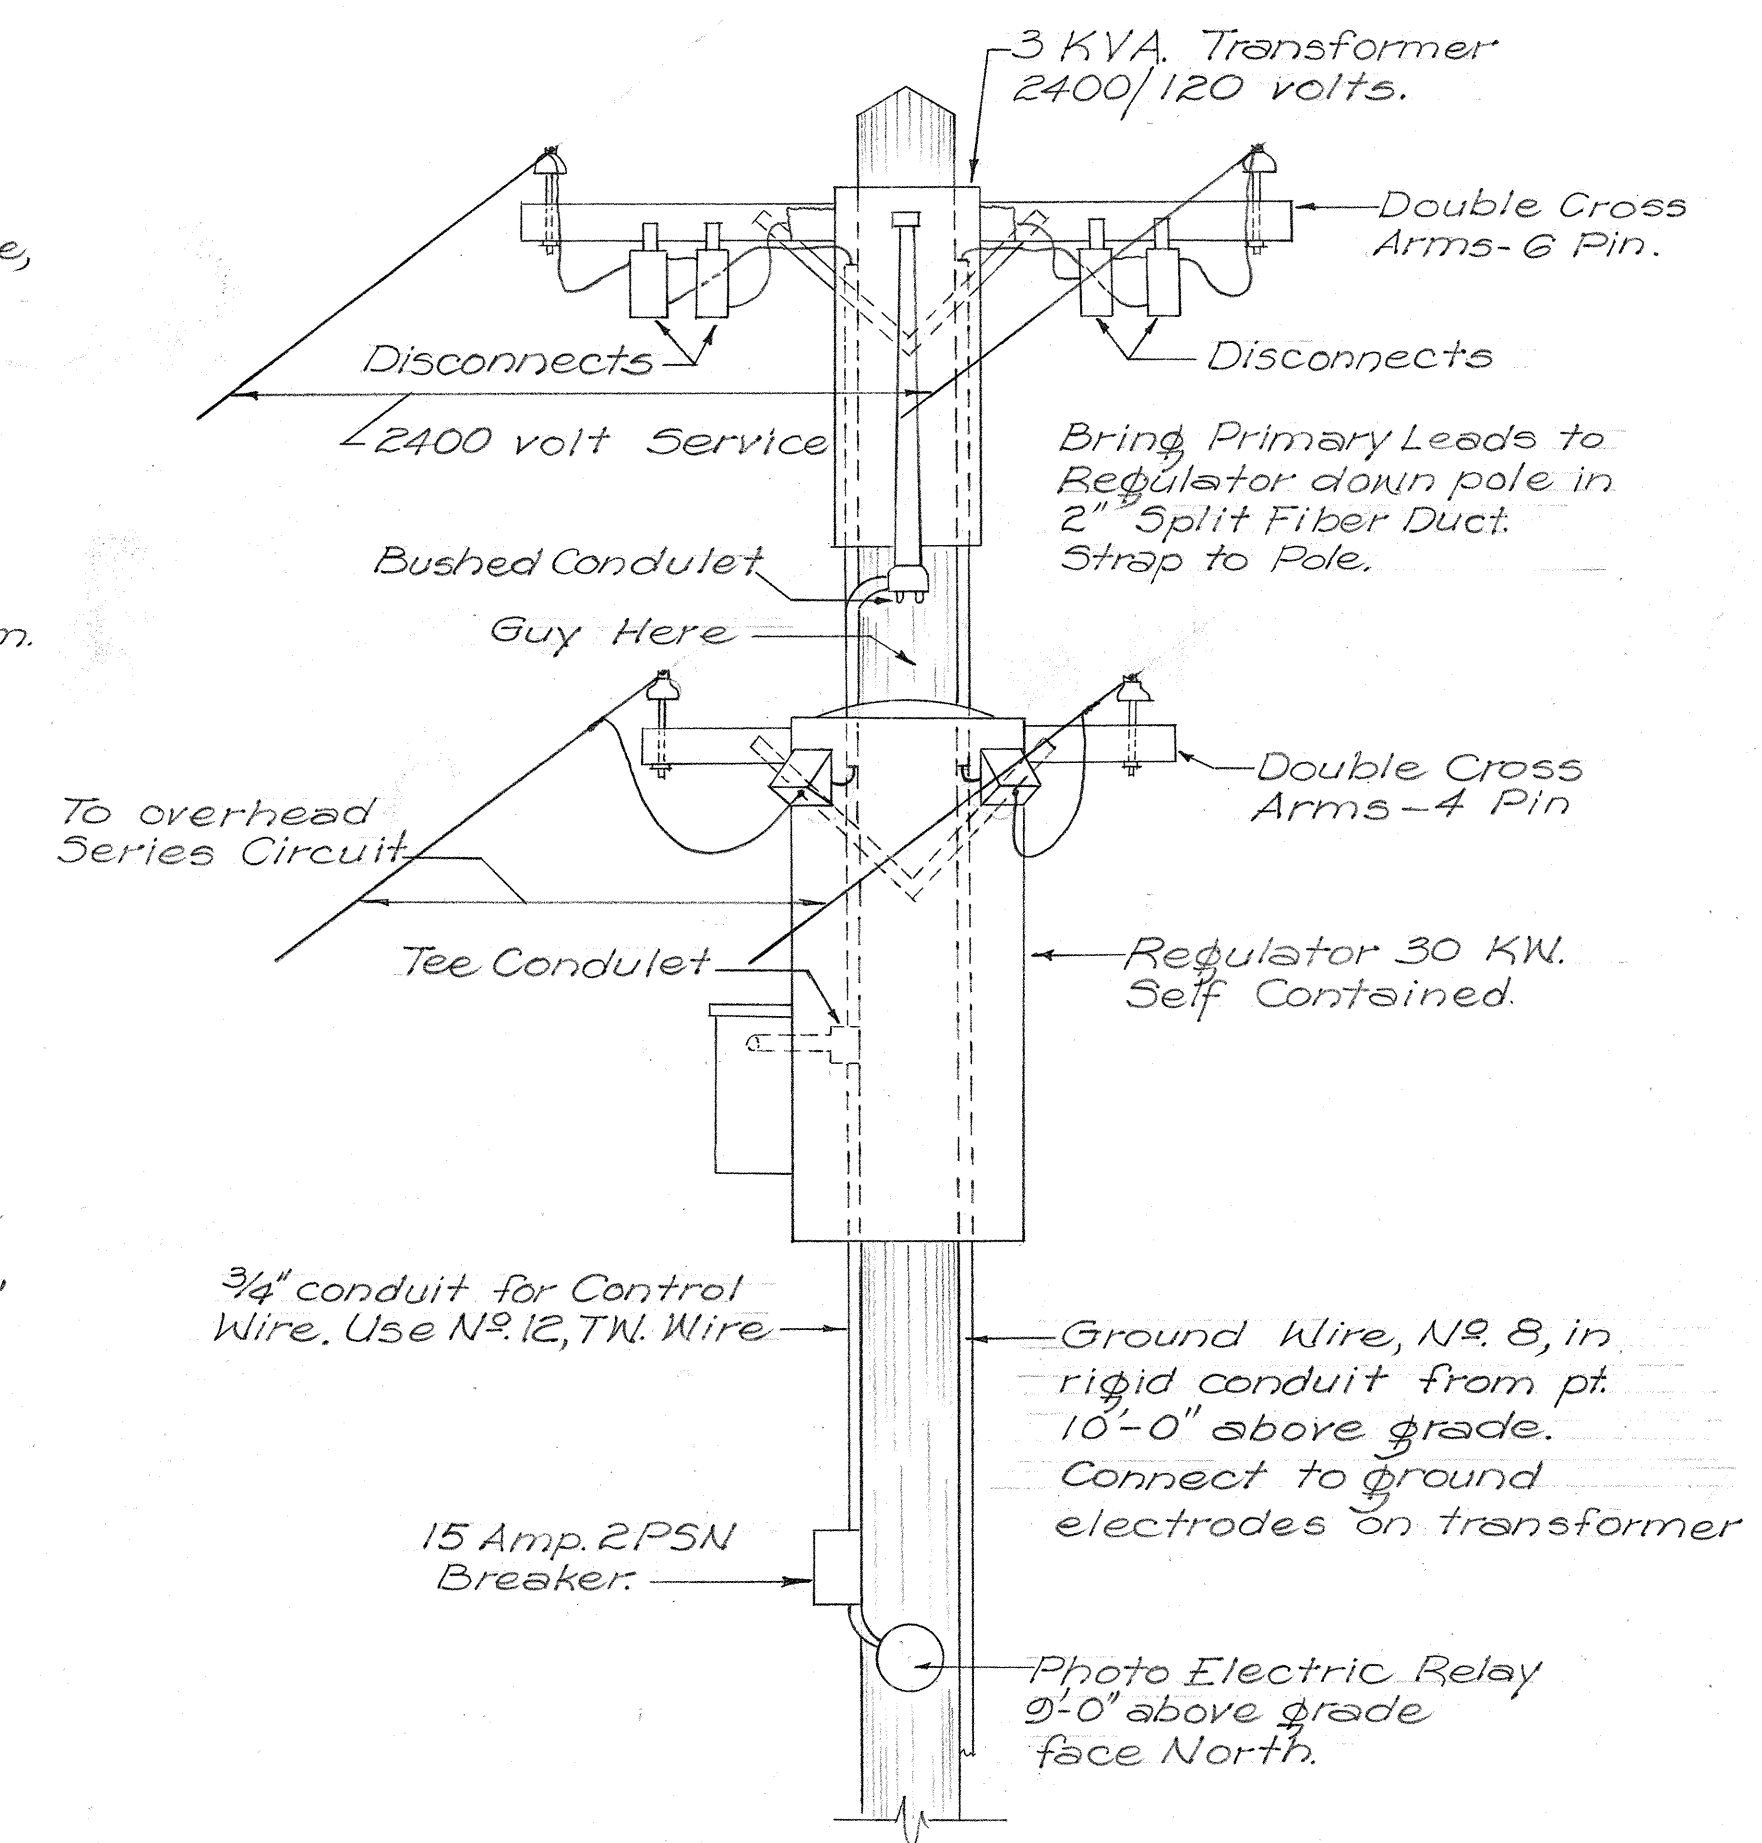

DETAIL CONTROL POLE
Not to Scale

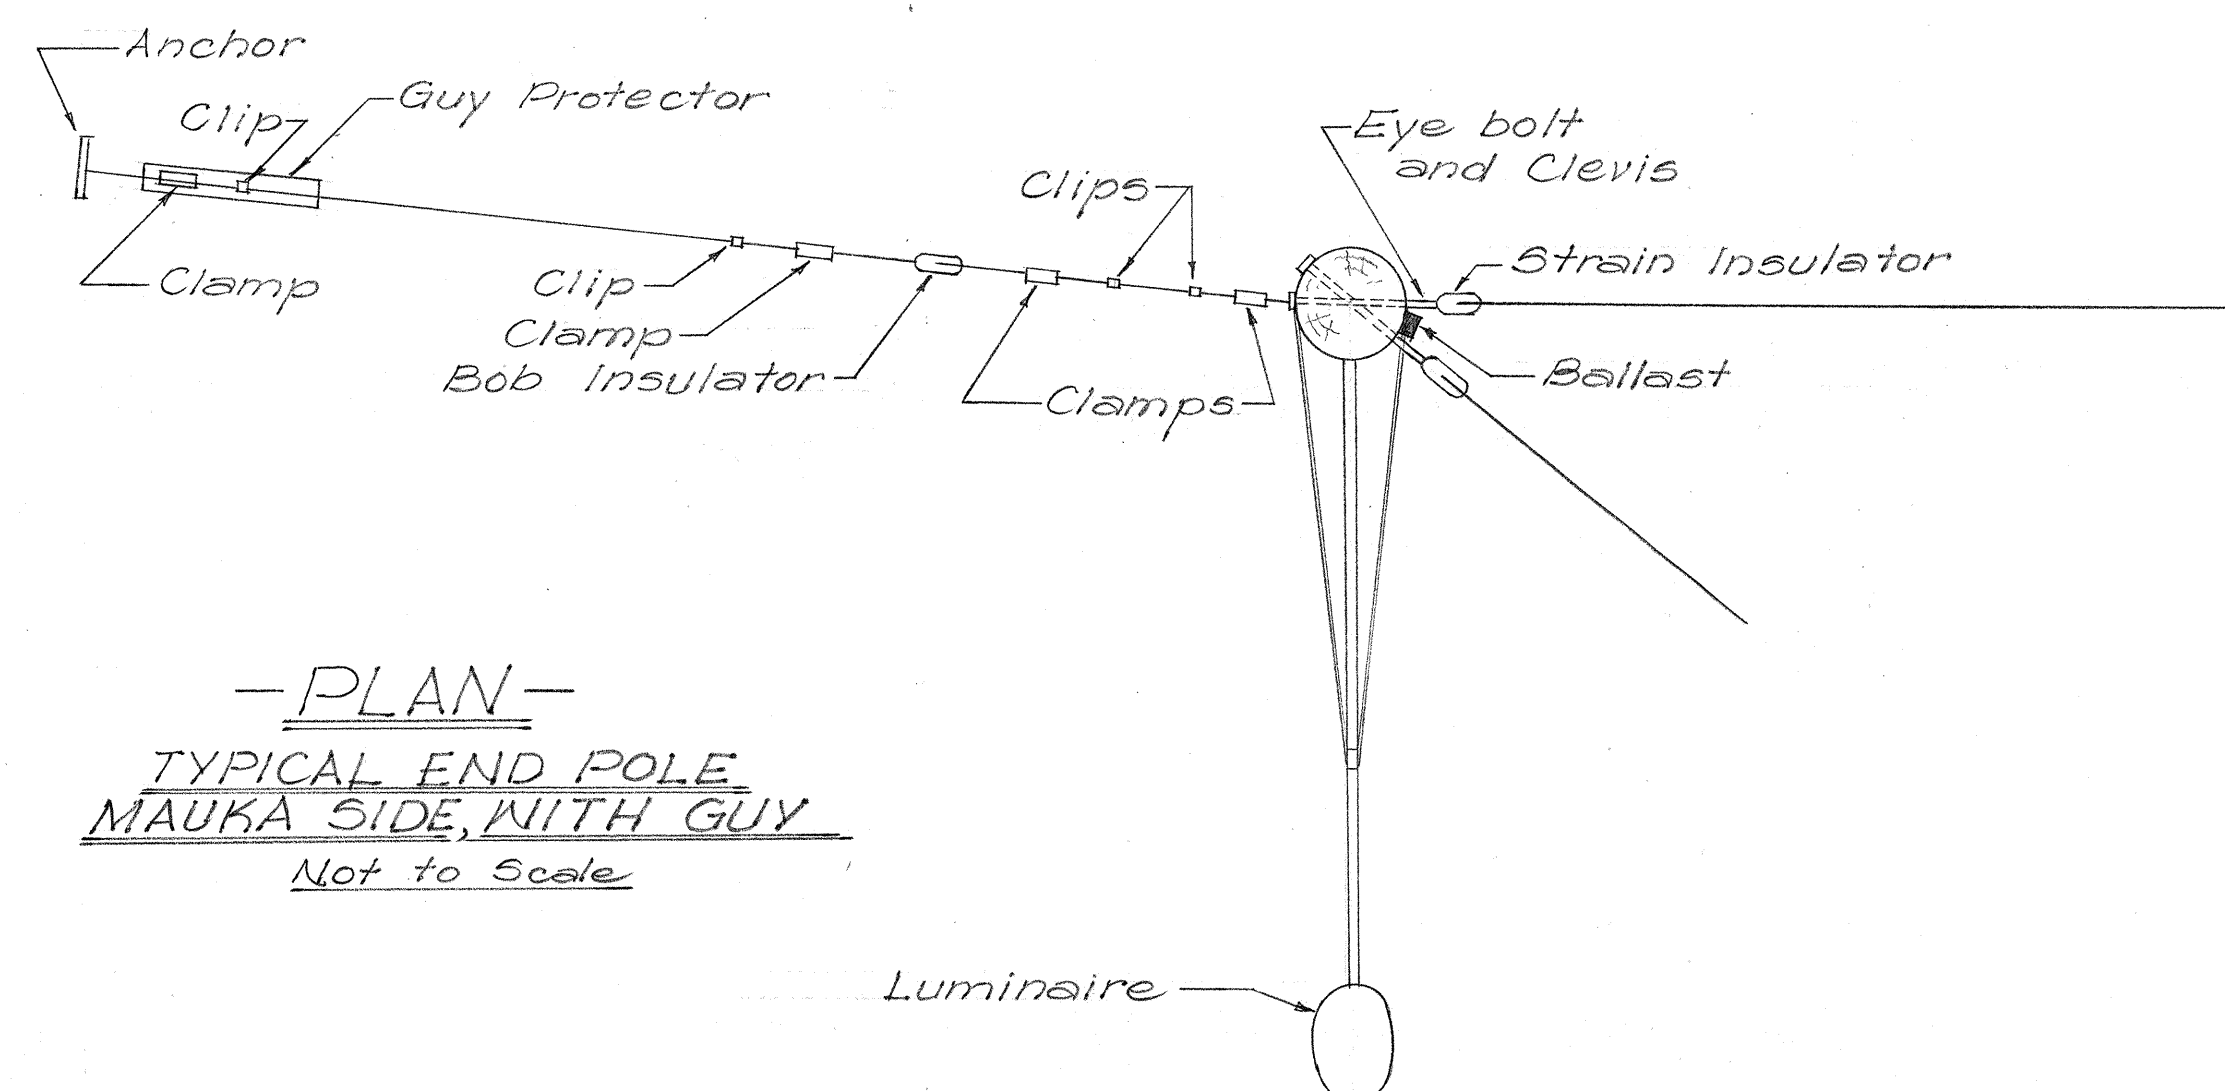

-PLAN-
TYPICAL END POLE
MAUKA SIDE, WITH GUY
Not to Scale