
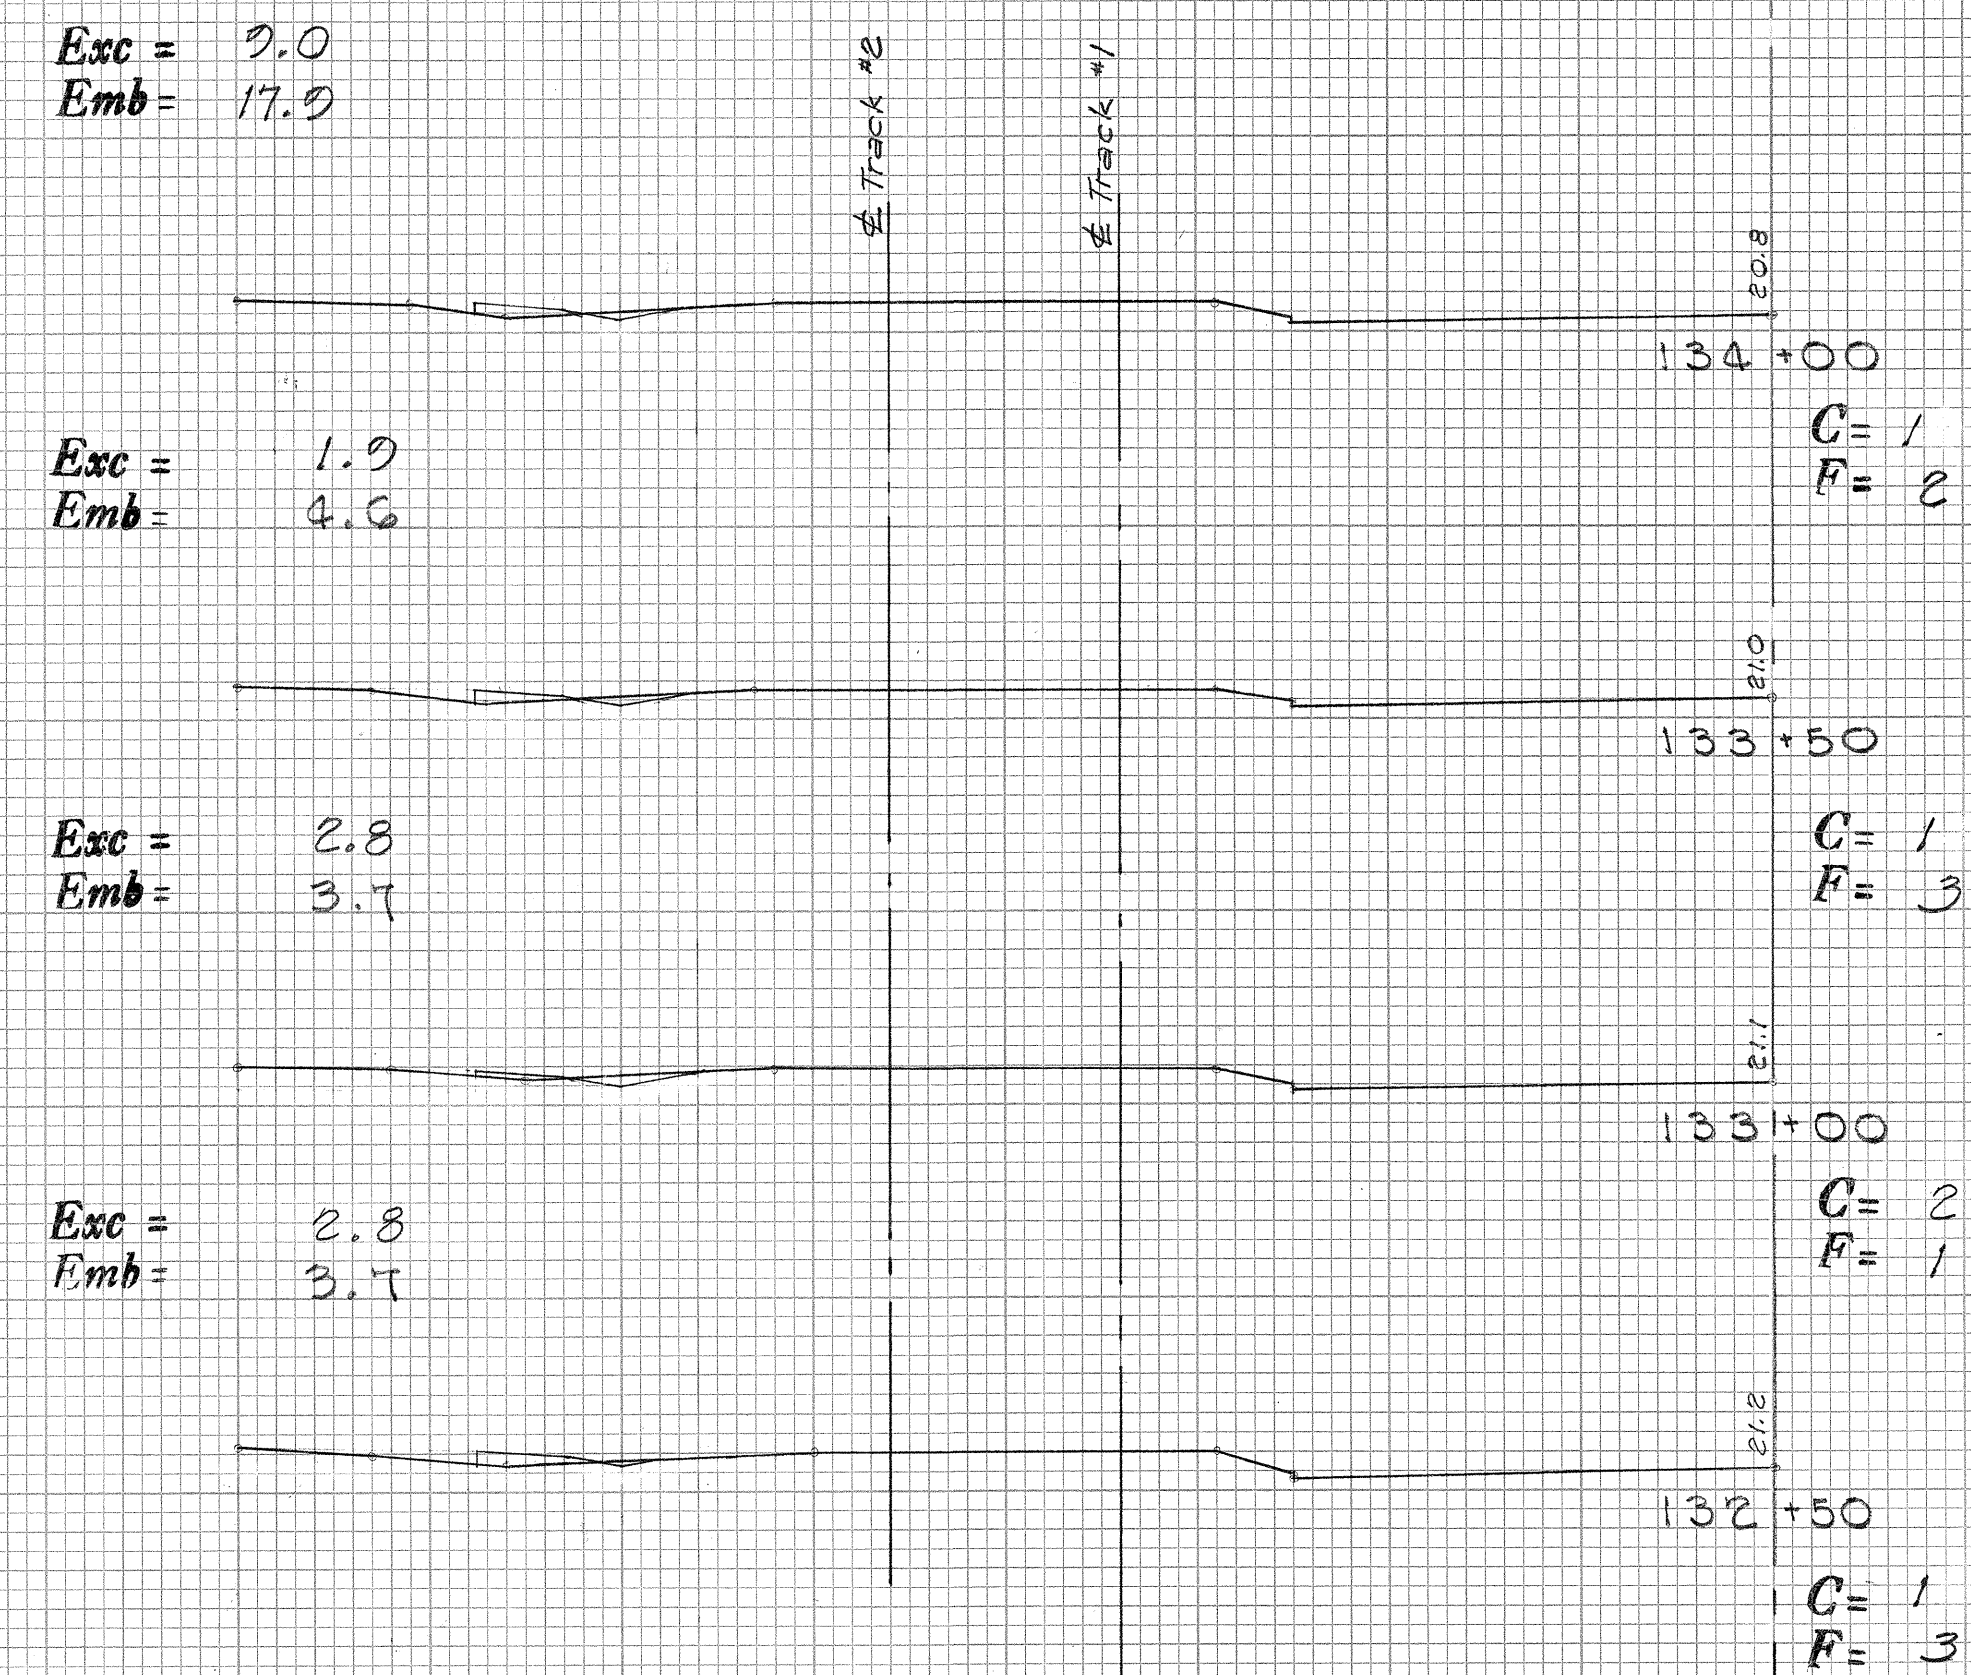



FED. ROAD DIST. NO.	STATE	FED. AID PROJ. NO.	FISCAL YEAR	SHEET NO.	TOTAL SHEETS
HAWAII	HAW	F 3 (34) UNIT 5	1951	13	16

FINAL SURVEY	SURVEYED	BY	DATE
NOTE BOOK	PLOTTED		
	TEMPLATE		
	AREA'S		
NO. _____	AREA'S CHECKED		


ORIGINAL SURVEY	SURVIVED	BY	DATE
NOTE BOOK	PLOTTED		
	TEMPLATE		
	AREAS		
NO. _____	AREAS CHECKED		

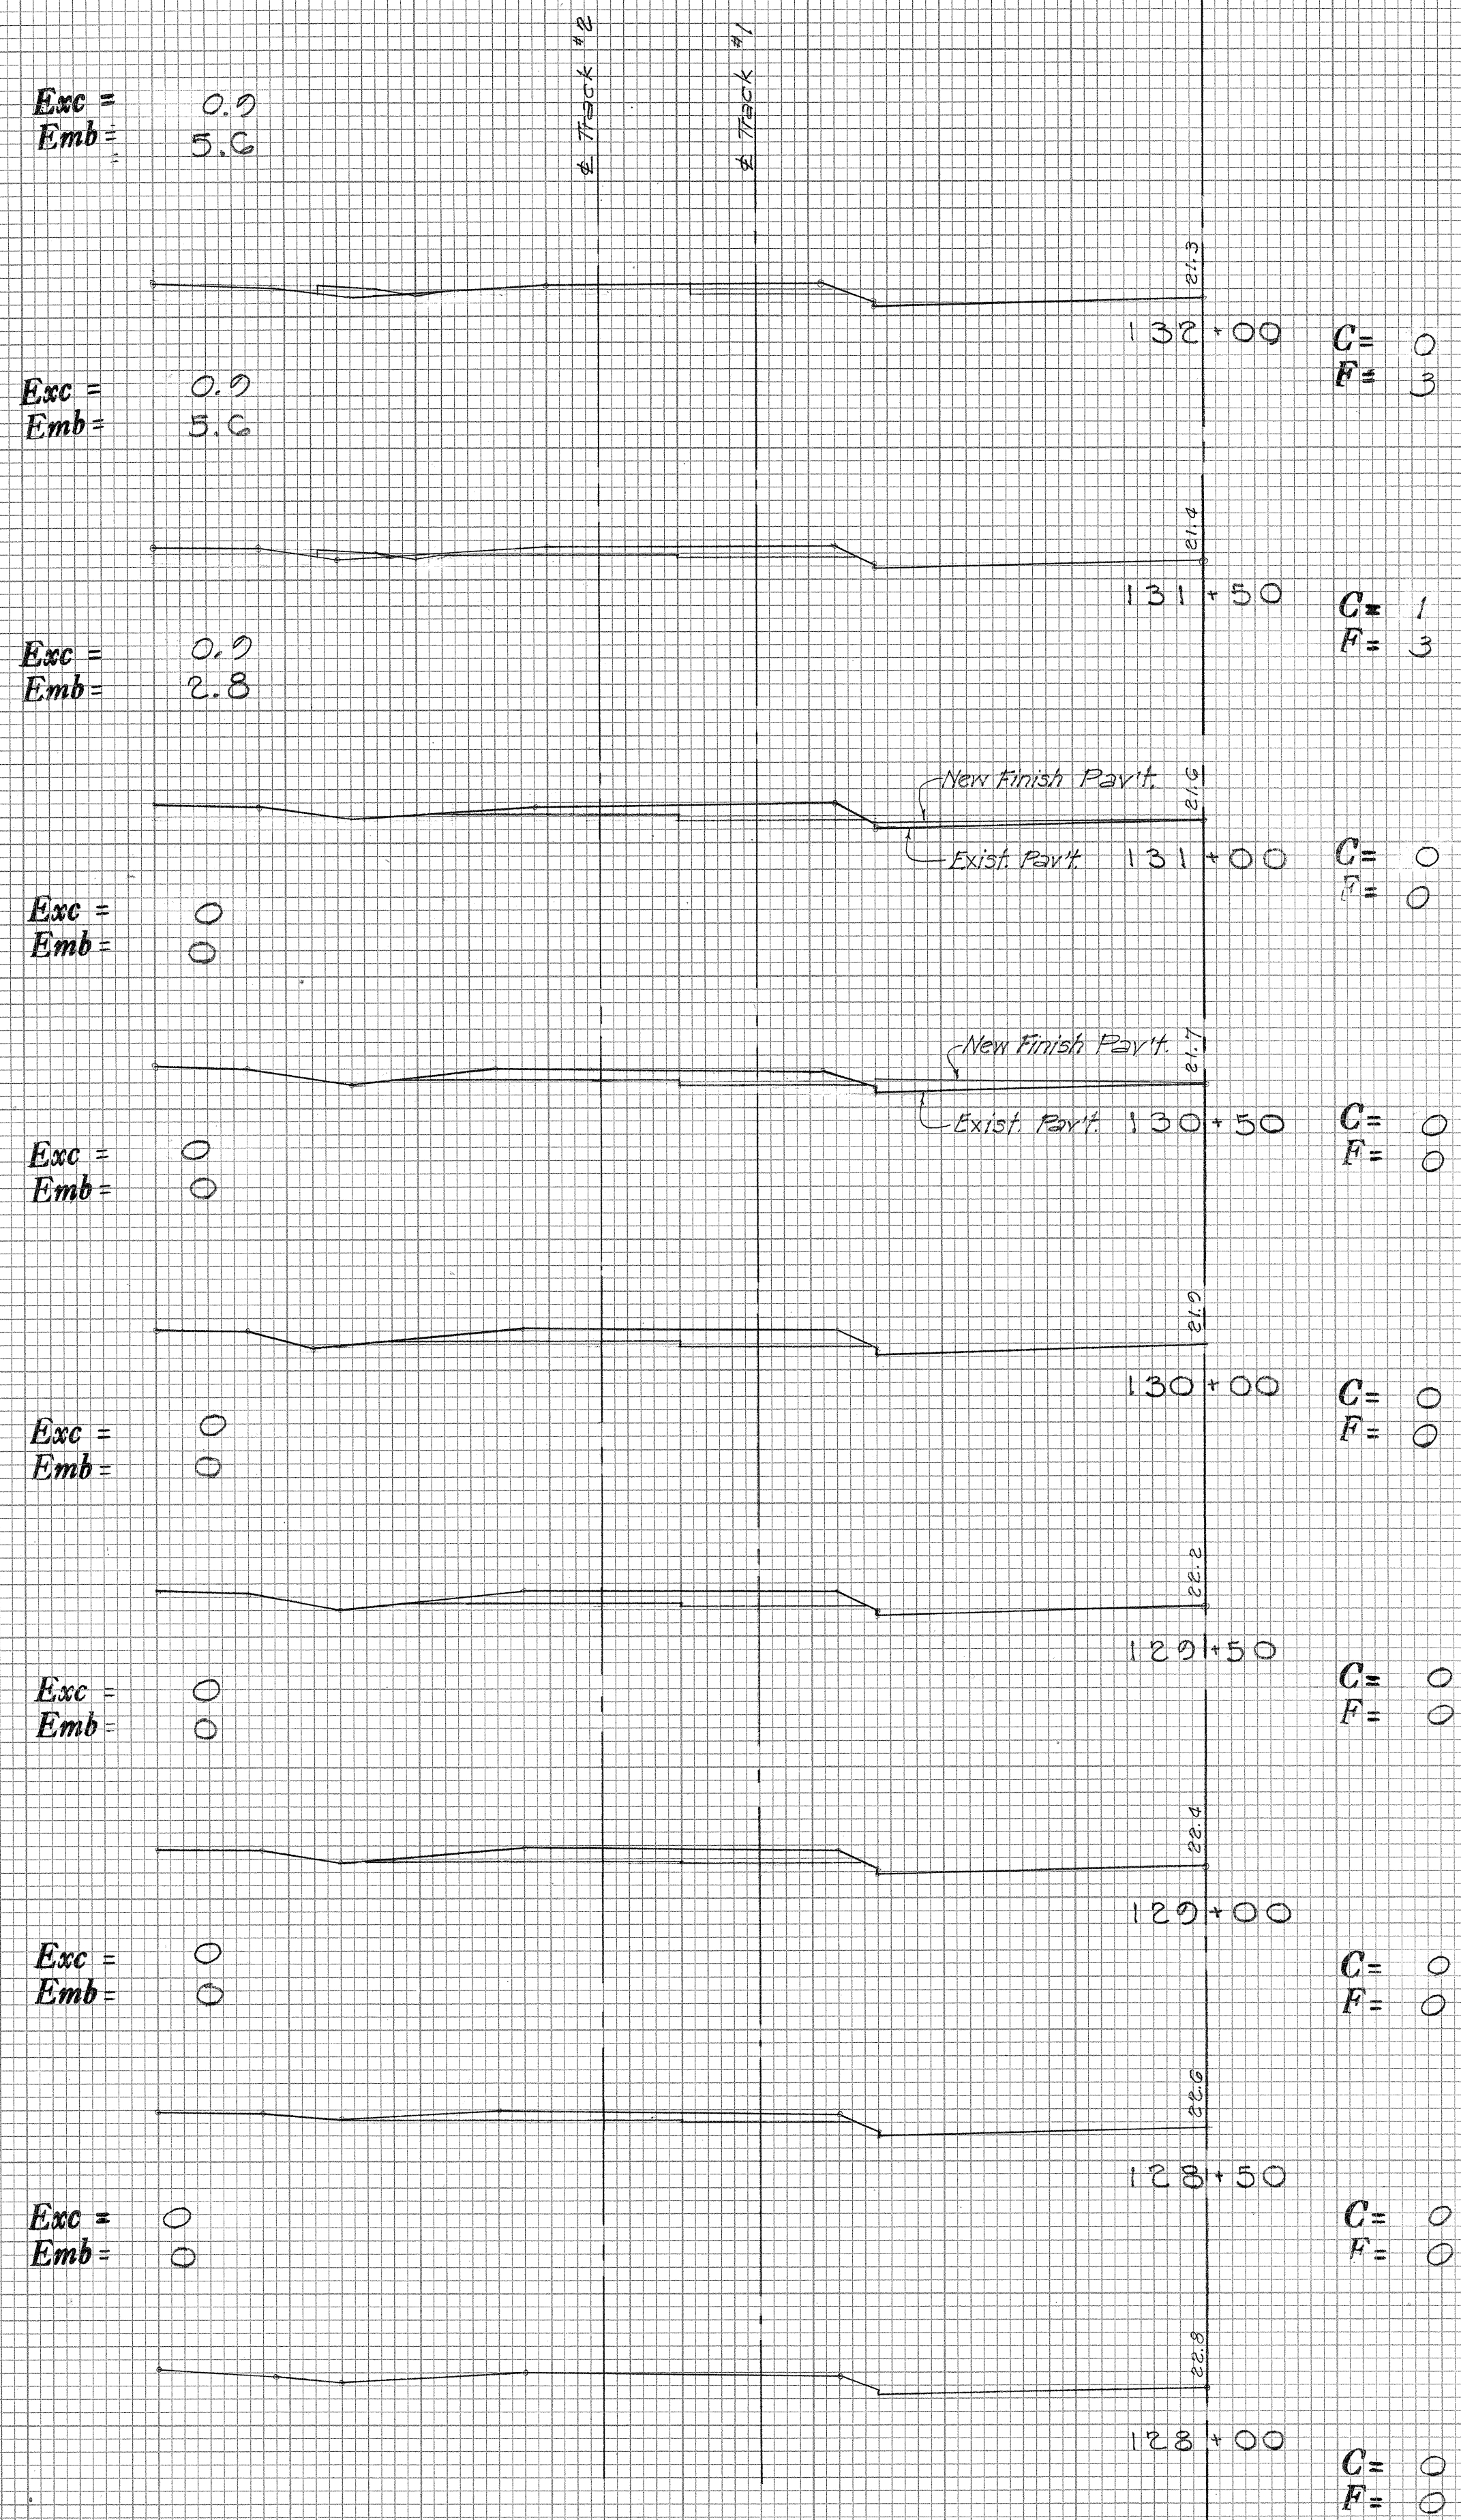

ORIGINAL	SURVEYED PLOTTED TEMPLATE AREAS AREAS CHECKED	BY _____	DATE _____
NOTE BOOK			
No. _____			

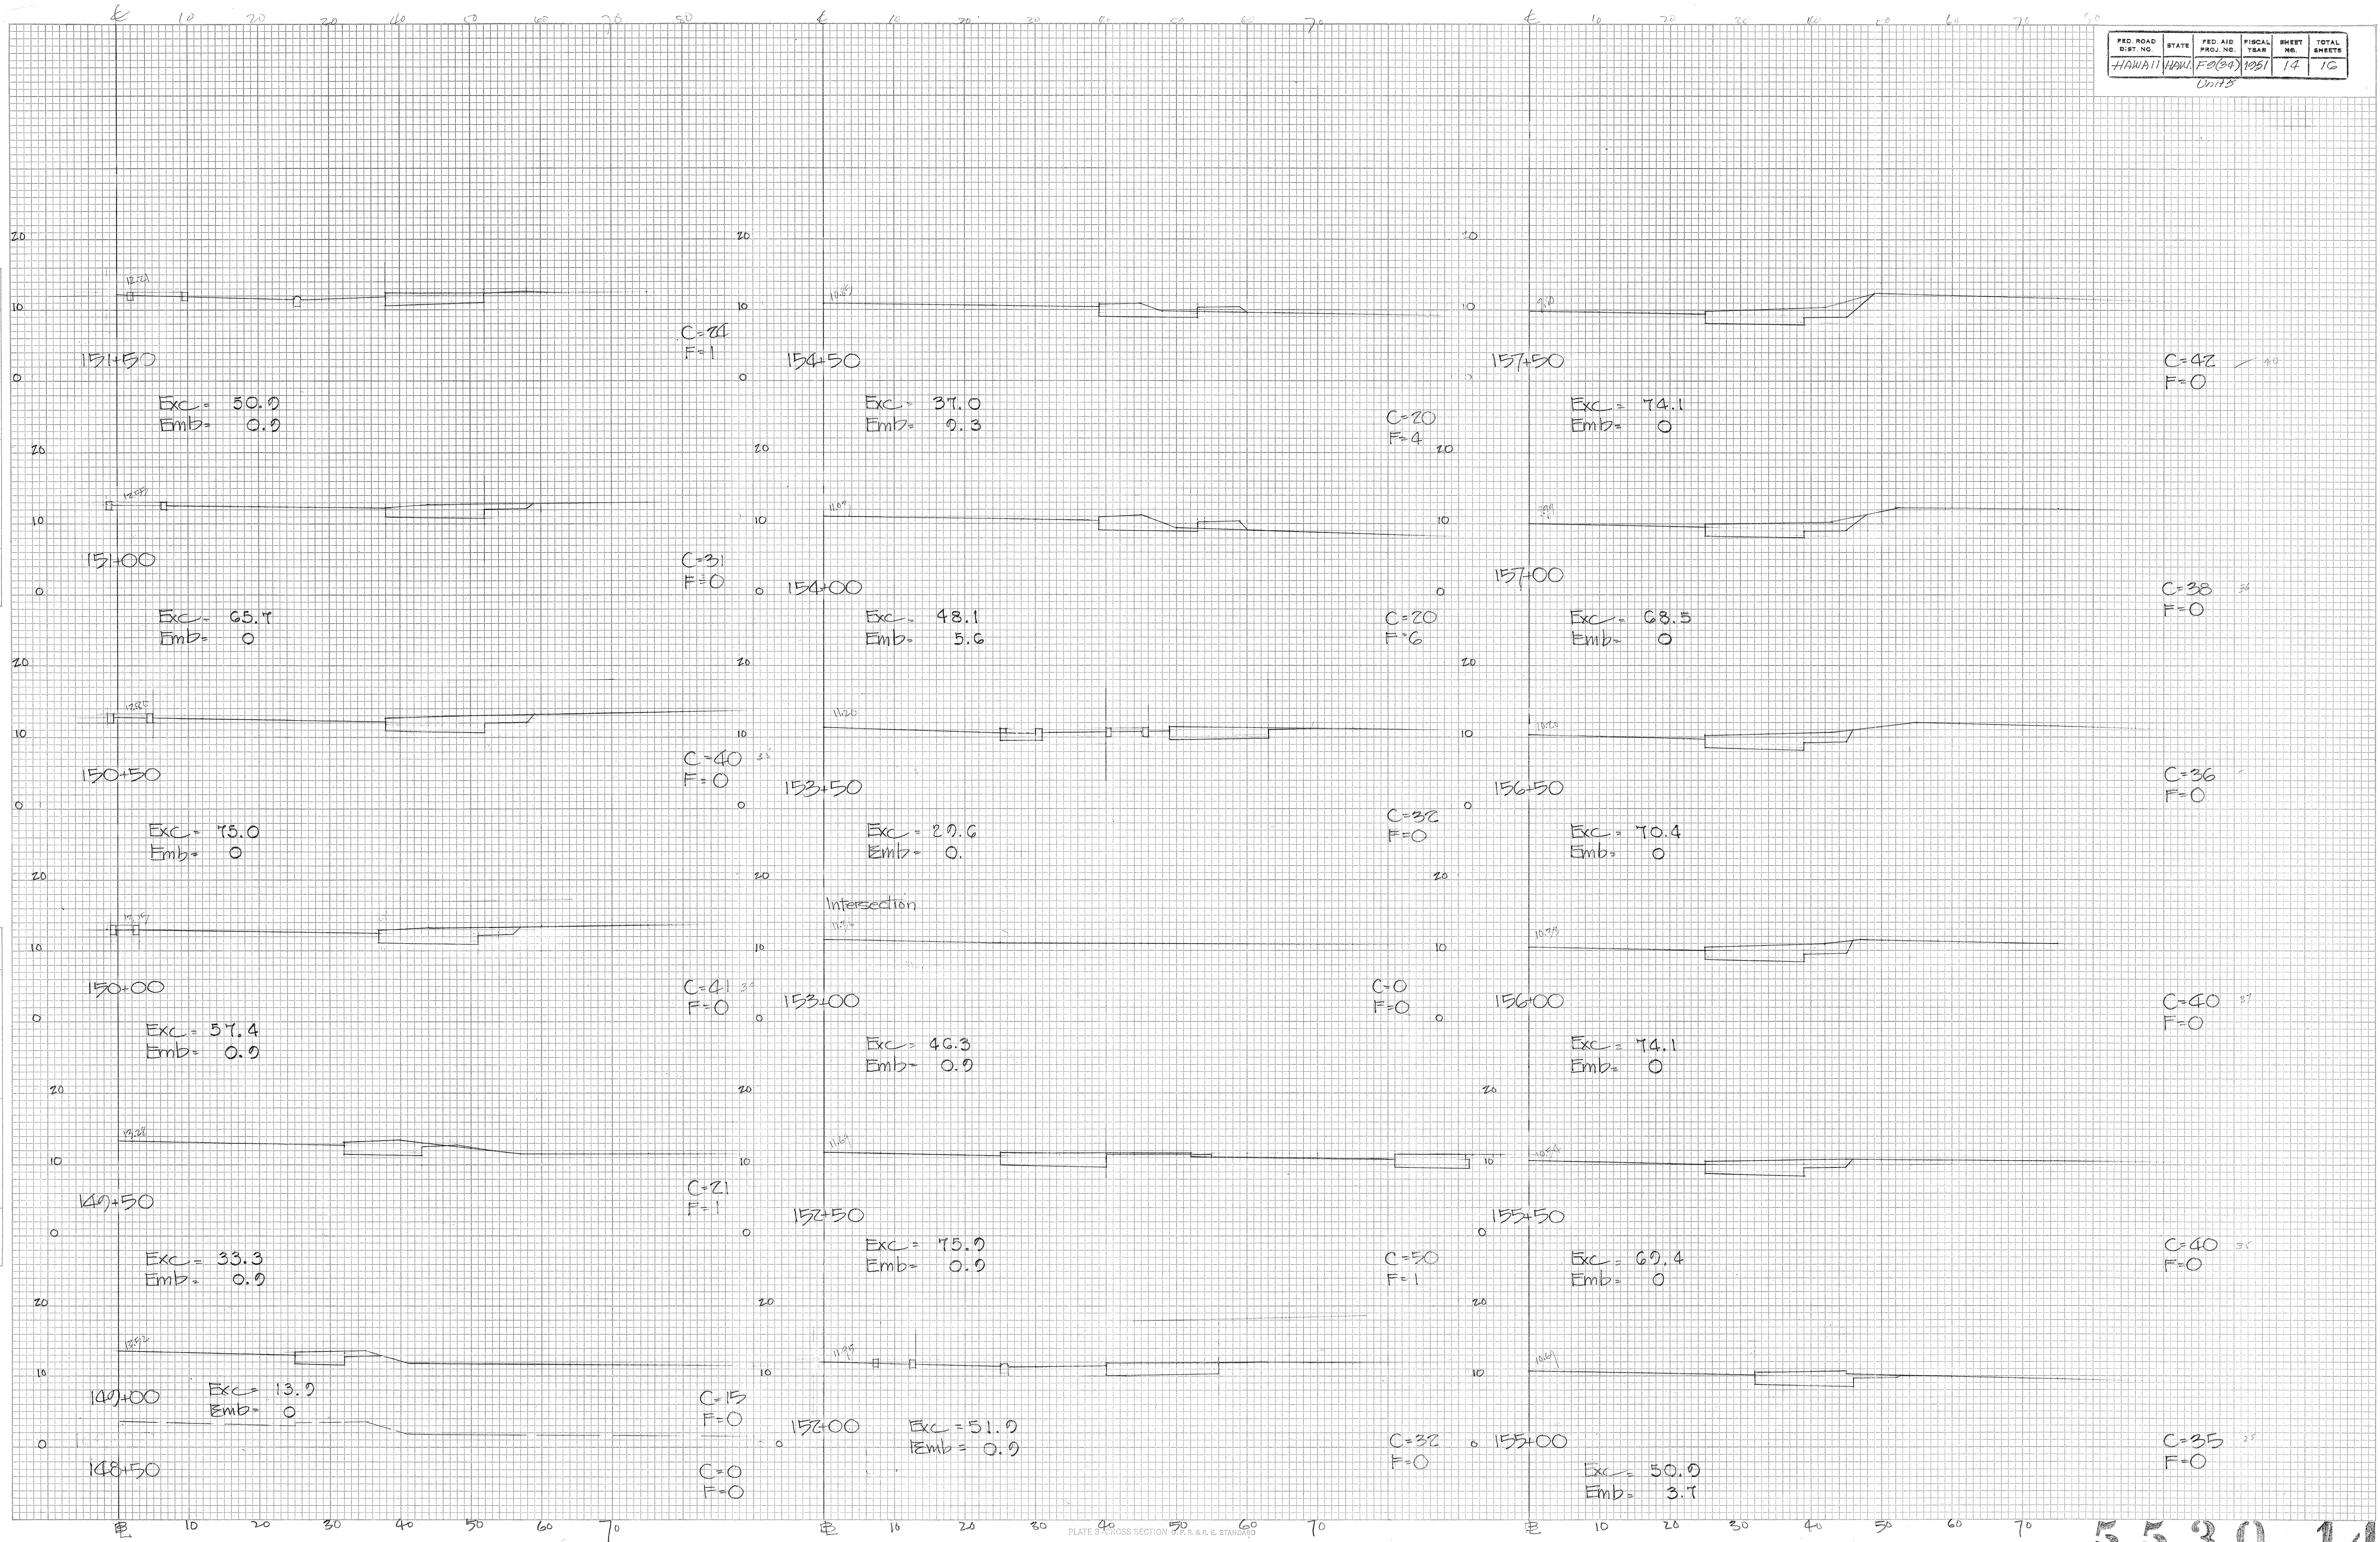

ORIGINAL	BY	DATE
SURVEYED		
PLOTTED		
TEMPLATE		
NOTE BOOK		
NO. _____		
AREAS		
AREAS CHECKED		

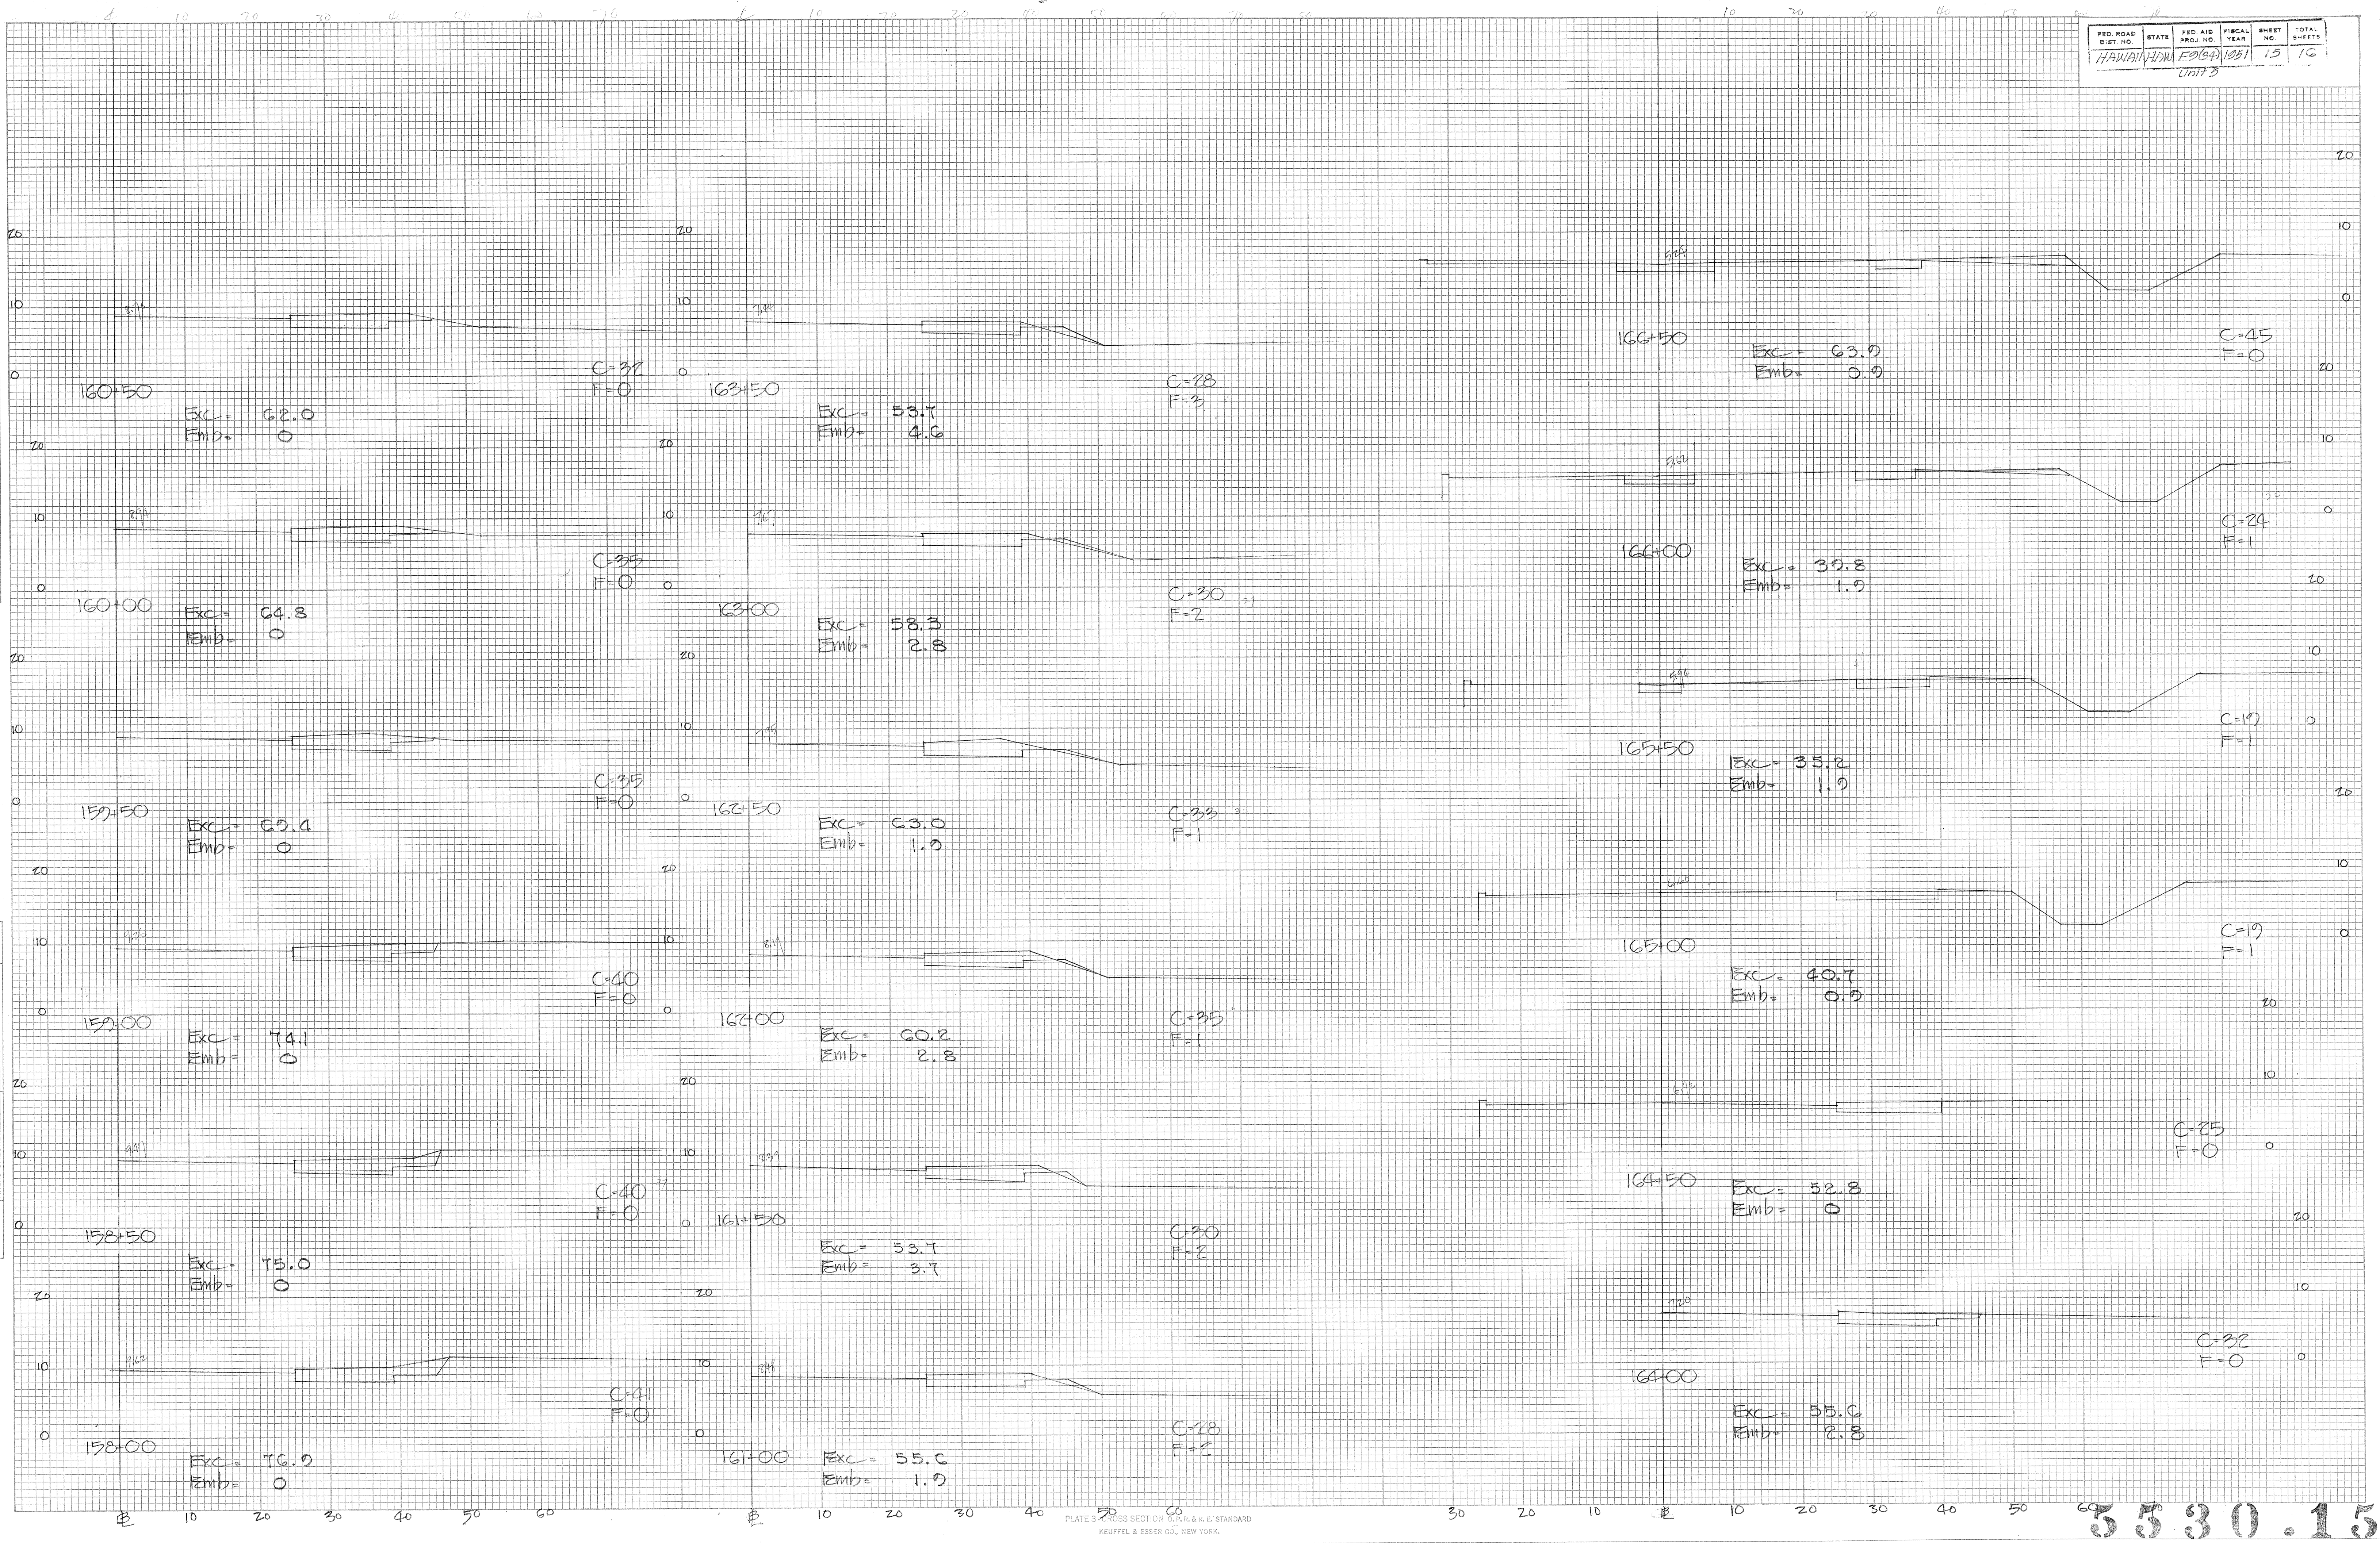

FINAL SURVEY NO.	DATE
SURVEYED BY	BY
PLOTTED	
TEMPLATE	
AREAS CHECKED	

ORIGINAL SURVEY NO.	DATE
SURVEYED BY	BY
PLOTTED	
TEMPLATE	
AREAS CHECKED	

