



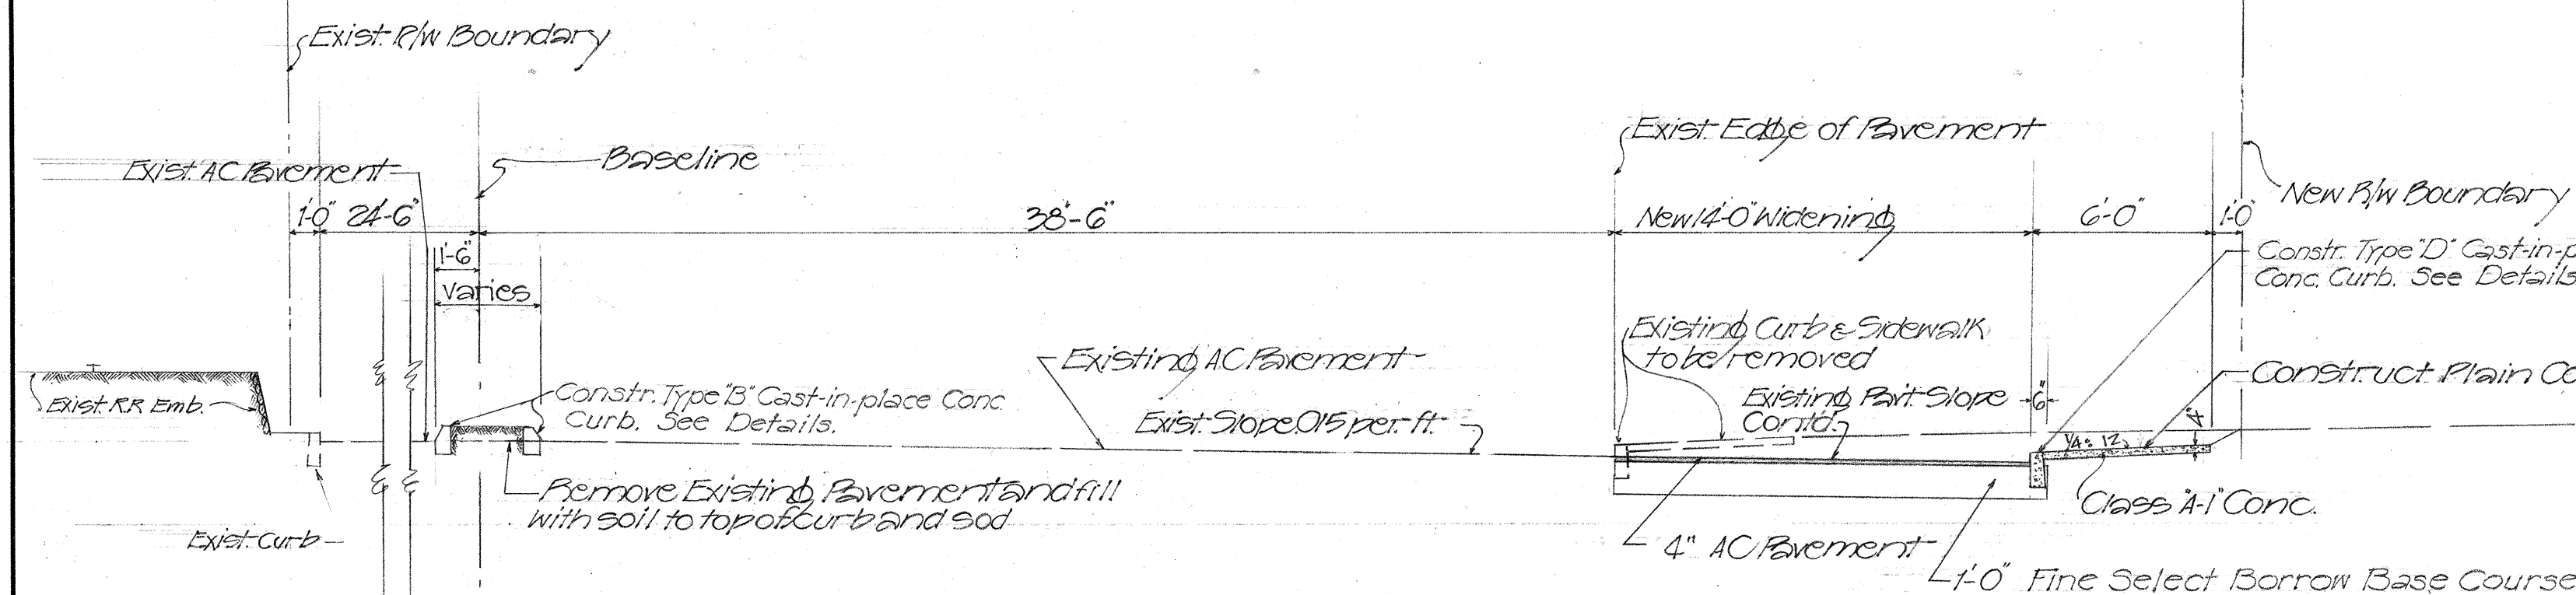


TYPICAL SECTION ON TANGENT
Sta 150+15 to Sta 151+65

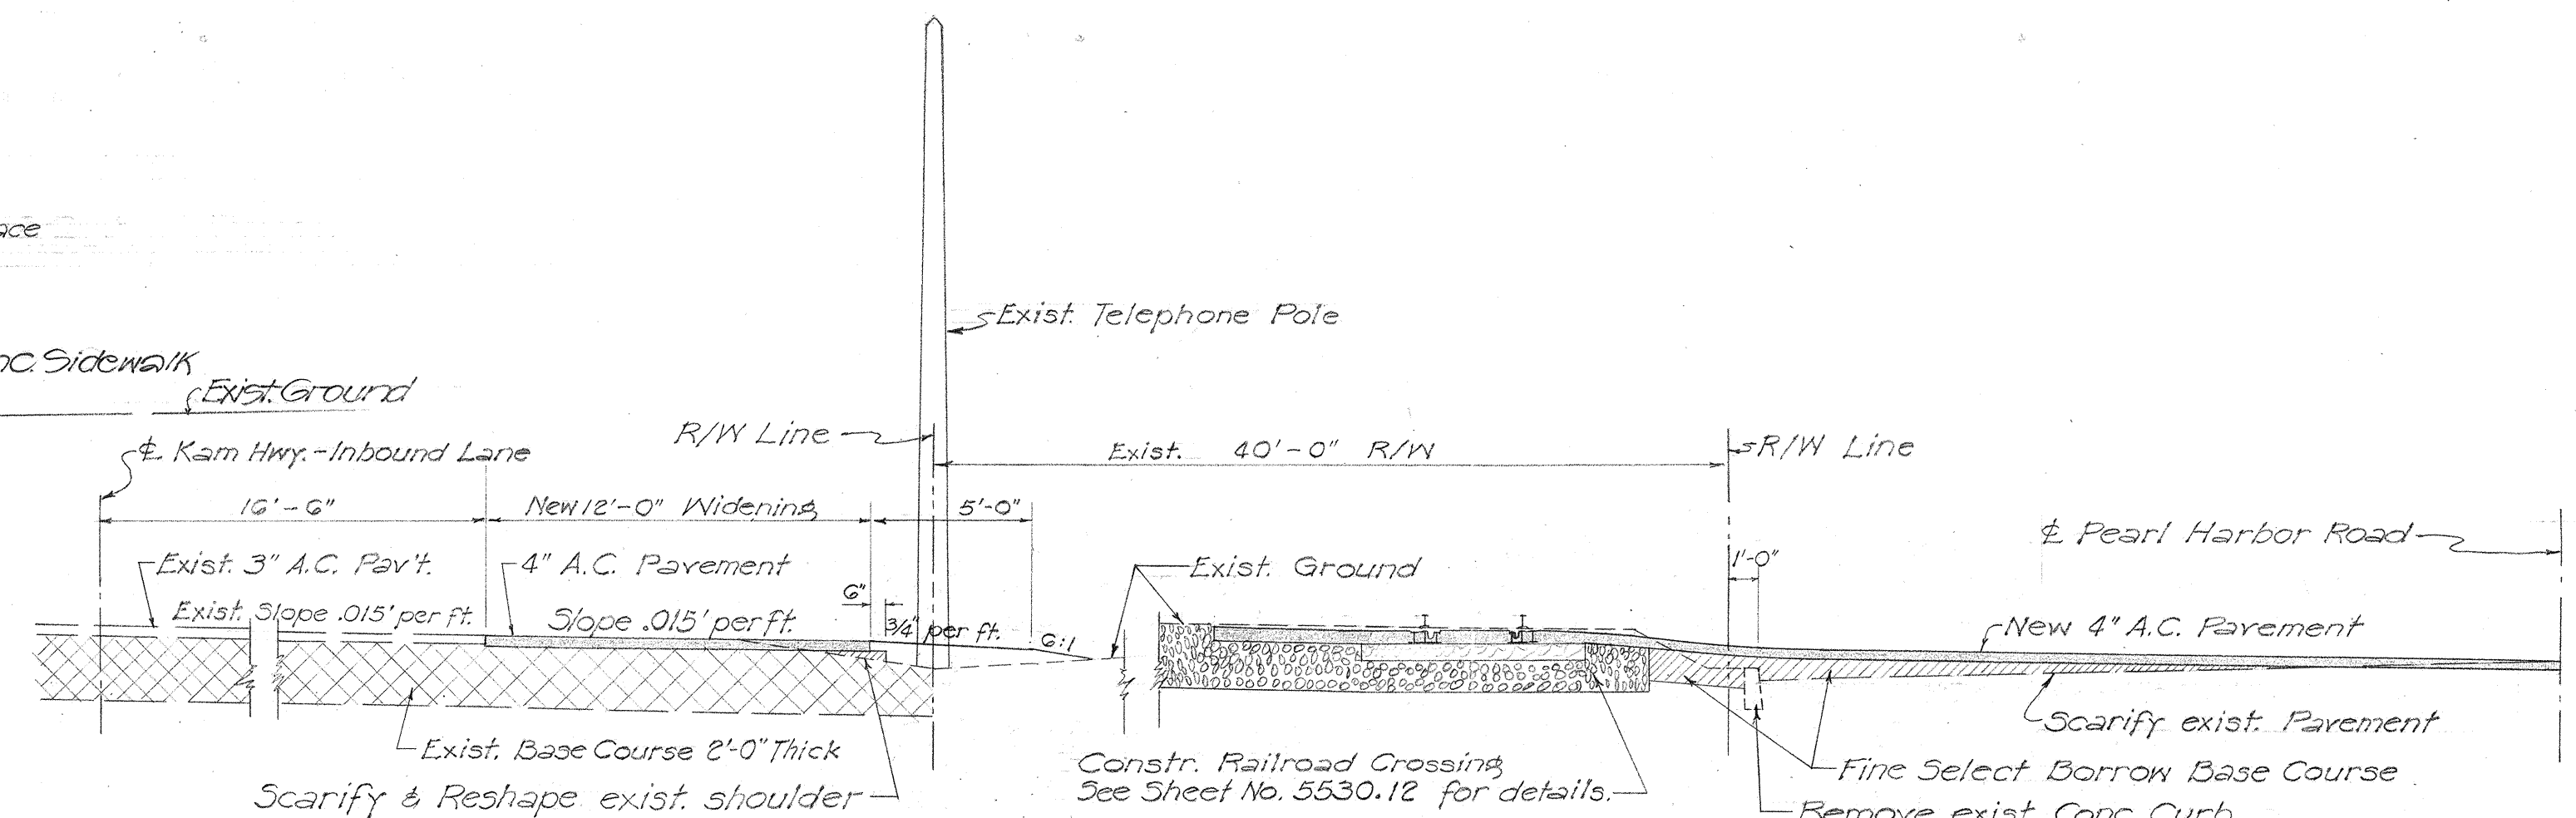


TYPICAL SECTION OF KAMEHAMEHA
HIGHWAY - INBOUND LANE STA. 131+50


TYPICAL SECTION OF PEARL HARBOR
ROAD - OUTBOUND LANE STA. 130+50

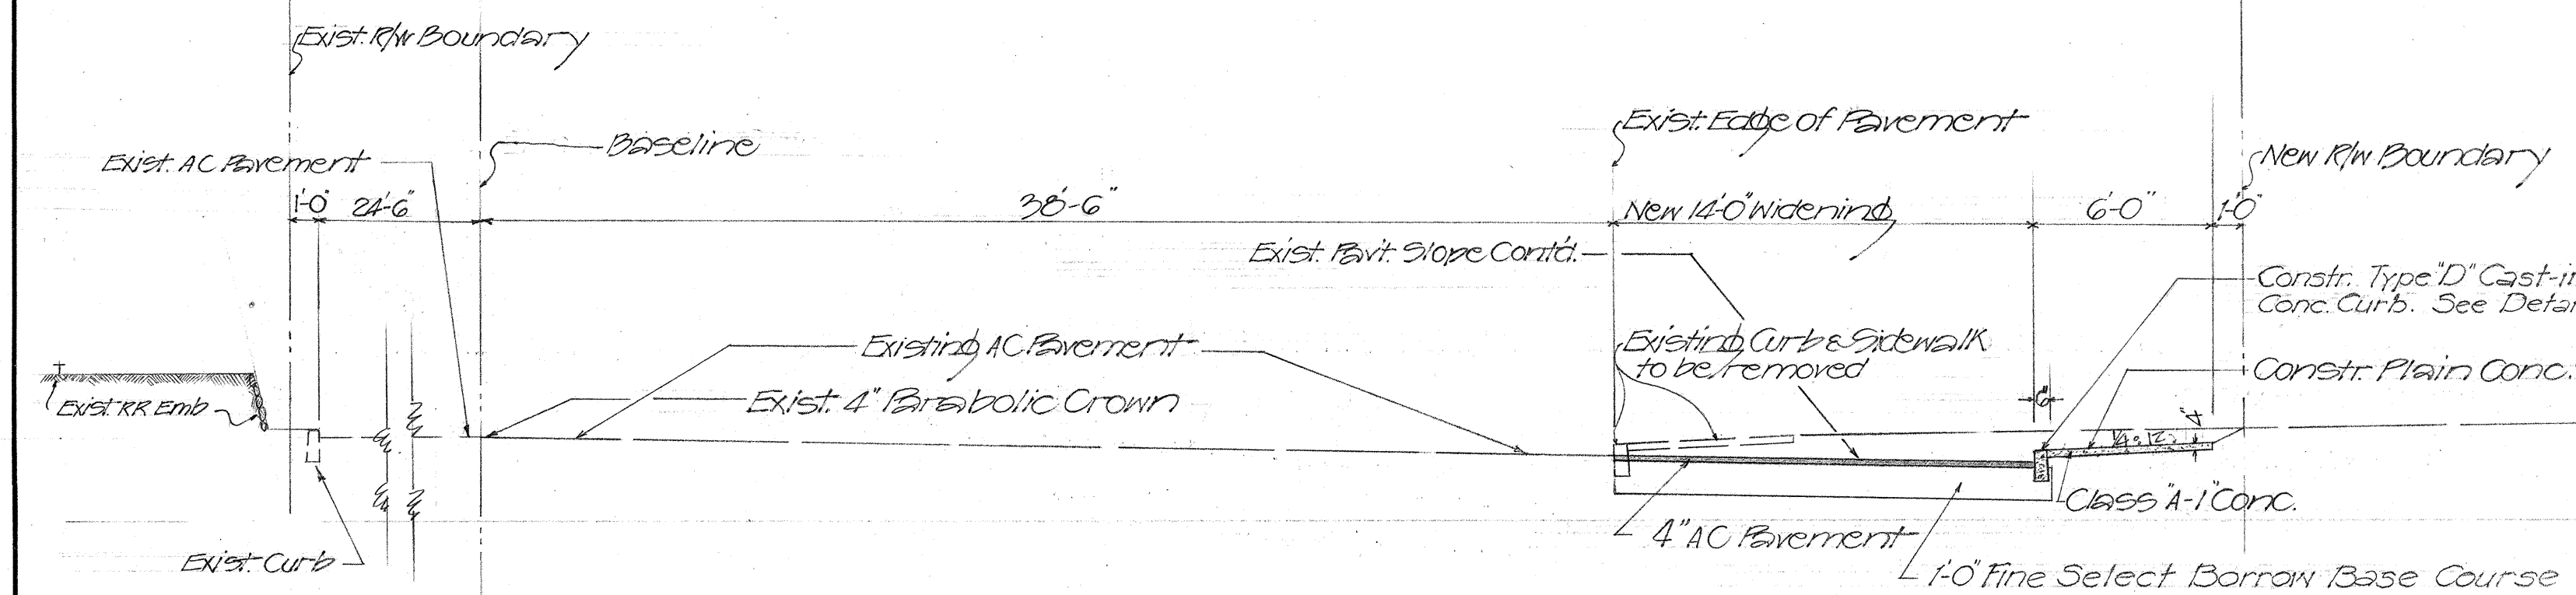

TYPICAL SECTION ON TANGENT
Sta 154+00 to Sta 156+80

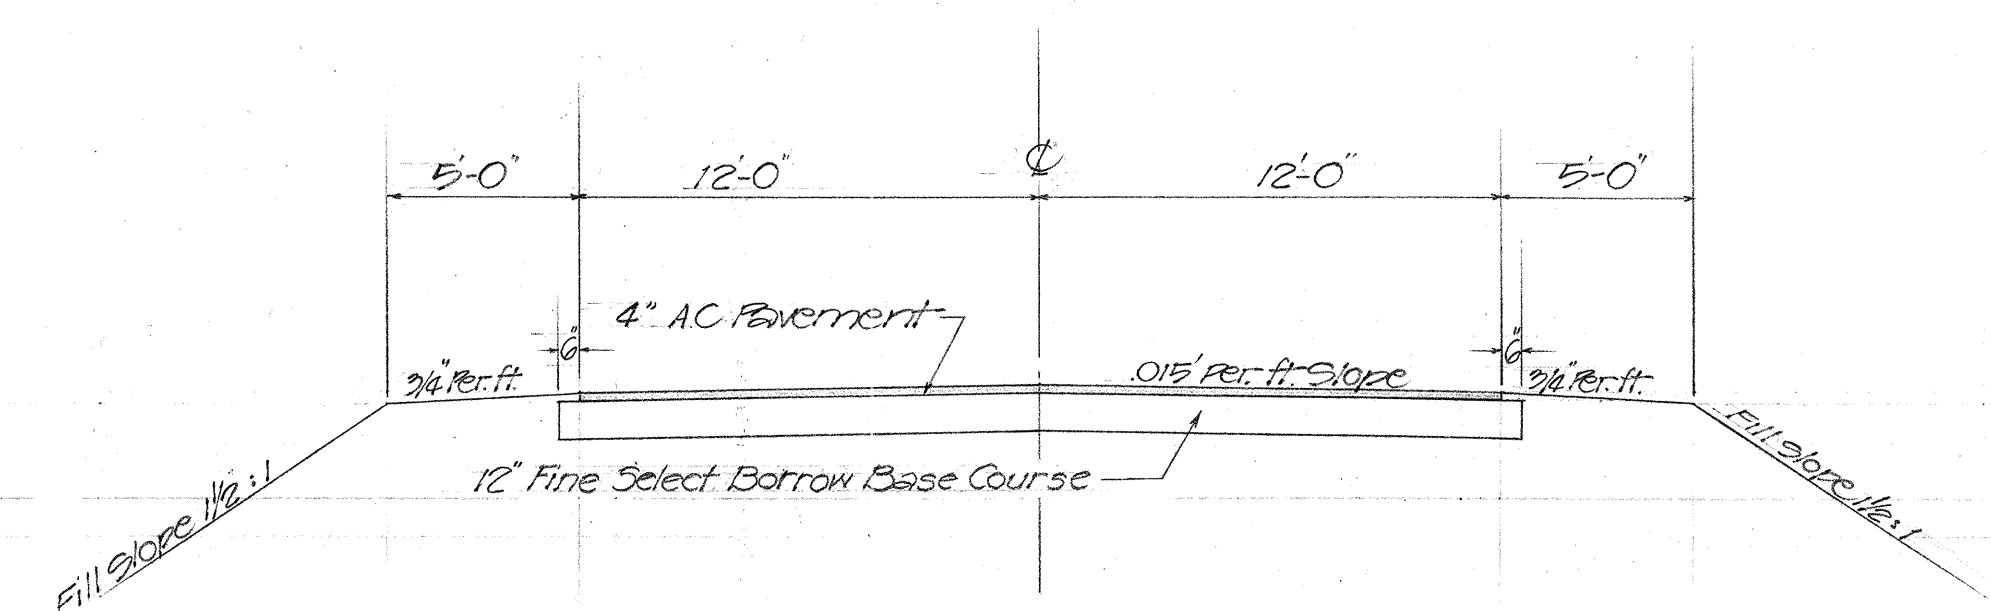

TYPICAL SECTION OF CROSSOVER AT STA 130+50

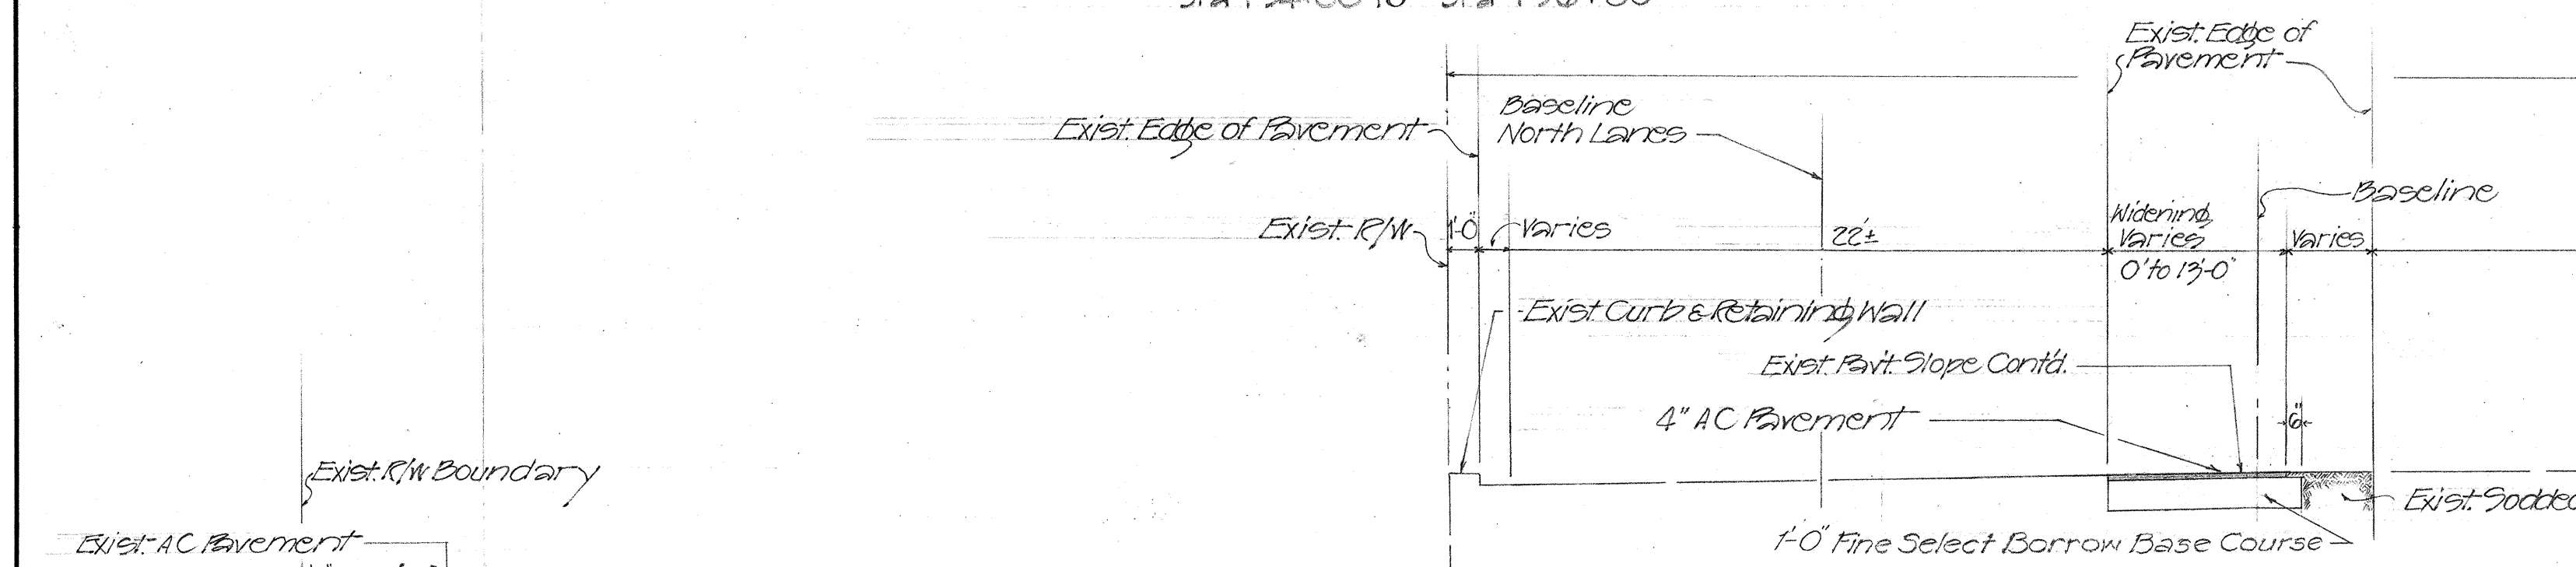

TYPICAL SECTION ON TANGENT
Sta 158+20 to Sta 164+20

TYPICAL SECTION ON CURVE
Sta 164+20 to Sta 170+49.50

GENERAL NOTES

ASPHALT CONCRETE PAVEMENT - Asphalt Concrete Pavement shall be 4" compacted thickness consisting of 2 1/2" Asphalt Leveling Course (Mix III) and 1 1/2" Asphalt Concrete Surface Course (Mix I).

BASE COURSE - Fine Select Borrow Base Course shall be 12" of compacted Coral or equal laid in layers of 6" compacted thickness.

All the above courses subject to Special Provisions and Specifications.

TERRITORIAL HIGHWAY DEPARTMENT
TERRITORY OF HAWAII

TYPICAL SECTION
PROJ. F-0 (24) UNIT 5

Scale: 1" = 5'-0"

DEC 1950

SHEET No. OF SHEETS

5530.2

DATE:
DESIGNED BY:
DRAWN BY:
CHECKED BY:
NOTE BOOK NO.