

Exact location of GRP swale and new drain holes to be determined by the engineer.

Note: Clean all existing 4"  $\phi$  deck drain pipes. Incidental to drilling deck drain holes.

Slope 1" per ft. min. along axis of swale

Existing grade line

Abut. repair - see sht. # 3 & 4

10 New 4"  $\phi$  drains are located. Drill hole thru deck.

Reconstruct concrete railing. Approx. 6 lin. ft.

TYPICAL SECTION-GRP SWALE  
Scale: 1/4" = 1'-0"

NOTE RE-EMBANKMENTS.

Placing of embankment in layers and rolling shall conform with the specifications therefor; roller being used as long as there is clearance for its height.

Reconstruct 2'-0" section of existing conc. rail.

Warp GRP as required

Remove existing silt-hatch area. Incidental to G.R.P.

Warp GRP as required


Hatched area washout. Use imported borrow to restore to approx. plan grade lines. 135 cu yds.

LAYOUT OF BRIDGE. Scale: 1" = 20'

Repair & patch various locations along concrete railing as directed. Total - 20 lin. ft.


### GENERAL NOTES.

- Dead Load :-** Concrete at 150# per cu ft.
- Live Load :-** Train of 15 ton trucks in three traffic lanes, spacing of trucks as per diagram with 30% allowance for impact.
- Concrete :-** Class "A" (1:2:4) mix with all exposed edges chamfered 3/8" unless otherwise noted. Allowable compression 4500# per sq. inch.
- Reinforcing Steel :-** Allowable tensile stress 16,000# per sq. inch. All steel to be round or square deformed bars of approved design, square twisted bars not to be considered deformed. All dimensions relating to reinforcement are to centers of bars unless otherwise noted. Where splicing of reinforcement is necessary bars are to be lapped 40 diameters & splices are to be staggered. Main longitudinal bars in girders cannot be spliced. No allowance will be made in the quantities for extra weight of steel required for splices. Unless otherwise noted the minimum covering measured from the surface of concrete to the face of any steel shall be not less than 2 1/2" in abutments and abutment footings; 2" in beams, girders & handrails and 1 1/4" in slabs. Steel to be held rigidly & accurately in place before and during placing of concrete.

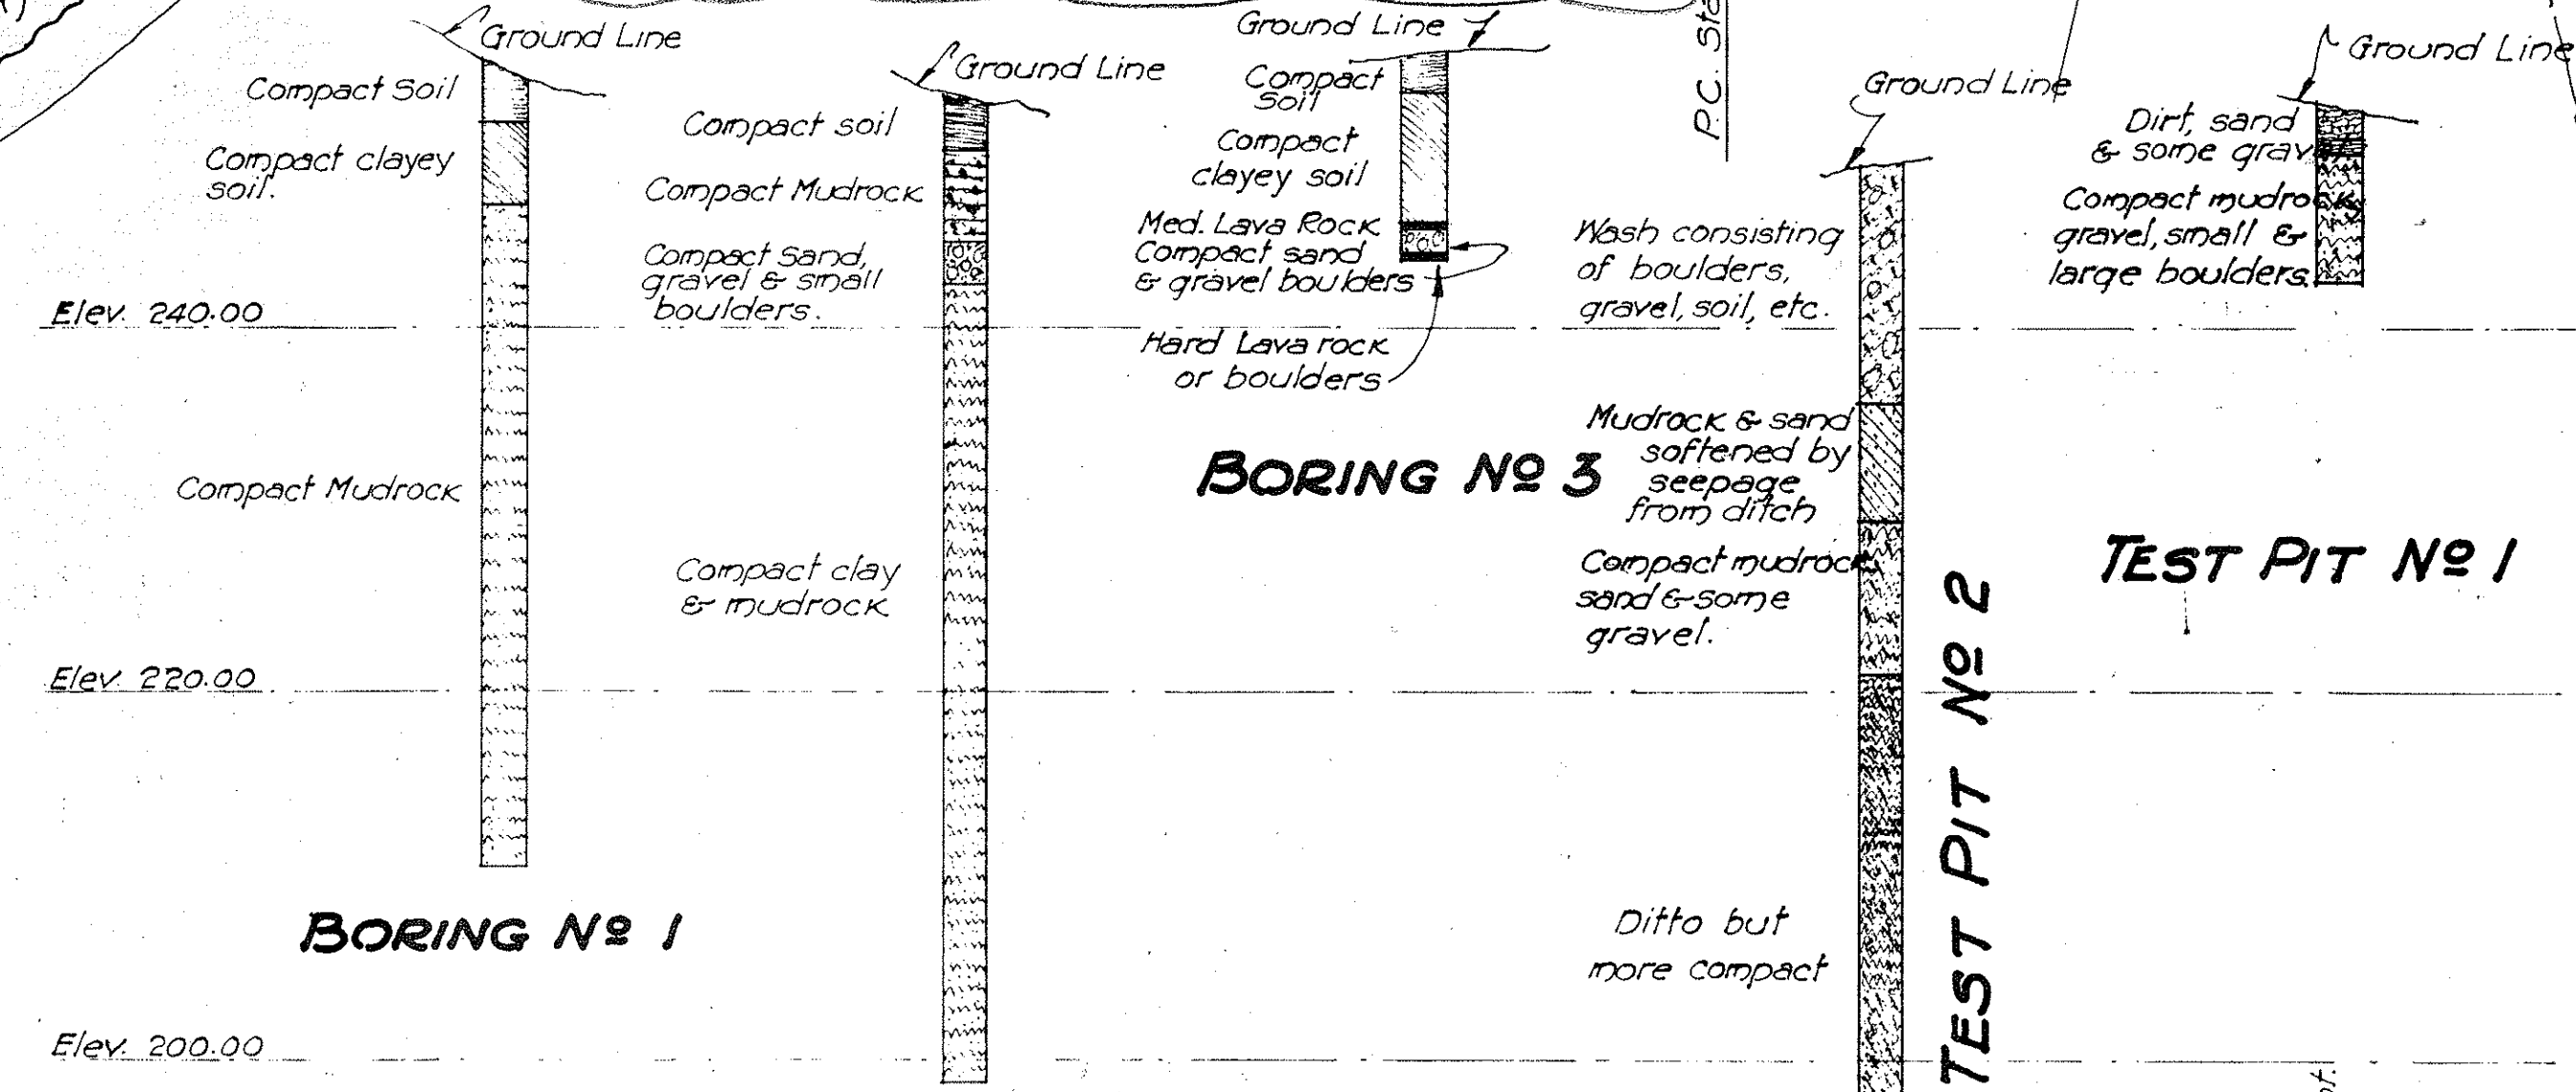

### ITEMS OF REPAIR AND ESTIMATED QUANTITIES

| ITEM NO | DESCRIPTION                                                                           | UNIT | QUANTITY |
|---------|---------------------------------------------------------------------------------------|------|----------|
| 640.08  | Repairs to Kipapa Bridge with shot-grate and/or Hand-Placed Mortar - Types 1, 2 and 3 | SF   | 15       |
| 612.92  | Grouted Rubble Paving for Kipapa Bridge                                               | C.Y. | 14       |
| 508.91  | Cement Rubble Masonry for Kipapa Br.                                                  | C.Y. | 2        |
| 200.91  | Structure excavation for CRM at Kipapa Bridge                                         | C.Y. | 3        |
| 640.11  | Repairs to concrete Railing at Kipapa Br.                                             | L.F. | 28       |
| 203.91  | Imported borrow                                                                       | C.Y. | 185      |
| 650.01  | Drilling of deck drain holes at Kipapa Br.                                            | EA   | 10       |

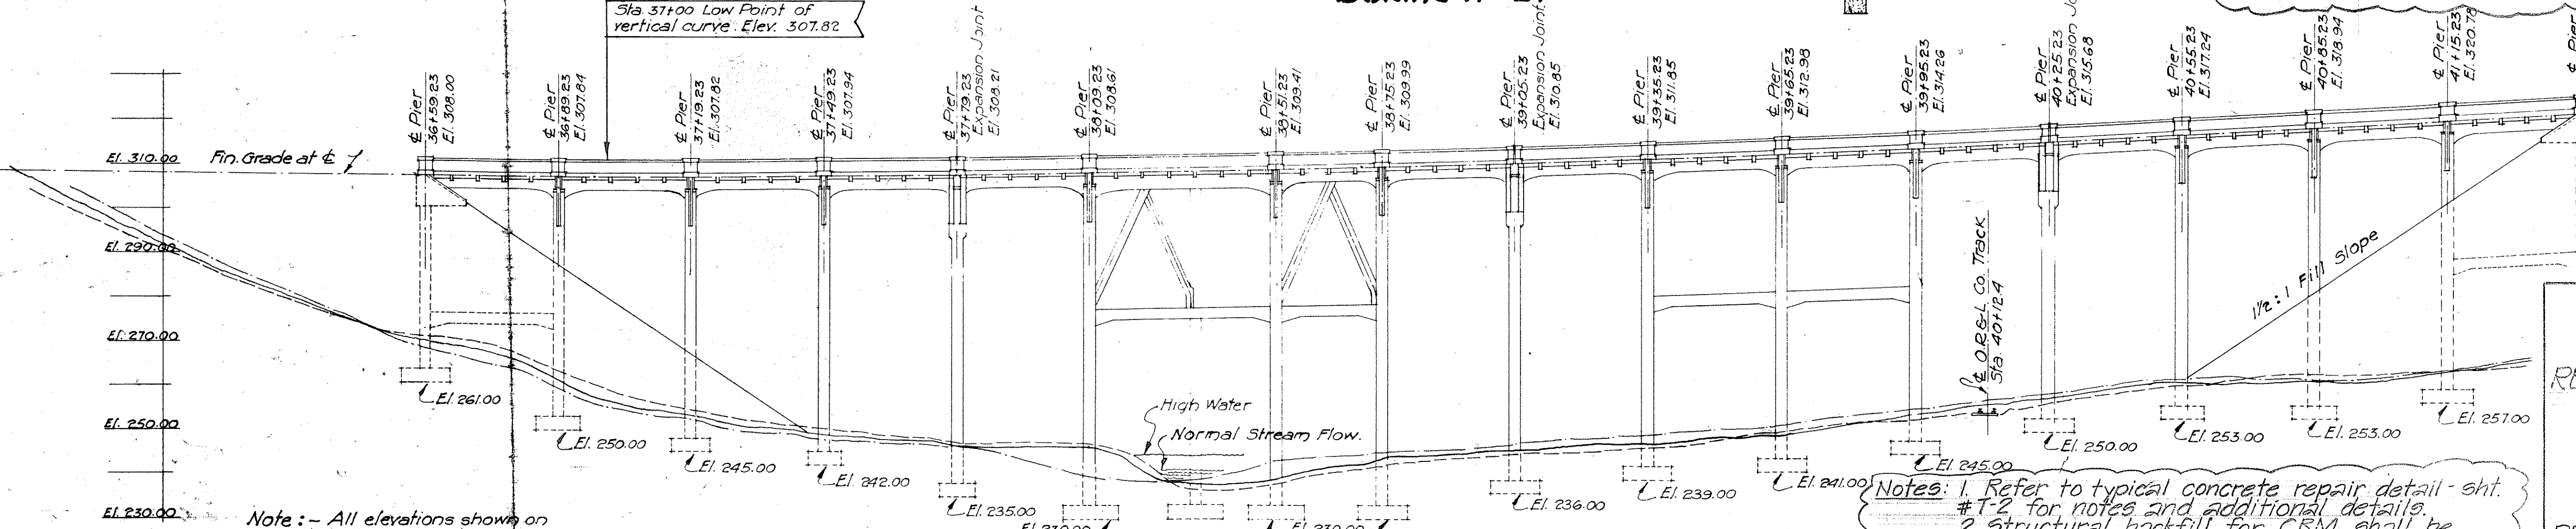

### ELEVATION OF BRIDGE.

Scale 1" = 20'

Note: - All elevations shown on bridge superstructure are finished & pavement grade.

Notes: 1. Refer to typical concrete repair detail - sht. #1-2 for notes and additional details.  
2. Structural backfill for CRM shall be incidental to structural excavation and will not be paid for separately.

THIS DRAWING IS IN PART ORIGINAL CONTRACT PLANS OF EXISTING KIPAPA BRIDGE FOR INFORMATION AND GUIDANCE TO REPAIR WORKS.


STATE OF HAWAII  
DEPARTMENT OF TRANSPORTATION  
HIGHWAYS DIVISION

### REHABILITATION AND REPAIRS TO KIPAPA BRIDGE


PROJ. NO HWY-0-01-72 NOV, 1971  
SHEET NO. 1 OF 4 SHEETS

Expansion joint

9' 6"

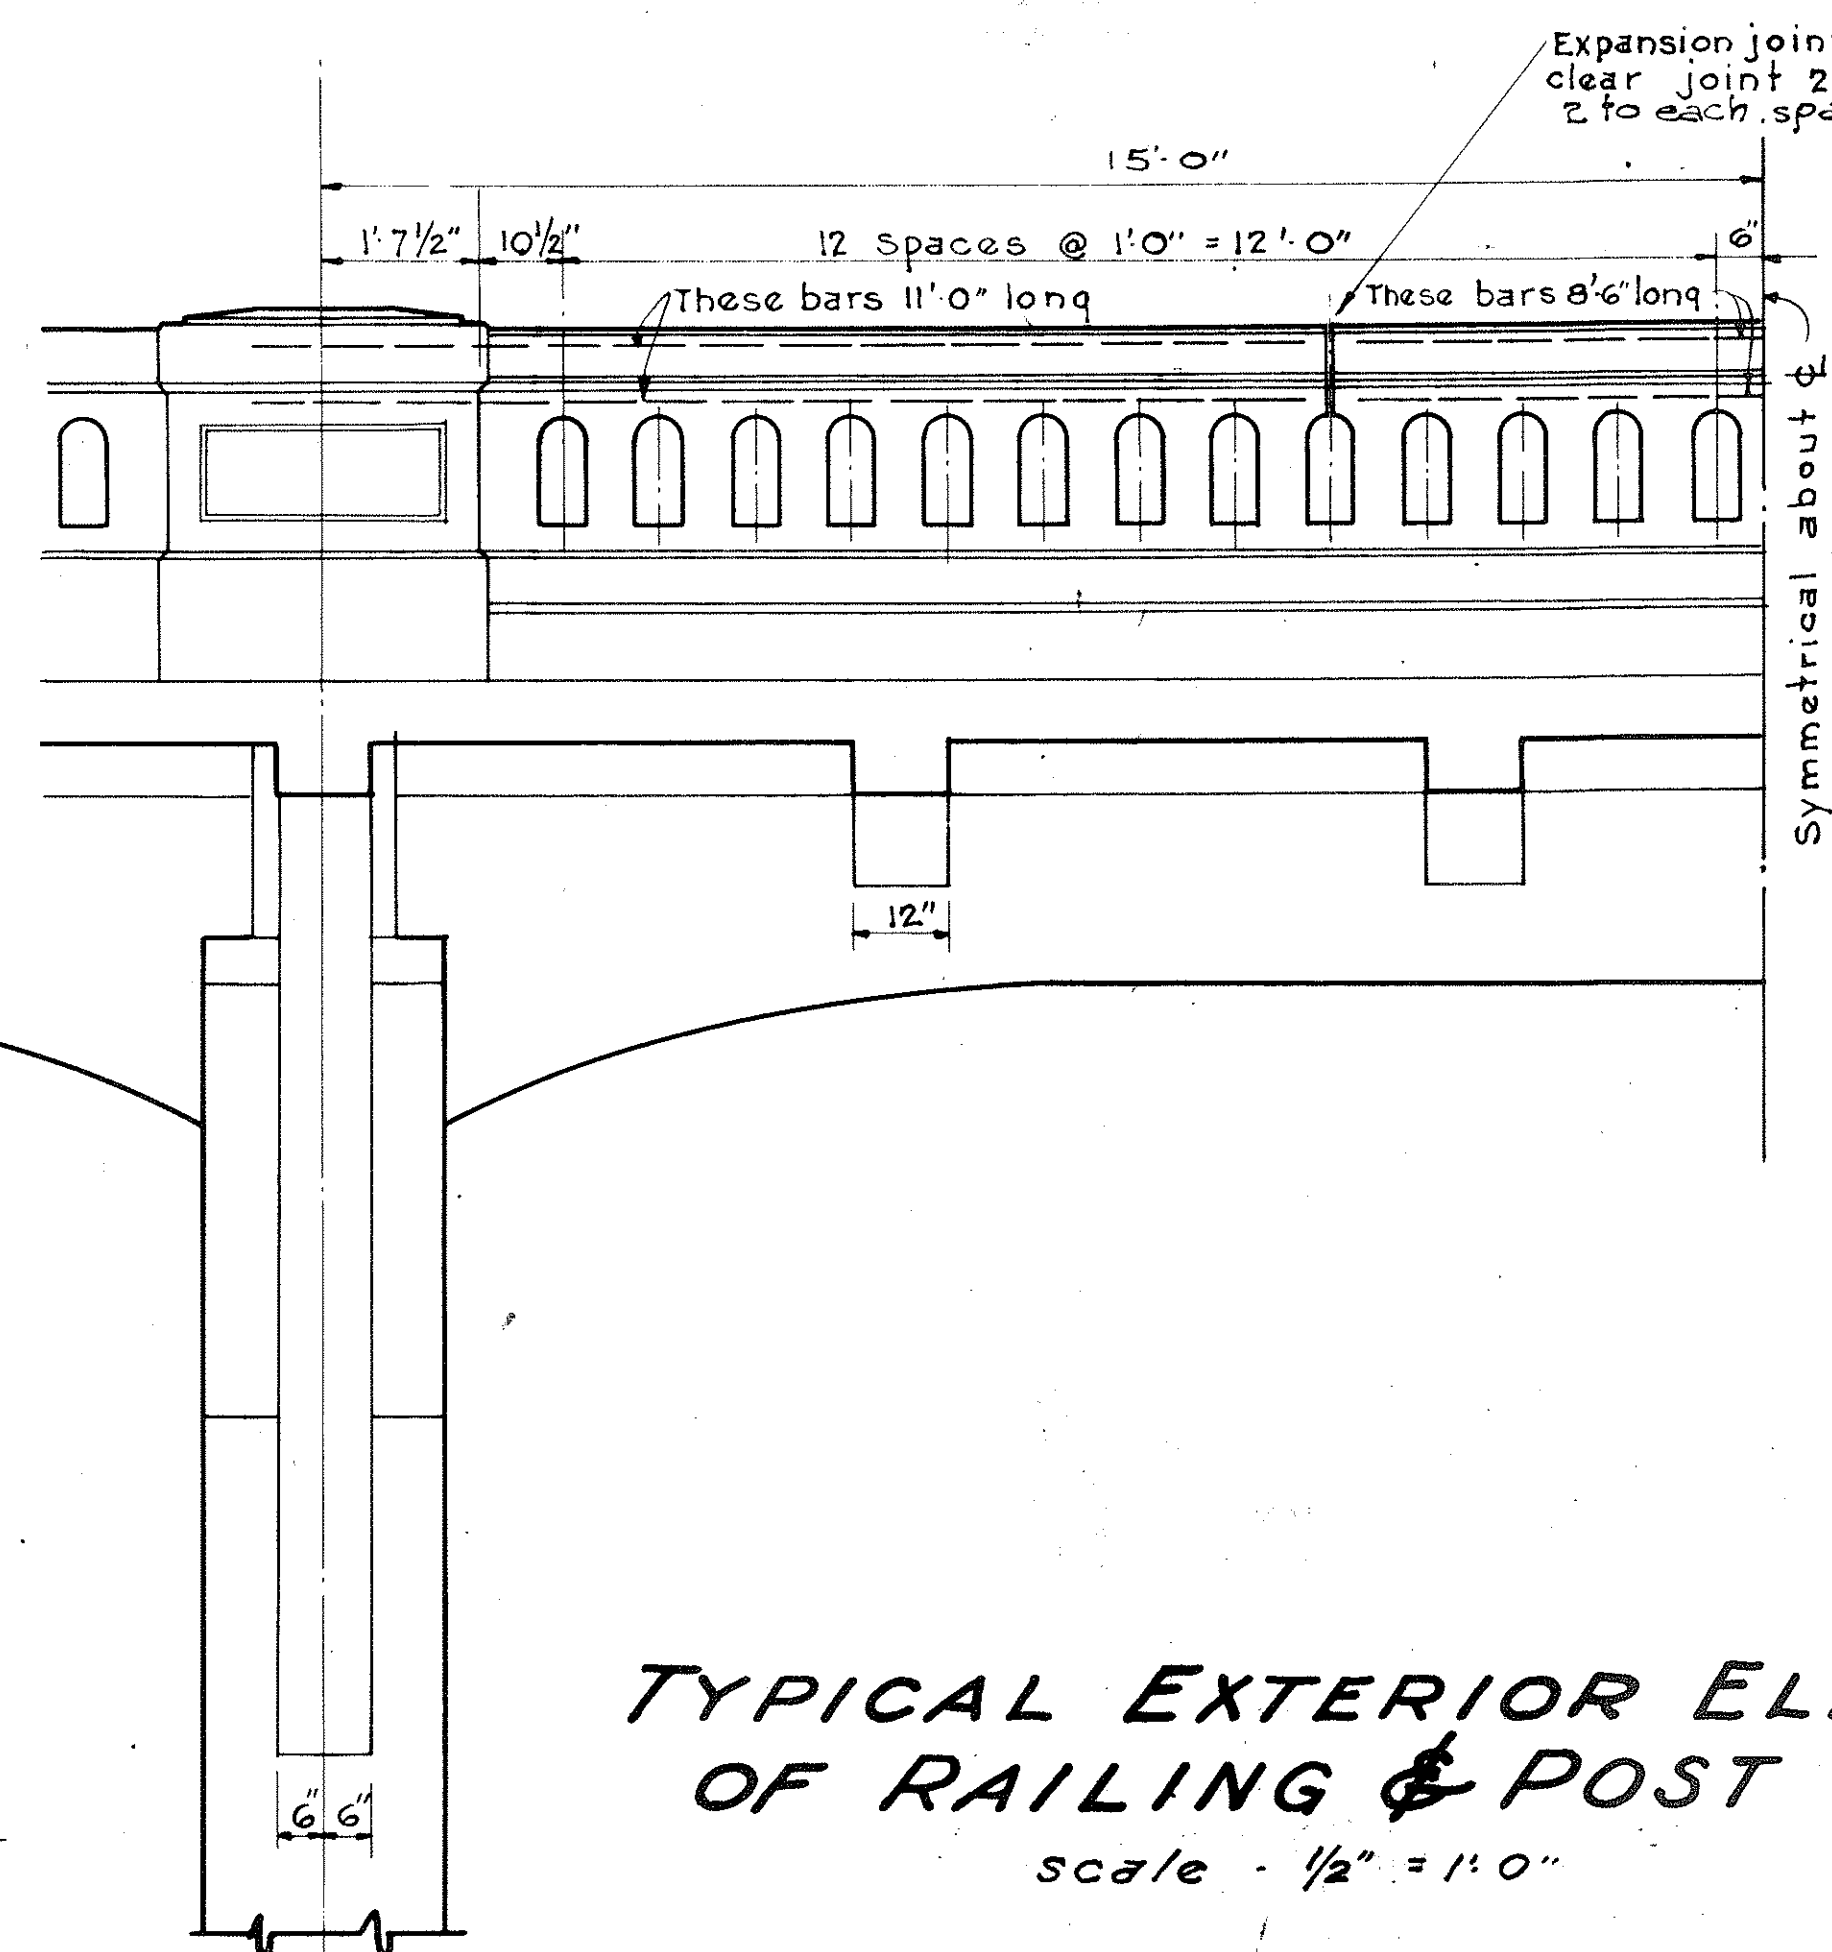

TYPICAL EXTERIOR ELEV.  
OF RAILING & POST  
scale -  $\frac{1}{2}" = 1'-0"$

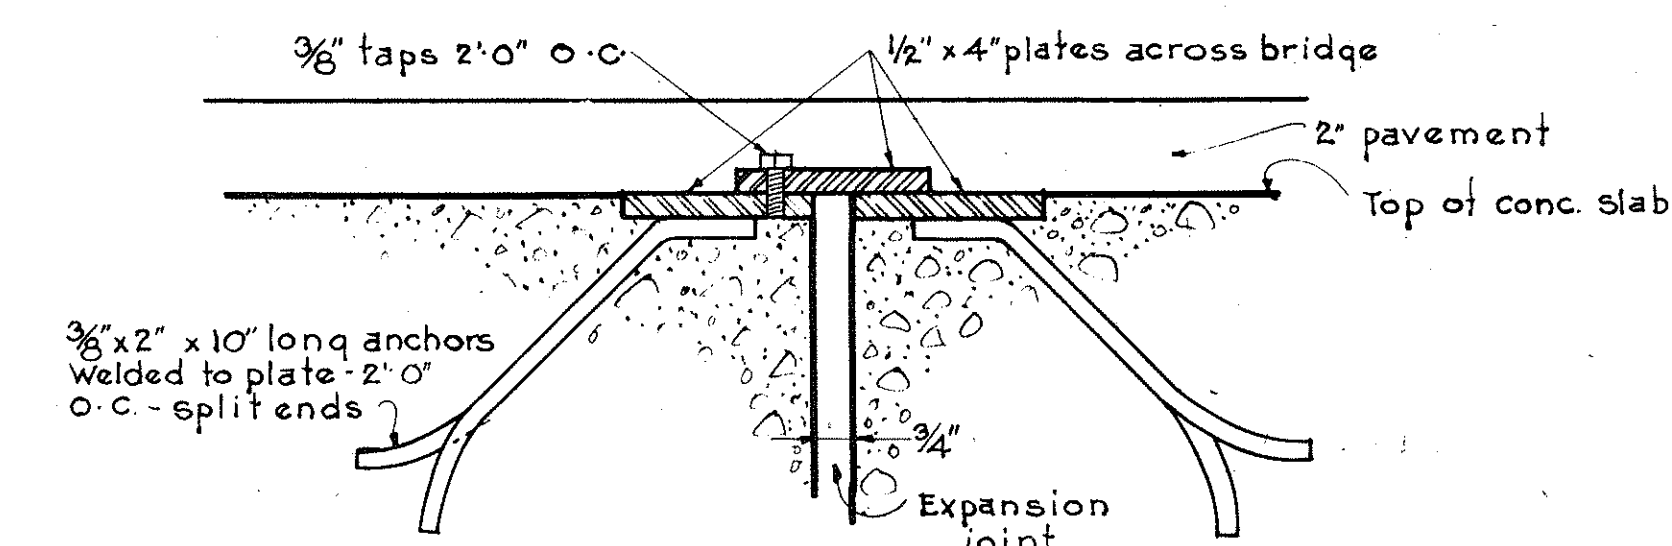

EXTERIOR ELEV. OF  
RAILING & POST AT  
EXPANSION JOINT  
Scale -  $\frac{1}{2}" = 1'0"$





THIS DRAWING IS IN PART ORIGINAL  
CONTRACT PLANS OF EXISTING KIPAPA  
BRIDGE FOR INFORMATION AND  
GUIDANCE TO REPAIR WORKS


PROJ. NO. HWY-0-01-72      DATE NOV, 1971  
SHEET No. 2 OF 4 SHEETS

| FED. ROAD DIST. NO. | STATE | PROJ. NO.  | FISCAL YEAR | SHEET NO. | TOTAL SHEETS |
|---------------------|-------|------------|-------------|-----------|--------------|
| HAWAII              | HAW.  | HWY-0-0172 | 1972        | 29        | 43           |

Hawaii Hwy E-7-F 1992 15A 16  
 This sheet constitutes a revision of sheets #126515 & #126519. It supersedes the corresponding details on these sheets.





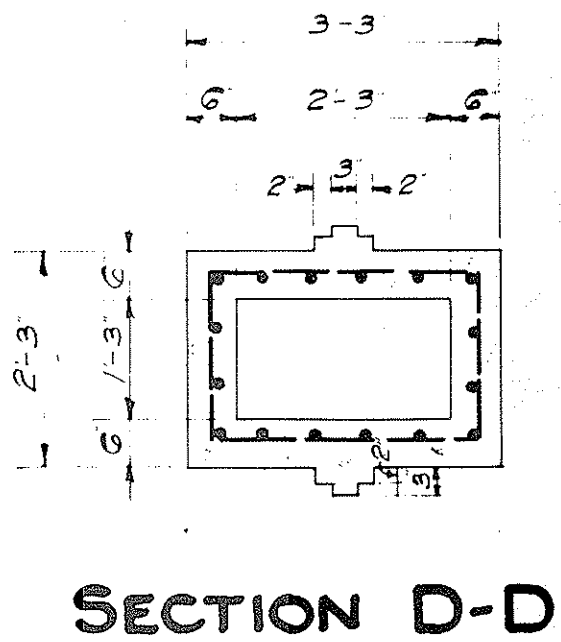
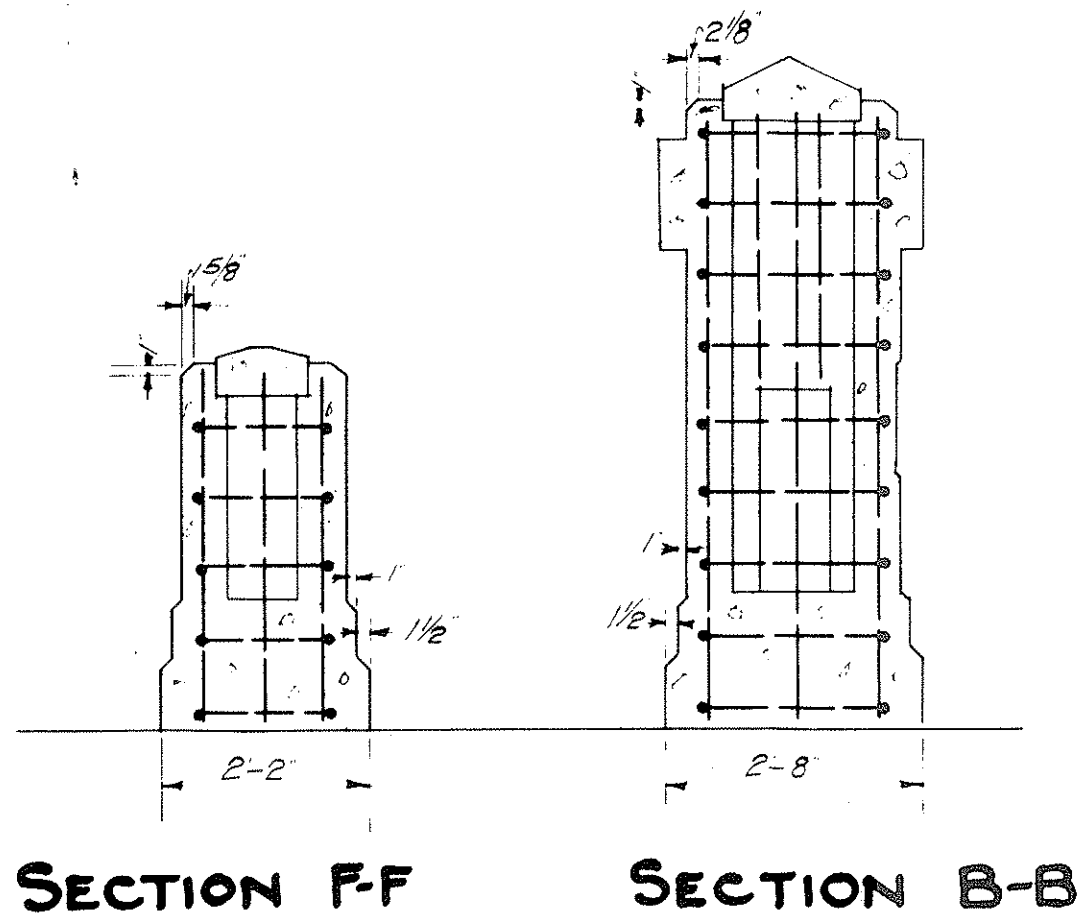


NOTE: All bars 3/8" Horizontals 9' o.c. Verticals spaced as shown.

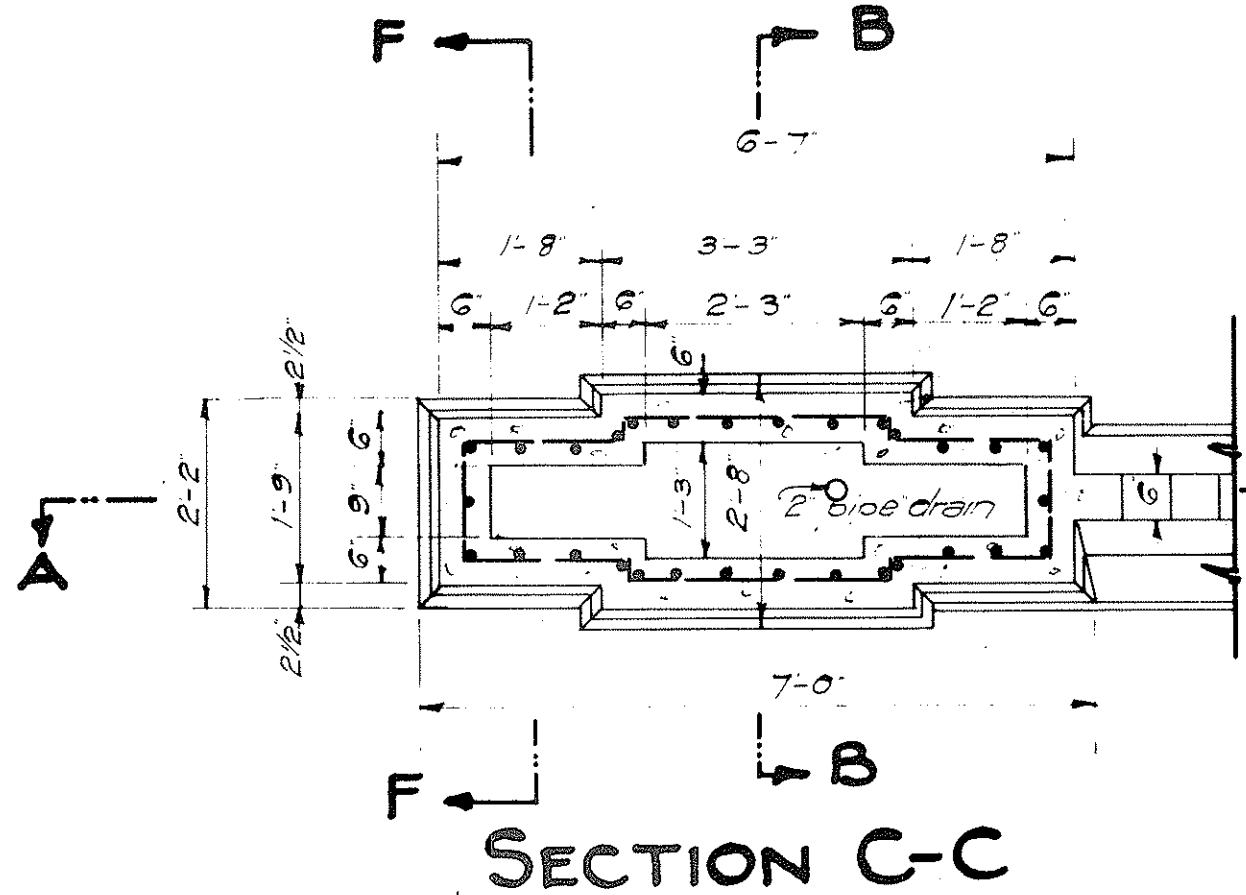

QUANTITIES FOR ONE END POST

|                   | conc (Cu Yds) | Steel (Lbs) |
|-------------------|---------------|-------------|
| Revised End Post  | 2.53          | 114         |
| Original End Post | 120           | 47          |
| Difference        | 133           | 67          |

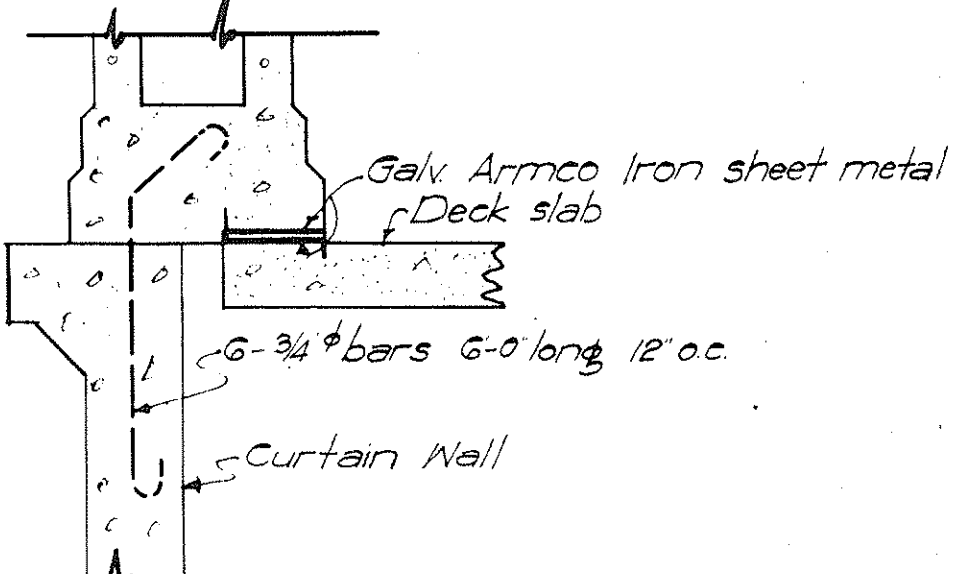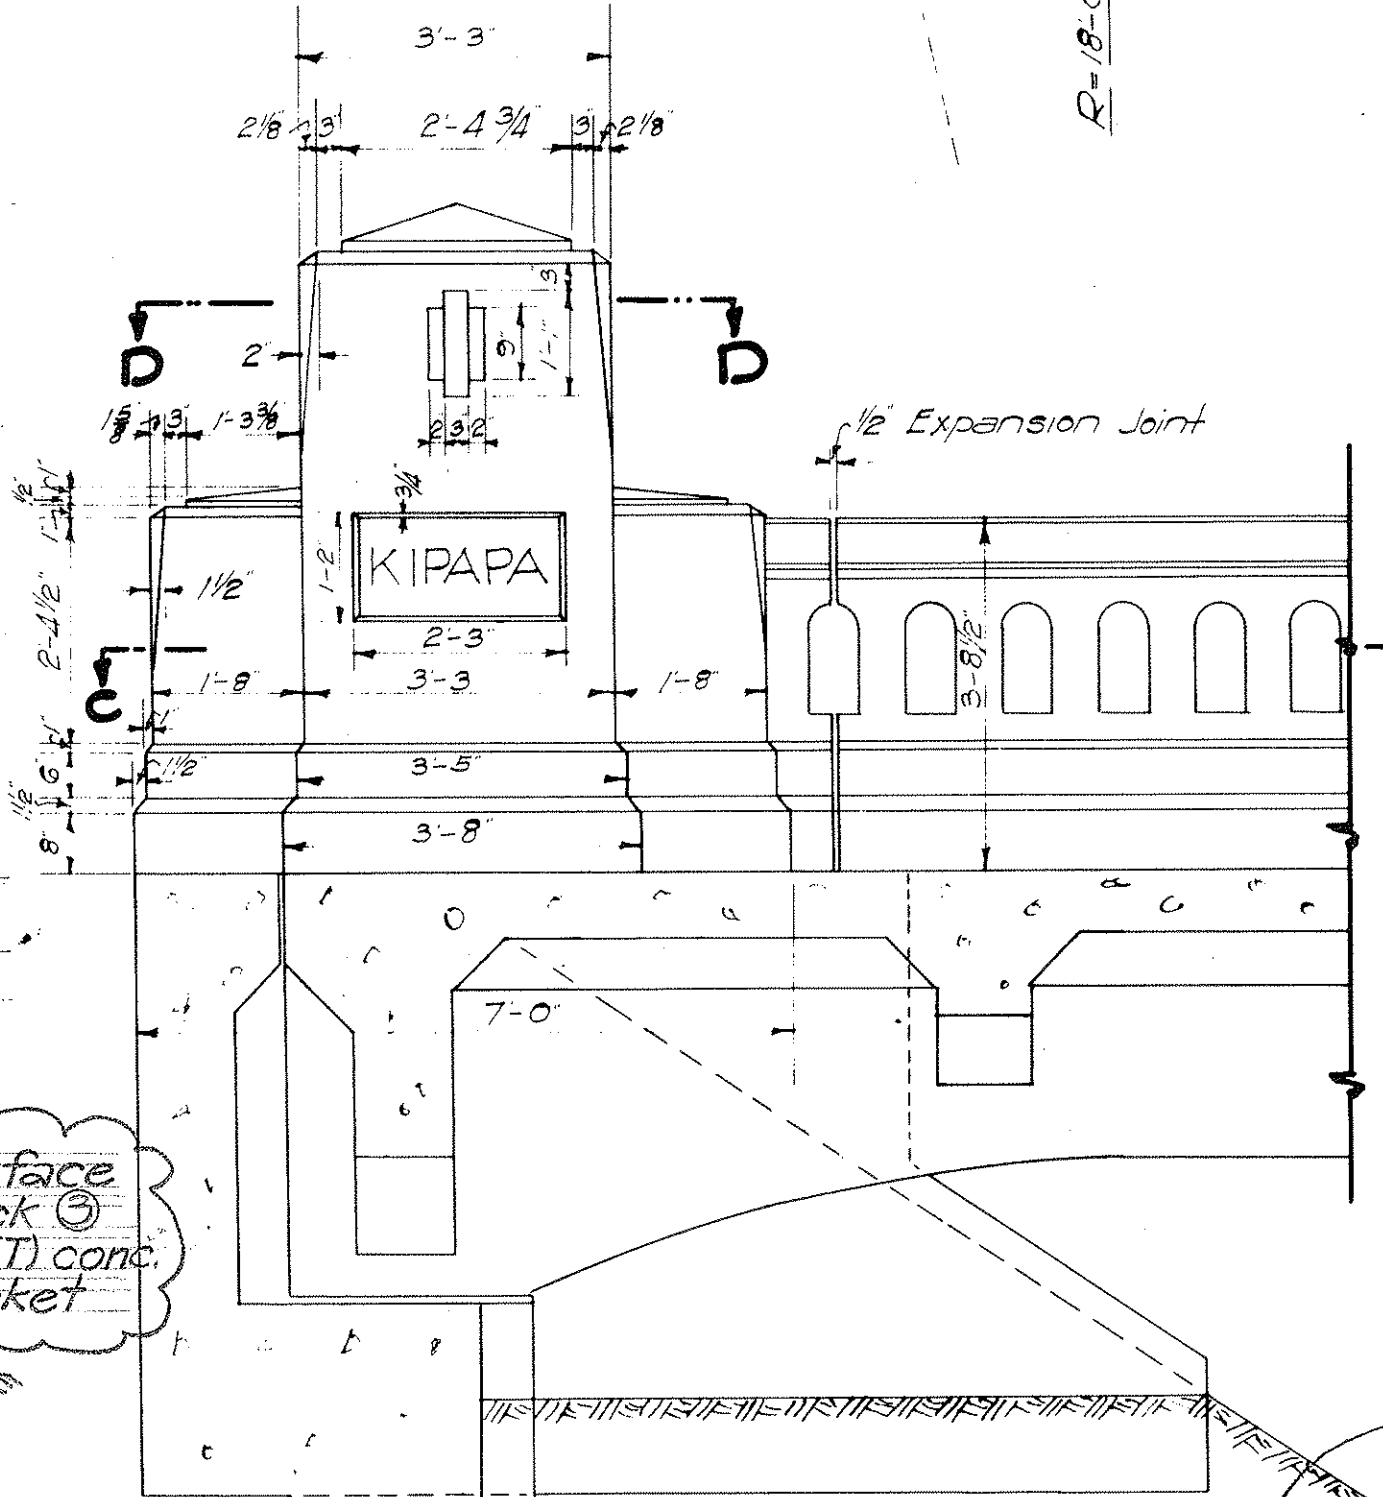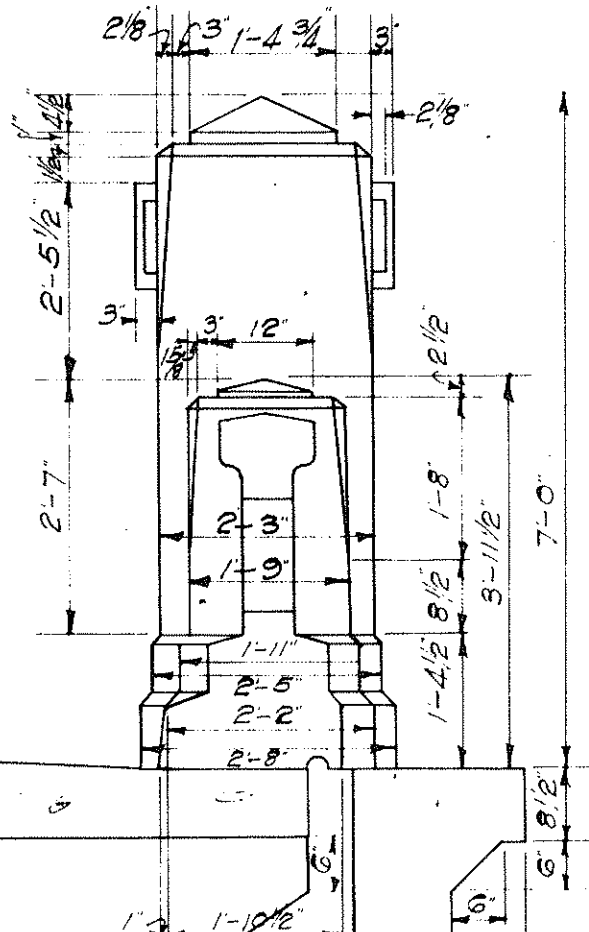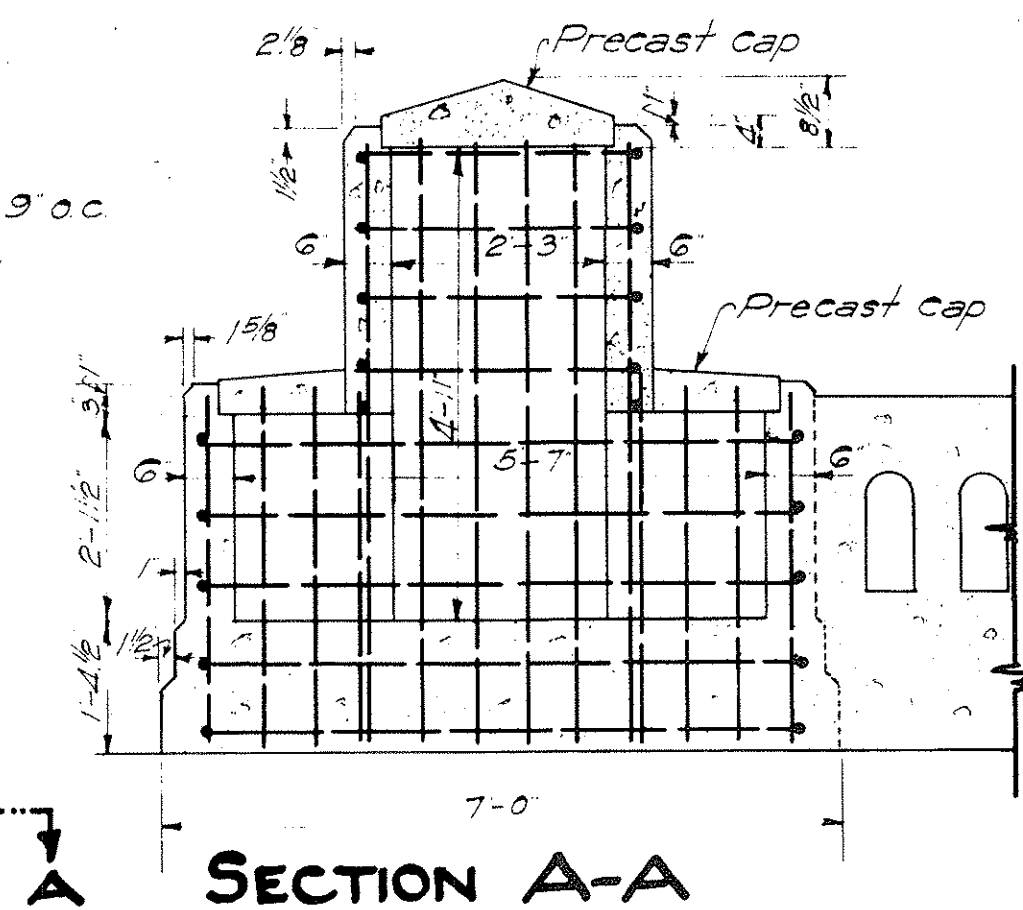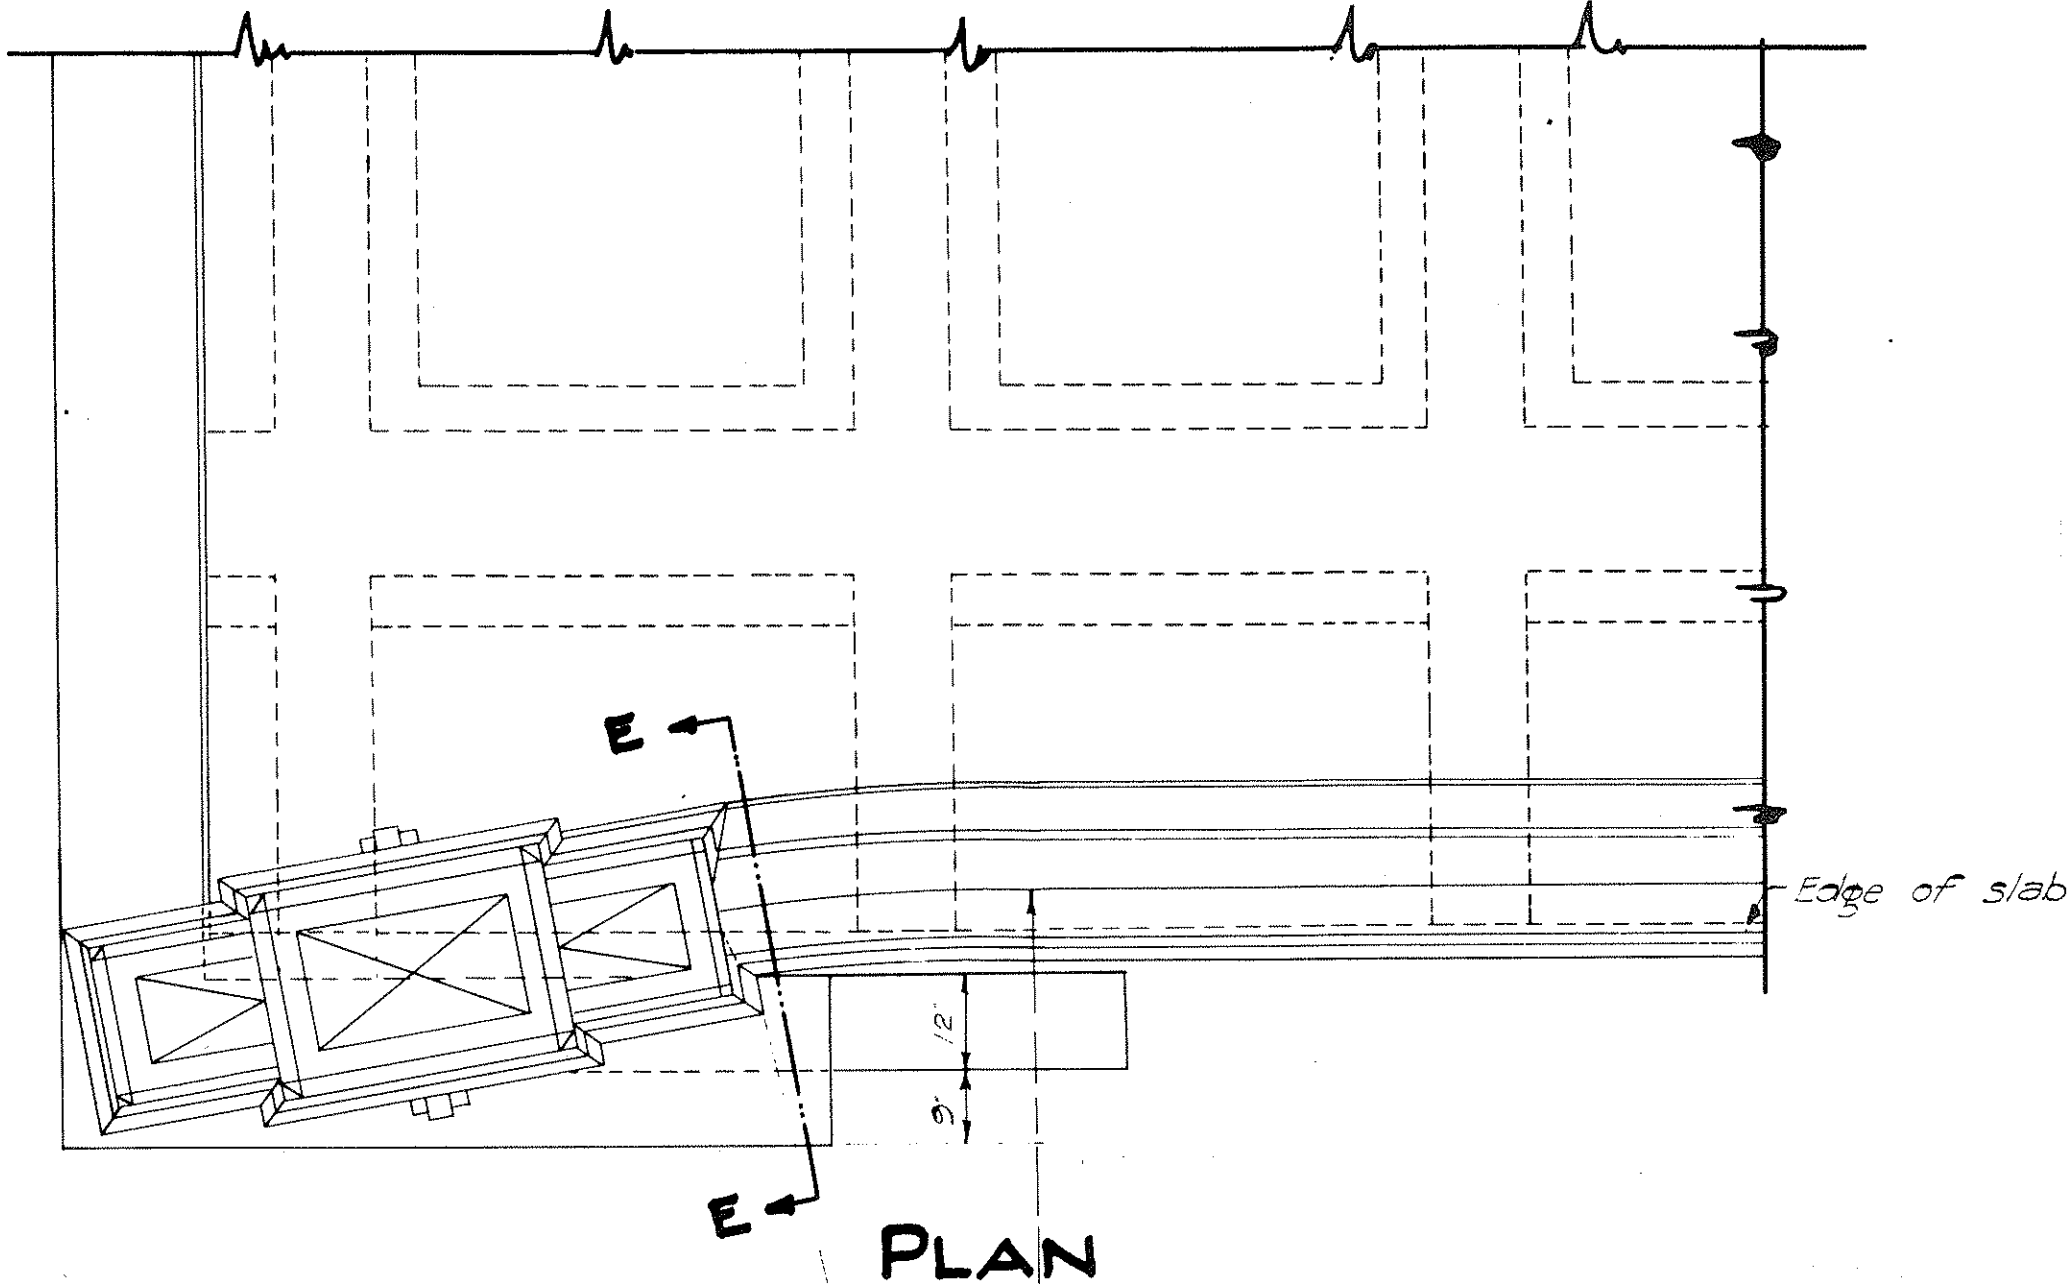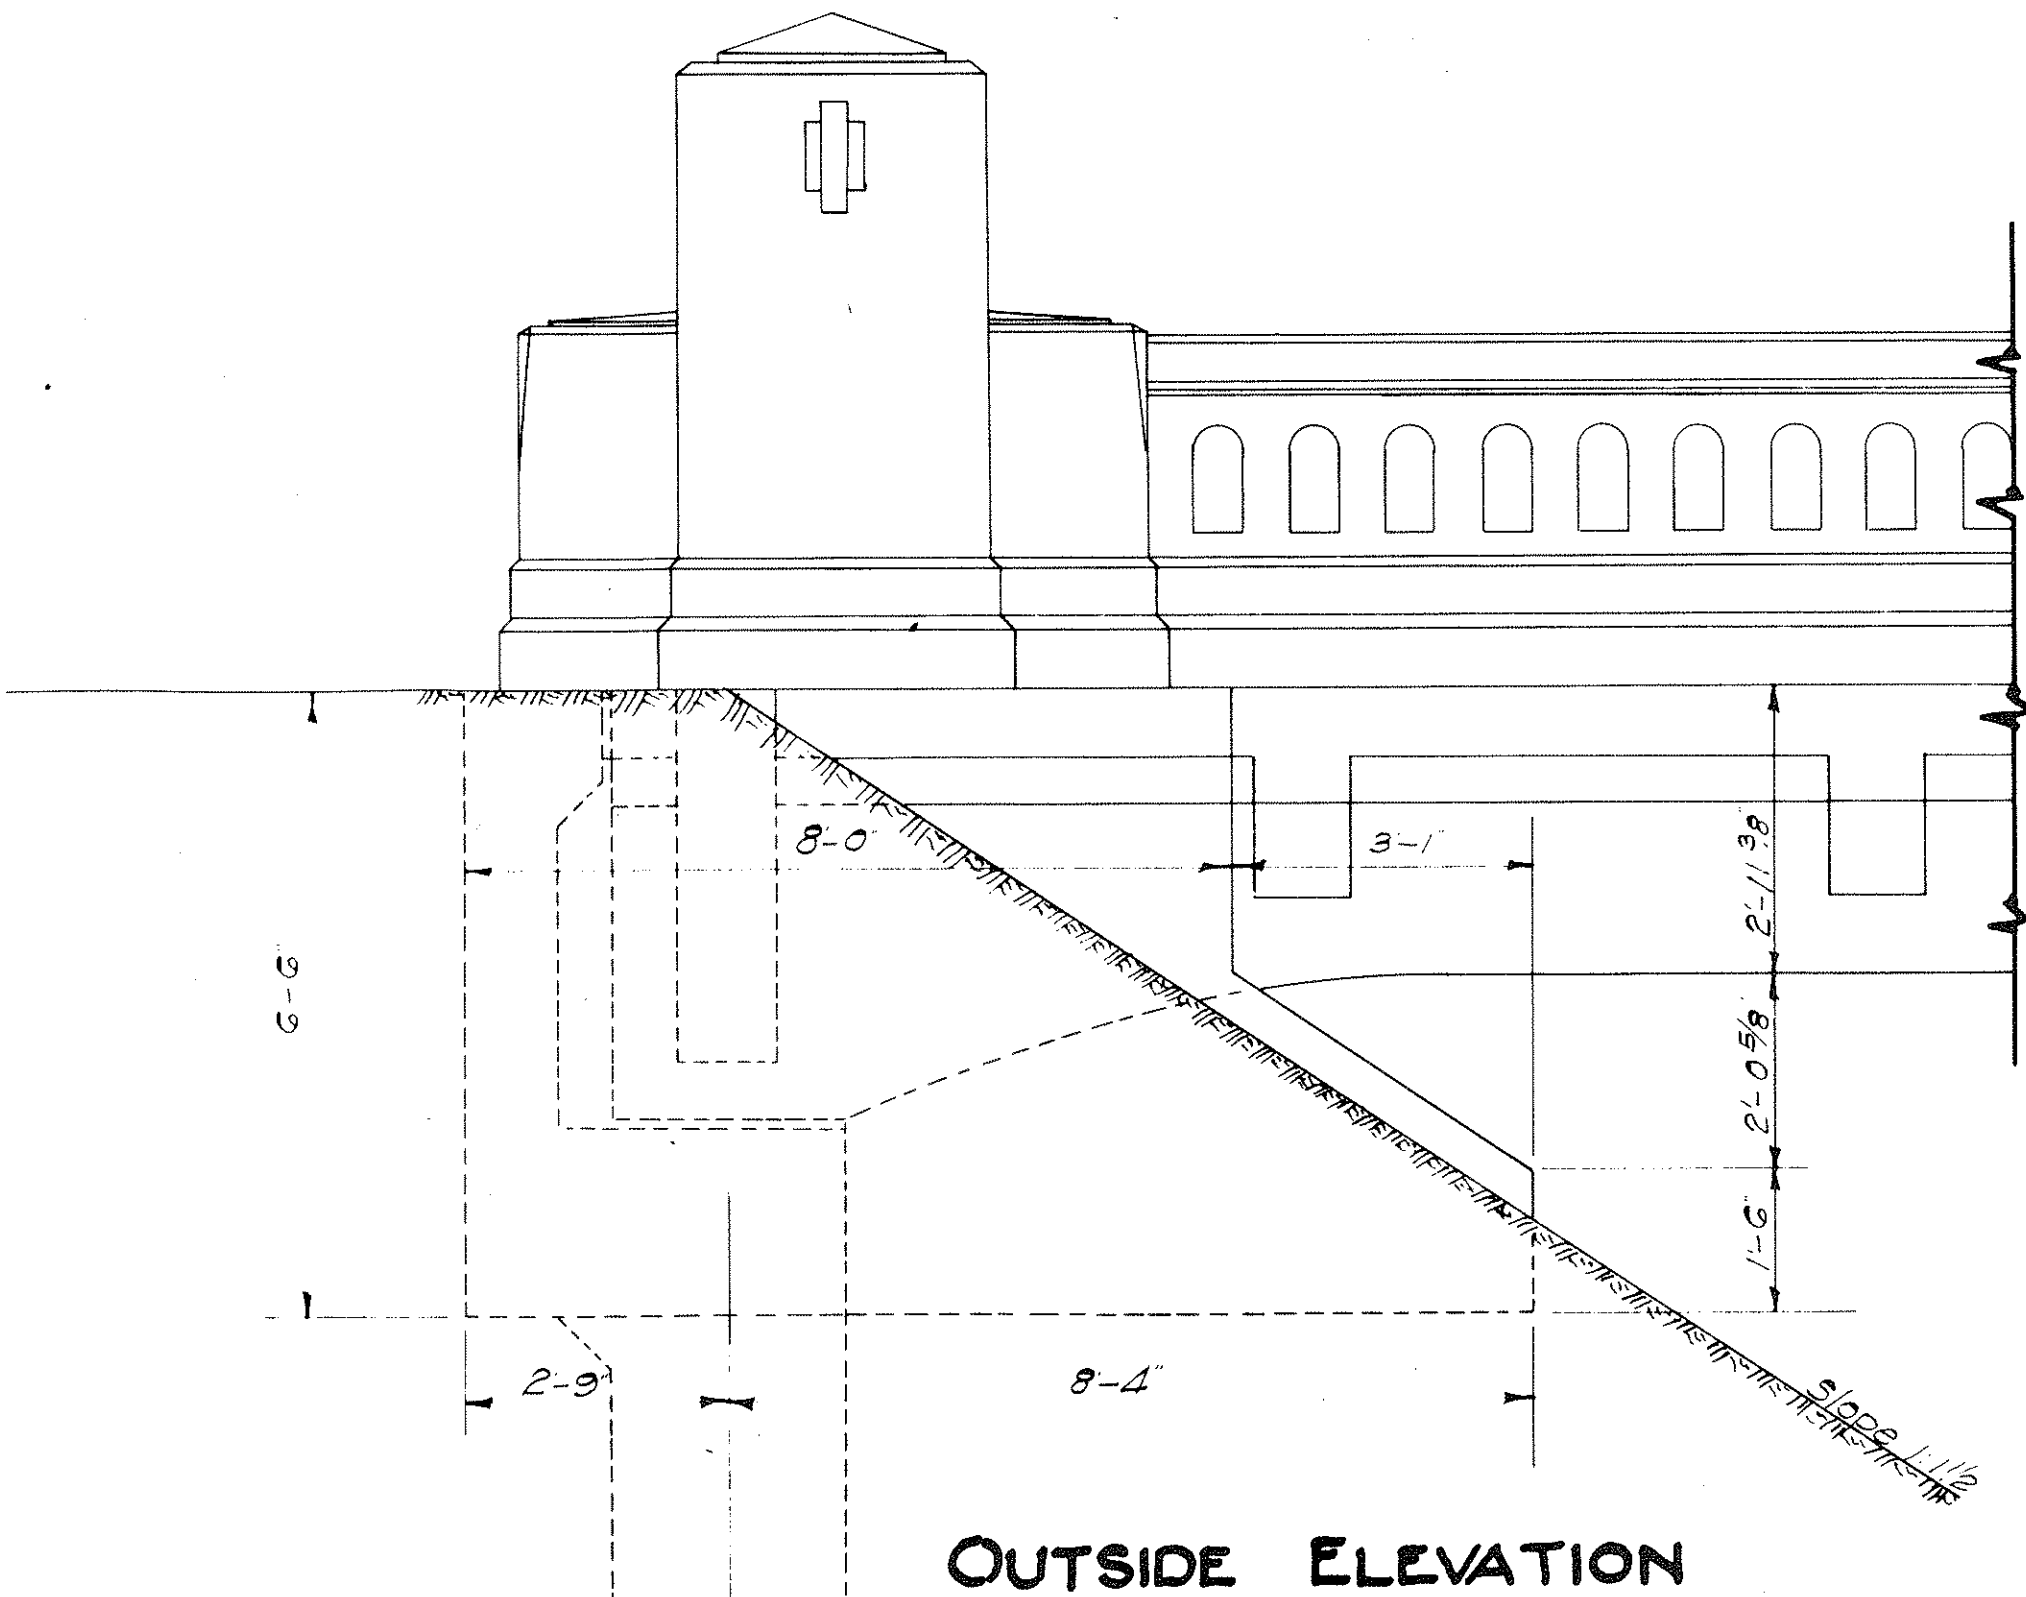

DETAIL SHOWING ANCHORAGE OF END POST TO CURTAIN WALL & EXPANSION JOINT BETWEEN END POST & DECK

Compacted backfill to approx. plan grades

Surface crack (LEFT) conc. bracket

SECTION E-E  
 Surface crack (RIGHT) conc. bracket. Chip & patch.

Approx. existing ground at curtain wall - (LEFT)

INSIDE ELEVATION

THIS DRAWING IS IN PART ORIGINAL CONTRACT PLANS OF EXISTING KIPAPA BRIDGE FOR INFORMATION AND GUIDANCE TO REPAIR WORKS.

STATE OF HAWAII  
 DEPARTMENT OF TRANSPORTATION  
 HIGHWAYS DIVISION  
 REHABILITATION AND REPAIRS TO KIPAPA BRIDGE  
 PROJ. NO HWY-0-01-72 NOV., 1971  
 SHEET No. 3 OF 4 SHEETS

Architectural Design By B.C.D. 3/33  
 Engineering Design By W.R.B.  
 Traced by W.C.V.

