


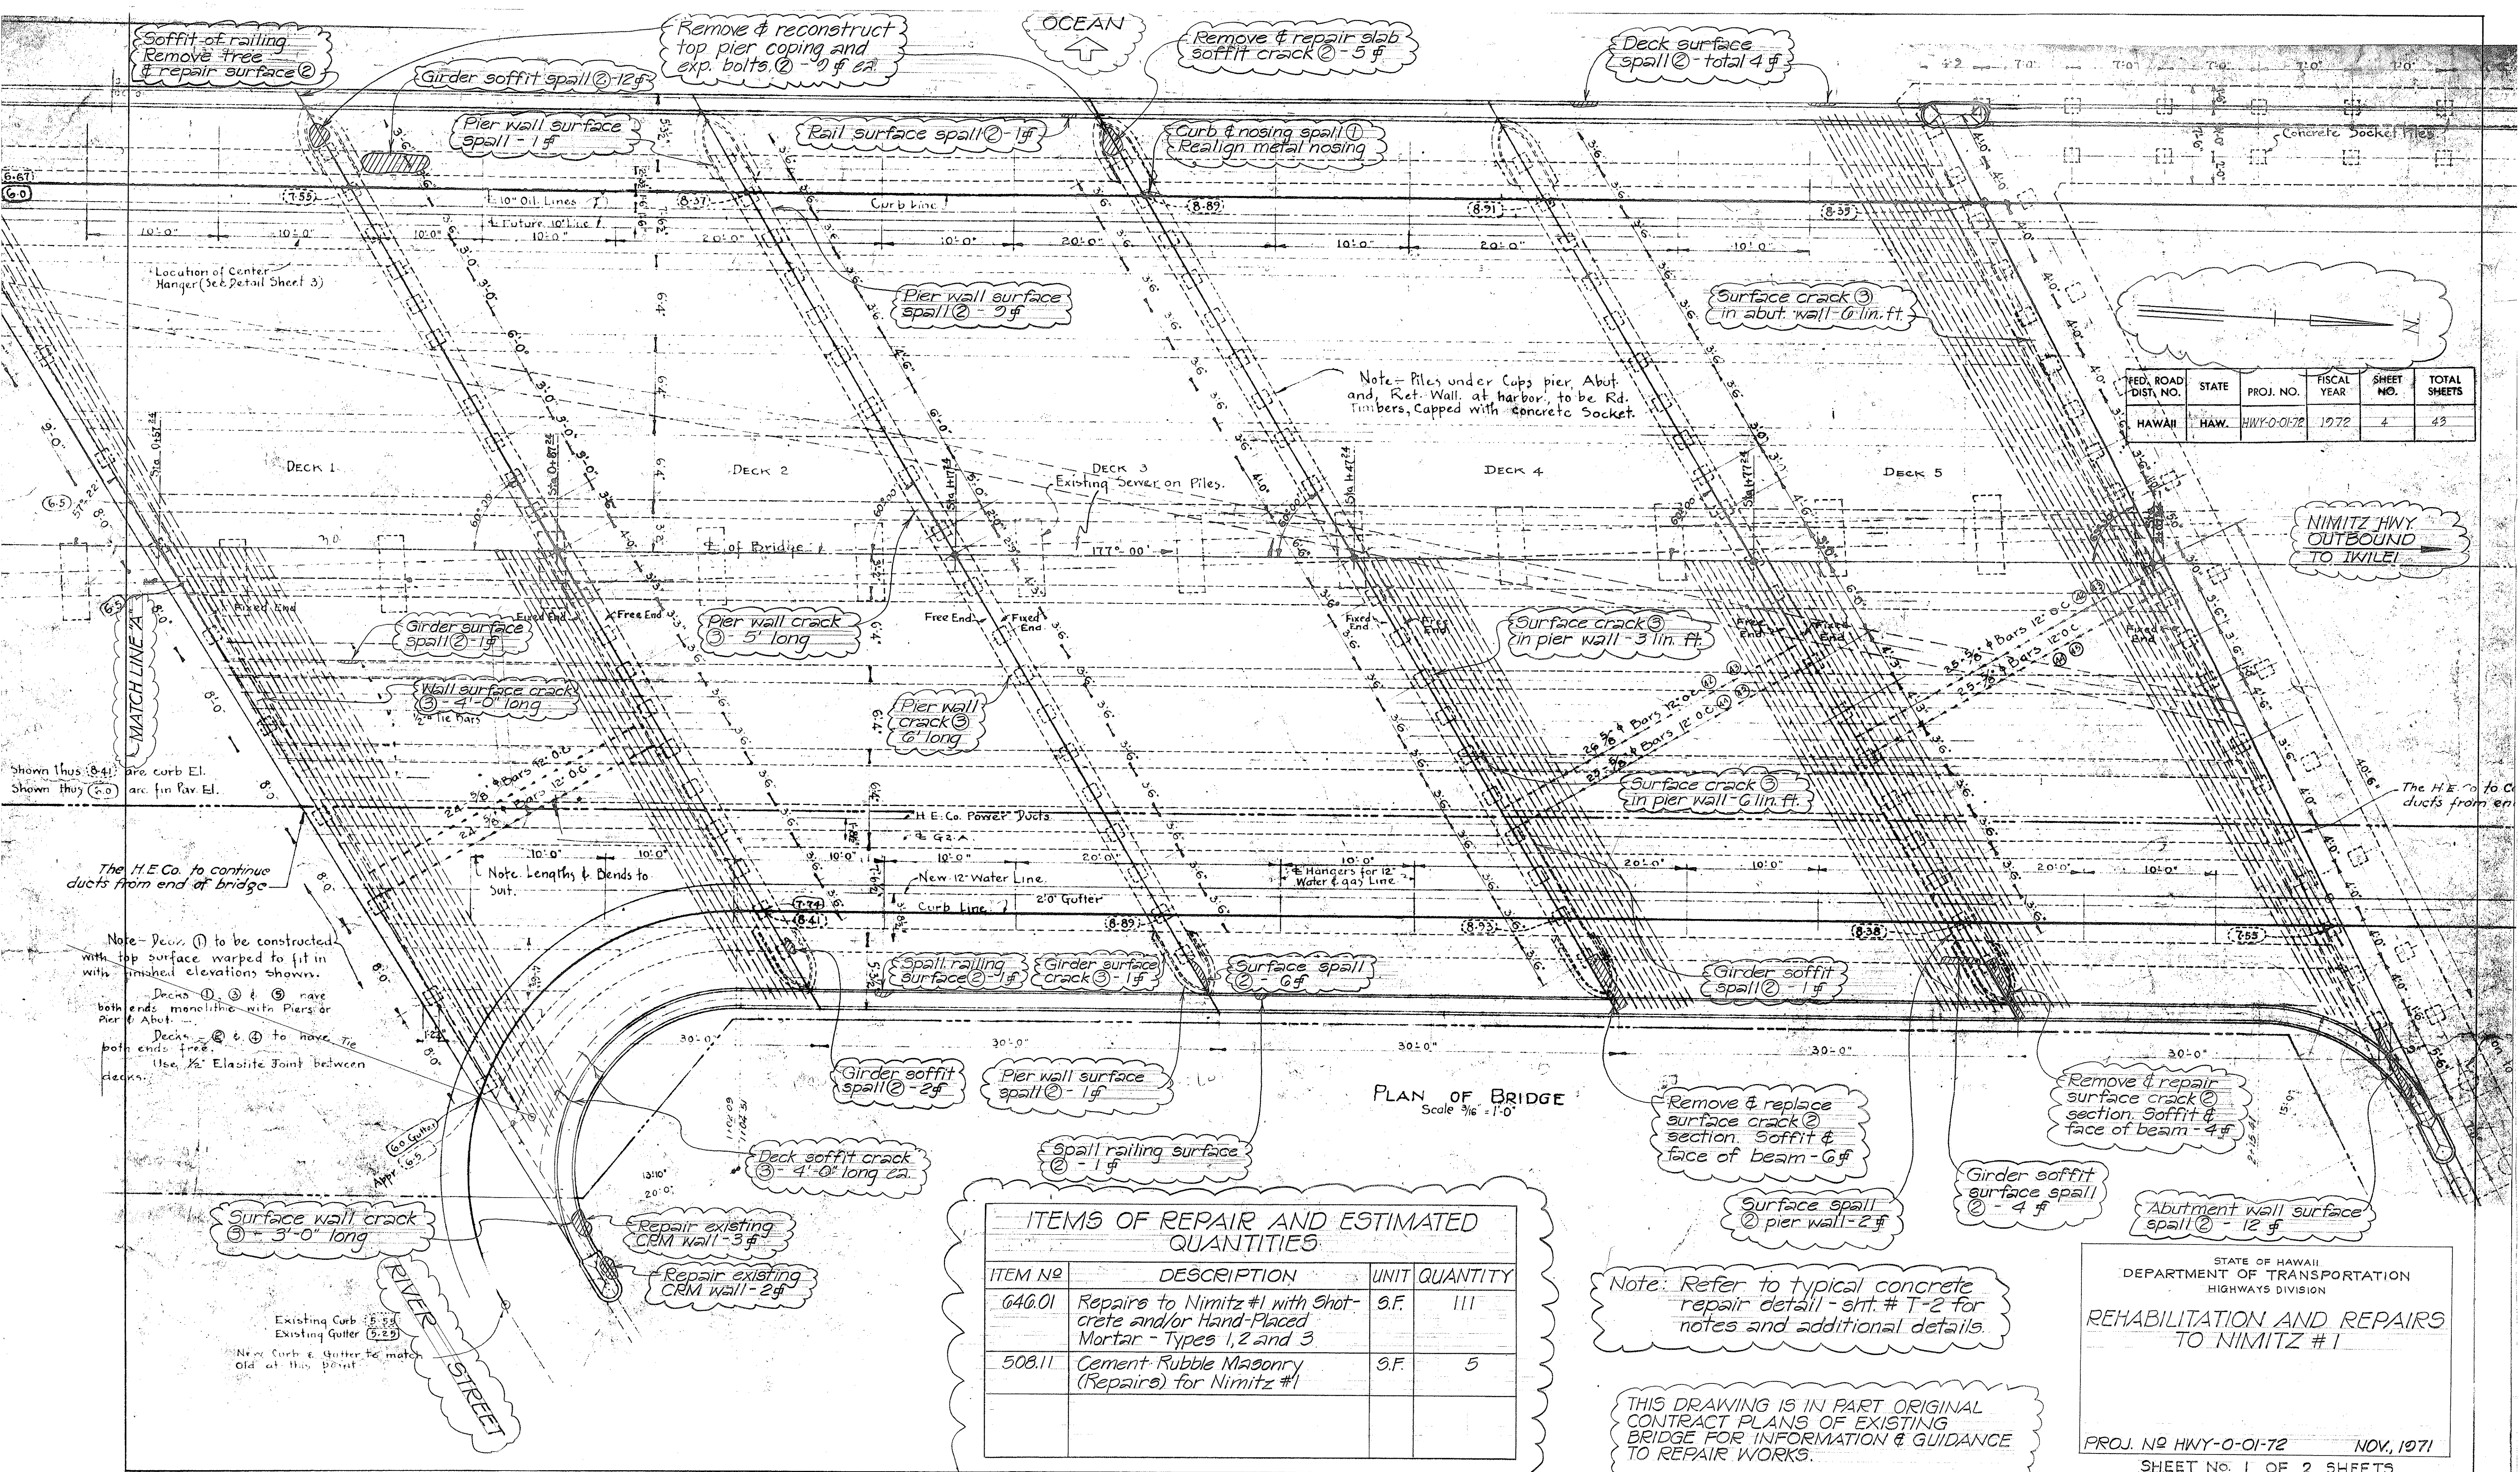

FED. ROAD DIST. NO.	STATE	PROJ. NO.	FISCAL YEAR	SHEET NO.	TOTAL SHEETS
HAWAII	HAW.	HWY-0-0172	1972	4	43



ITEMS OF REPAIR AND ESTIMATED QUANTITIES				
ITEM NO	DESCRIPTION	UNIT	QUANTITY	
646.01	Repairs to Nimitz #1 with Shotcrete and/or Hand-Placed Mortar - Types 1, 2 and 3	S.F.	111	
508.11	Cement-Rubble Masonry (Repairs) for Nimitz #1	S.F.	5	

STATE OF HAWAII
DEPARTMENT OF TRANSPORTATION
HIGHWAYS DIVISION

REHABILITATION AND REPAIRS
TO NIMITZ #1

PROJ. NO HWY-0-01-72 NOV, 1971
SHEET No. 1 OF 2 SHEETS

FED. ROAD DIST. NO.	STATE	PROJ. NO.	FISCAL YEAR	SHEET NO.	TOTAL SHEETS
HAWAII	HAW.	HWY-0-01-72	1972	5	43

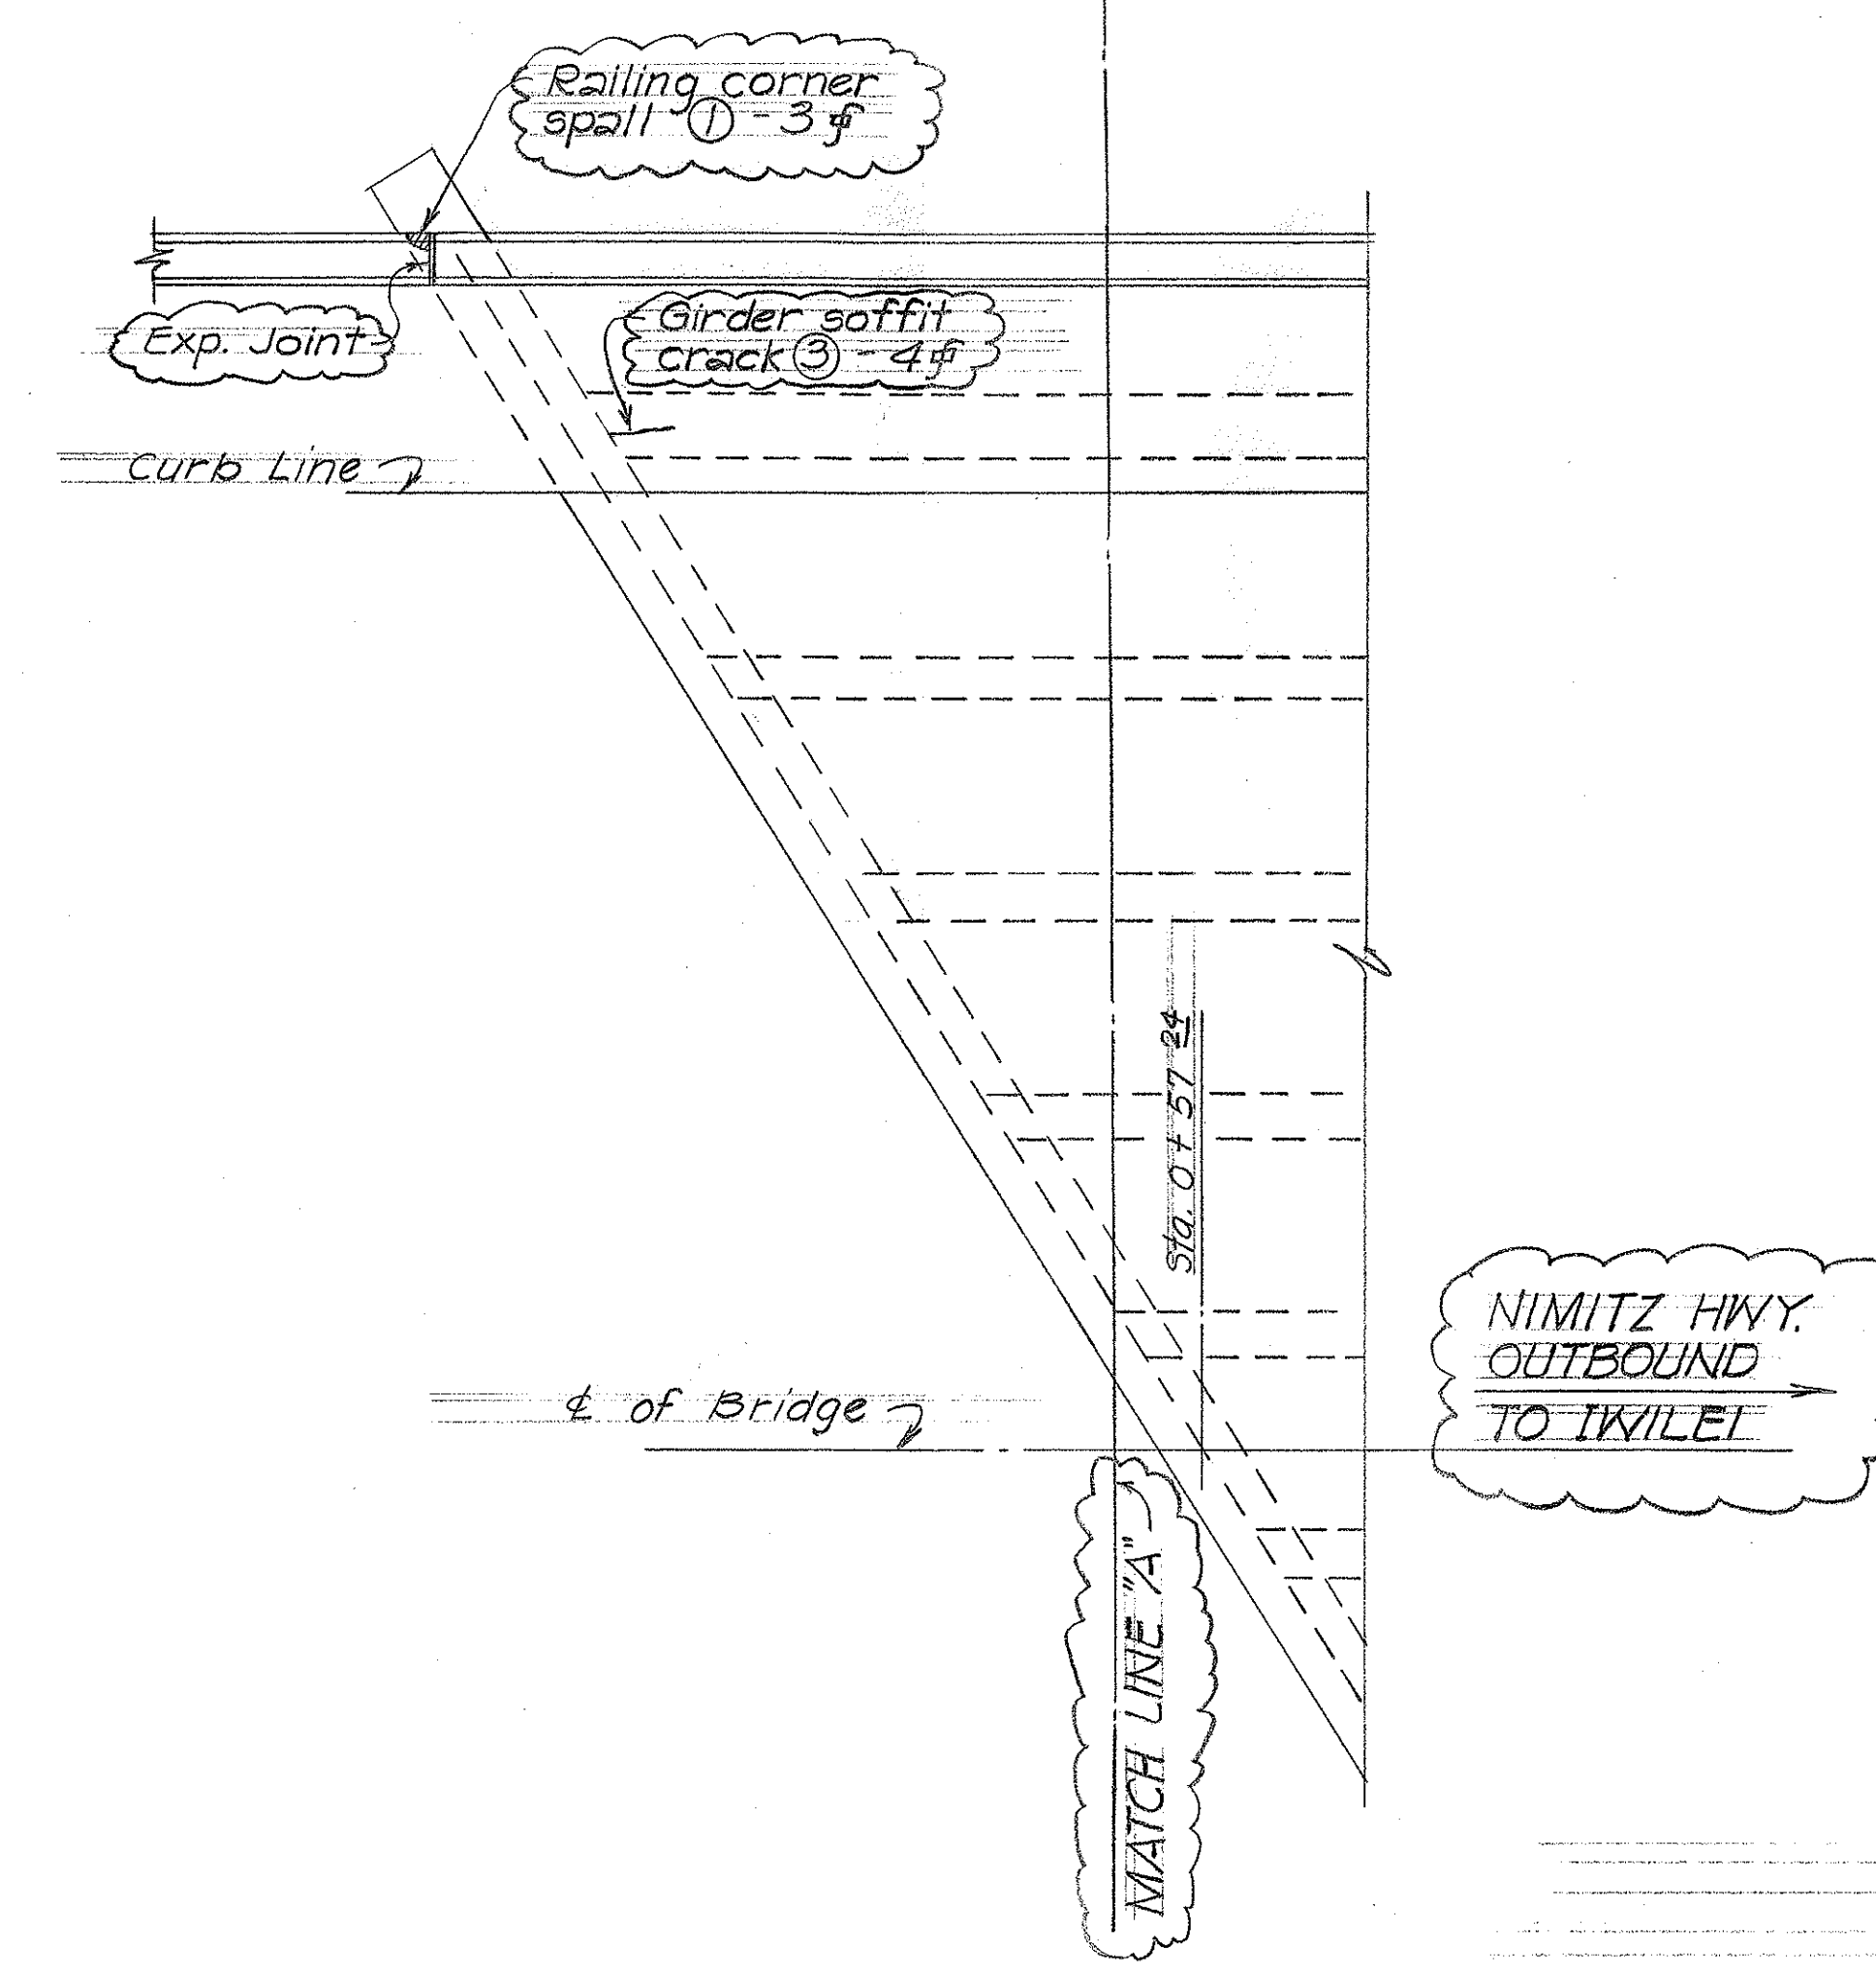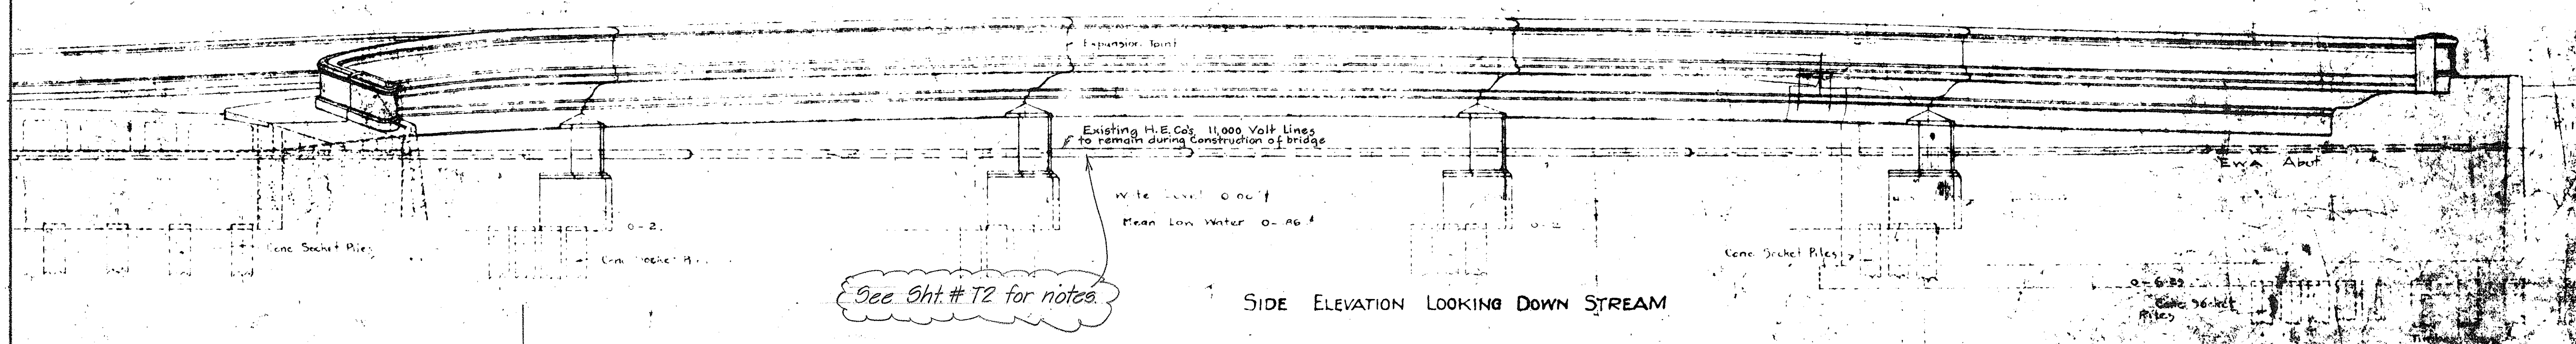

THIS DRAWING IS IN PART ORIGINAL CONTRACT PLANS OF EXISTING BRIDGE FOR INFORMATION & GUIDANCE TO REPAIR WORKS.

STATE OF HAWAII
DEPARTMENT OF TRANSPORTATION
HIGHWAYS DIVISION

REHABILITATION AND REPAIRS
TO NIMITZ #1

PROJ. No HWY-0-01-72 NOV, 1971
SHEET No. 2 OF 2 SHEETS