




LAYOUT PLAN - SLIP COVER NO. 2 - SCALE: 1/8" = 1'-0"

ITEMS OF REPAIR & ESTIMATED QUANTITIES

ITEM NO	DESCRIPTION	UNIT	QUANTITY
640.02	Repairs to Nimitz #2 with Shotcrete and/or Hand-Placed Mortar - Types 1, 2 & 3	S.F.	51
612.11	Grouted Rubble Paving (Repairs) for Nimitz #2	S.F.	100

Note: Refer to typical concrete repair detail - sht. # T-2 for notes and additional details.

THIS DRAWING IS IN PART ORIGINAL CONTRACT PLANS OF EXISTING BRIDGE FOR INFORMATION & GUIDANCE TO REPAIR WORKS.

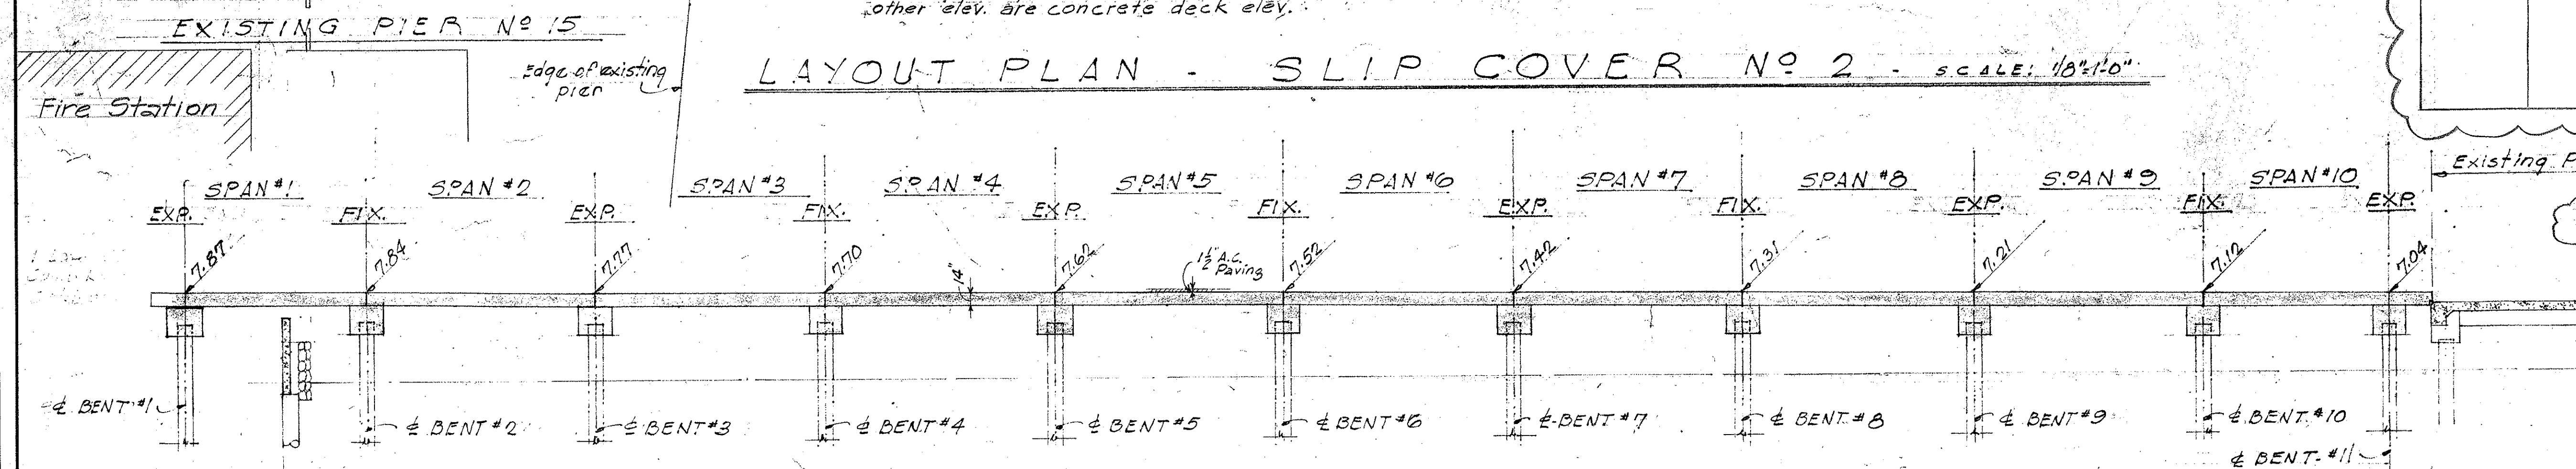

LONGITUDINAL SECTION ALONG & INBOUND LANE - SCALE: 1/8" = 1'-0"

NOTES

REFERENCE:

For Rail & railing post/sidewalk details, see sht. # 3
For Fixed & Expansion slab connection details see sht. # 12

GENERAL:

Provide expansion sleeve for conduit of highway lighting system at all expansion jt. For details see sht. # 3.

STATE OF HAWAII
DEPARTMENT OF TRANSPORTATION
HIGHWAYS DIVISION

REHABILITATION AND REPAIRS
TO 'ITZ #2


HONOLULU-PEARL I. 'BOR ROAD
QUEEN STREET SECTION SEPT. 1971

SHEET NO. 1 OF 3 SHEETS

DESIGNED BY: E. KING
DRAWN BY: E. KING
CHECKED BY: E. KING
DATE: 6-70

FED. ROAD DIST. NO.	STATE	FED. AID PROJ. NO.	FISCAL YEAR	SHEET NO.	TOTAL SHEETS
HAWAII	HAW.	HWY-0-01-72	1972	7	43

STATE	PROJ. NO.	FISCAL YEAR	SHEET NO.	TOTAL SHEETS	
HAWAII	HAW.	HWY-0-01-72	1972	7	43

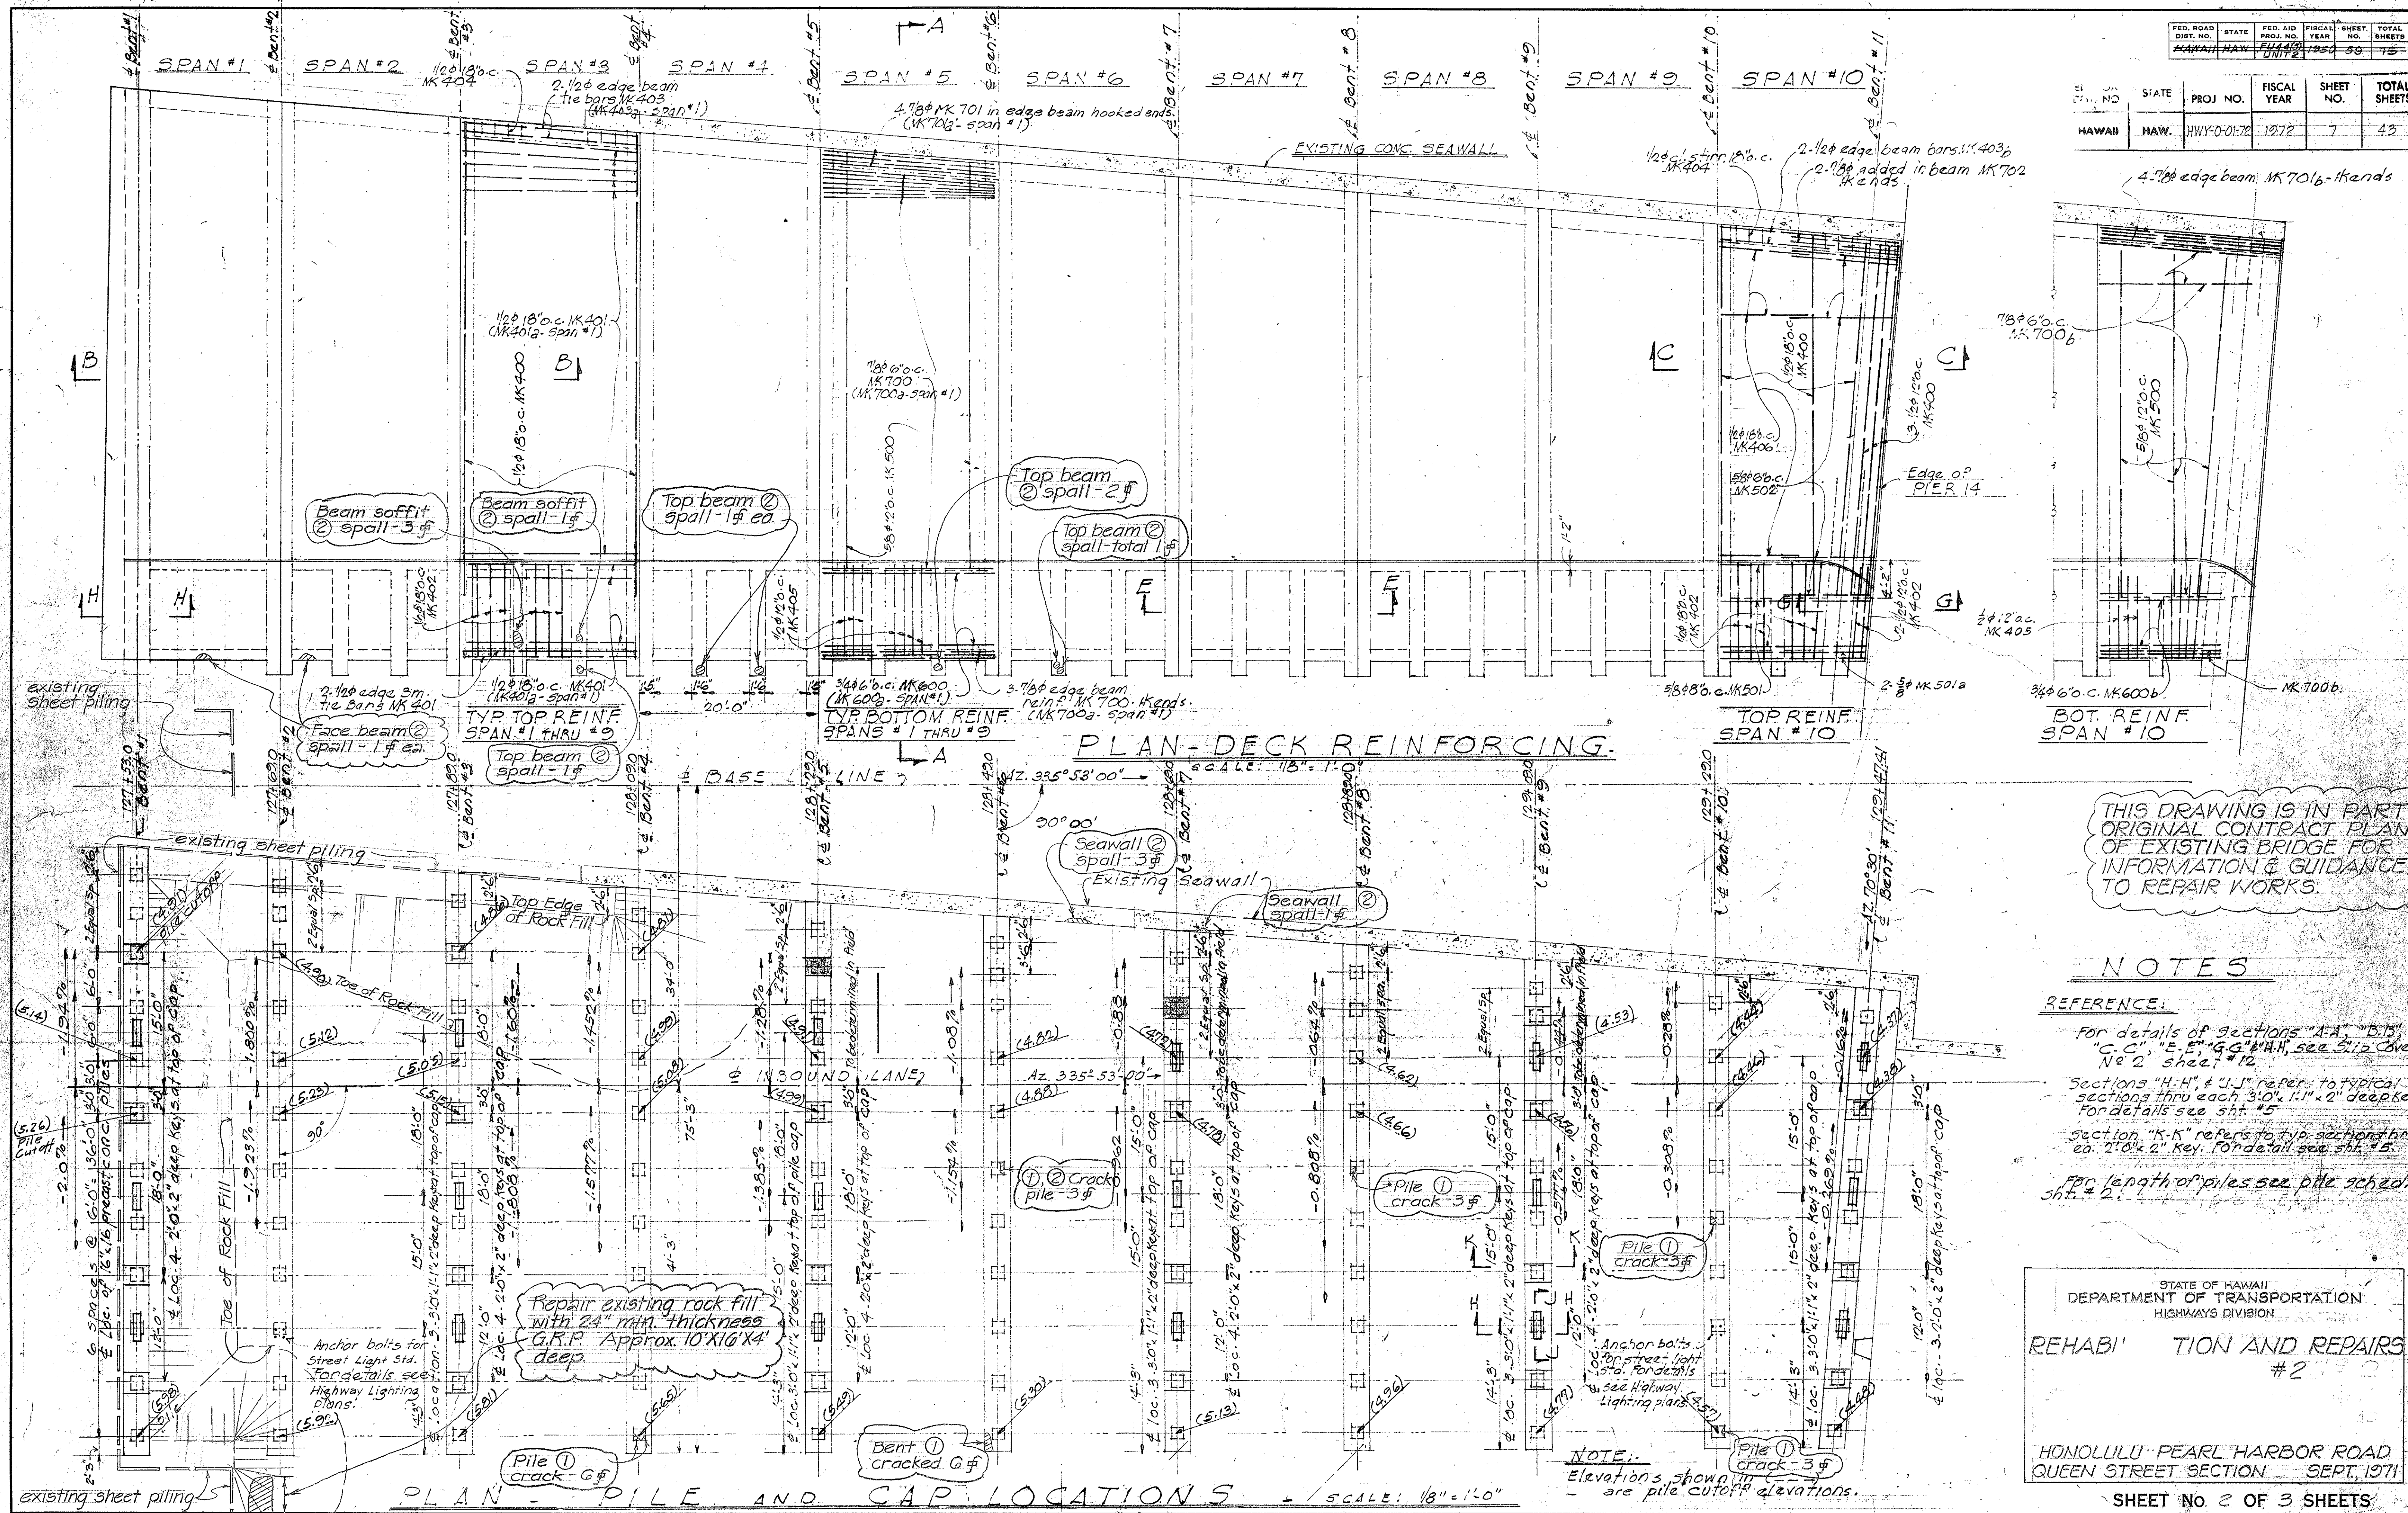

ORIGINAL
 PLAN
 DESIGNED BY
 DRAWN BY
 QUANTITIES CHECKED BY
 NOTE BOOK
 NO.

STATE OF HAWAII
 DEPARTMENT OF TRANSPORTATION
 HIGHWAYS DIVISION

REHABILITATION AND REPAIRS
 #2

HONOLULU-PEARL HARBOR ROAD
 QUEEN STREET SECTION
 SEPT. 1971

SHEET NO. 2 OF 3 SHEETS

