




FED. ROAD DIST. NO.	STATE	PROJ. NO.	FISCAL YEAR	SHEET NO.	TOTAL SHEETS
HAWAII	HAW.	HWY-0-01-72	1972	1	45

STATE OF HAWAII
DEPARTMENT OF TRANSPORTATION
HIGHWAYS DIVISION
HONOLULU, HAWAII
"AS BUILT PLAN"
REPAIRS TO HIGHWAY BRIDGES
VARIOUS LOCATIONS
PROJECT NO. HWY-0-01-72
ISLAND OF OAHU

(7) WOODEN BRIDGES
ON FARRINGTON HIGHWAY
MAUKA

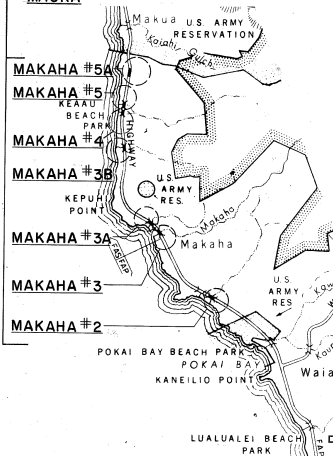

SHEET NO.	DESCRIPTION
1	TITLE SHEET
2-3	TYPICAL DETAILS AND NOTES
4-5	NIMITZ #1
6-8	NIMITZ #2
9-11	NIMITZ #3
12-13	NIMITZ #4
14-17	MOANALUA BRIDGE (OUTBOUND)
18-20	MOANALUA BRIDGE (INBOUND)
21-23	AIEA INTERCHANGE STRUCT. #1
24-26	KALAUAO STREAM BRIDGE
27-30	KIPAPA BRIDGE
31	WAIKAKALAU BRIDGE
32-34	MAKAHA #2
35-36	MAKAHA #3
37-38	MAKAHA #3A
39-40	MAKAHA #3B
41	MAKAHA #4
42	MAKAHA #5
43	MAKAHA #5A

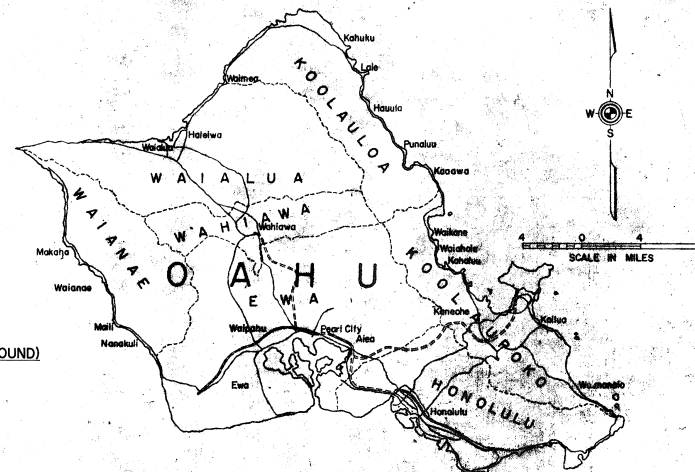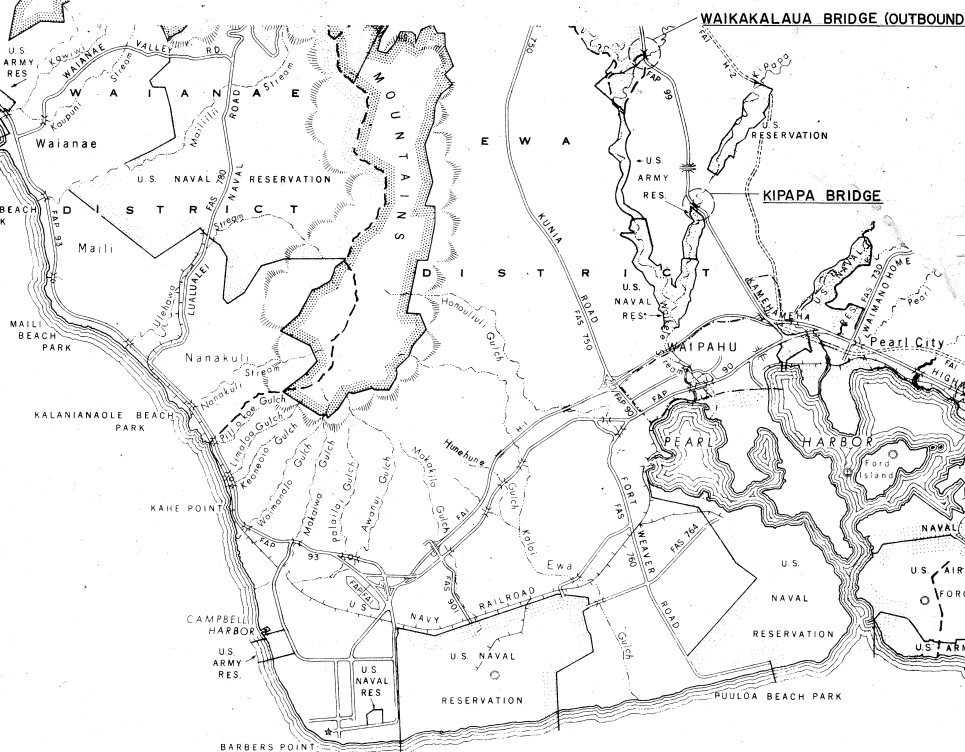

Federal Aid Interstate Projects Previously Constructed or Under Construction.

NOTE:

ALL CHANGES MADE DURING CONSTRUCTION HAVE BEEN INCORPORATED ON THESE PLANS EXCEPT CHANGES IN THE ORIGINAL THEORETICAL QUANTITIES.

David Jamashiro
PROJECT ENGINEER
DATE

KALAUAO STREAM BRIDGE (OUTBOUND)

AIEA INTERCHANGE
STRUCTURE NO. 1

MOANALUA BRIDGE (OUTBOUND)
ON KAMEHAMEHA HIGHWAY
MOANALUA BRIDGE (INBOUND)
ON KAMEHAMEHA HIGHWAY

NIMITZ NO. 1
NIMITZ NOS. 2, 3, 4

DEPARTMENT OF TRANSPORTATION
STATE OF HAWAII
APPROVED:
Franklin Lee
DIR. OF TRANSPORTATION
DATE 11/13/72