

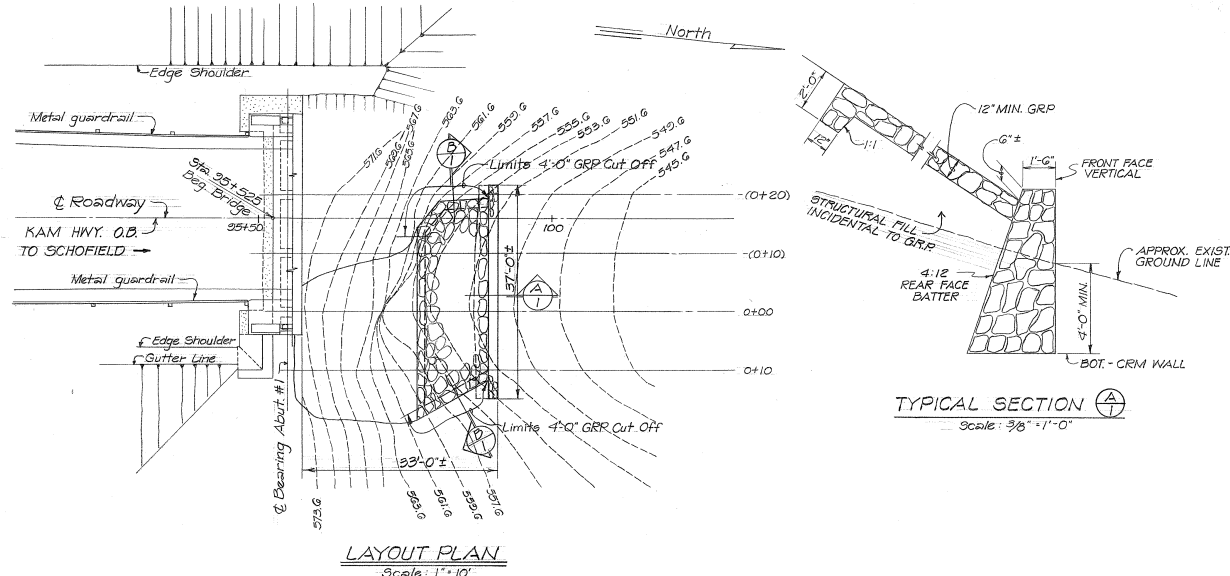
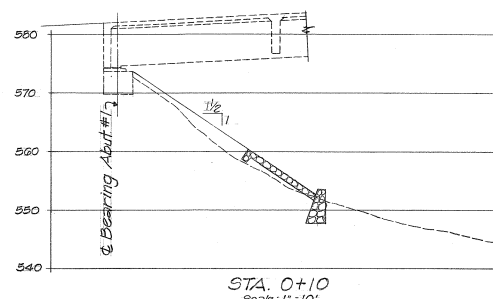
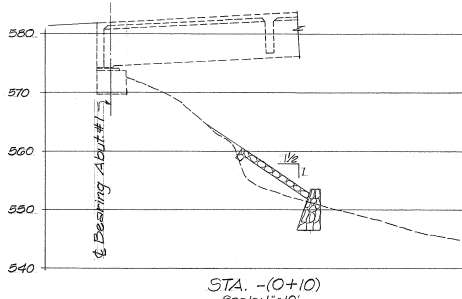


FED. ROAD DIST. NO.	STATE	PROJ. NO.	FISCAL YEAR	SHEET NO.	TOTAL SHEETS
HAWAII	HAW.	HWY-0-0172	1972	31	45

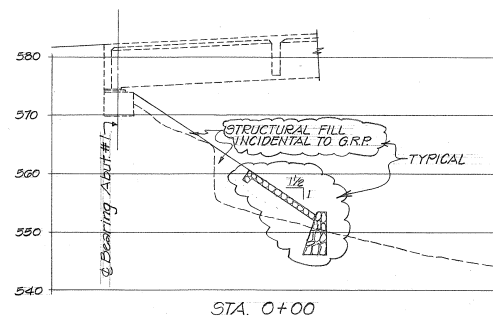

TYPICAL SECTION (A)
Scale: 3/8" = 1'-0"

TYPICAL SECTION (B)
Scale: 3/8" = 1'-0"

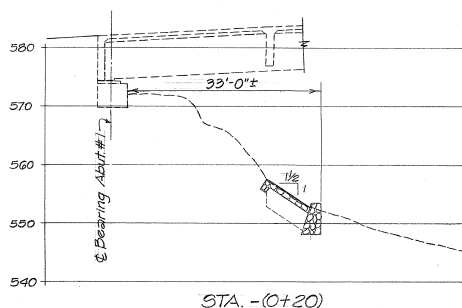

NOTE: STRUCTURAL BACKFILL FOR CRM SHALL BE INCIDENTAL TO STRUCTURAL EXCAVATION AND WILL NOT BE PAID FOR SEPARATELY.

ITEMS OF REPAIR AND ESTIMATED QUANTITIES			
ITEM NO.	DESCRIPTION	UNIT	QUANTITY
508.92	Cement Rubble Masonry for Waikakalaua Bridge	C.Y.	24
612.93	Grouted Rubble Paving for Waikakalaua Bridge	C.Y.	21
206.92	Structural Excavation for CRM at Waikakalaua Bridge	C.Y.	35

STATE OF HAWAII
DEPARTMENT OF TRANSPORTATION
HIGHWAYS DIVISION

REHABILITATION AND REPAIRS
TO WAIKAKALAUA BRIDGE

PROJ. NO. HWY-0-01-72 NOV. 1971
SHEET No. 1 OF 1 SHEETS