




FED. ROAD DIST. NO.	STATE	FED. AID PROJ. NO.	FISCAL YEAR	SHEET NO.	TOTAL SHEETS
HAWAII	HAW.	I-HI-1(51)	1969	13	33

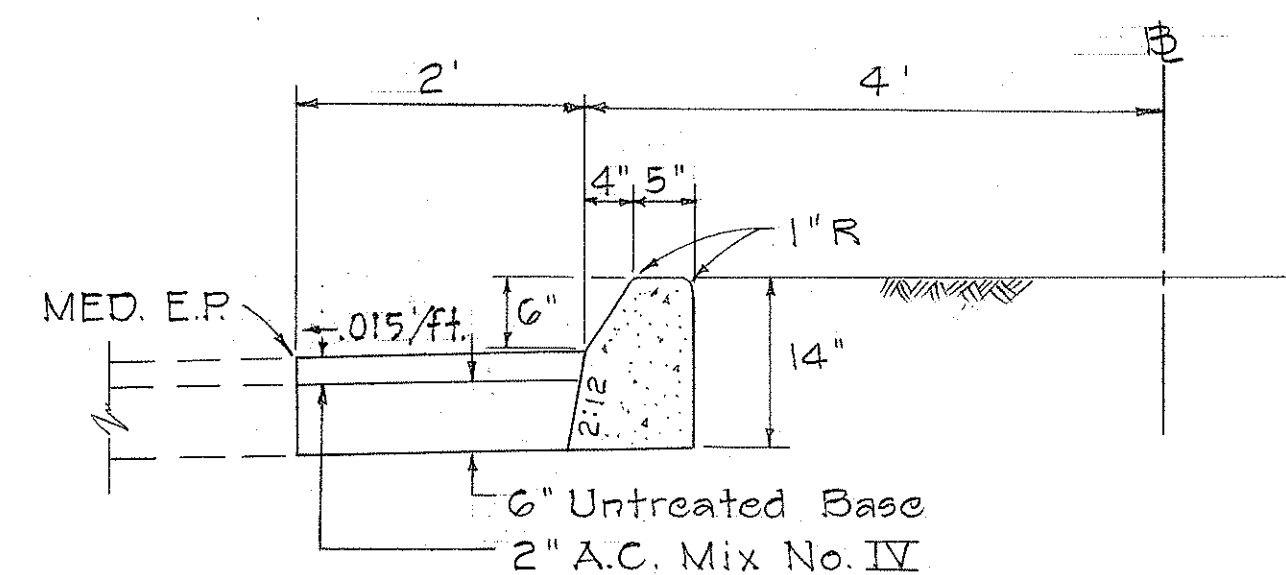


SECTION "A-A"
Scale: 3/4" = 1'-0"

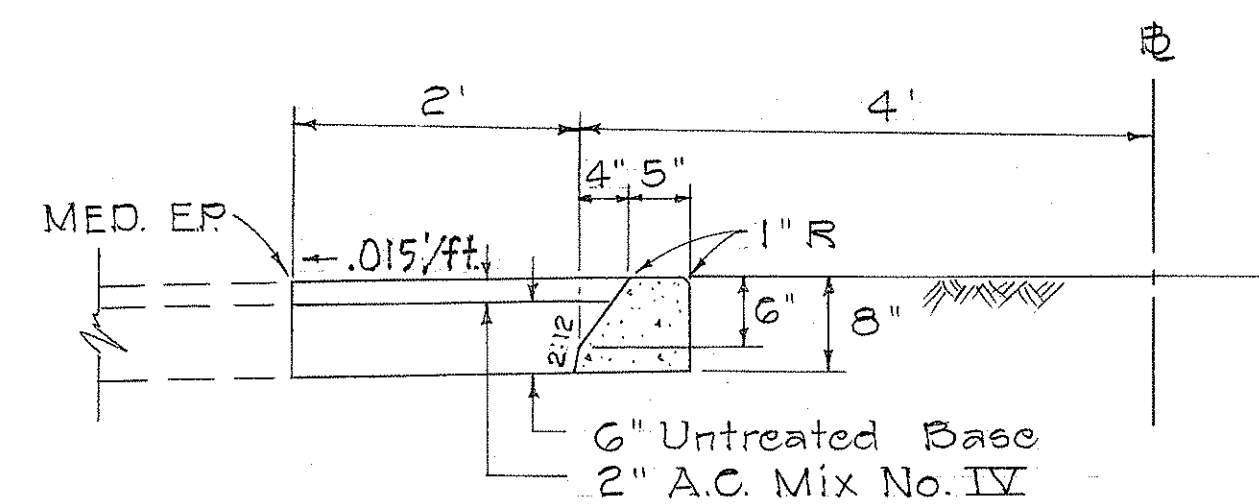


SECTION "B-B"
Scale: 3/4" = 1'-0"

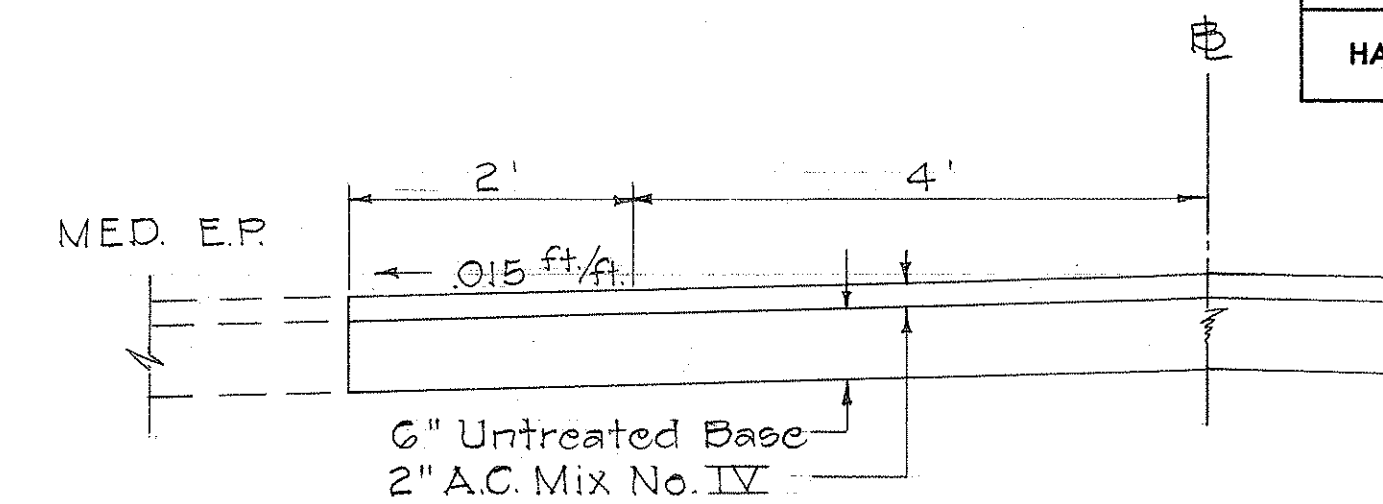

TYPICAL SECTION OF MEDIAN
STATION 355 + 25 to STATION 355 + 35
Scale: 3/4" = 1'-0"

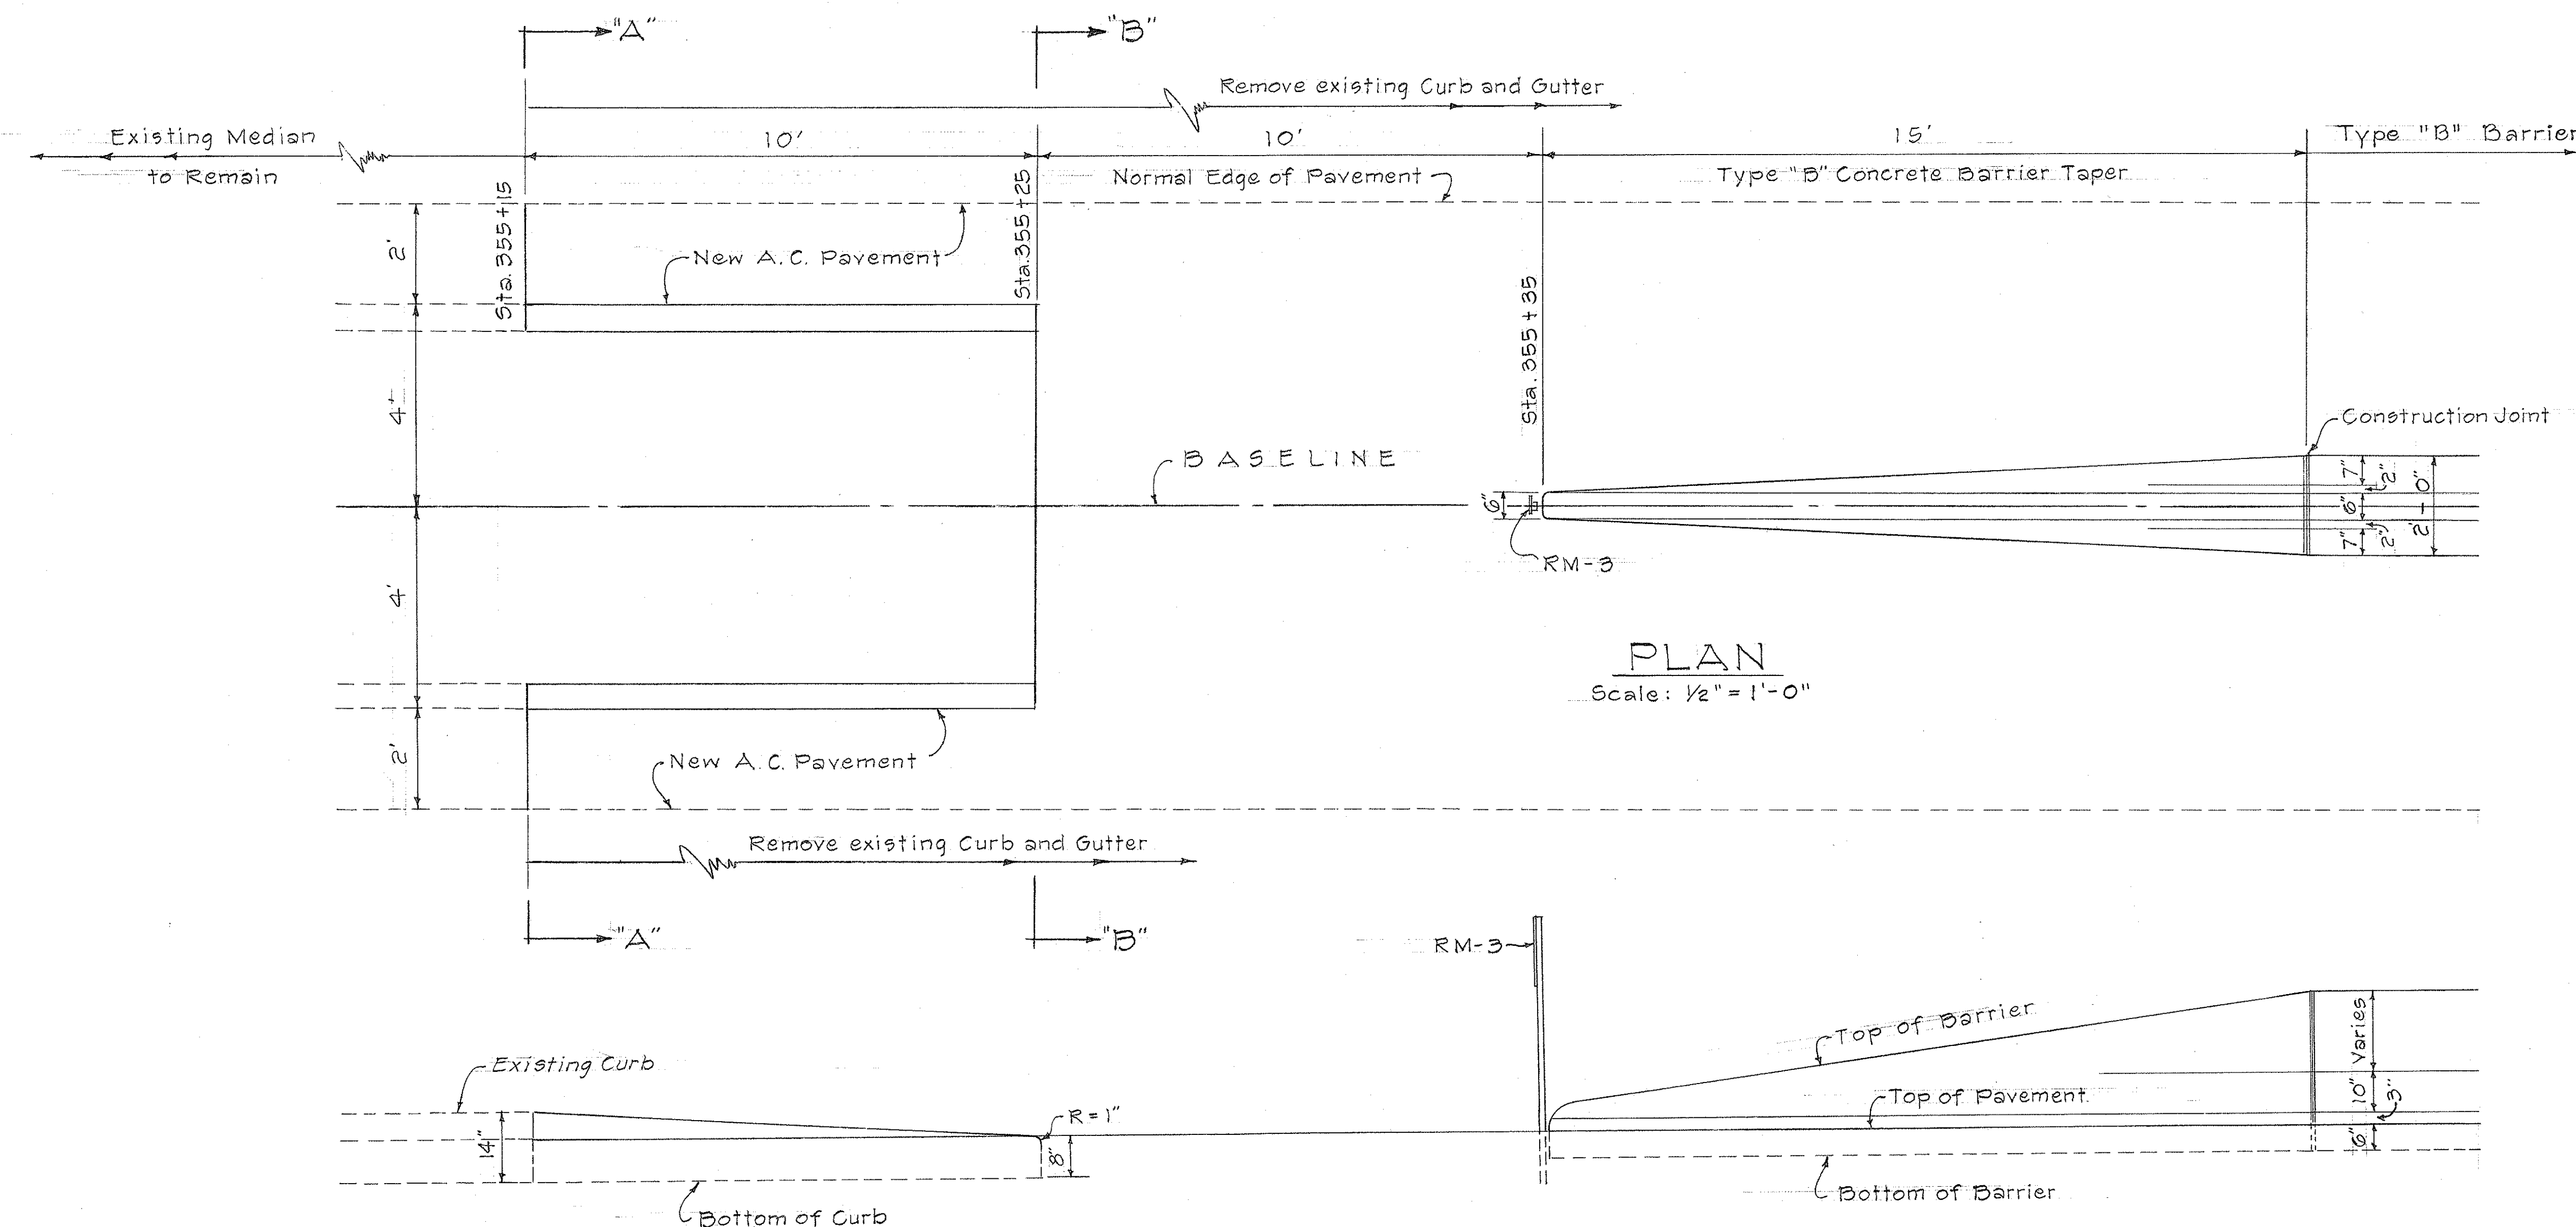

PLAN
Scale: 1/2" = 1'-0"

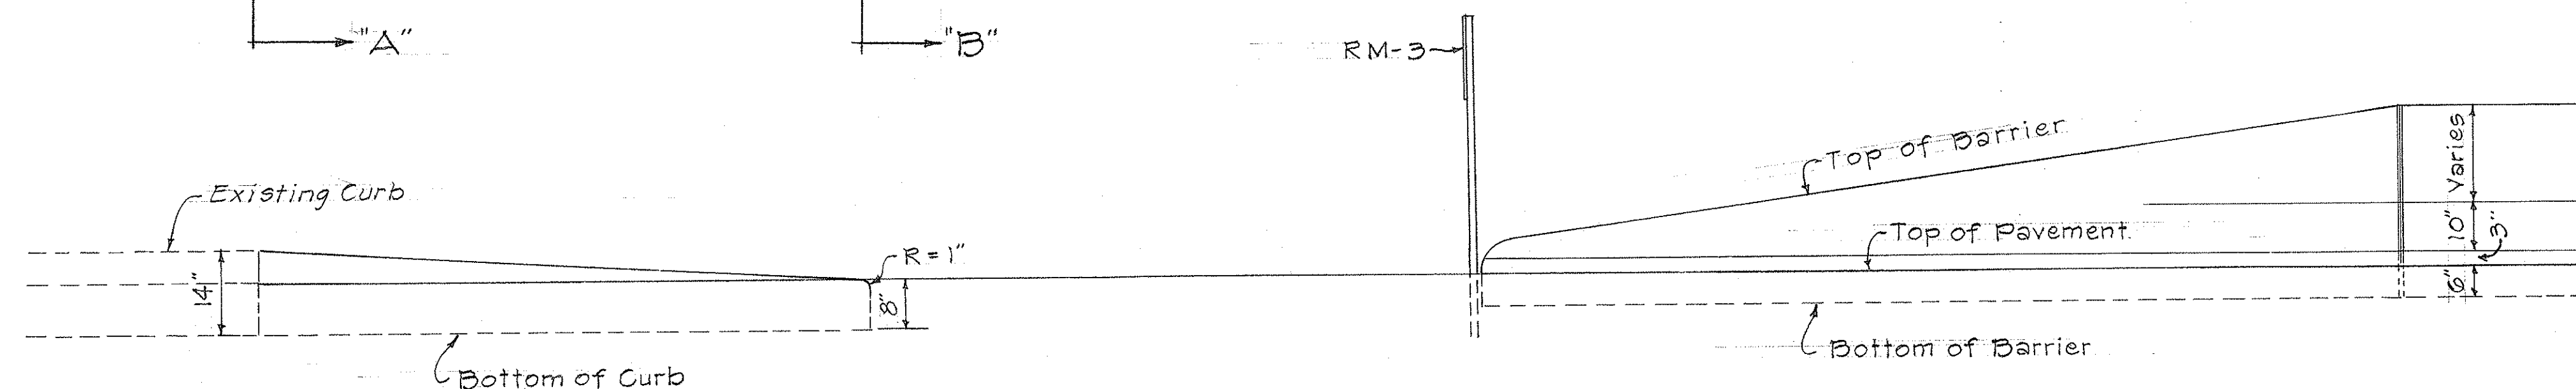

ELEVATION
Scale: 1/2" = 1'-0"

Notes:

1. Median shall be symmetrical on both sides of the centerline.
2. Type "A" Curb shall be cast in place as shown on the plans (Incidental to A.C. Mix No. IV).
3. Median shall transition from Section "A-A" to Section "B-B".

STATE OF HAWAII
DEPARTMENT OF TRANSPORTATION
HIGHWAYS DIVISION

DETAIL OF CONNECTION
TO TYPE "B"
CONCRETE BARRIER

Scale: As Shown Date: August 1968

SHEET No. 1 OF 1 SHEETS