


ORIGINAL PLAN	SURVEY PLOTTED BY _____ DATE _____	
	DRAWN BY _____	44
	TRACED BY _____	44
	DESIGNED BY _____	44
	QUANTITIES BY _____	44
NOTE BOOK	CHECKED BY _____	44
	No. _____	44

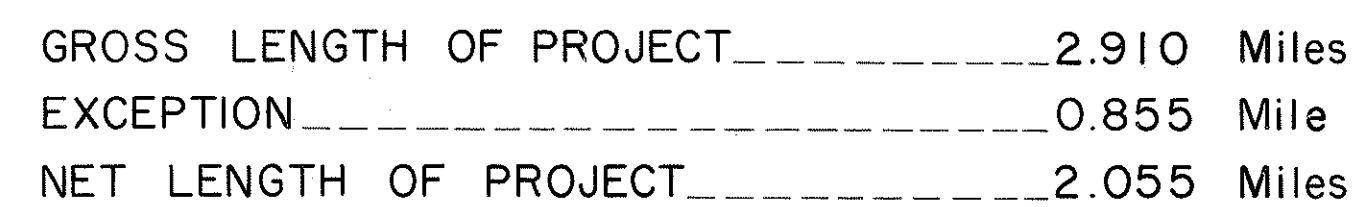

STATE OF HAWAII
DEPARTMENT OF TRANSPORTATION
HIGHWAYS DIVISION

LAYOUT PLAN

FED. AID INTERSTATE PROJ. NO. I-HI-1(51)

Scale: 1" = 400' Date: MAY 1968

SHEET No. 1 OF 1 SHEETS