

[illegible]

FED. ROAD DIST. NO.	STATE	FED. AID PROJ. NO.	FISCAL YEAR	SHEET NO.	TOTAL SHEET
HAWAII	HAW.	I-HI-1(5)	1969	1	33


STATE OF HAWAII
DEPARTMENT OF TRANSPORTATION
HIGHWAYS DIVISION
HONOLULU, HAWAII

"AS BUILT" PLANS OF

SAFETY IMPROVEMENTS ALONG
INTERSTATE H-1, MIDDLE STREET
TO PELE STREET

FEDERAL AID INTERSTATE PROJECT NO. I-HI-1(5)18

DISTRICT OF HONOLULU
ISLAND OF OAHU

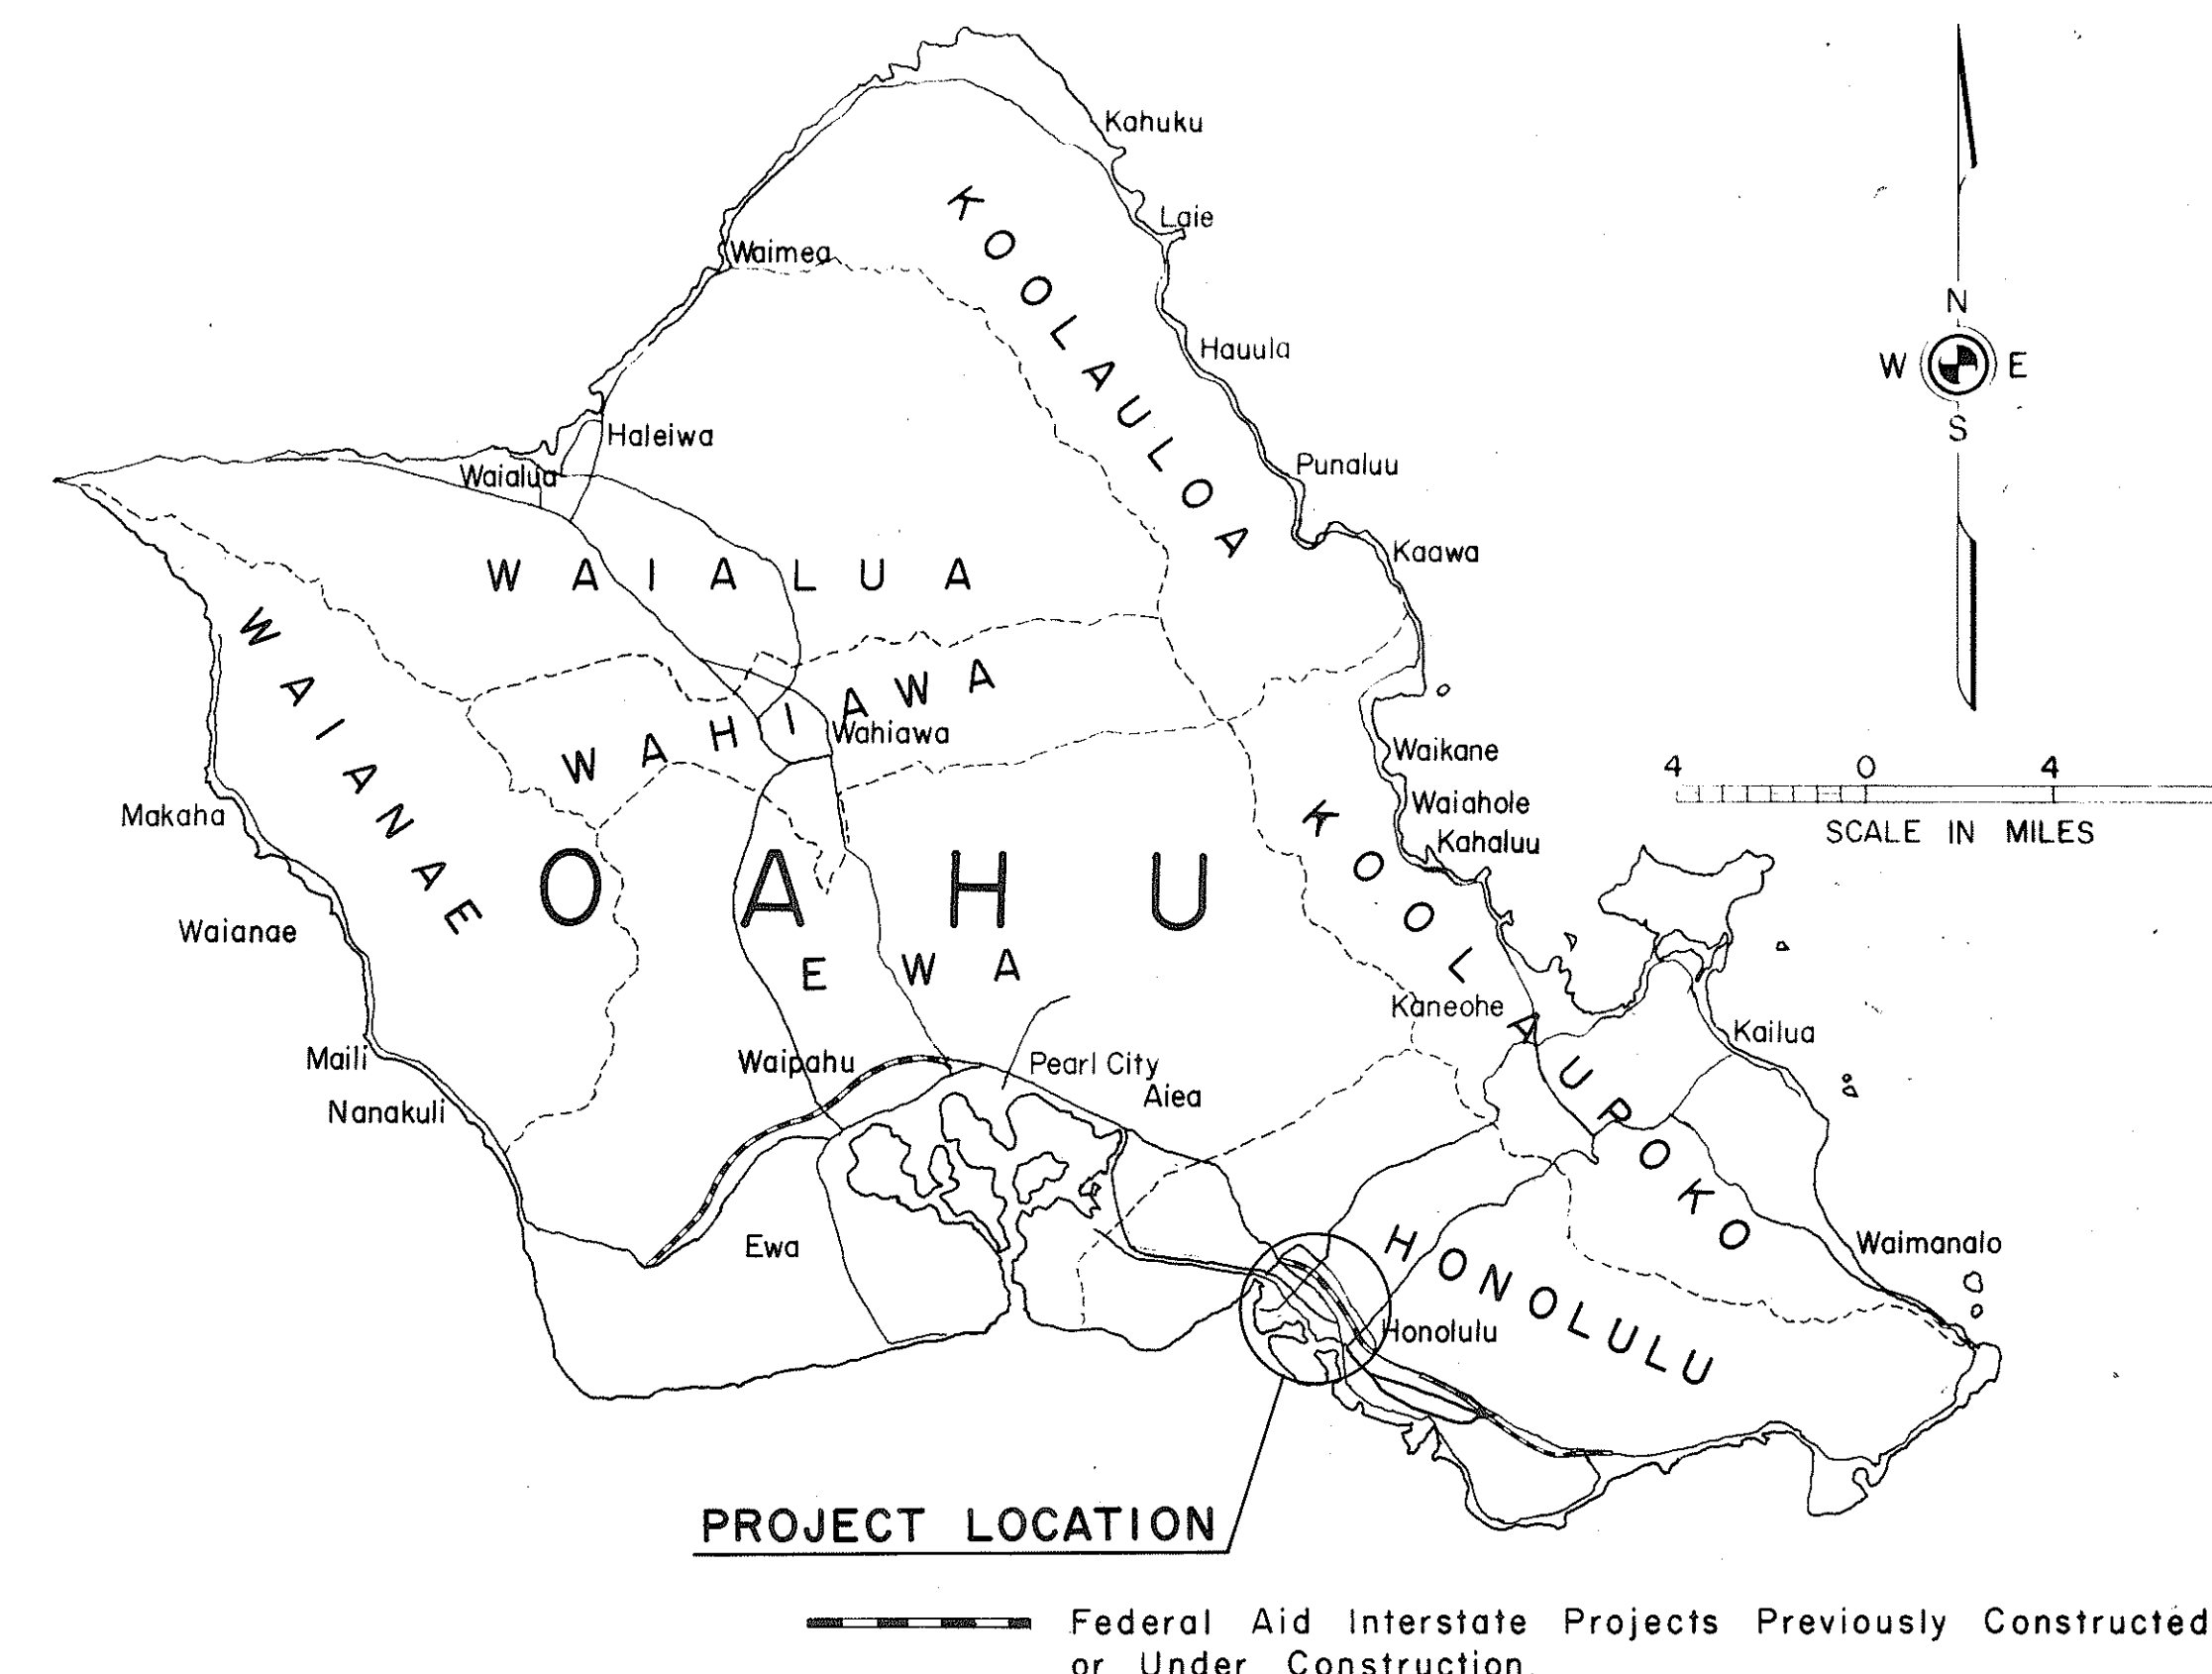

NOTE:

ALL CHANGES MADE DURING CONSTRUCTION
HAVE BEEN NOTED IN RED ON THESE TRACINGS
AND CHECKED BY:

G. Cabana
PROJECT ENGINEER
12/9/71
DATE

DESIGN	CLASSIFICATION
ADT (1962)	0
DESIGN ADT (1983) . .	.80,000
DHV	11%
D55/45
T	2%
V	50 MPH

DEPARTMENT OF TRANSPORTATION BUREAU OF PUBLIC ROADS	
<i>APPROVED:</i>	
<i>[Signature]</i> DIVISION ENGINEER	<i>[Signature]</i> DATE

DEPARTMENT OF TRANSPORTATION STATE OF HAWAII	
APPROVED:	
_____ DIR. OF TRANSPORTATION	_____ DATE