

INDEX TO DRAWINGS	
SHEET NO.	DESCRIPTION
1	TITLE SHEET
2	SITE PLAN AND ELEVATION
3	LAYOUT PLAN AND LONGITUDINAL SECTION
4	PIERS AND PYLONS
5	BRIDGE SUPER STRUCTURE
6	CROSS SECTION & RAILING
7	RAMP DETAILS
8	LANDSCAPE, SPRINKLER AND SIGNING PLAN
9	STANDARD CHAIN LINK FENCE DETAIL
10	STANDARD SPRINKLER DET.
11	MISC. SIGN DETAILS

STATE OF HAWAII

DEPARTMENT OF TRANSPORTATION

LAND TRANSPORTATION FACILITIES DIVISION

HONOLULU, HAWAII

AS BUILT

PLANS FOR

CONSTRUCTION OF A

PEDESTRIAN - BIKEWAY OVERPASS


AT THE INTERSECTION OF MAIN STREET AND NIMITZ HIGHWAY

PEARL HARBOR INTERCHANGE

FEDERAL AID INTERSTATE PROJECT NO. I-HI-1 (143):15

DISTRICT OF HONOLULU

ISLAND OF OAHU

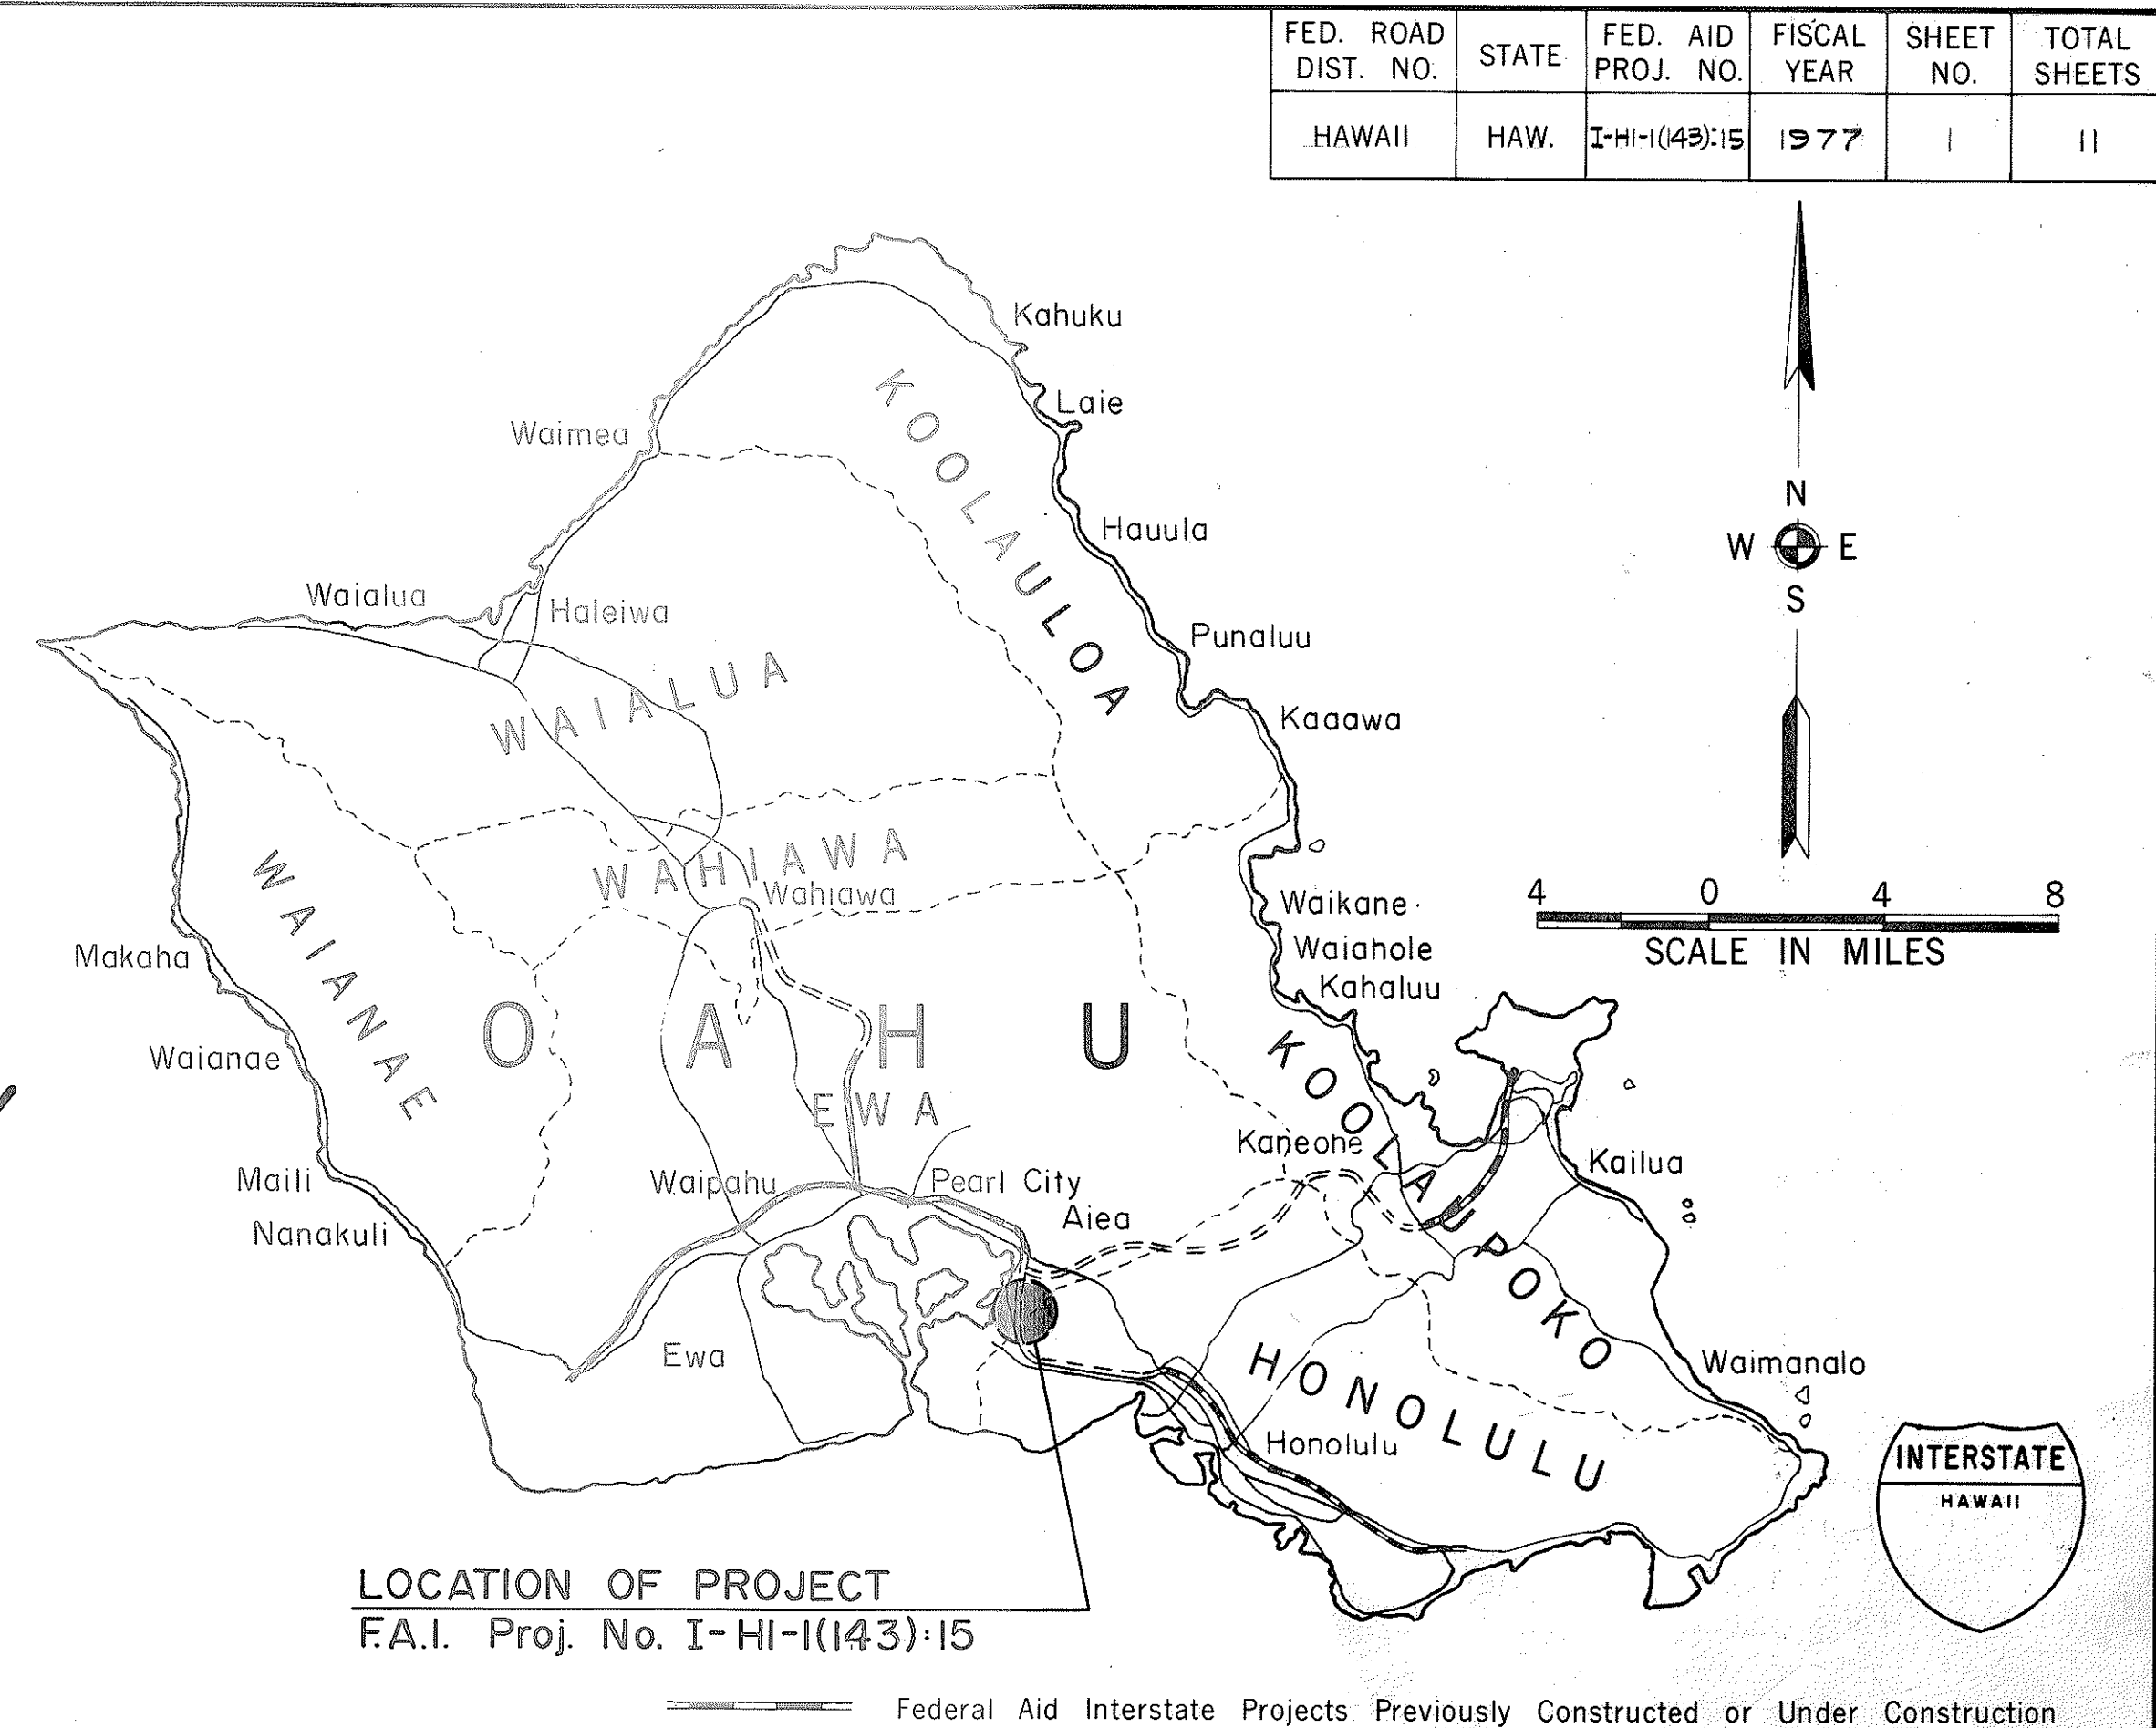

DESIGN DESIGNATION

DESIGN ADT (1994).....50,444

DHV7,030

D 90 / 10

T 15 %

V 40 MPH

CONTROL OF ACCESS..... FULL

ALL CHANGES MADE DURING CONSTRUCTION HAVE BEEN INCORPORATED ON THESE PLANS EXCEPT CHANGES IN THE ORIGINAL THEORETICAL QUANTITIES.

Robert Y. Omai

RESIDENT ENGINEER

4-4-79

DATE

DEPARTMENT OF TRANSPORTATION

FEDERAL HIGHWAY ADMINISTRATION

APPROVED:



DIVISION ADMINISTRATOR

6-28-77

DATE

DEPARTMENT OF TRANSPORTATION

STATE OF HAWAII

APPROVED:



for DIR. OF TRANSPORTATION

5/11/77

DATE

SS&F&SLTH

DESIGNED BY

J. SUGHARA

P. S. & E. BY

548-5812

PHONE

JAN 14, 1977

DATE

