

24.6±
Match
Exist.

8+12


8+00

EXIST. ELLIOTT ST.)

STATE OF HAWAII
DEPARTMENT OF TRANSPORTATION
HIGHWAYS DIVISION

PROFILES
ELLIOTT STREET
AOLELE STREET
(EXISTING ELLIOTT STREET)
FUTURE AOLELE STREET
AIRPORT INTERCHANGE
F.A.I. PROJ. NO. I-HI-1(156):16
SCALE: AS SHOWN DATE: AUG 9, 1977

SHEET No. 1 OF 1 SHEETS

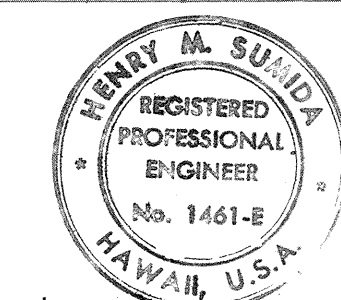

THIS WORK WAS PREPARED BY
ME OR UNDER MY SUPERVISION.
Henry M. Smith

STATE OF HAWAII
DEPARTMENT OF TRANSPORTATION
HIGHWAYS DIVISION
PROFILES
ELLIOTT STREET
AOELE STREET
(EXISTING ELLIOTT STREET)
FUTURE AOELE STREET
AIRPORT INTERCHANGE
F.A.I. PROJ. NO. 1-HI-1(156)-16
SCALE: AS SHOWN DATE: AUG. 9, 1977
SHEET No. 1 OF 1 SHEETS