

INDEX TO DRAWINGS	
SHEET NO	DESCRIPTION
1	TITLE SHEET
2	CONSTRUCTION PHASING
3-5	TYPICAL ROADWAY SECTIONS
6-7	FRONTAGE ROAD - PLAN & PROFILE
8	SUPERELEVATION DIAGRAM
9	BUS STOPS AT VALKENBURGH ST.
10-13	INTERSECTION DETAILS
14	PROFILES
15	LANE TRANSITIONS
16	WHEEL CHAIR RAMPS
17	MISCELLANEOUS SCHEDULES
18-19	DRAINAGE - PLAN & PROFILE
20-21	MANHOLE DETAILS
22-23	DRAINAGE DETAILS
24-25	DRAINAGE SUMMARY
26-28	TRAFFIC SIGNALS
29-39	SIGNING & STRIPING- PLANS & DETAILS
40-42	CONSTRUCTION DETOURS
43-75	STANDARD DETAILS
76-84	ROADWAY LIGHTING
85-89	UTILITY ADJUSTMENTS
90-91	UNDERGROUND UTILITY LOCATION MAP
92-94	IRRIGATION PLAN PIPE STUB-OUTS & SLEEVES
95-96	INDEX TO VIADUCT PLANS
97-171	VIADUCT PLANS
172-200	TYPICAL DETAILS
201	STANDARD STRUCTURE DETAILS
202-207	EXPRESSWAY SIGN DETAILS
208-216	CROSS SECTIONS
217-236	ADDITIONAL WORK - STA.25+00 TO I15+30

STATE OF HAWAII
DEPARTMENT OF TRANSPORTATION
LAND TRANSPORTATION FACILITIES DIVISION
HONOLULU, HAWAII
"AS BUILT"
PLANS FOR
CONSTRUCTION OF A PORTION OF
INTERSTATE ROUTE H-1
AIRPORT INTERCHANGE
INBOUND VIADUCT
EAST OF VALKENBURGH STREET TO EAST OF ELLIOTT STREET
FEDERAL AID INTERSTATE PROJECT I-HI-1(I56):16
DISTRICT OF HONOLULU
ISLAND OF OAHU

INDEX TO DRAWINGS (Cont'd.)

- ① 27A, 27B
② 34A, 38A
③ 40A, 41A, 41B, 41C
④ 84A
- SUPPLEMENT SHEETS
TO THE CONTRACT
PLANS
NEW TOTAL 245 SHEETS

DESIGN CLASSIFICATION

DESIGN ADT (1994) 102,675
DHV 11%
D 60/40
T 5%
V 60 M.P.H.

SCALES:



PLANS HOR. 1" = 50'
PROFILES HOR. 1" = 50'
VER. 1" = 10'
DETAIL ROADWAY PLANS HOR. 1" = 20'
CROSS SECTIONS HOR. 1" = 10'
VER. 1" = 5'

CHANGES MADE DURING CONSTRUCTION
HAVE BEEN INCORPORATED ON THESE
PLANS EXCEPT CHANGES IN THE ORIGINAL
THEORETICAL QUANTITIES

[Signature] 12-7-83
RESIDENT ENGINEER DATE

DEPARTMENT OF TRANSPORTATION
FEDERAL HIGHWAY ADMINISTRATION
APPROVED: *[Signature]* 2.28.79
DIVISION ADMINISTRATOR DATE

DEPARTMENT OF TRANSPORTATION
STATE OF HAWAII
APPROVED: *[Signature]* Jan 2, 79
DIR. OF TRANSPORTATION DATE

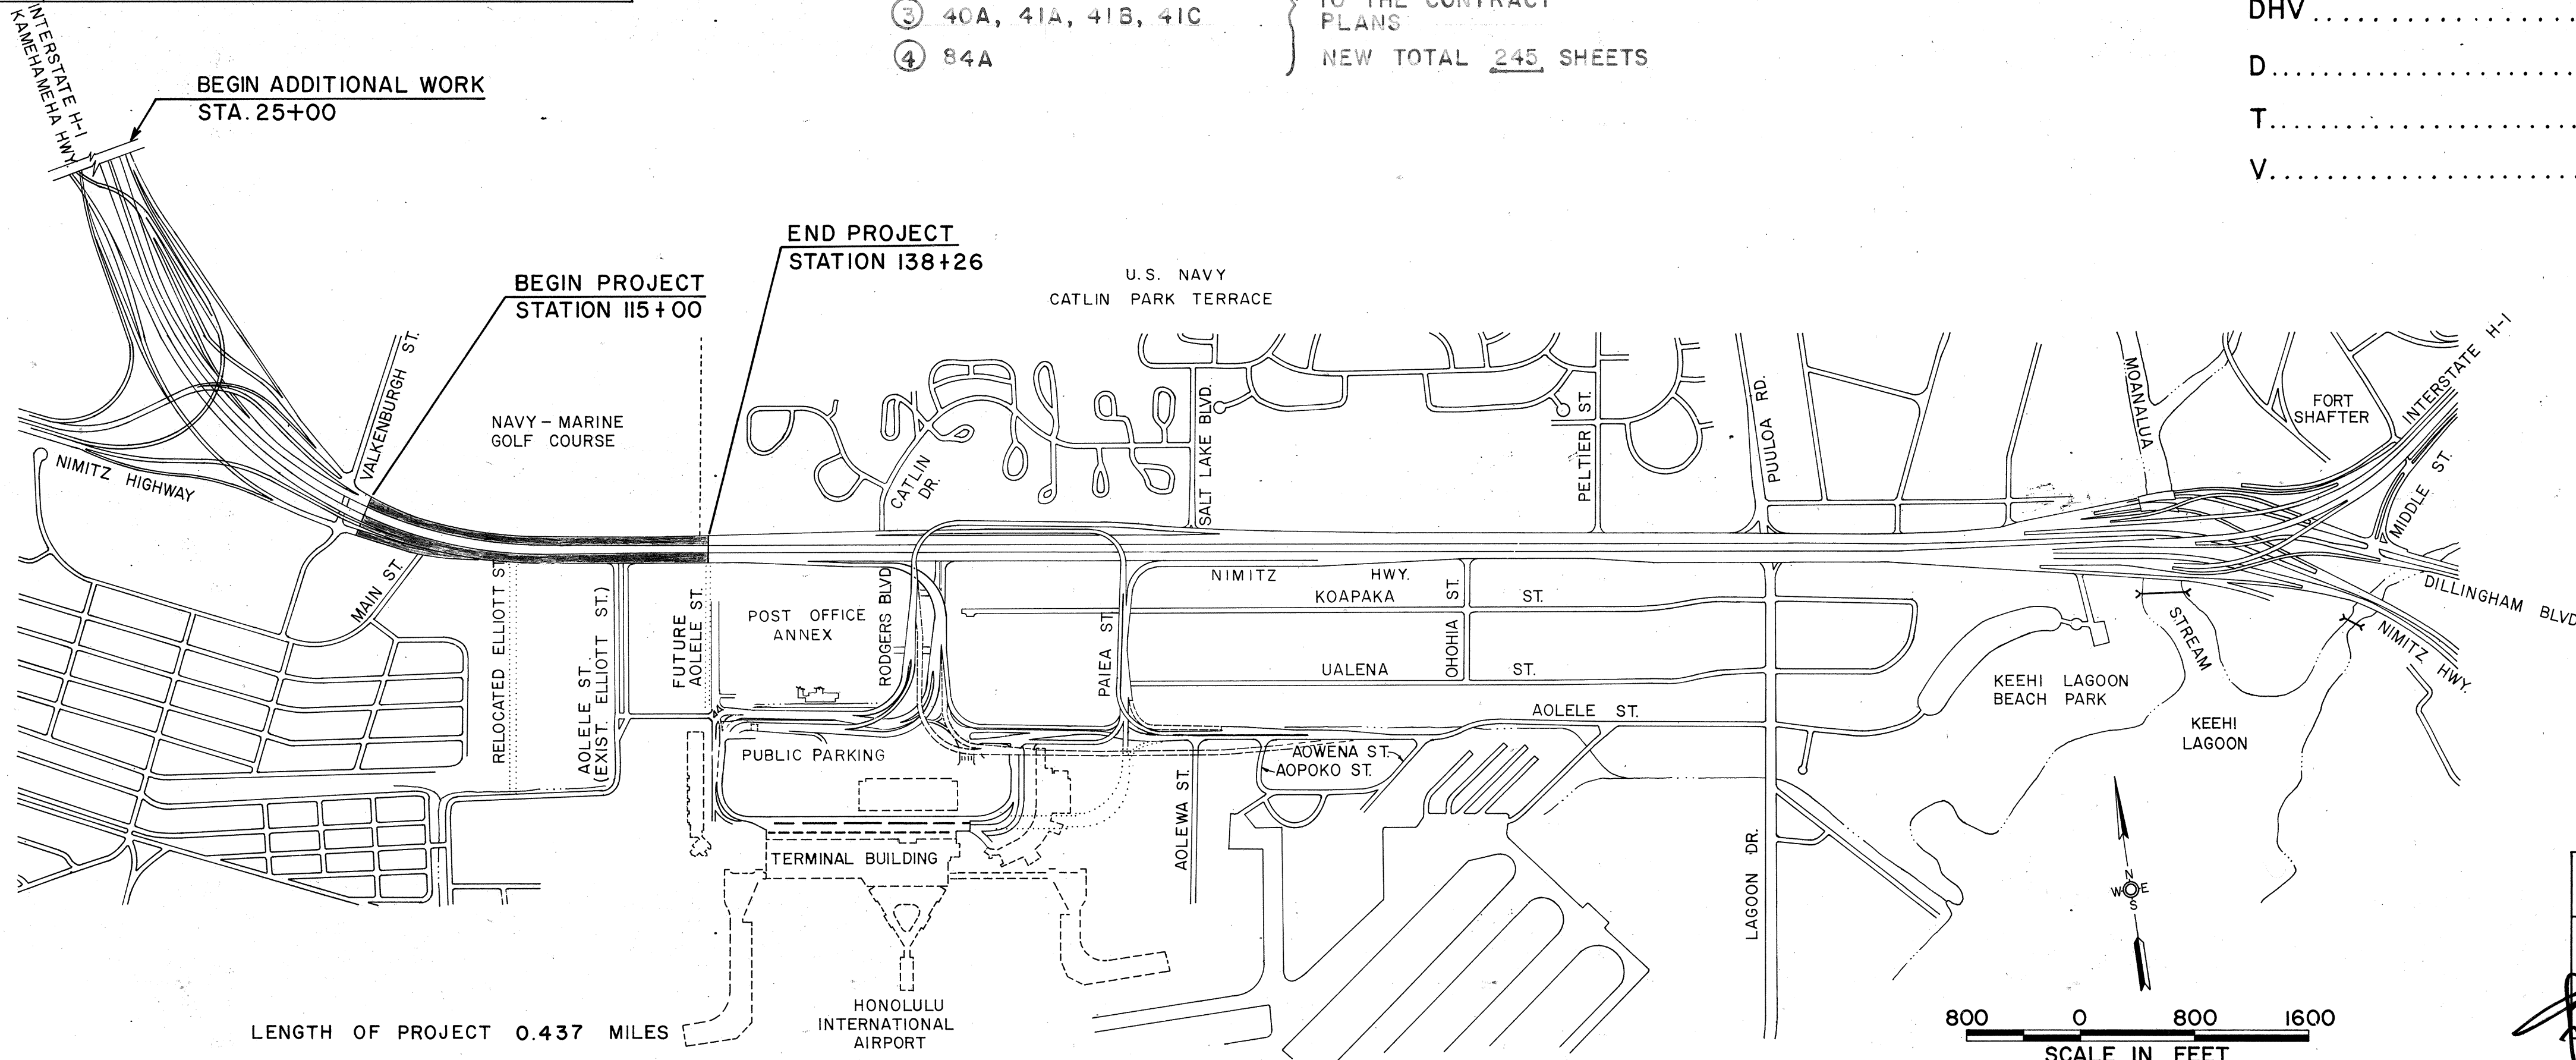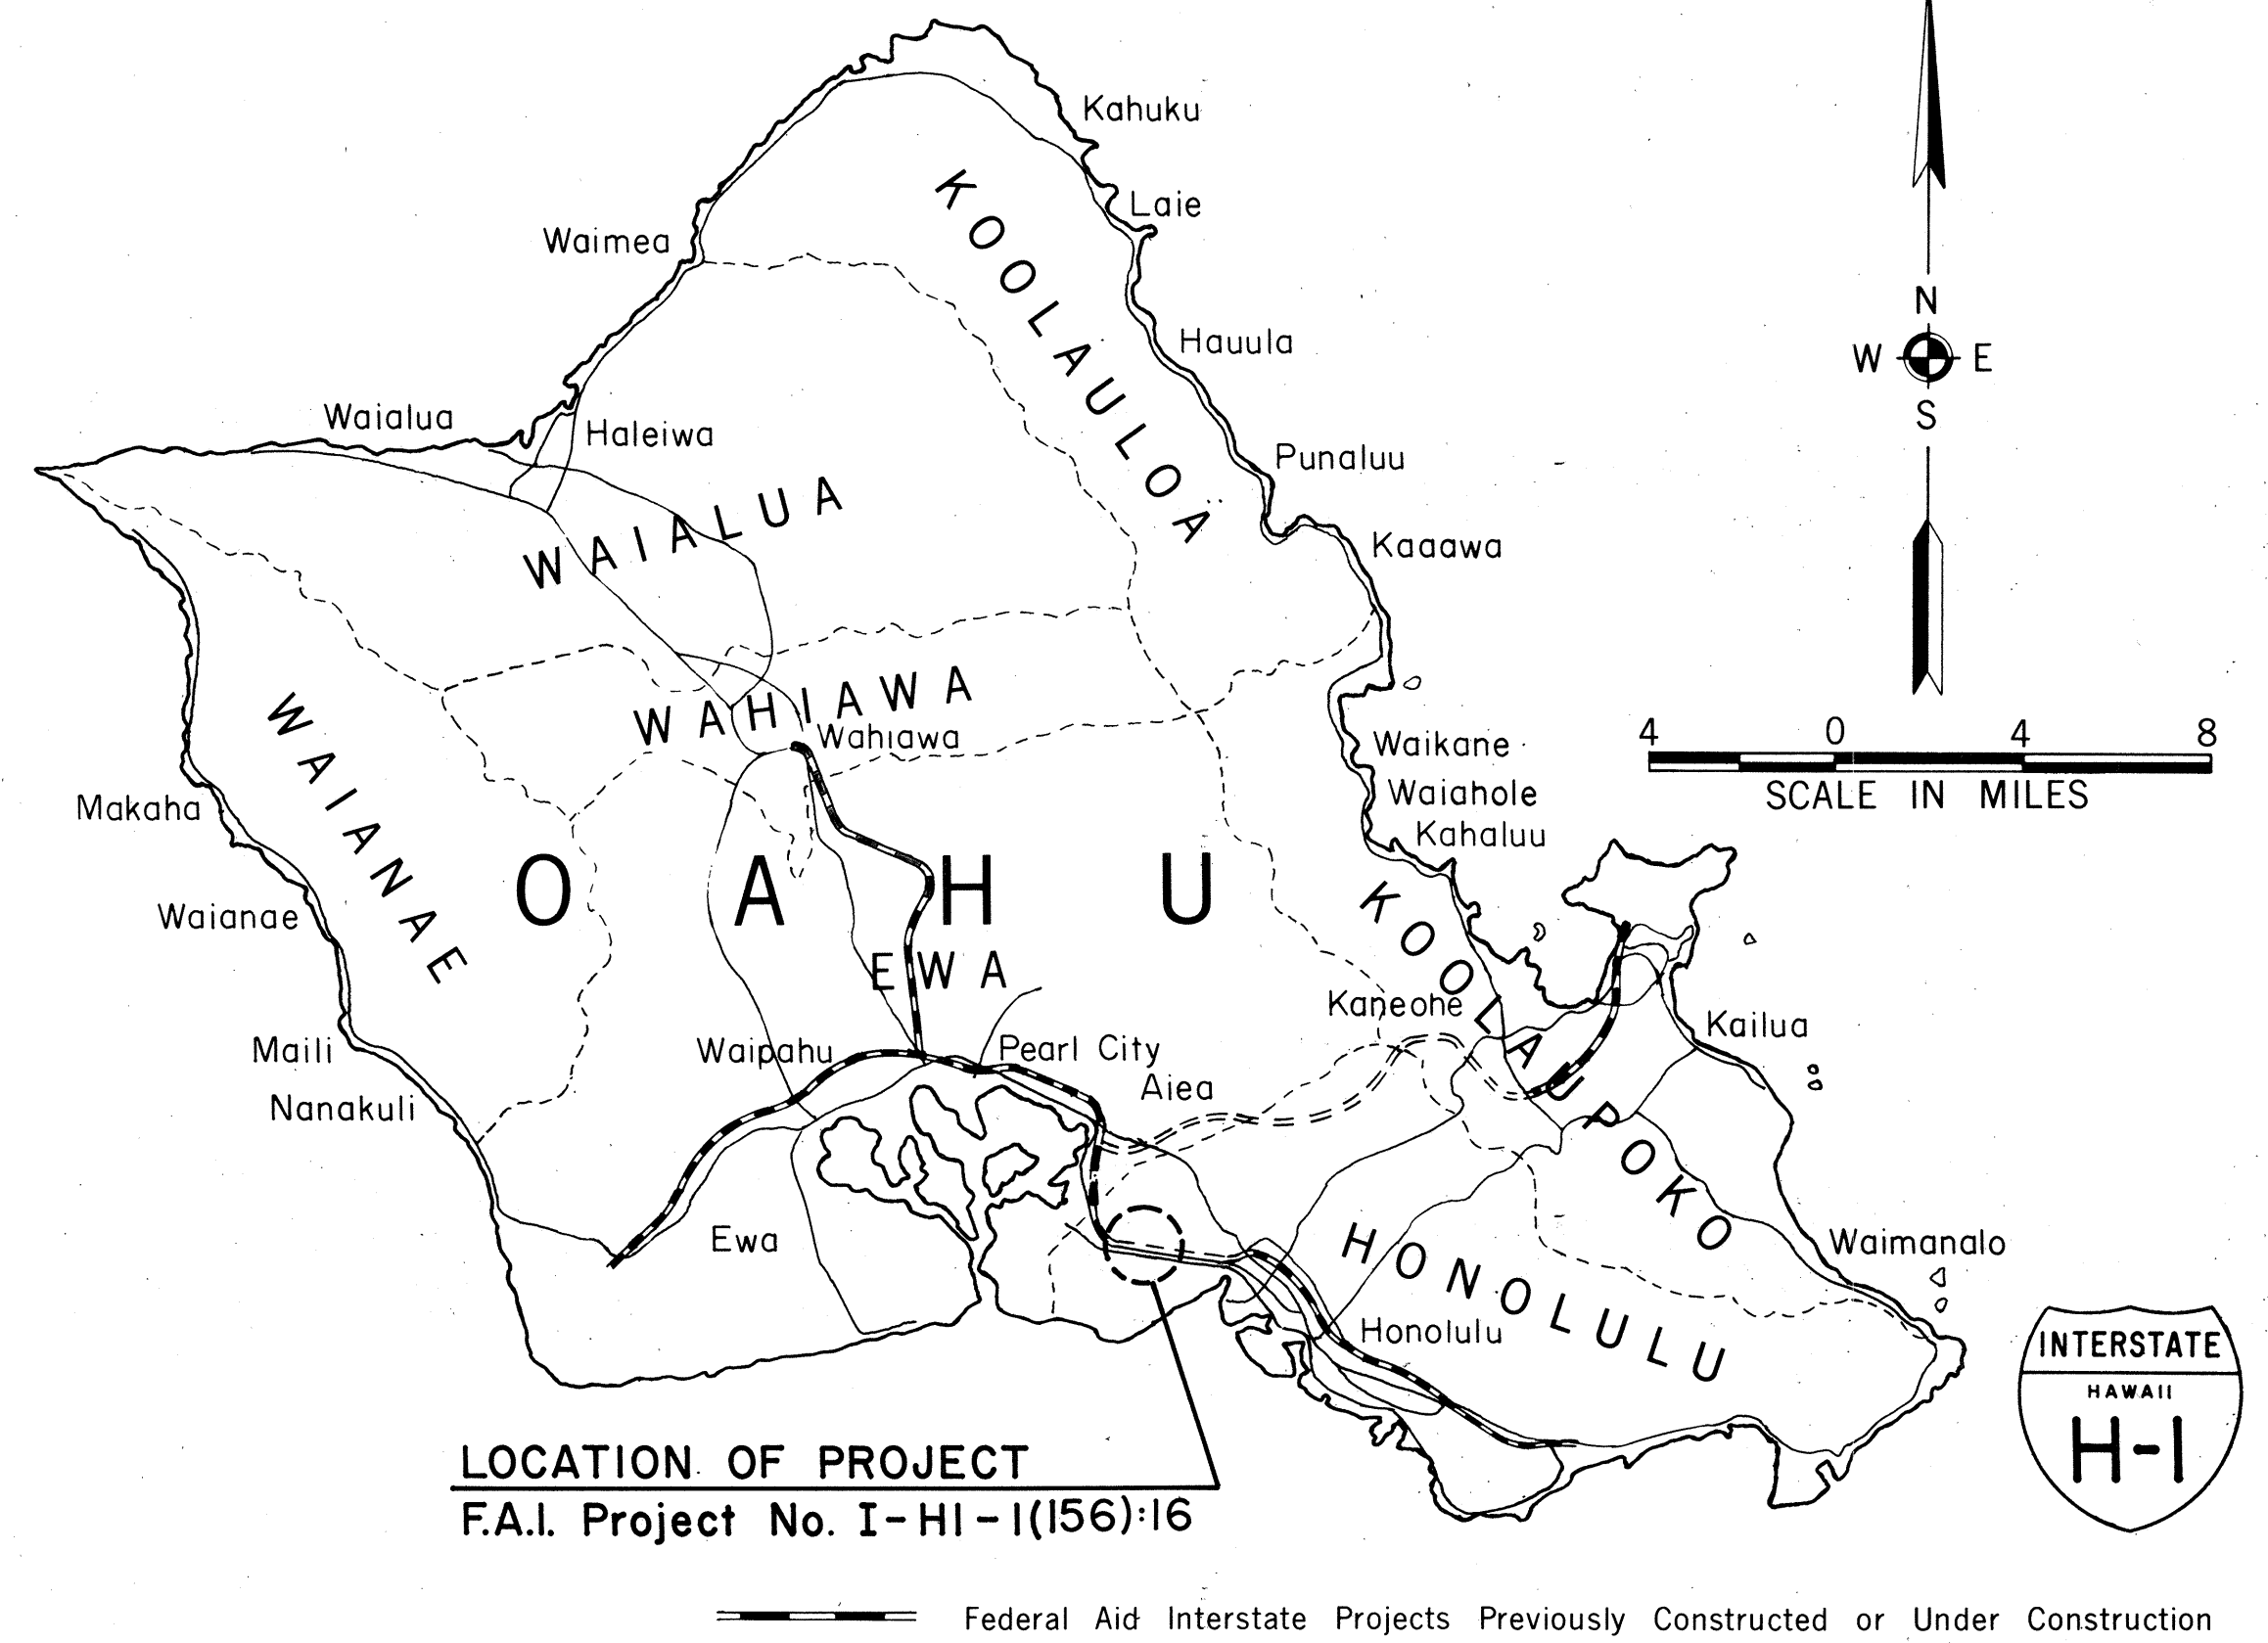

LENGTH OF PROJECT 0.437 MILES

800 0 800 1600
SCALE IN FEET

URS COMPANY HAWAII
DESIGNED BY
GEORGE ASATO
P. S. & E. BY
521-3051
PHONE
NOV. 27, 1978
DATE

DD-C-8-6