

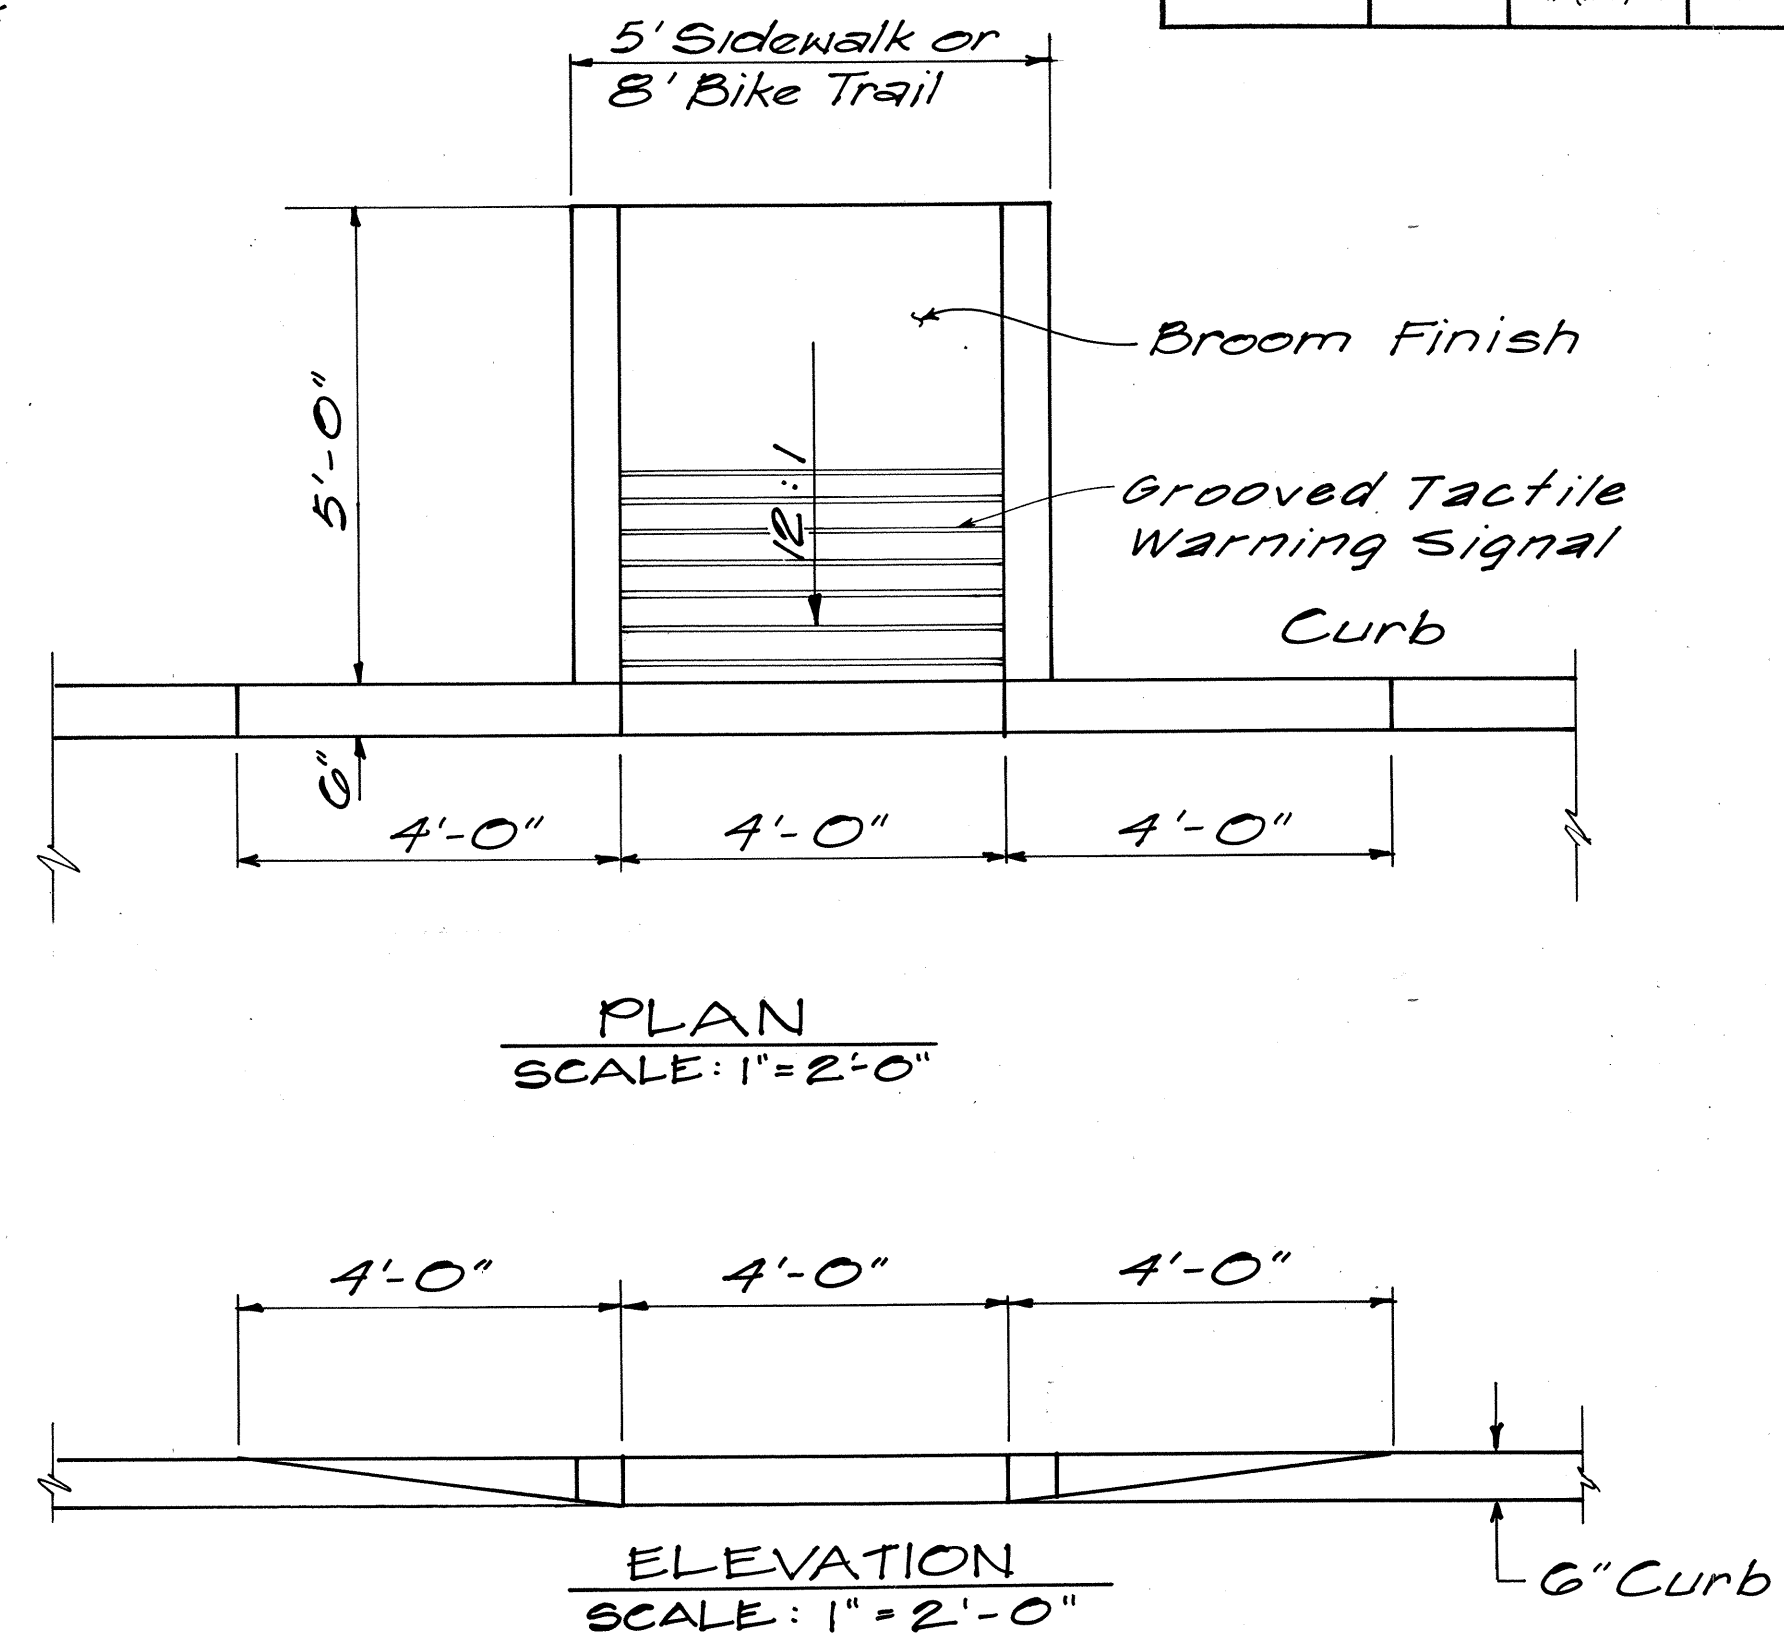
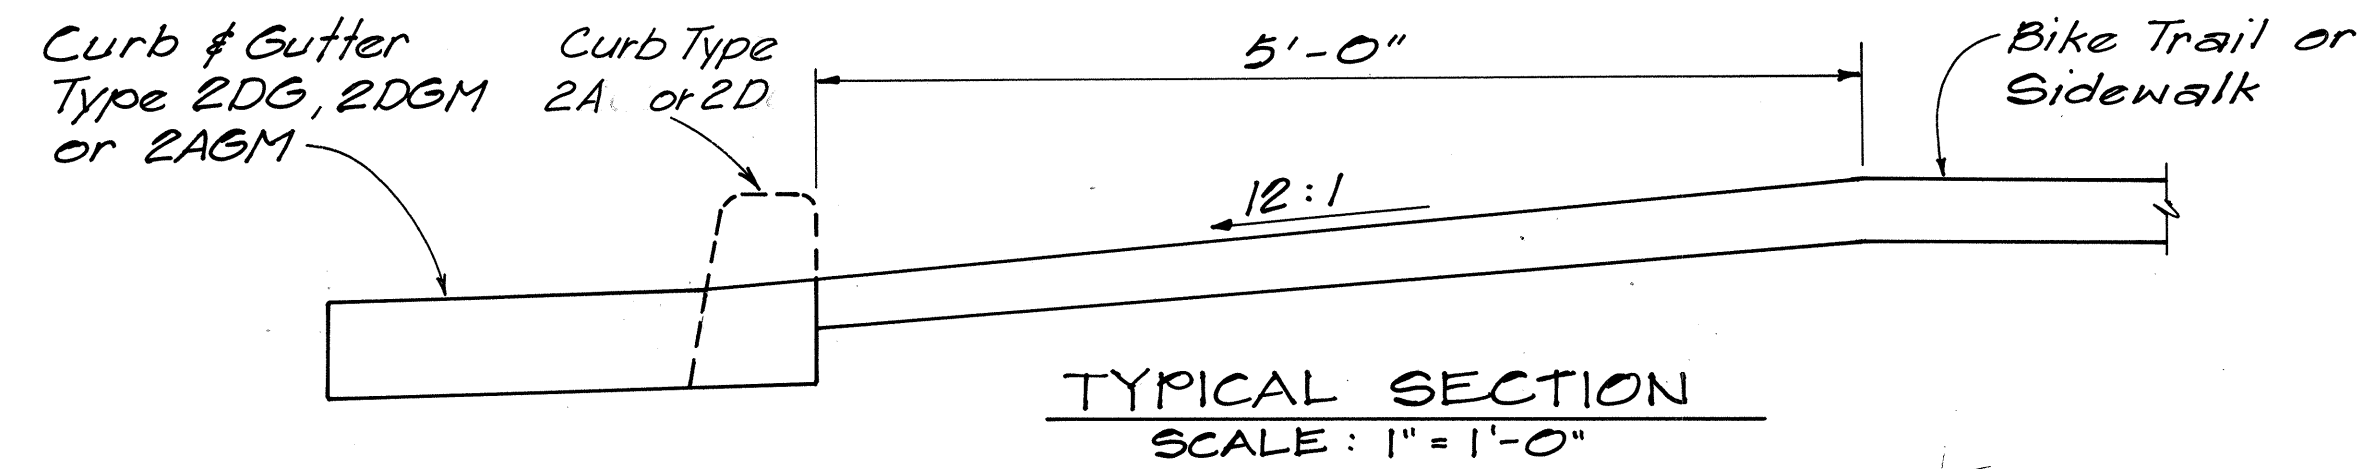



FED. ROAD DIST. NO.	STATE	FED. AID PROJ. NO.	FISCAL YEAR	SHEET NO.	TOTAL SHEETS
HAWAII	HAW.	I-HI-1(156)-16	1979	16	236

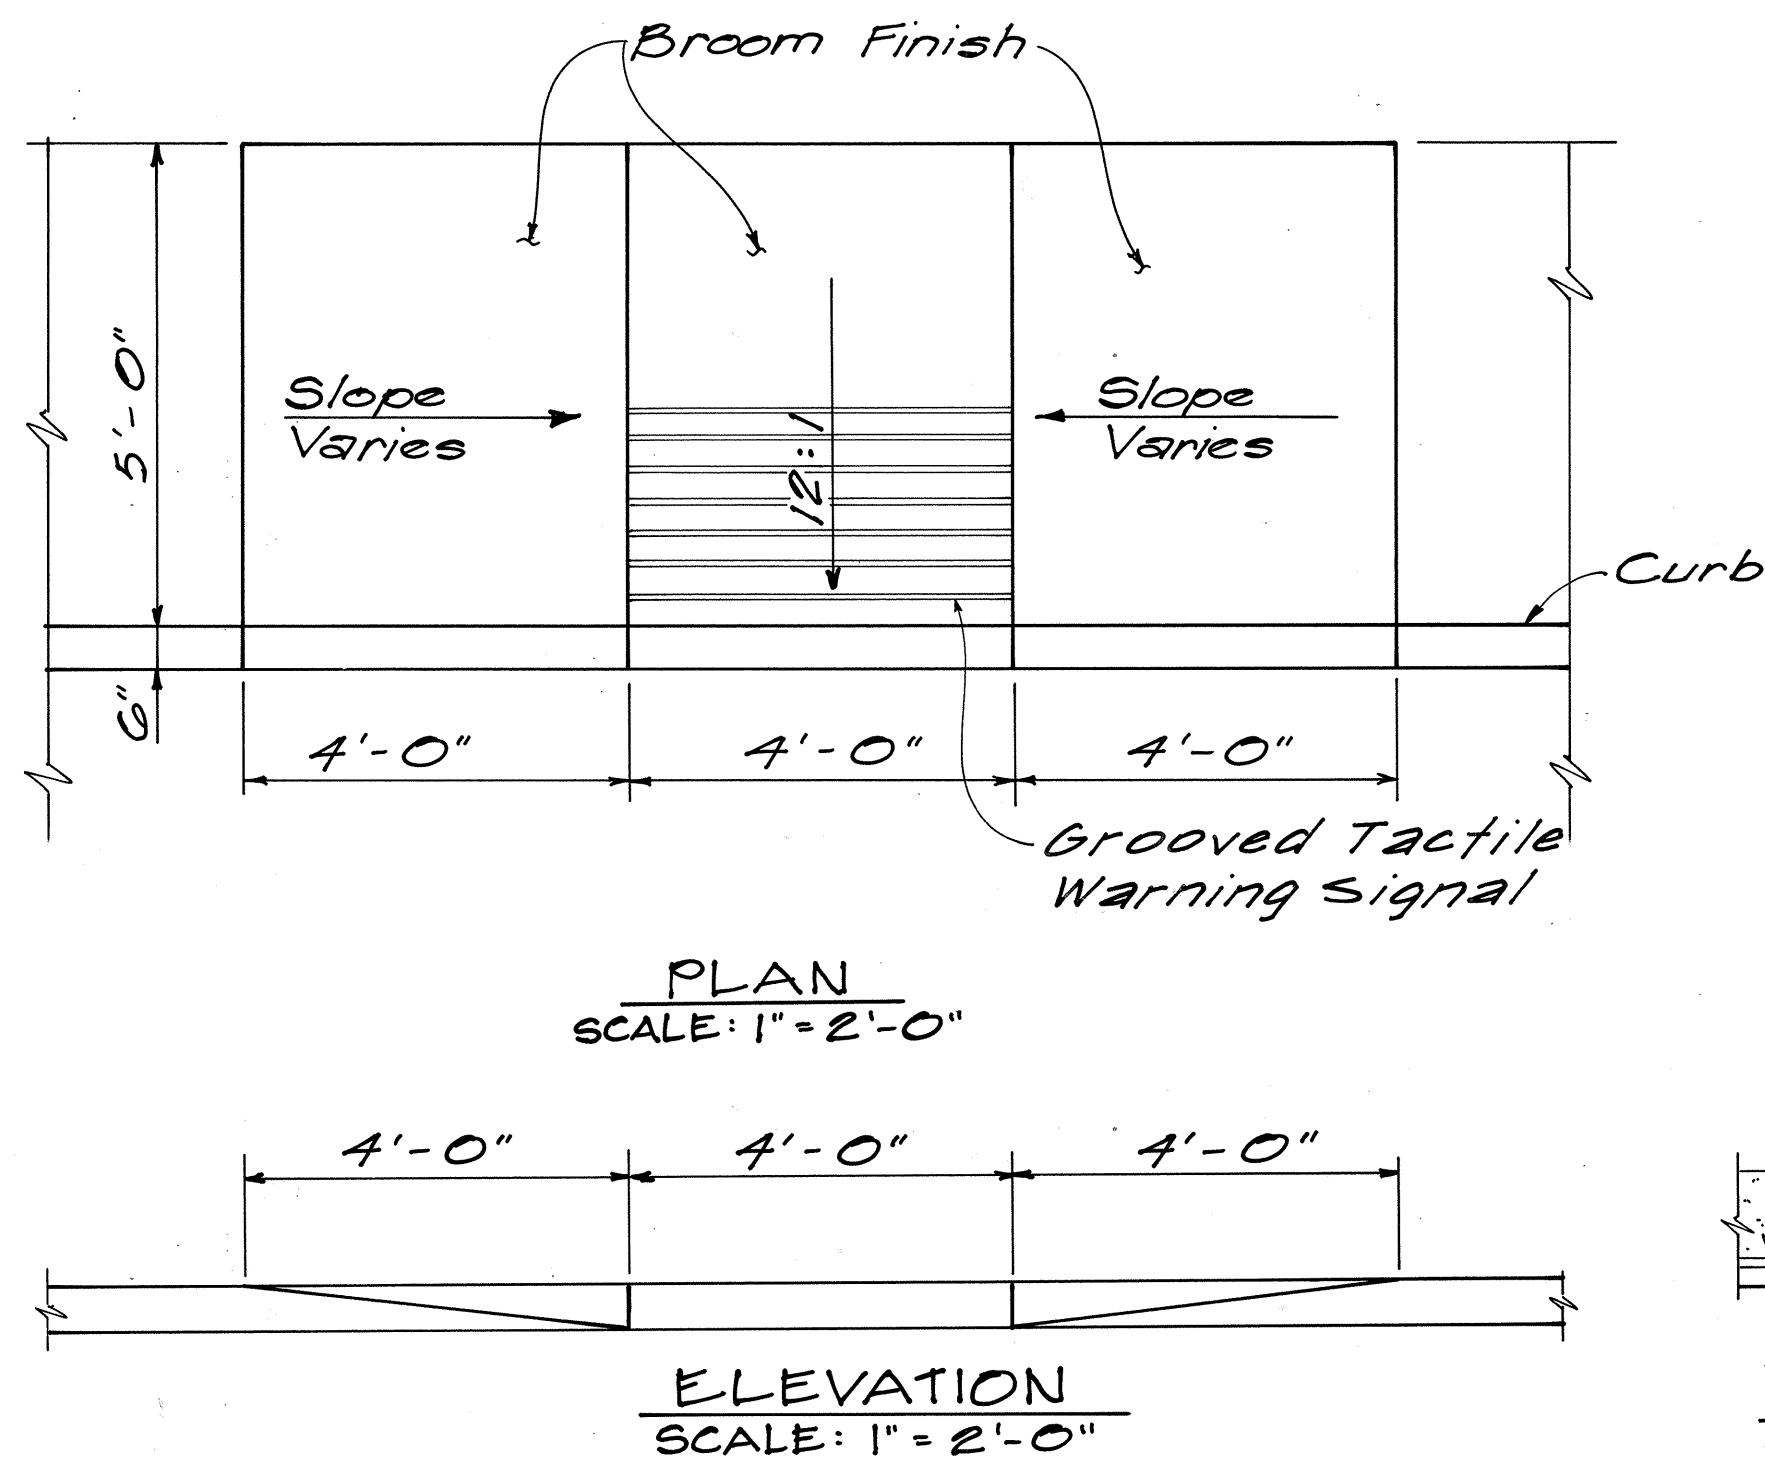

Note:
Wheel Chair Ramp Costs shall be incidental to Item G08.0200 Concrete Sidewalk.

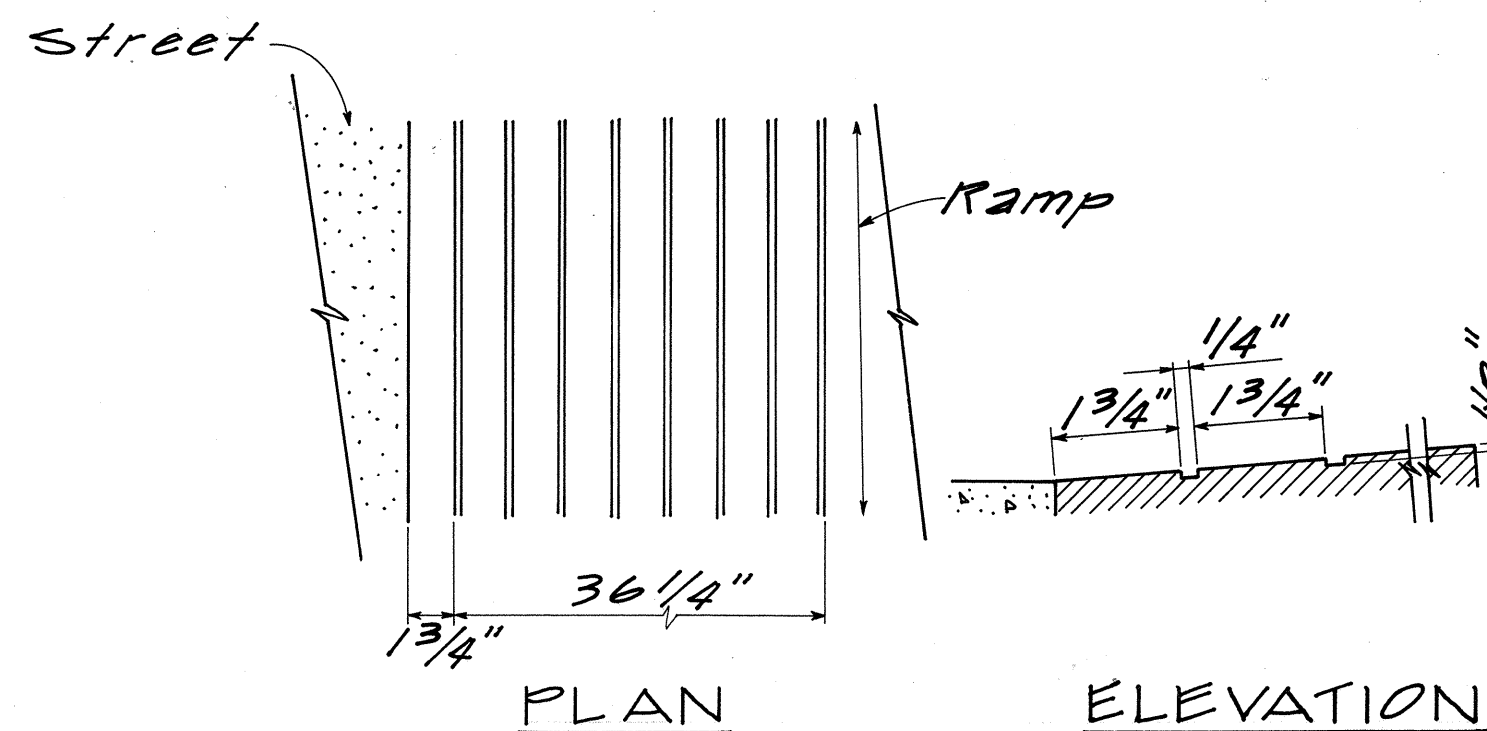


GROOVED TACTILE WARNING SIGNAL

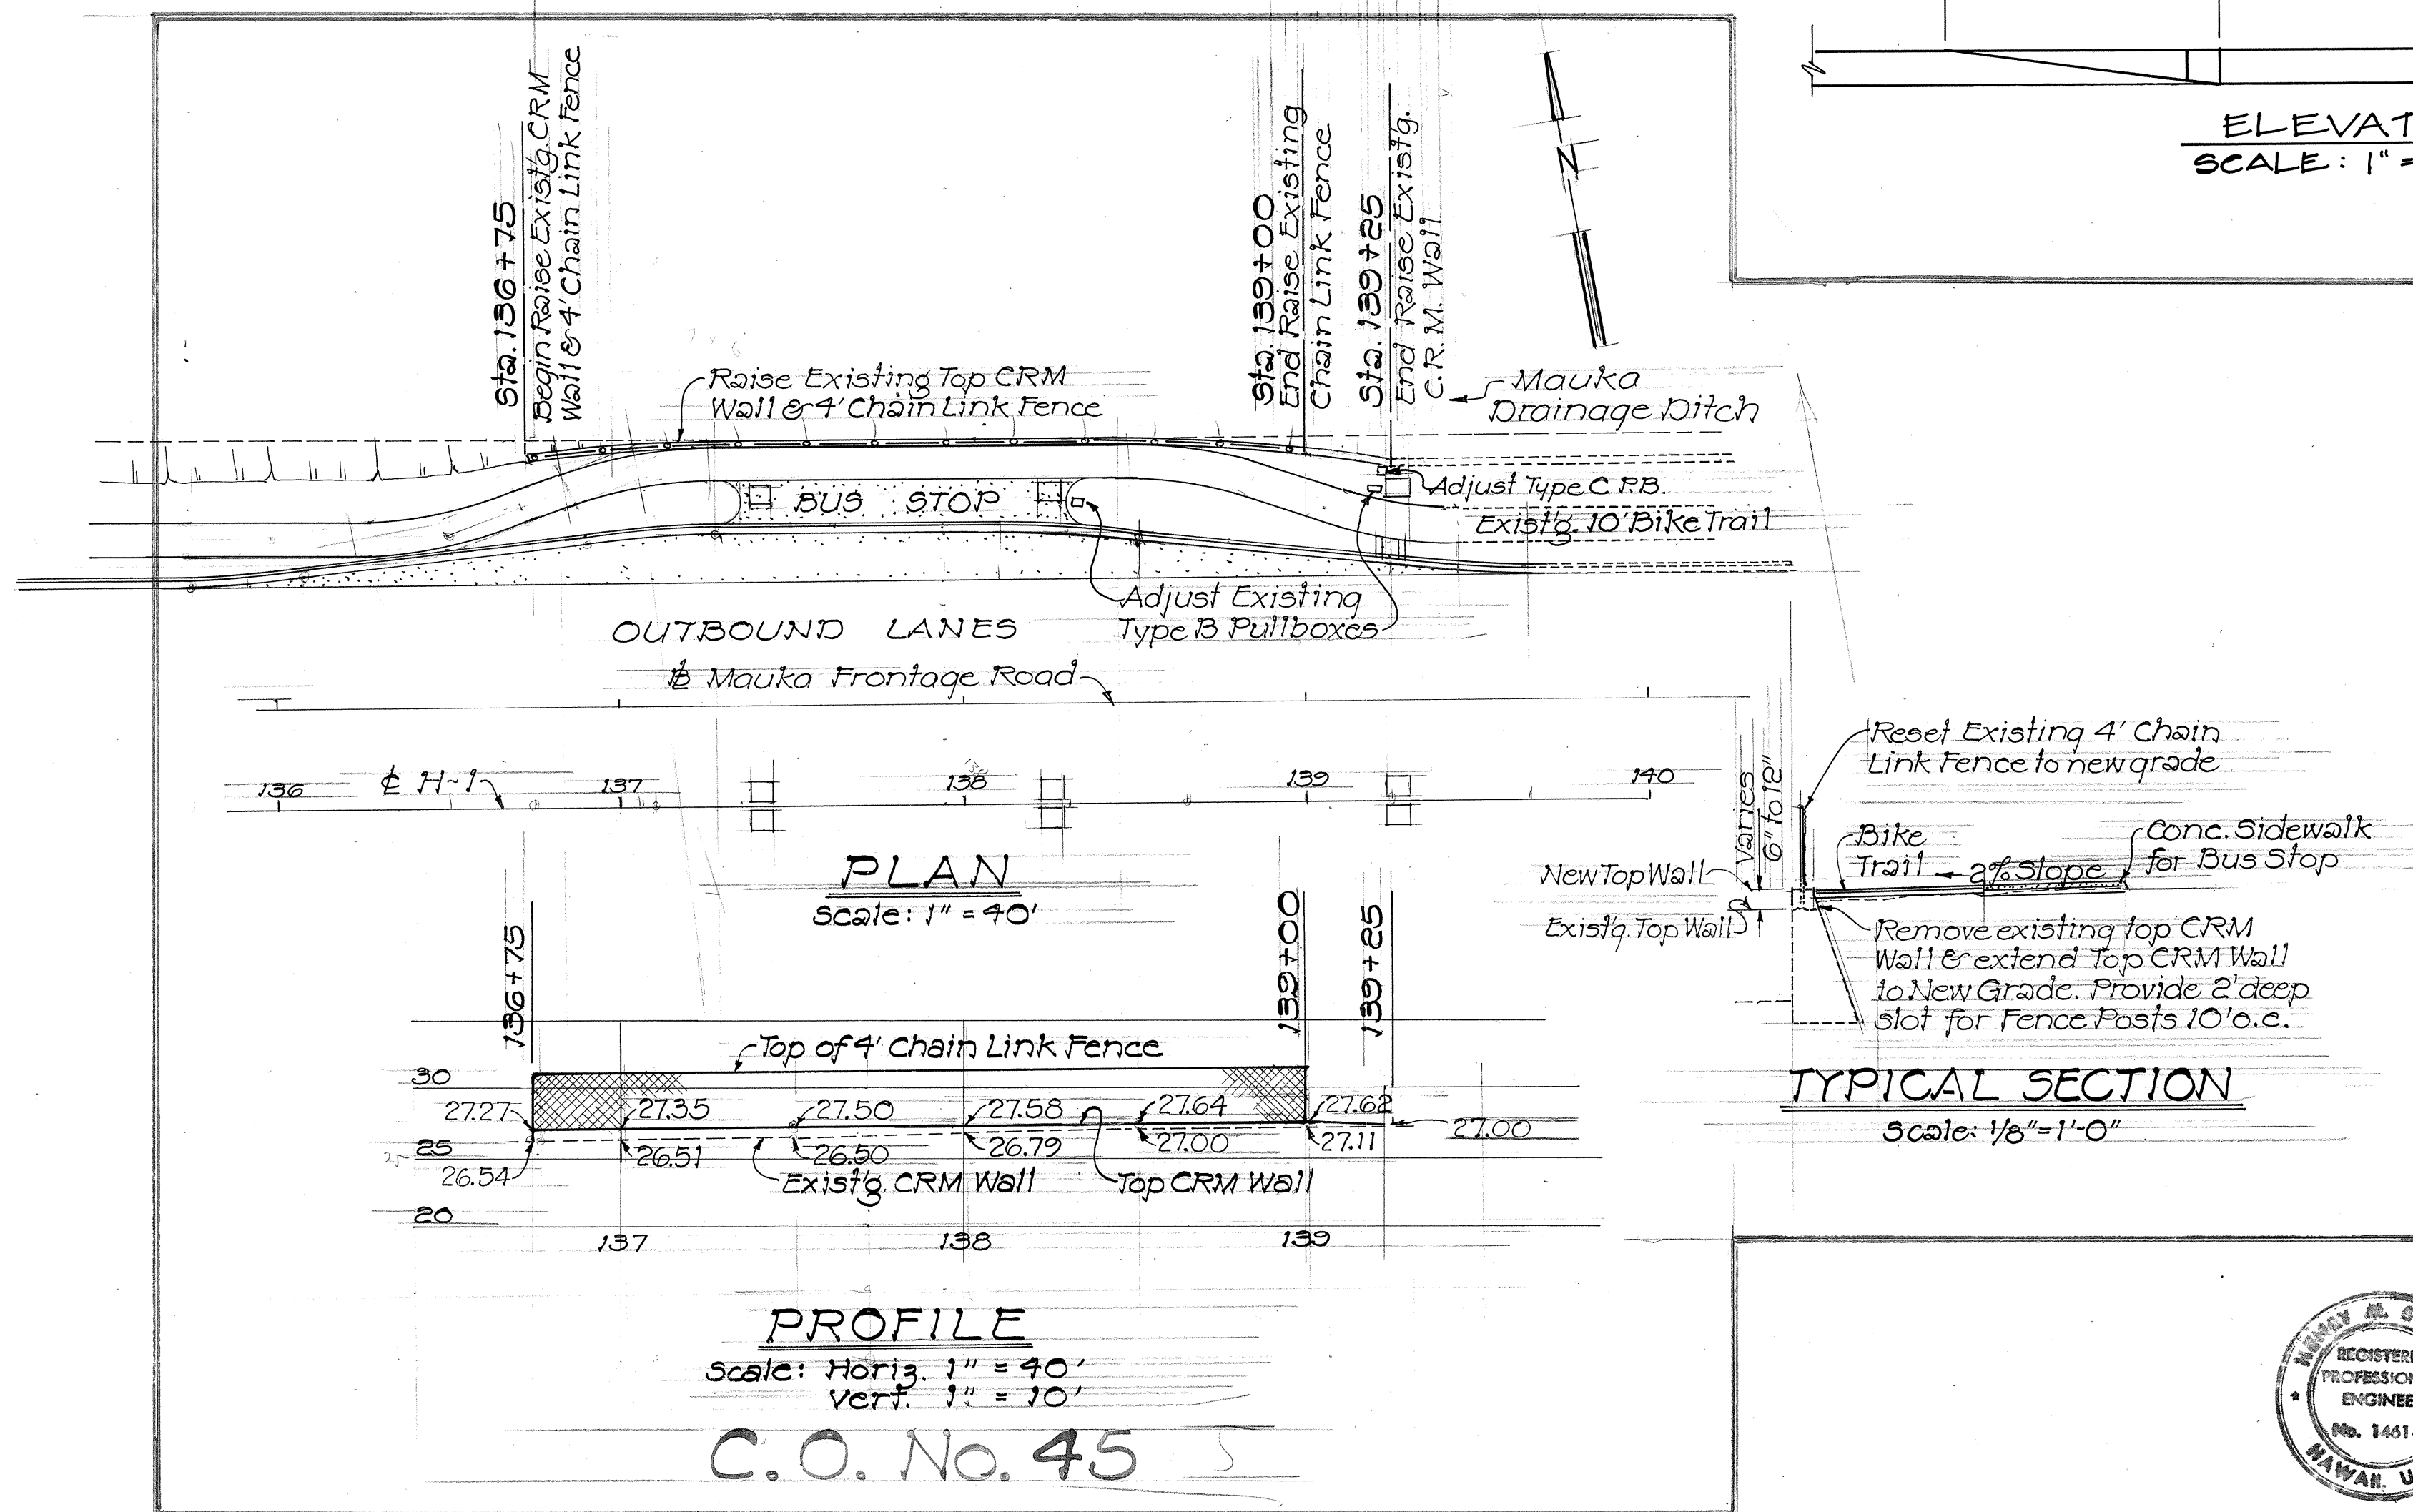

TYPICAL SECTION
Scale: 1/8" = 1'-0"

PROFILE
Scale: Horiz. 1" = 40'
Vert. 1" = 10'

C.O. No. 45

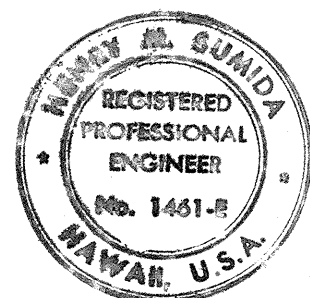

STATE OF HAWAII
DEPARTMENT OF TRANSPORTATION
LAND TRANSPORTATION FACILITIES DIVISION
TYPICAL INSTALLATION
OF
WHEEL CHAIR RAMPS

AIRPORT INTERCHANGE
F.A.I. PROJ. NO. I-HI-1(156)-16

SCALE: AS SHOWN DATE: AUG. 9, 1978
SHEET NO. 1 OF 1 SHEETS

THIS WORK WAS PREPARED BY
ME OR UNDER MY SUPERVISION
Randy R. Gunda

NO.	DATE	REVISION
1	8-28-79	Added Tactile Warning Signal at Wheel Chair Ramp

SURVEY PLOTTED BY	DATE
DRAWN BY	
DESIGNED BY	
CHECKED BY	
ORIGINAL PLAN	
NOTE BOOK	
NO.	