


FED. ROAD DIST. NO.	STATE	FED. AID PROJ. NO.	FISCAL YEAR	SHEET NO.	TOTAL SHEETS
HAWAII	HAW.	I-HI-1(172):16	1981	20	24

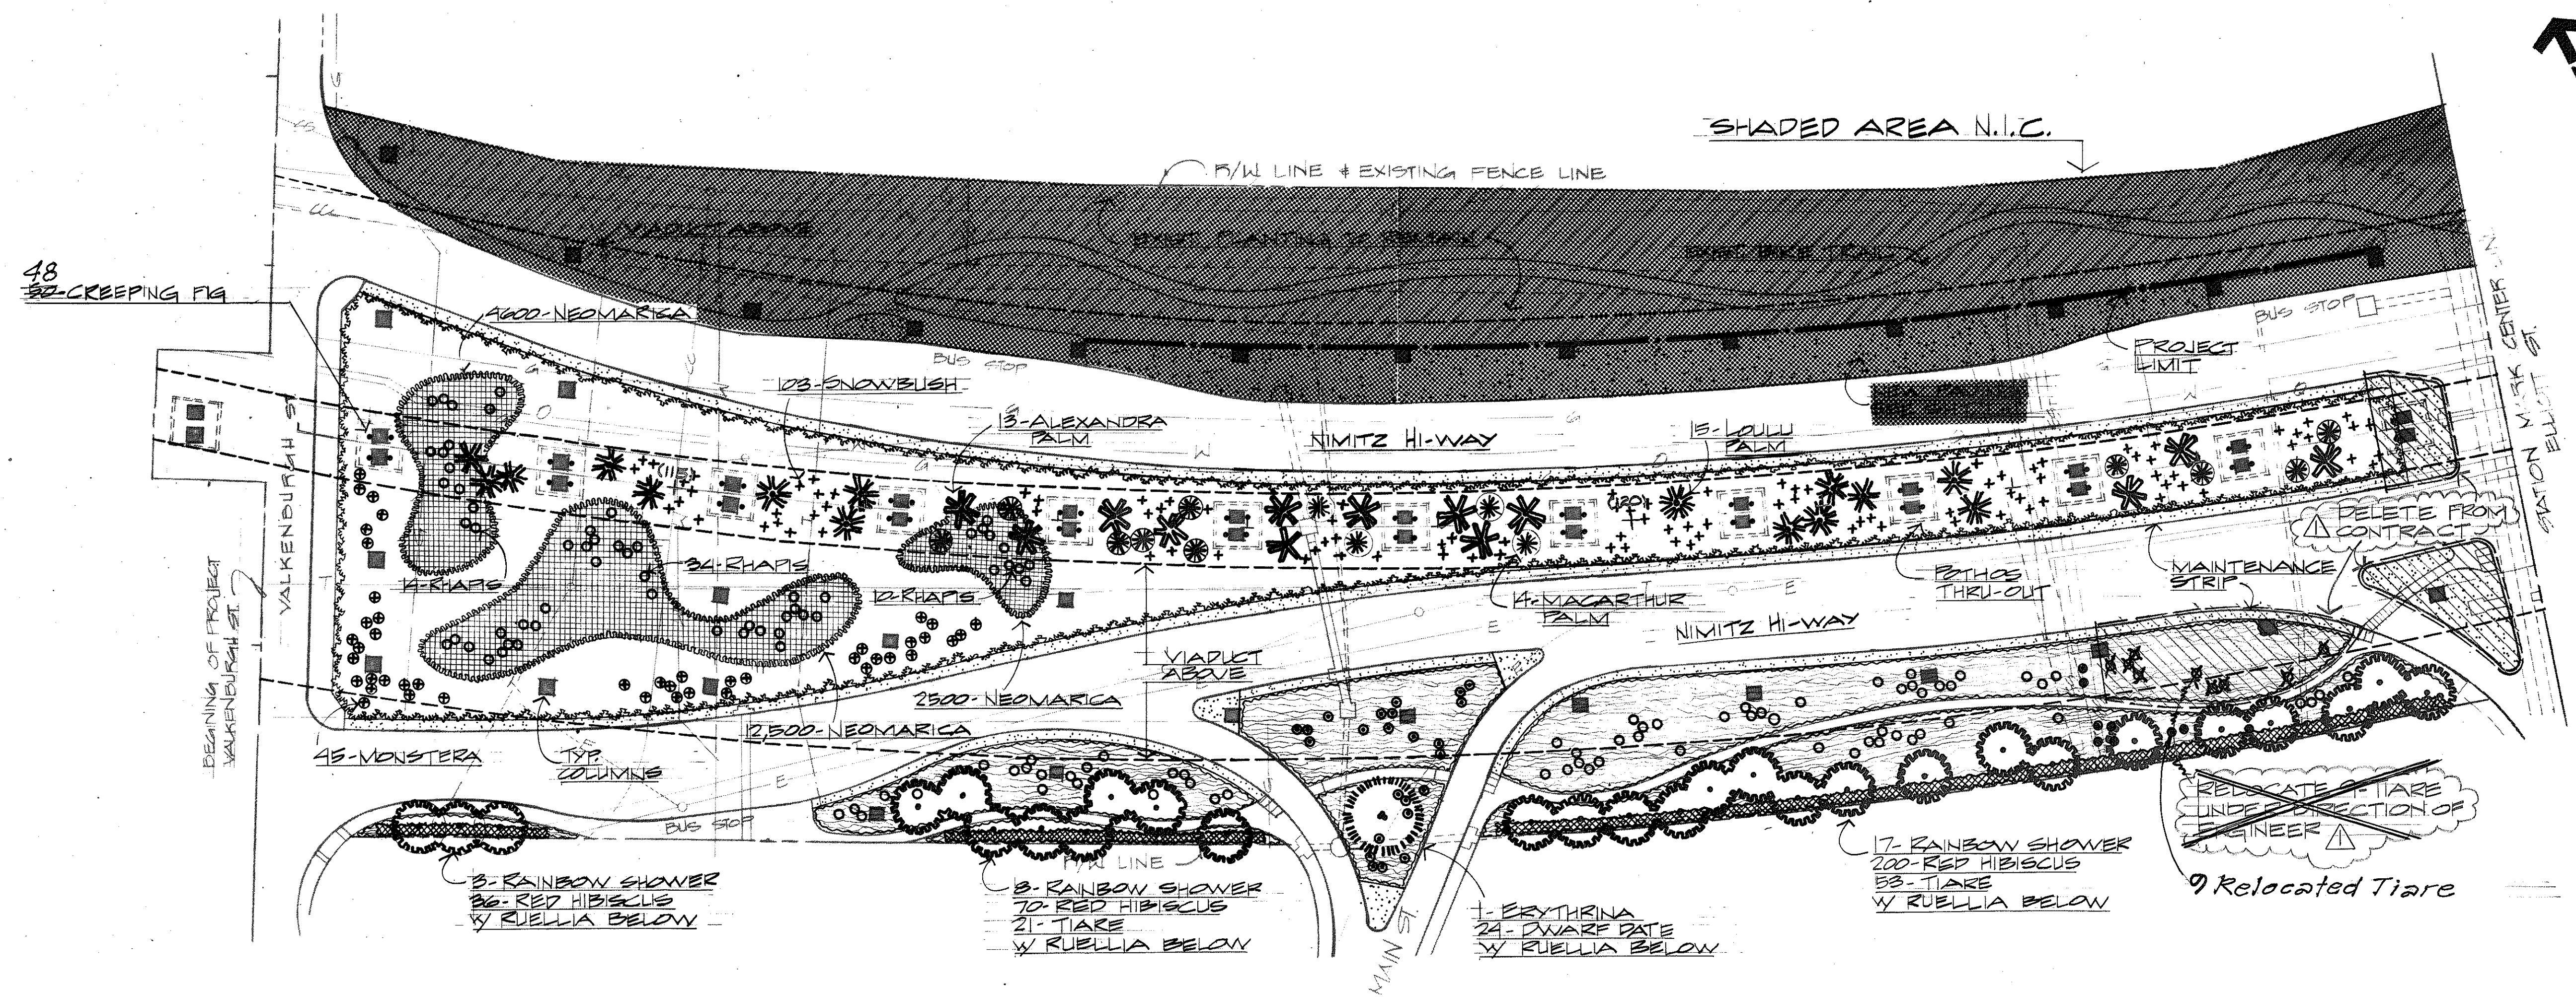


UTILITY LEGEND

S	SANITARY SEWER
SS	STORM SEWER
W	WATER LINE
G	GAS LINE
O	OIL LINE
C	COMMUNICATION CABLE
E	ELECTRIC DUCTLINE
T	TELEPHONE DUCTLINE
V	MANHOLE VALVE BOX
A	ABANDONED LINE


PARTIAL PLANTING PLAN
SCALE = 1" = 50'

ORIGINAL PLAN	DATE
SURVEY PLOTTED BY	
DRAWN BY	
DESIGNED BY	
QUANTITIES BY	
CHECKED BY	

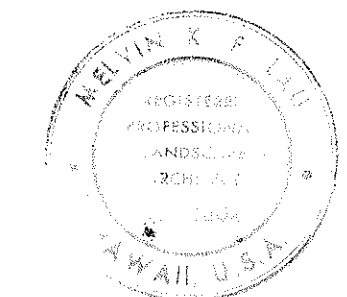 THIS WORK WAS PREPARED BY ME OR UNDER MY SUPERVISION <i>Kevin K. F. Lee</i> Signature	8/24/82 DATE	DELETE PART OF PLANTING REVISION
	STATE OF HAWAII DEPARTMENT OF TRANSPORTATION LAND TRANSPORTATION FACILITIES DIVISION PLANTING PLAN AIRPORT INTERCHANGE ROADWAY LANDSCAPING F.A.I. PROJ. NO. I-HI-1(172):16 SCALE AS SHOWN DATE: 8-31-1981 SHEET NO. 19 OF 24 SHEETS	

FED. ROAD DIST. NO.	STATE	FED. AID PROJ. NO.	FISCAL YEAR	SHEET NO.	TOTAL SHEETS
HAWAII	HAW.	I-HI-1(172):16	1981	21	24

SHADED AREA N.I.C.

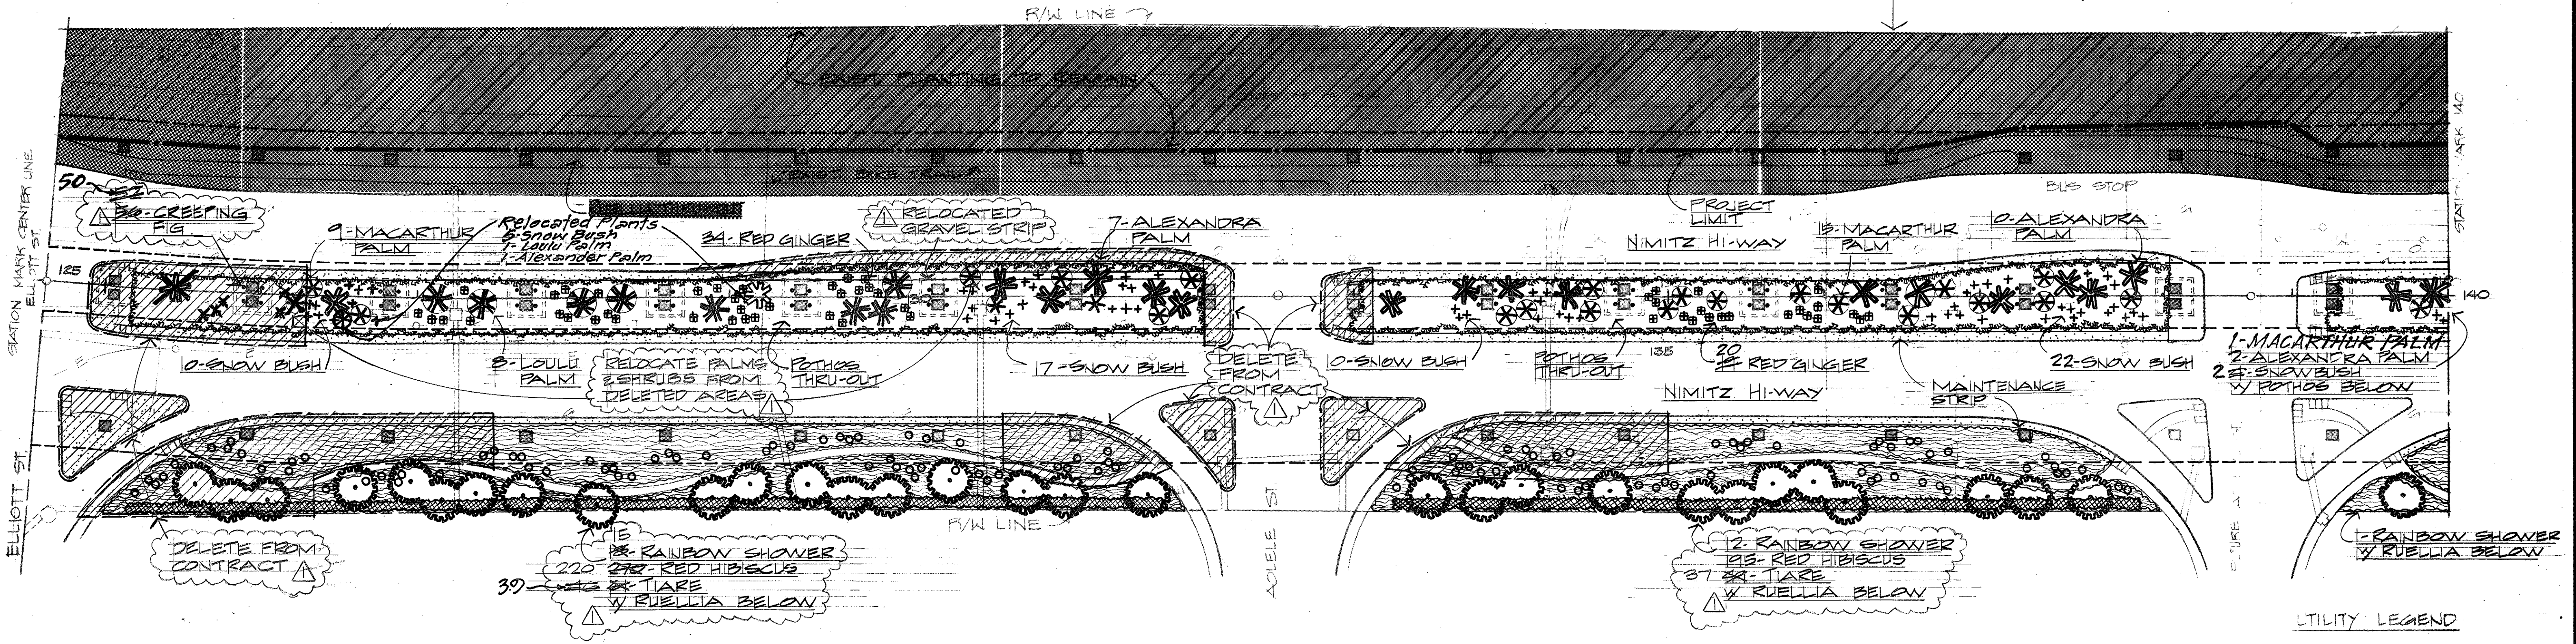

PARTIAL PLANTING PLAN
SCALE: 1"=50'

UTILITY LEGEND


—S—	SANITARY SEWER
—SS—	STORM SEWER
—W—	WATER LINE
—G—	GAS LINE
—O—	OIL LINE
—CC—	COMMUNICATION CABLE
—E—	ELECTRIC DUCTLINE
—T—	TELEPHONE DUCTLINE
—M—	MANHOLE VALVE BOX
---	ABANDONED LINE
---	IRRIGATION PIPE

ORIGINAL PLAN	SURVEY PLOTTED BY	DATE
NOTE BOOK	DRAWN BY	
No.	TRACED BY	
	QUANTITIES BY	
	CHECKED BY	

	8/24/82 DATE	DELETE PART OF PLANTING REVISION
	STATE OF HAWAII DEPARTMENT OF TRANSPORTATION LAND TRANSPORTATION FACILITIES DIVISION	
	PLANTING PLAN AIRPORT INTERCHANGE ROADWAY LANDSCAPING F.A.I. PROJ. NO. I-HI-1(172):16 SCALE AS SHOWN DATE: 8-31-1981	

SHEET NO. 20 OF 24 SHEETS

FED. ROAD DIST. NO.	STATE	FED. AID PROJ. NO.	FISCAL YEAR	SHEET NO.	TOTAL SHEETS
HAWAII	HAW.	1-HI-1(172):16	1981	23	24

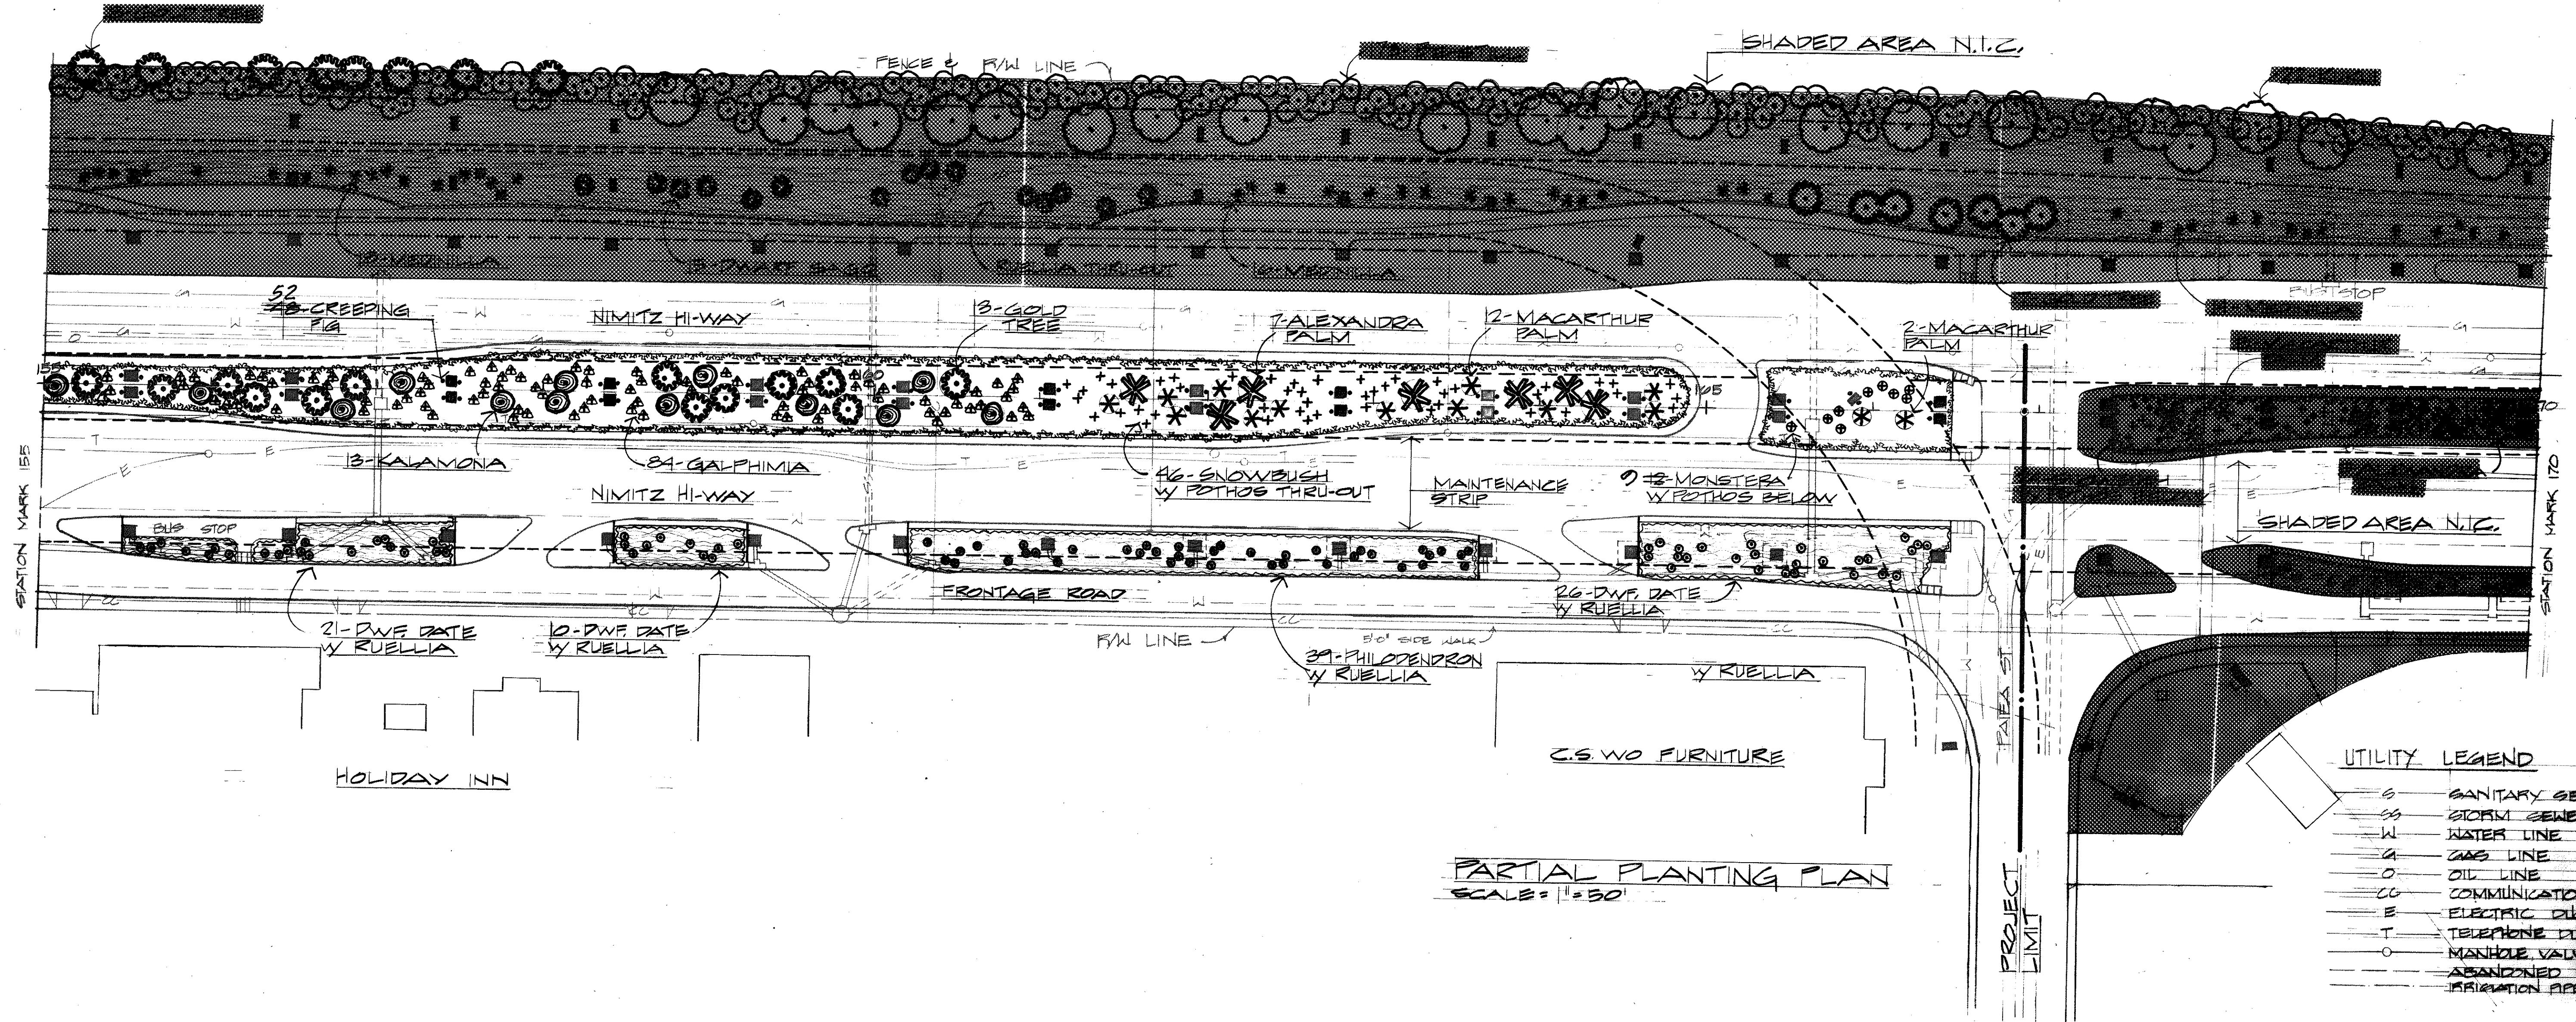

UTILITY LEGEND

S	SANITARY SEWER
SS	STORM SEWER
W	WATER LINE
G	GAS LINE
O	OIL LINE
CC	COMMUNICATION CABLE
E	ELECTRIC DUCTLINE
T	TELEPHONE DUCTLINE
M	MANHOLE VALVE BOX
A	ABANDONED LINE
I	IRRIGATION PIPE

DATE	
DESIGNED BY	
DRAWN BY	
CHECKED BY	
NOTED BY	
QUANTITY BY	
ORIGINAL PLAN	

STATE OF HAWAII
DEPARTMENT OF TRANSPORTATION
LAND TRANSPORTATION FACILITIES DIVISION

PLANTING PLAN

AIRPORT INTERCHANGE
ROADWAY LANDSCAPING
F.A.I. PROJ. NO. I-HI-1(172):16
SCALE AS SHOWN DATE: 8-31-1981

SHEET NO. 23 OF 24 SHEETS

THIS PLAN WAS PREPARED BY
ME OR UNDER MY SUPERVISION
[Signature]
Signature