



FED. ROAD DIST. NO.	STATE	FED. AID PROJ. NO.	FISCAL YEAR	SHEET NO.	TOTAL SHEETS
HAWAII	HAW.	I-H1-1(164):16	1981	2	30

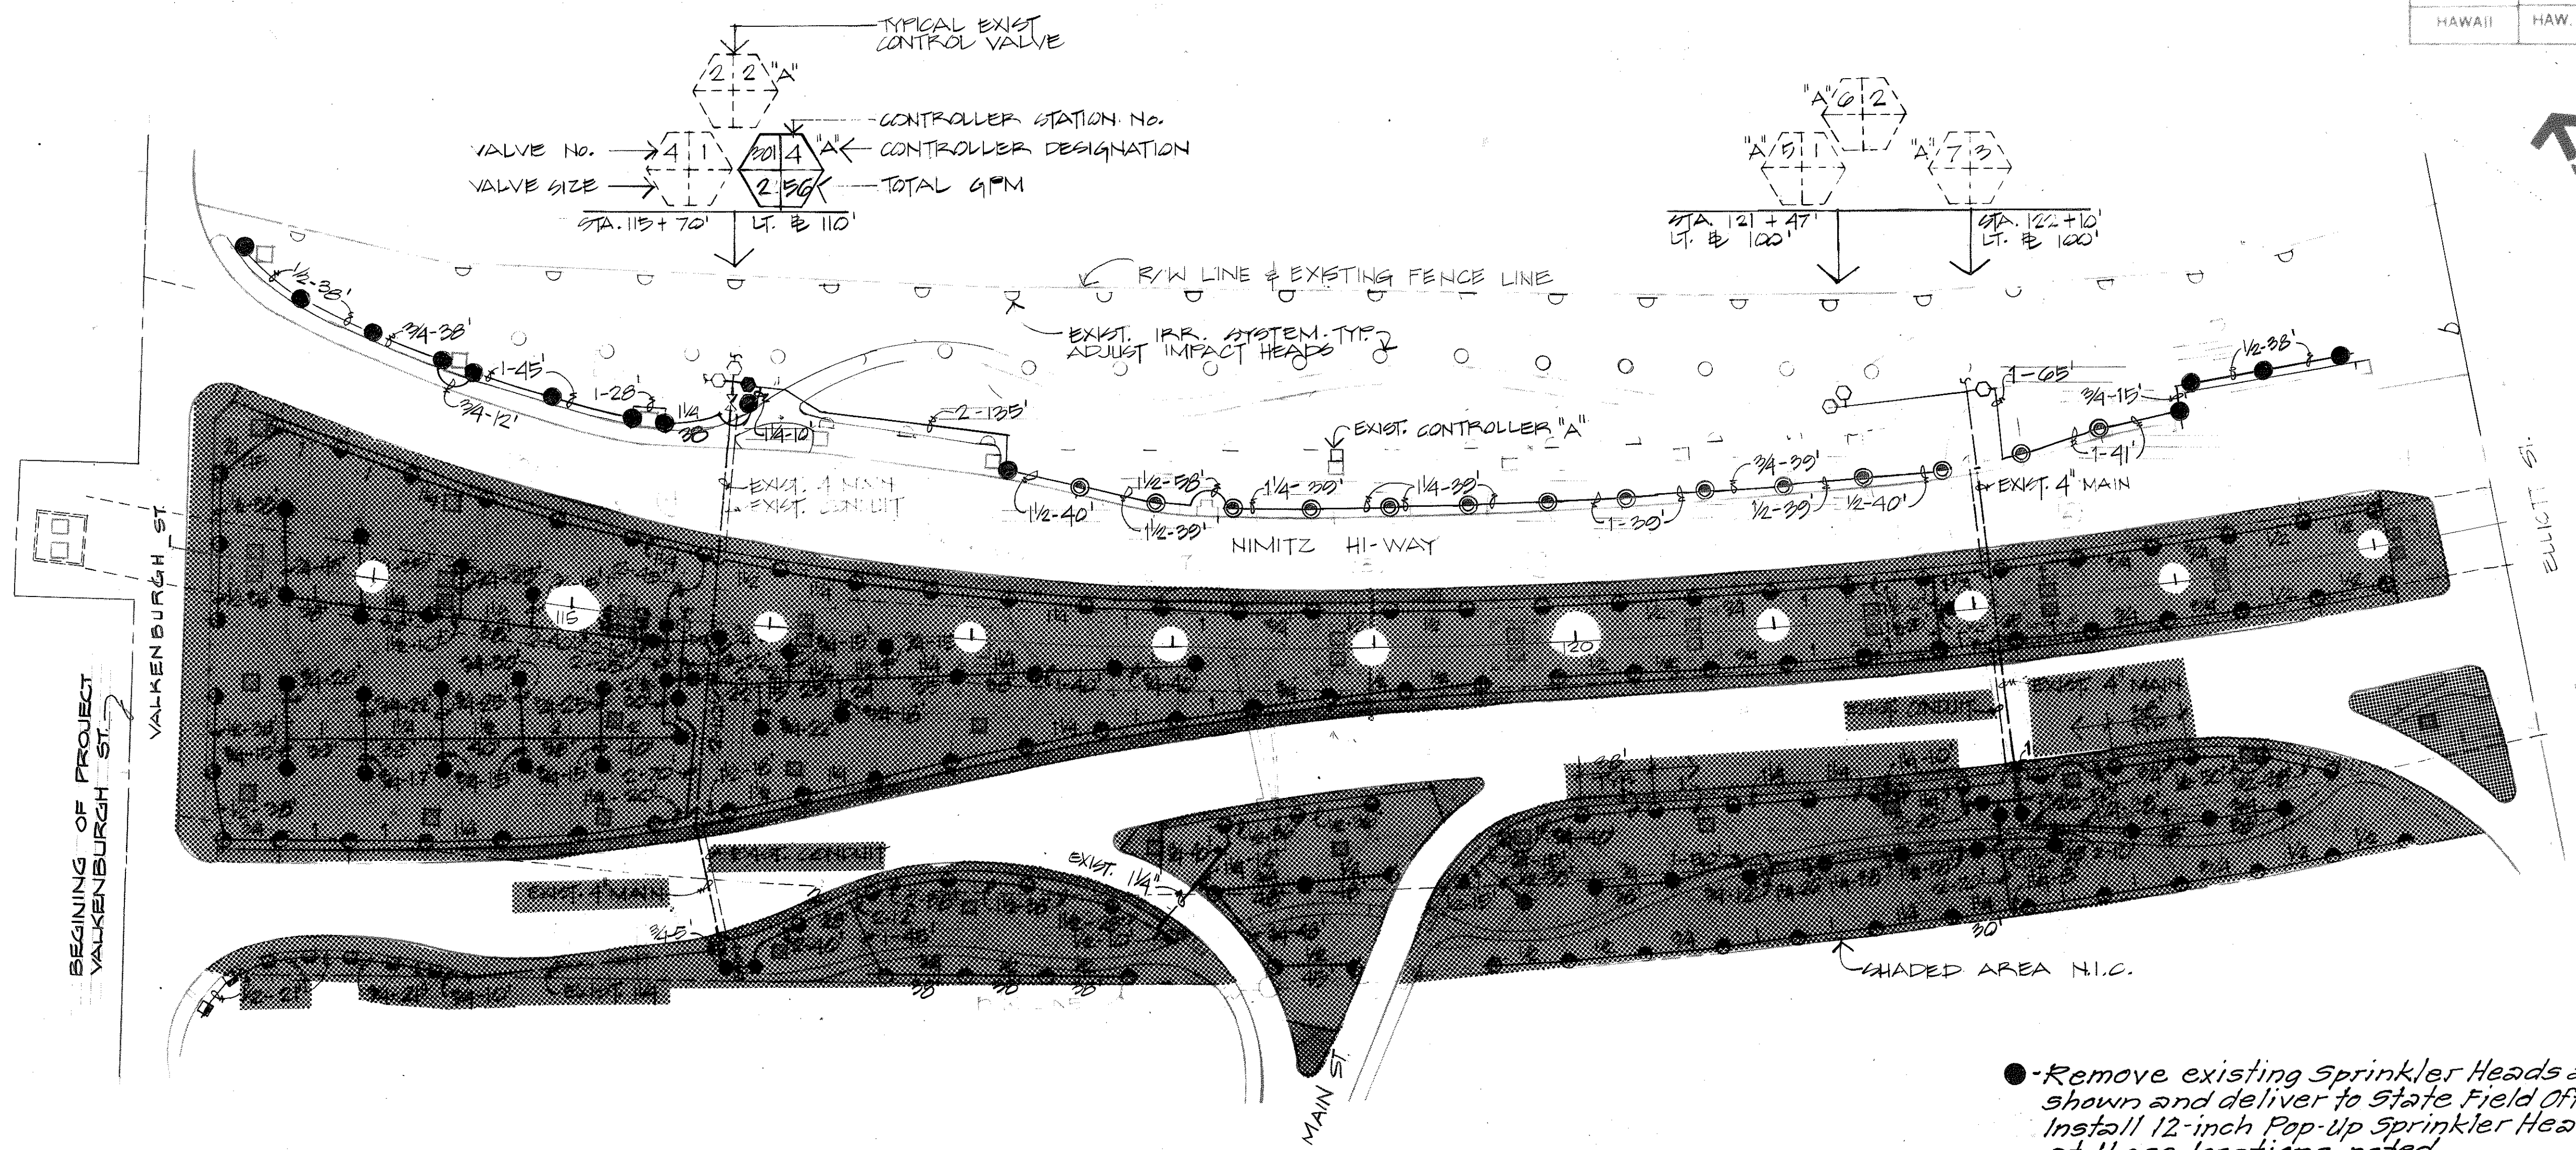

Remove existing Sprinkler Heads as shown and deliver to State Field Office. Install 12-inch Pop-Up Sprinkler Heads at those locations noted.

CHANGE ORDER No. 4

PARTIAL IRRIGATION PLAN
SCALE: 1" = 50'

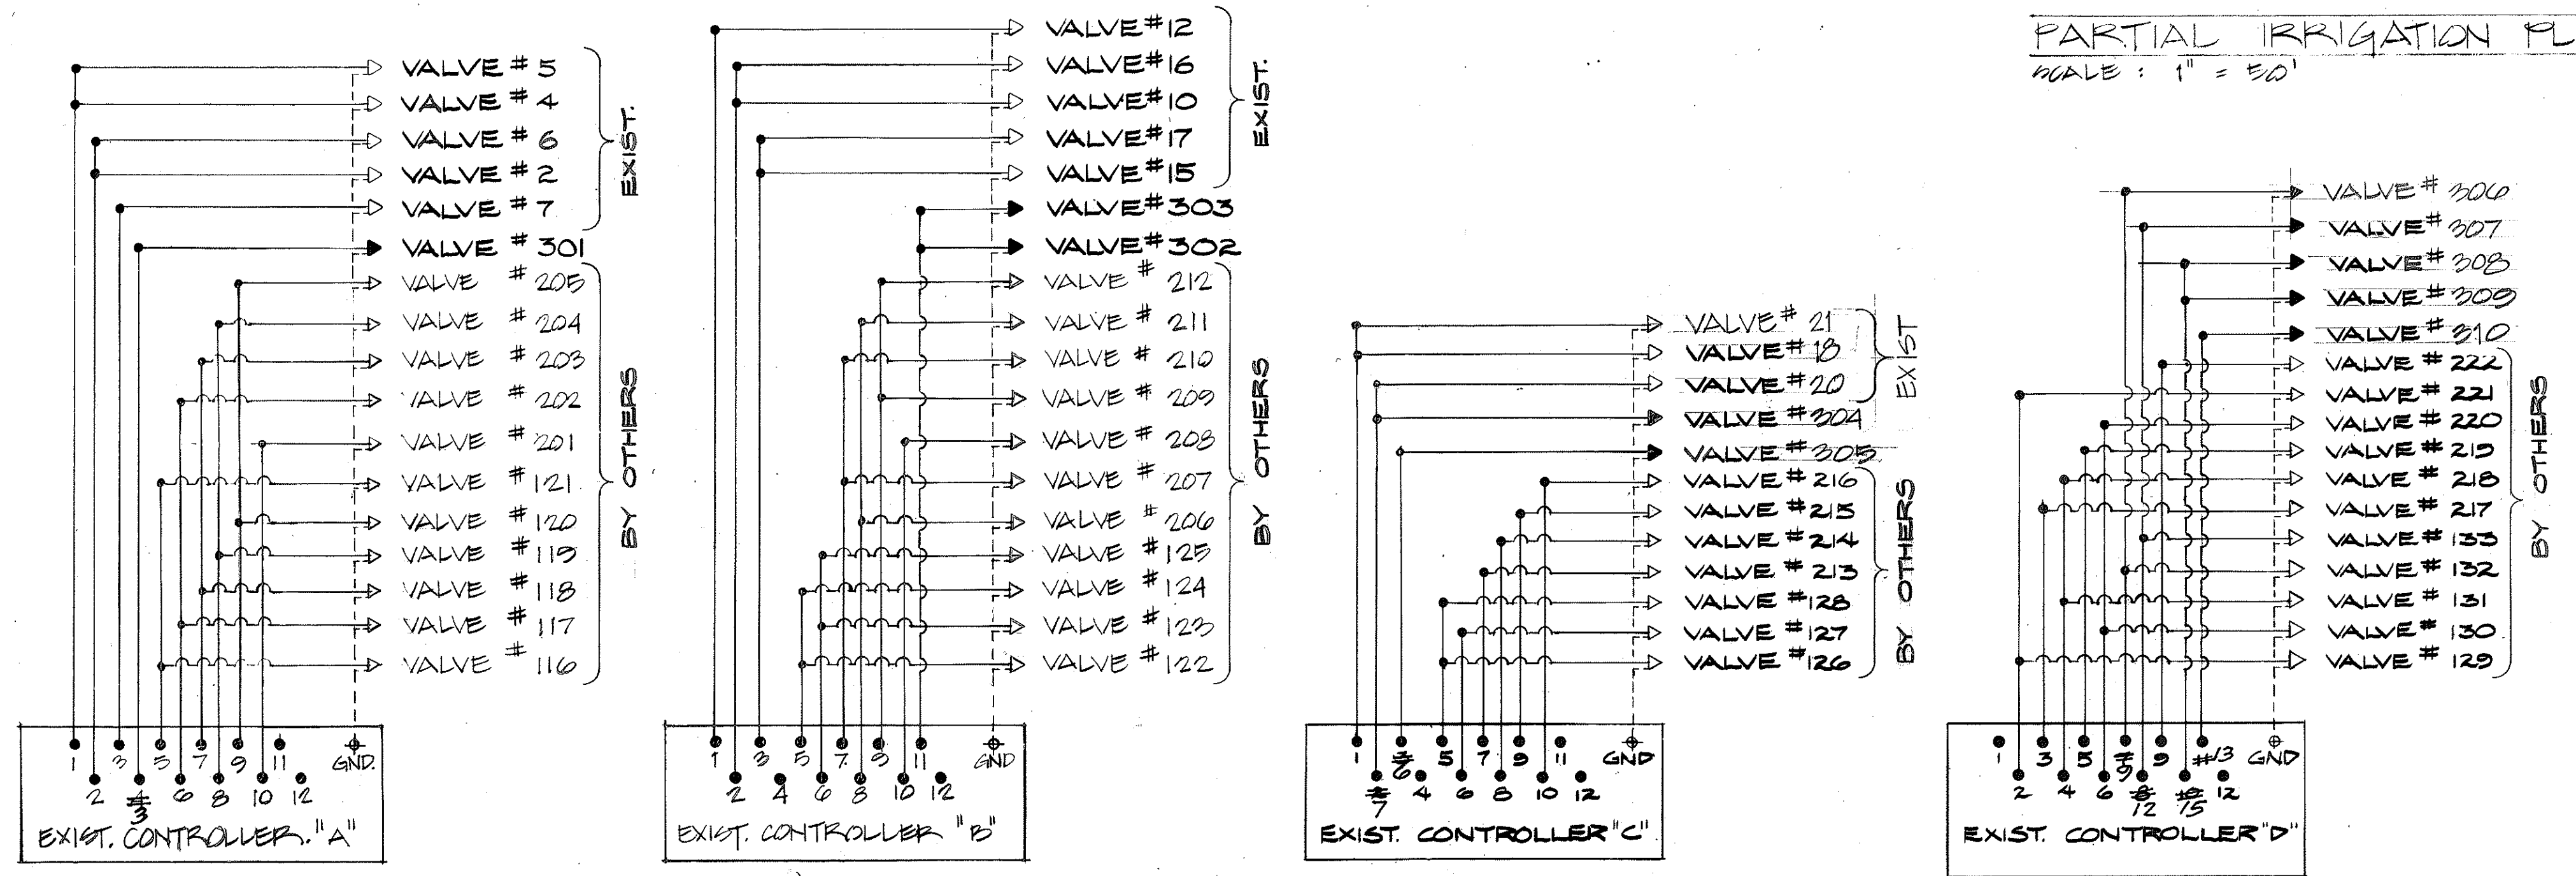

WIRING DIAGRAMS FOR IRRIGATION CONTROLLERS

MQ 10.7. Jan


STATE OF HAWAII
DEPARTMENT OF TRANSPORTATION
LAND TRANSPORTATION FACILITIES DIVISION

PARTIAL IRRIGATION PLAN
& WIRING DIAGRAMS
AIRPORT INTERCHANGE
ROADWAY LANDSCAPING
F.A.I. PROJ. No. I-H1-1(164):16
SCALE: AS SHOWN DATE: 9-14-1981

SHEET No. 1 OF 30 SHEETS

ORIGINAL PLAN	DATE
DESIGNED BY	
TRACED BY	
NOTED BY	
CHECKED BY	

FED. ROAD DIST. NO.	STATE	FED. AID PROJ. NO.	FISCAL YEAR	SHEET NO.	TOTAL SHEETS
HAWAII	HAW.	I-H-1(164):16	1981	3	30

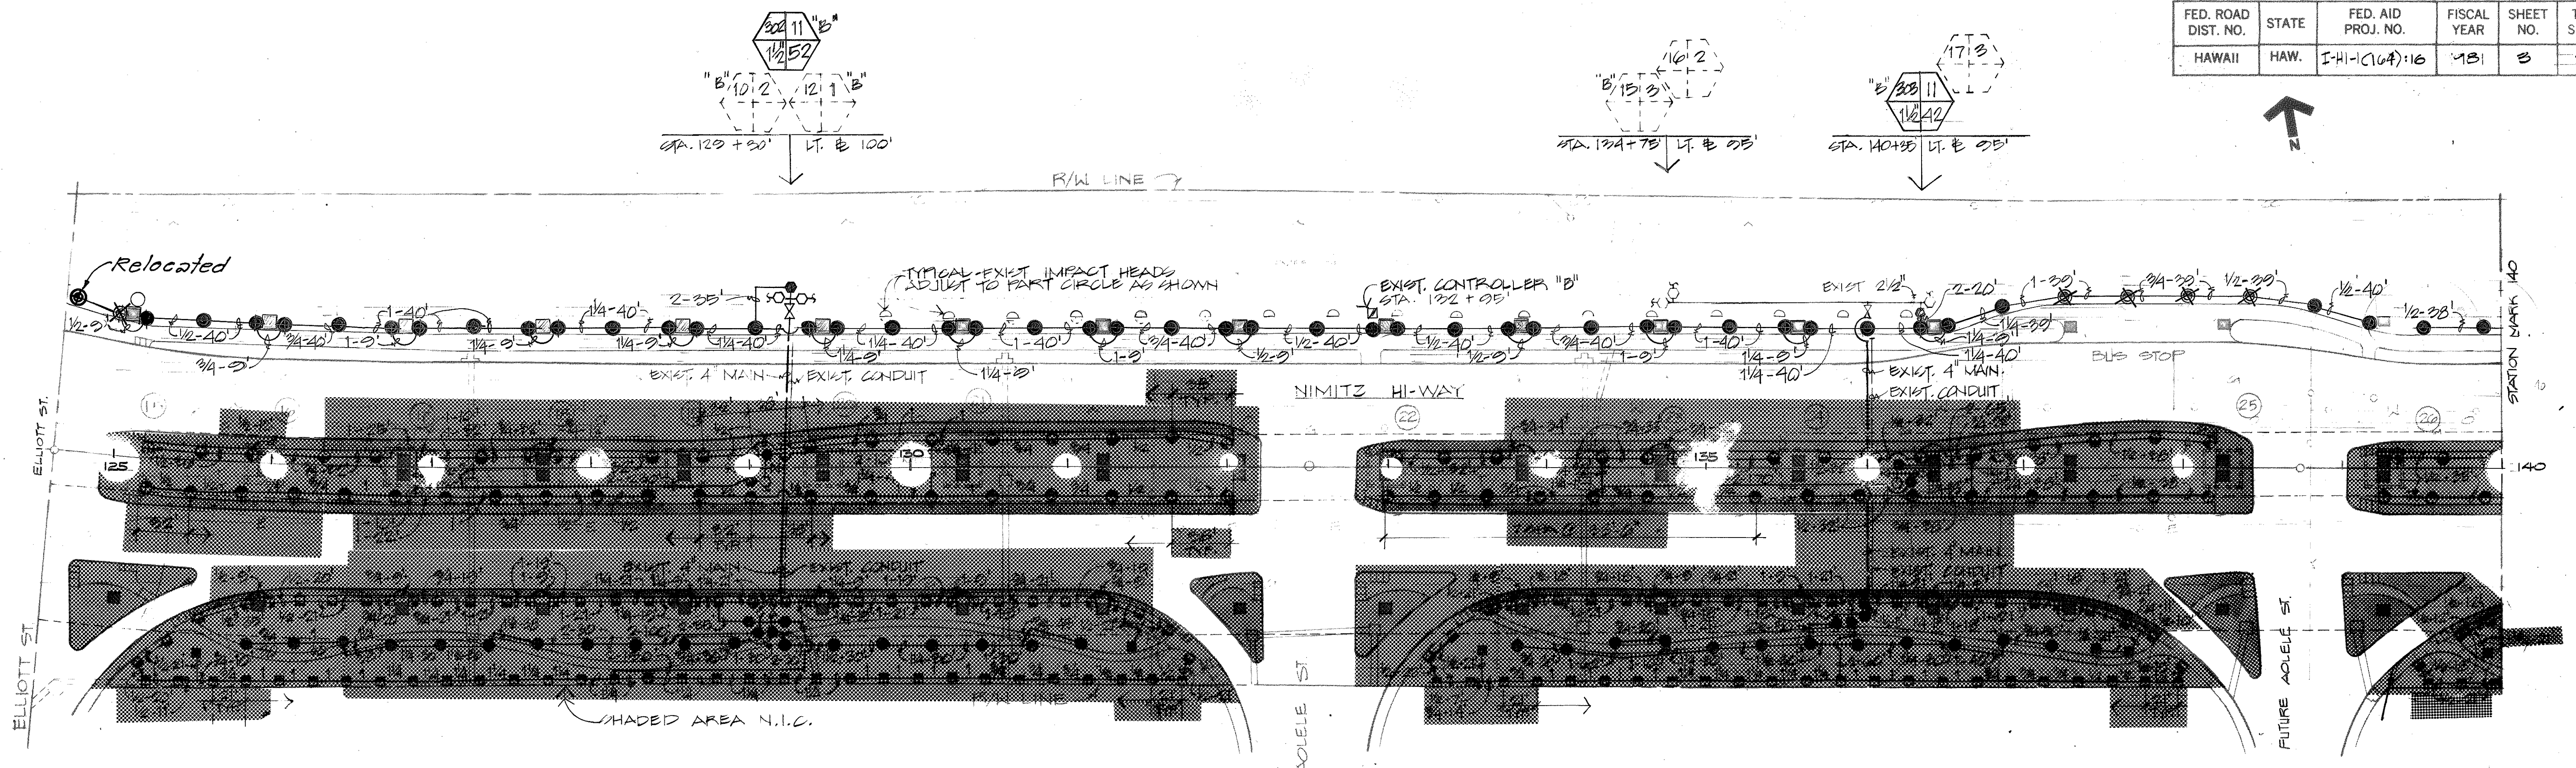


PARTIAL IRRIGATION PLAN
SCALE: 1" = 50'

- Remove existing Sprinkler Heads as shown and deliver to State Field Office.
- Install 12-inch pop-up Sprinkler Heads at those locations noted.

CHANGE ORDER NO. 4

UTILITY LEGEND

—S—	SANITARY SEWER
—SS—	STORM SEWER
—W—	WATER LINE
—G—	GAS LINE
—O—	OIL LINE
—C—	COMMUNICATION CABLE
—E—	ELECTRIC DUCTLINE
—T—	TELEPHONE DUCTLINE
—M—	MANHOLE VALVE BOX
—A—	ABANDONED LINE
—IR—	IRRIGATION PIPE

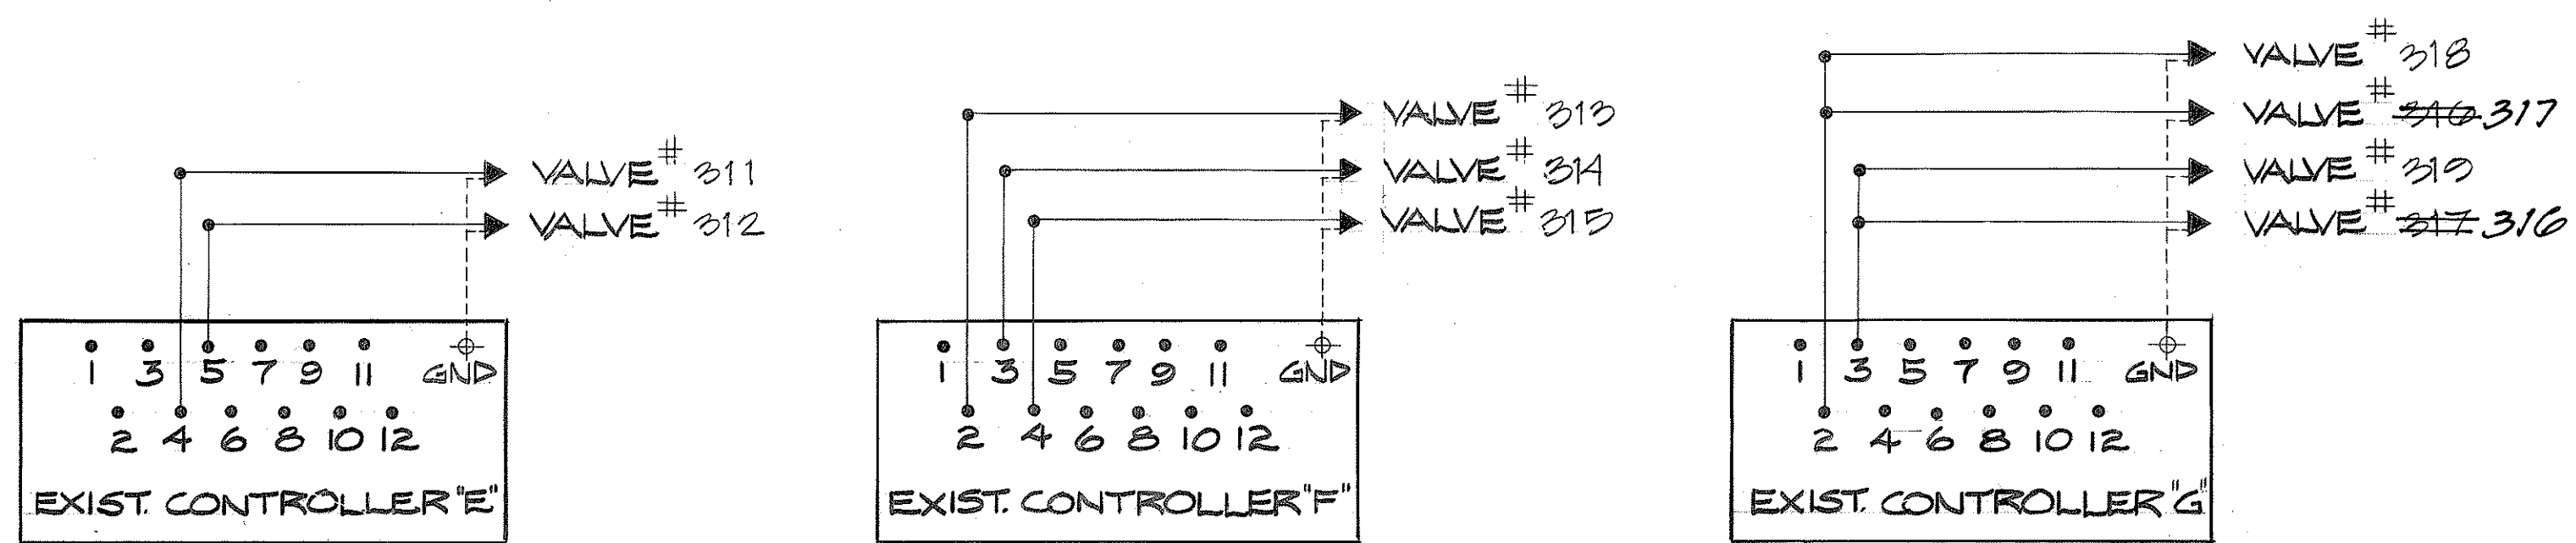

WIRING DIAGRAMS FOR IRRIGATION CONTROLLERS




STATE OF HAWAII
DEPARTMENT OF TRANSPORTATION
LAND TRANSPORTATION FACILITIES DIVISION

PARTIAL IRRIGATION PLAN & WIRING DIAGRAMS

AIRPORT INTERCHANGE
ROADWAY LANDSCAPING
F.A.I. PROJ. NO. I-H-1(164):16
SCALE: AS SHOWN DATE: 9-14-81

SHEET NO. 2 OF 30 SHEETS

DESIGNED BY	DATE
DRAWN BY	
CHECKED BY	
NOTED BY	
ORIGINAL PLAN	

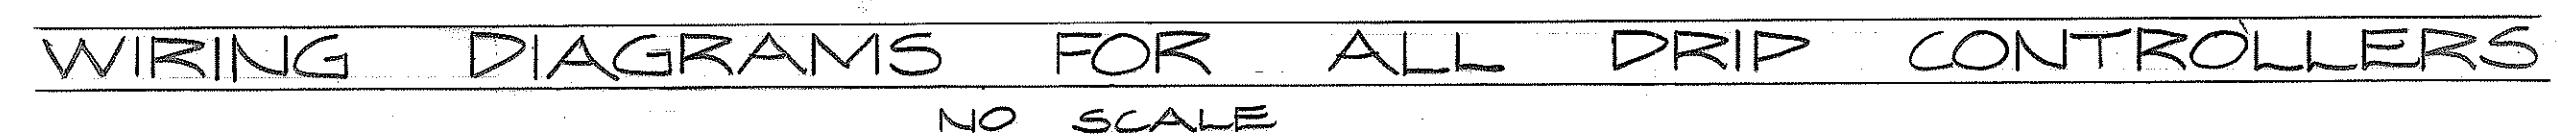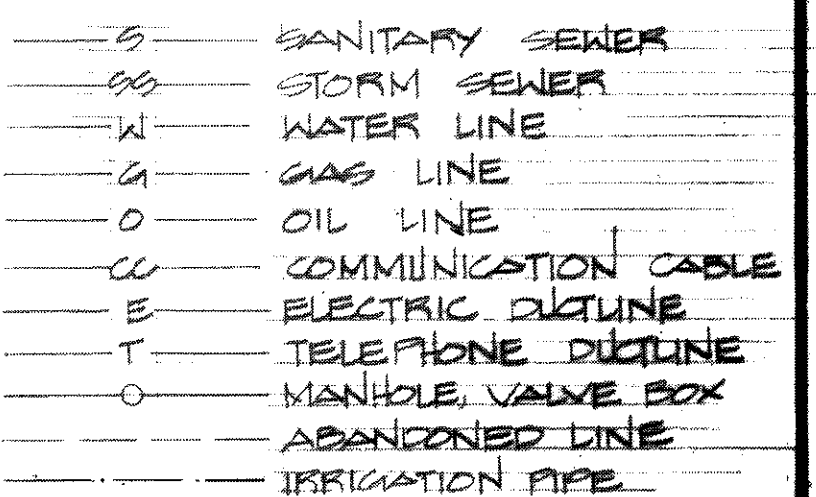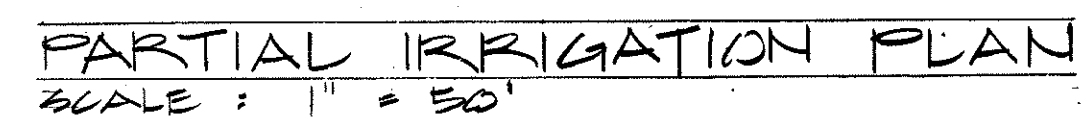

CHANGE ORDER NO. 4


DROP IRRIGATION PROGRAM

SHEET NO. 15 OF 30 SHEETS

THIS WORK WAS PREPARED BY
ME OR UNDER MY SUPERVISION.
Michael J. F. Long
Signature

ORIGINAL PLAN	SURVEY PLOTTED BY	DATE
	DRAWN BY	
	TRACED BY	
NOTE BOOK	DESIGNED BY	
	QUANTITIES BY	
No.	CHECKED BY	

FED. ROAD DIST. NO.	STATE	FED. AID PROJ. NO.	FISCAL YEAR	SHEET NO.	TOTAL SHEETS
HAWAII	HAW.	I-H-1-1(164)-16	1981	7	30

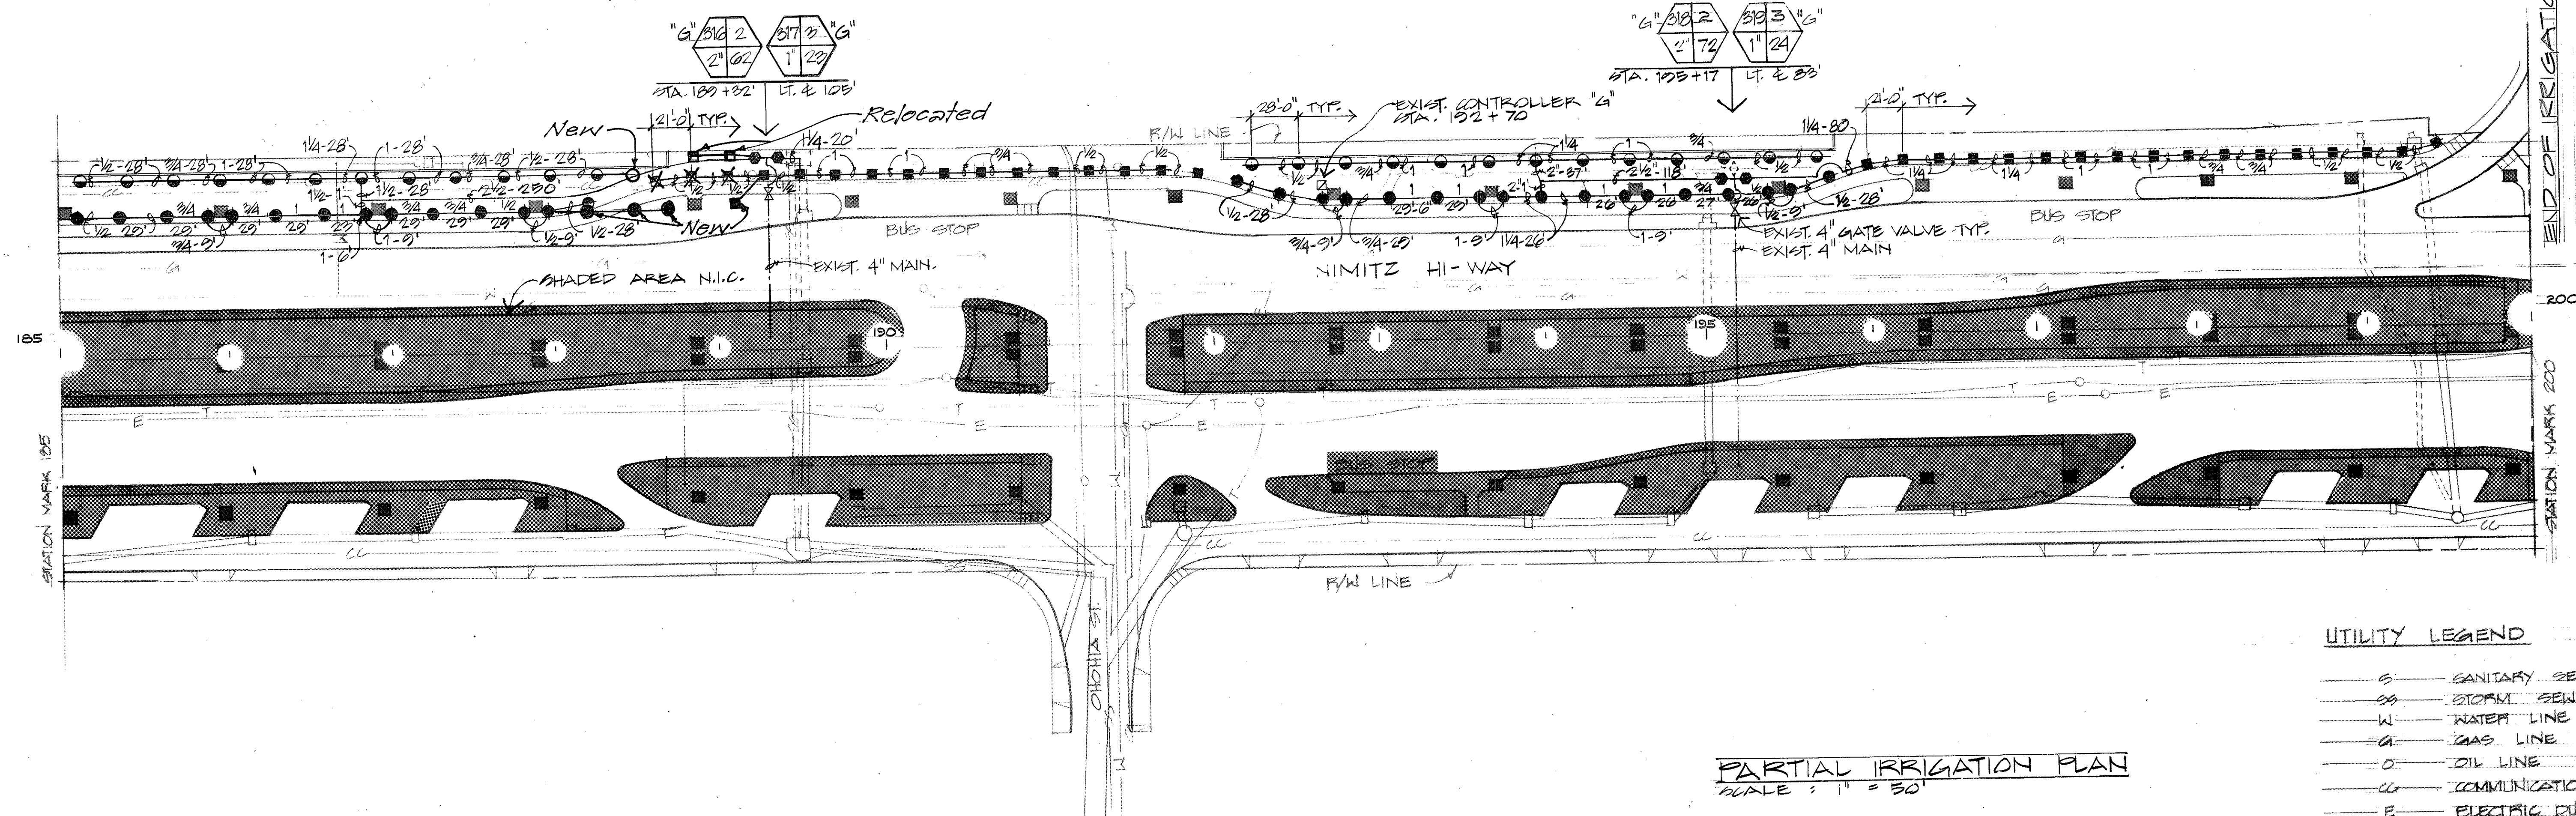

UTILITY LEGEND

—S—	SANITARY SEWER
—SS—	STORM SEWER
—W—	WATER LINE
—G—	GAS LINE
—O—	OIL LINE
—C—	COMMUNICATION CABLE
—E—	ELECTRIC DUCTLINE
—T—	TELEPHONE DUCTLINE
—O—	MANHOLE VALVE BOX
—	ABANDONED LINE
—	IRRIGATION PIPE

PARTIAL IRRIGATION PLAN
SCALE: 1" = 50'

● ■ Remove existing Sprinkler Heads as shown and delivered to State Field Office. Install 12-inch pop-up Sprinkler Heads at those locations noted.

CHANGE ORDER NO. 4

ORIGINAL PLAN	DATE
DRAWN BY	
DESIGNED BY	
CHECKED BY	
NOTED BY	
NO.	

STATE OF HAWAII
DEPARTMENT OF TRANSPORTATION
LAND TRANSPORTATION FACILITIES DIVISION

PARTIAL IRRIGATION PLAN

AIRPORT INTERCHANGE
ROADWAY LANDSCAPING
F.A.I. PROJ. No I-H-1-1 (164)-16
SCALE: AS SHOWN DATE: 9-14-81

SHEET NO. 16 OF 30 SHEETS

THIS WORK WAS
PREPARED UNDER MY SUPERVISION

Mr. K. J. [Signature]
Signature