


FED. ROAD DIST. NO.	STATE	FED. AID PROJ. NO.	FISCAL YEAR	SHEET NO.	TOTAL SHEETS
HAWAII	HAW.	I-164:16	1981	24	30

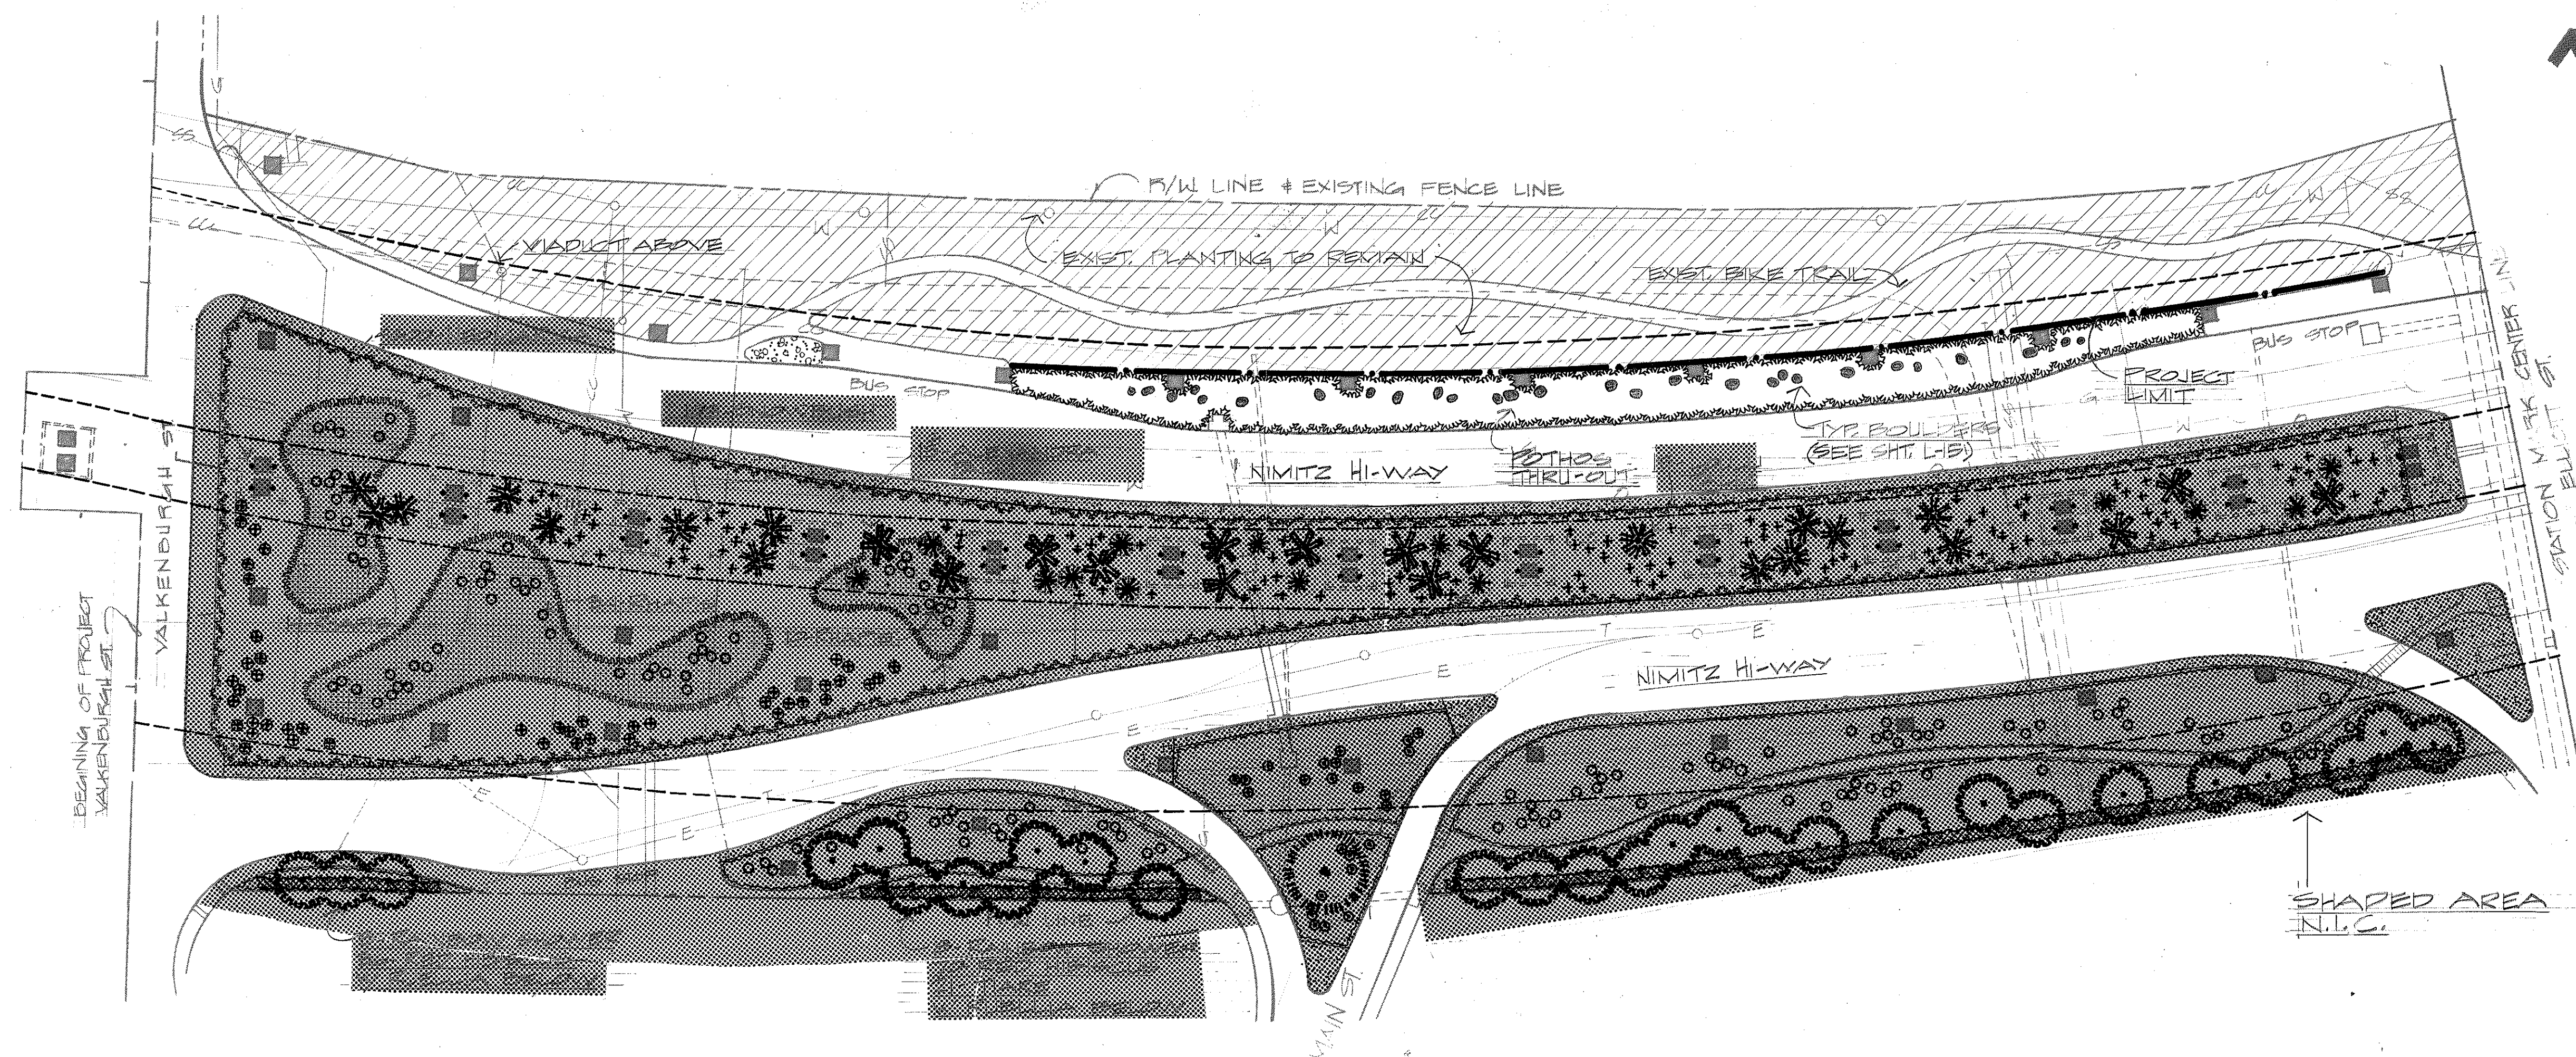


UTILITY LEGEND

S	SANITARY SEWER
SS	STORM SEWER
W	WATER LINE
G	GAS LINE
O	OIL LINE
C	COMMUNICATION CABLE
E	ELECTRIC DUCTLINE
T	TELEPHONE DUCTLINE
O	MANHOLE, VALVE BOX
- - -	ABANDONED LINE
- - -	IRRIGATION PIPE

PARTIAL PLANTING PLAN
SCALE = 1" = 50'

ORIGINAL PLAN	SURVEY PLOTTED BY	DATE
NOTE BOOK	DRAWN BY	
No.	DESIGNED BY	
	QUANTITIES BY	
	CHECKED BY	

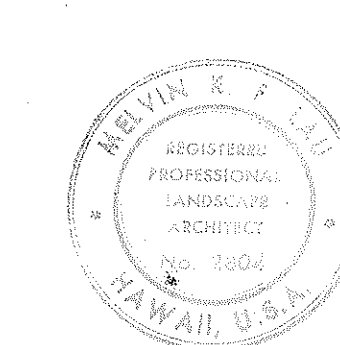

THIS WORK WAS PREPARED
BY ME OR UNDER MY SUPERVISION
Kevin K. P. O'Neil
Signature


STATE OF HAWAII
DEPARTMENT OF TRANSPORTATION
LAND TRANSPORTATION FACILITIES DIVISION

PLANTING PLAN

AIRPORT INTERCHANGE
ROADWAY LANDSCAPING
F.A.I. PROJ. NO. I-HI-1(164):16
SCALE AS SHOWN DATE: 9-14-81

SHEET NO. 23 OF 30 SHEETS

FED. ROAD DIST. NO.	STATE	FED. AID PROJ. NO.	FISCAL YEAR	SHEET NO.	TOTAL SHEETS
HAWAII	HAW.	I-HI-1(164):16	1981	25	30

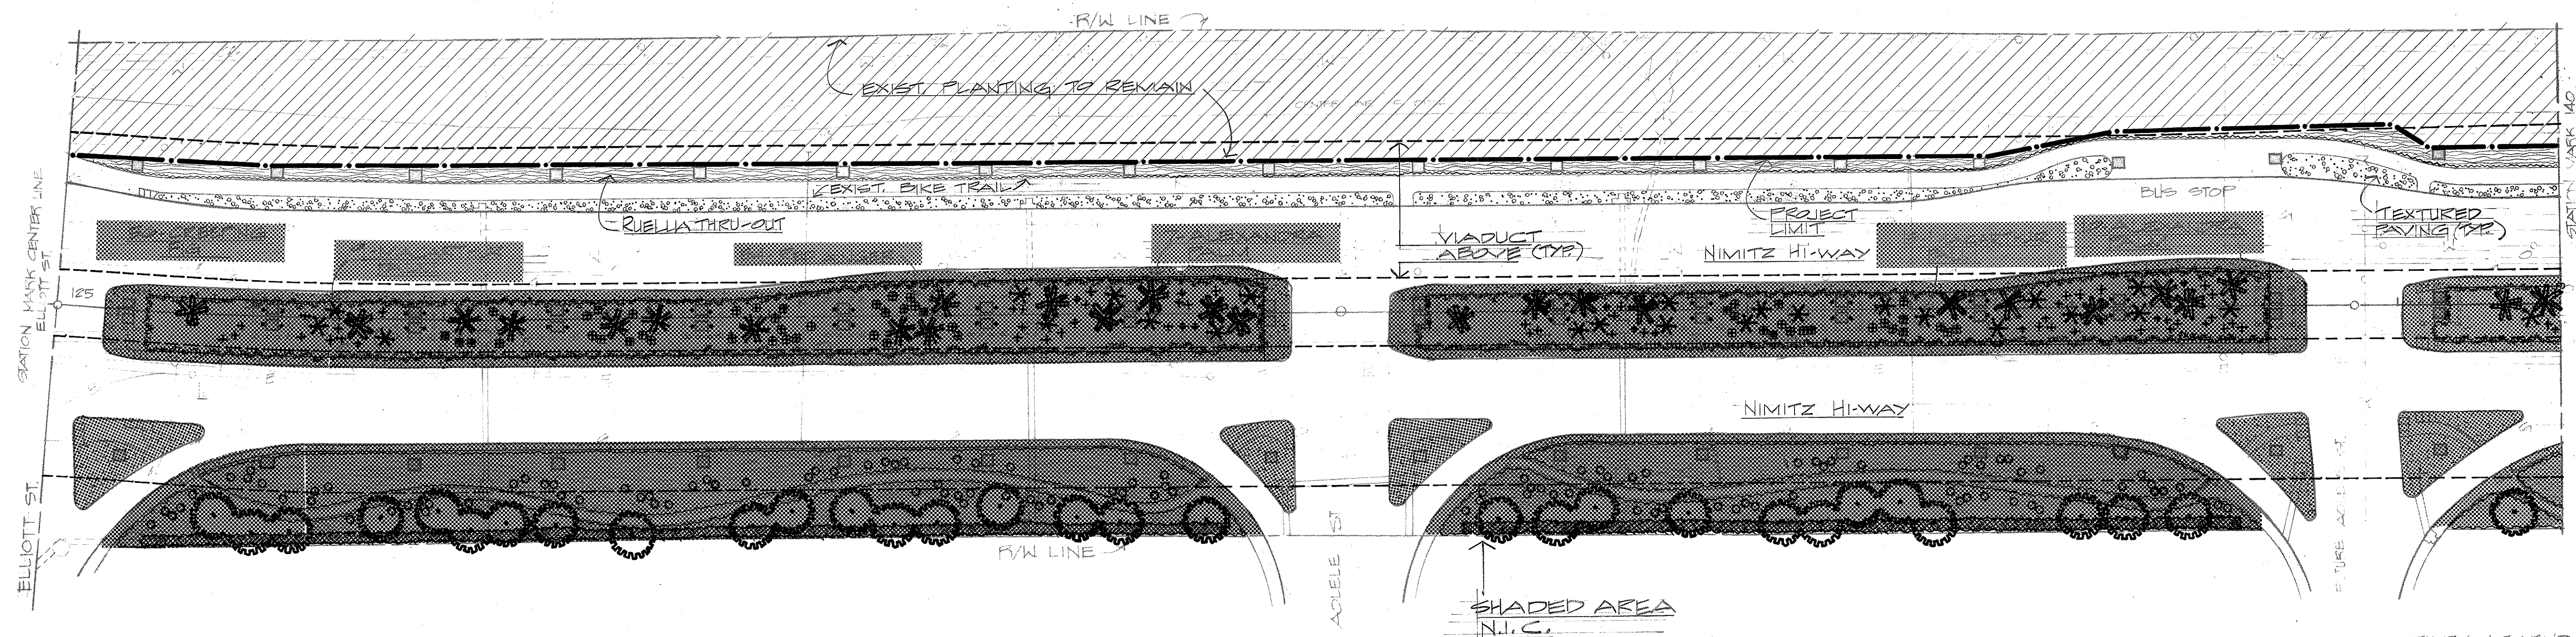

UTILITY LEGEND

—S—	SANITARY SEWER
—SS—	STORM SEWER
—W—	WATER LINE
—G—	GAS LINE
—O—	OIL LINE
—CC—	COMMUNICATION CABLE
—E—	ELECTRIC DUCTLINE
—T—	TELEPHONE DUCTLINE
—M—	MANHOLE VALVE BOX
—A—	ABANDONED LINE
—IR—	IRRIGATION PIPE

PARTIAL PLANTING PLAN
SCALE: 1" = 50'

ORIGINAL PLAN	SURVEY PLOTTED BY	DATE
NOTE BOOK	DRAWN BY	
	DESIGNED BY	
	CHECKED BY	

STATE OF HAWAII
DEPARTMENT OF TRANSPORTATION
LAND TRANSPORTATION FACILITIES DIVISION


PLANTING PLAN

AIRPORT INTERCHANGE
ROADWAY LANDSCAPING
F.A.I. PROJ. NO. I-HI-1(164):16
SCALE AS SHOWN DATE: 9-14-81

SHEET NO. 24 OF 30 SHEETS

THIS WORK WAS PREPARED BY
Melvin K. F. Lau
Signature

FED. ROAD DIST. NO.	STATE	FED. AID PROJ. NO.	FISCAL YEAR	SHEET NO.	TOTAL SHEETS
HAWAII	HAW.	I-HI-1(164):16	1981	26	30

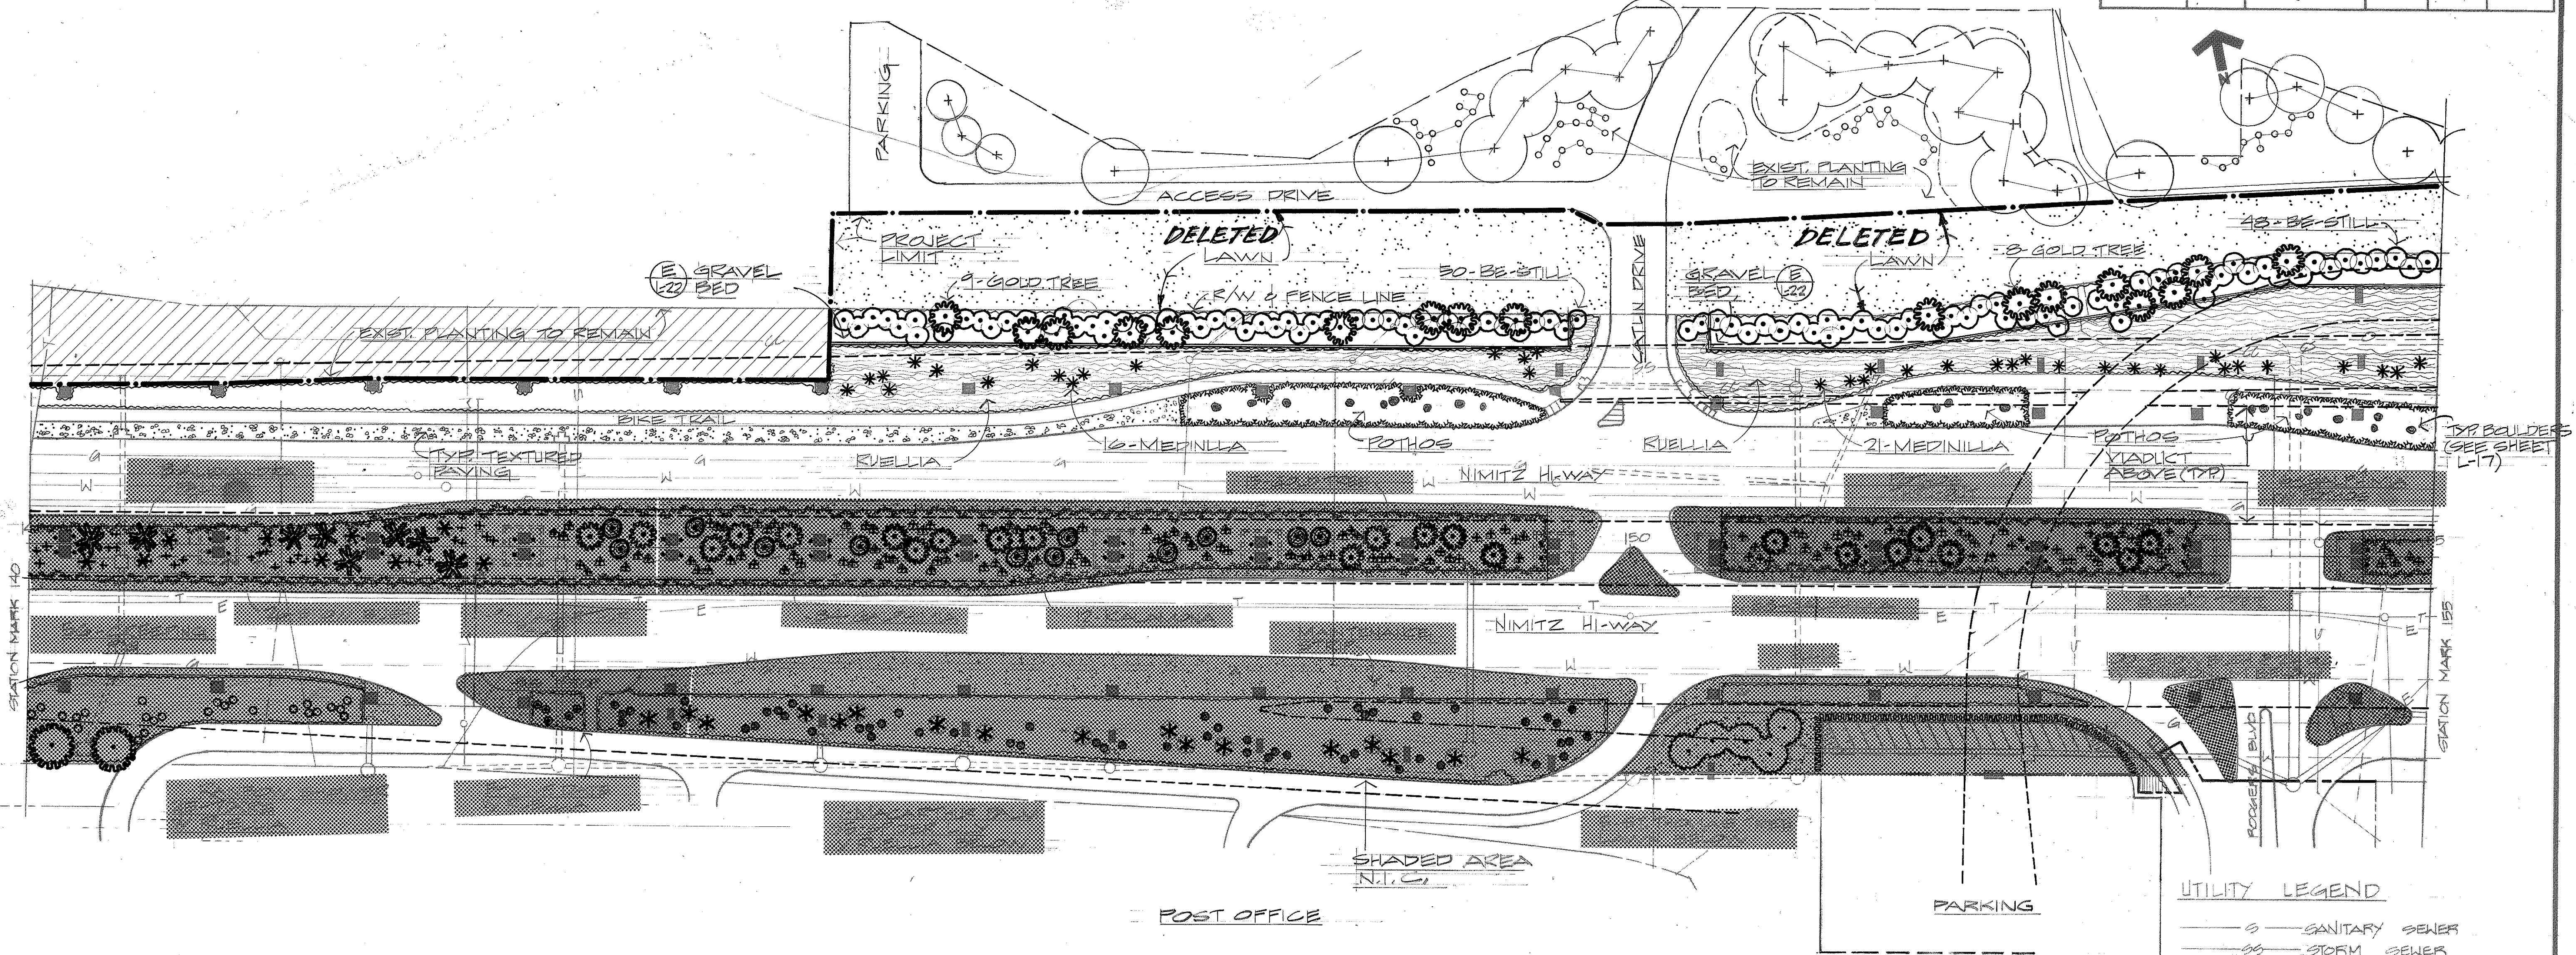

PARTIAL PLANTING PLAN
SCALE = 1" = 50'

ORIGINAL PLAN	SURVEY PLOTTED BY	DATE
NOTE BOOK	DRAWN BY	
	DESIGNED BY	
	CHECKED BY	

THIS WORK WAS PREPARED BY ME OR UNDER MY SUPERVISION

Marvin K. F. Lau
Signature


STATE OF HAWAII
DEPARTMENT OF TRANSPORTATION
LAND TRANSPORTATION FACILITIES DIVISION

PLANTING PLAN

AIRPORT INTERCHANGE
ROADWAY LANDSCAPING
F.A.I. PROJ. NO. I-HI-1(164):16
SCALE AS SHOWN DATE: 9-14-81

SHEET NO. 26 OF 30 SHEETS

FED. ROAD DIST. NO.	STATE	FED. AID PROJ. NO.	FISCAL YEAR	SHEET NO.	TOTAL SHEETS
HAWAII	HAW.	I-HI-1(164):16	1981	27	30

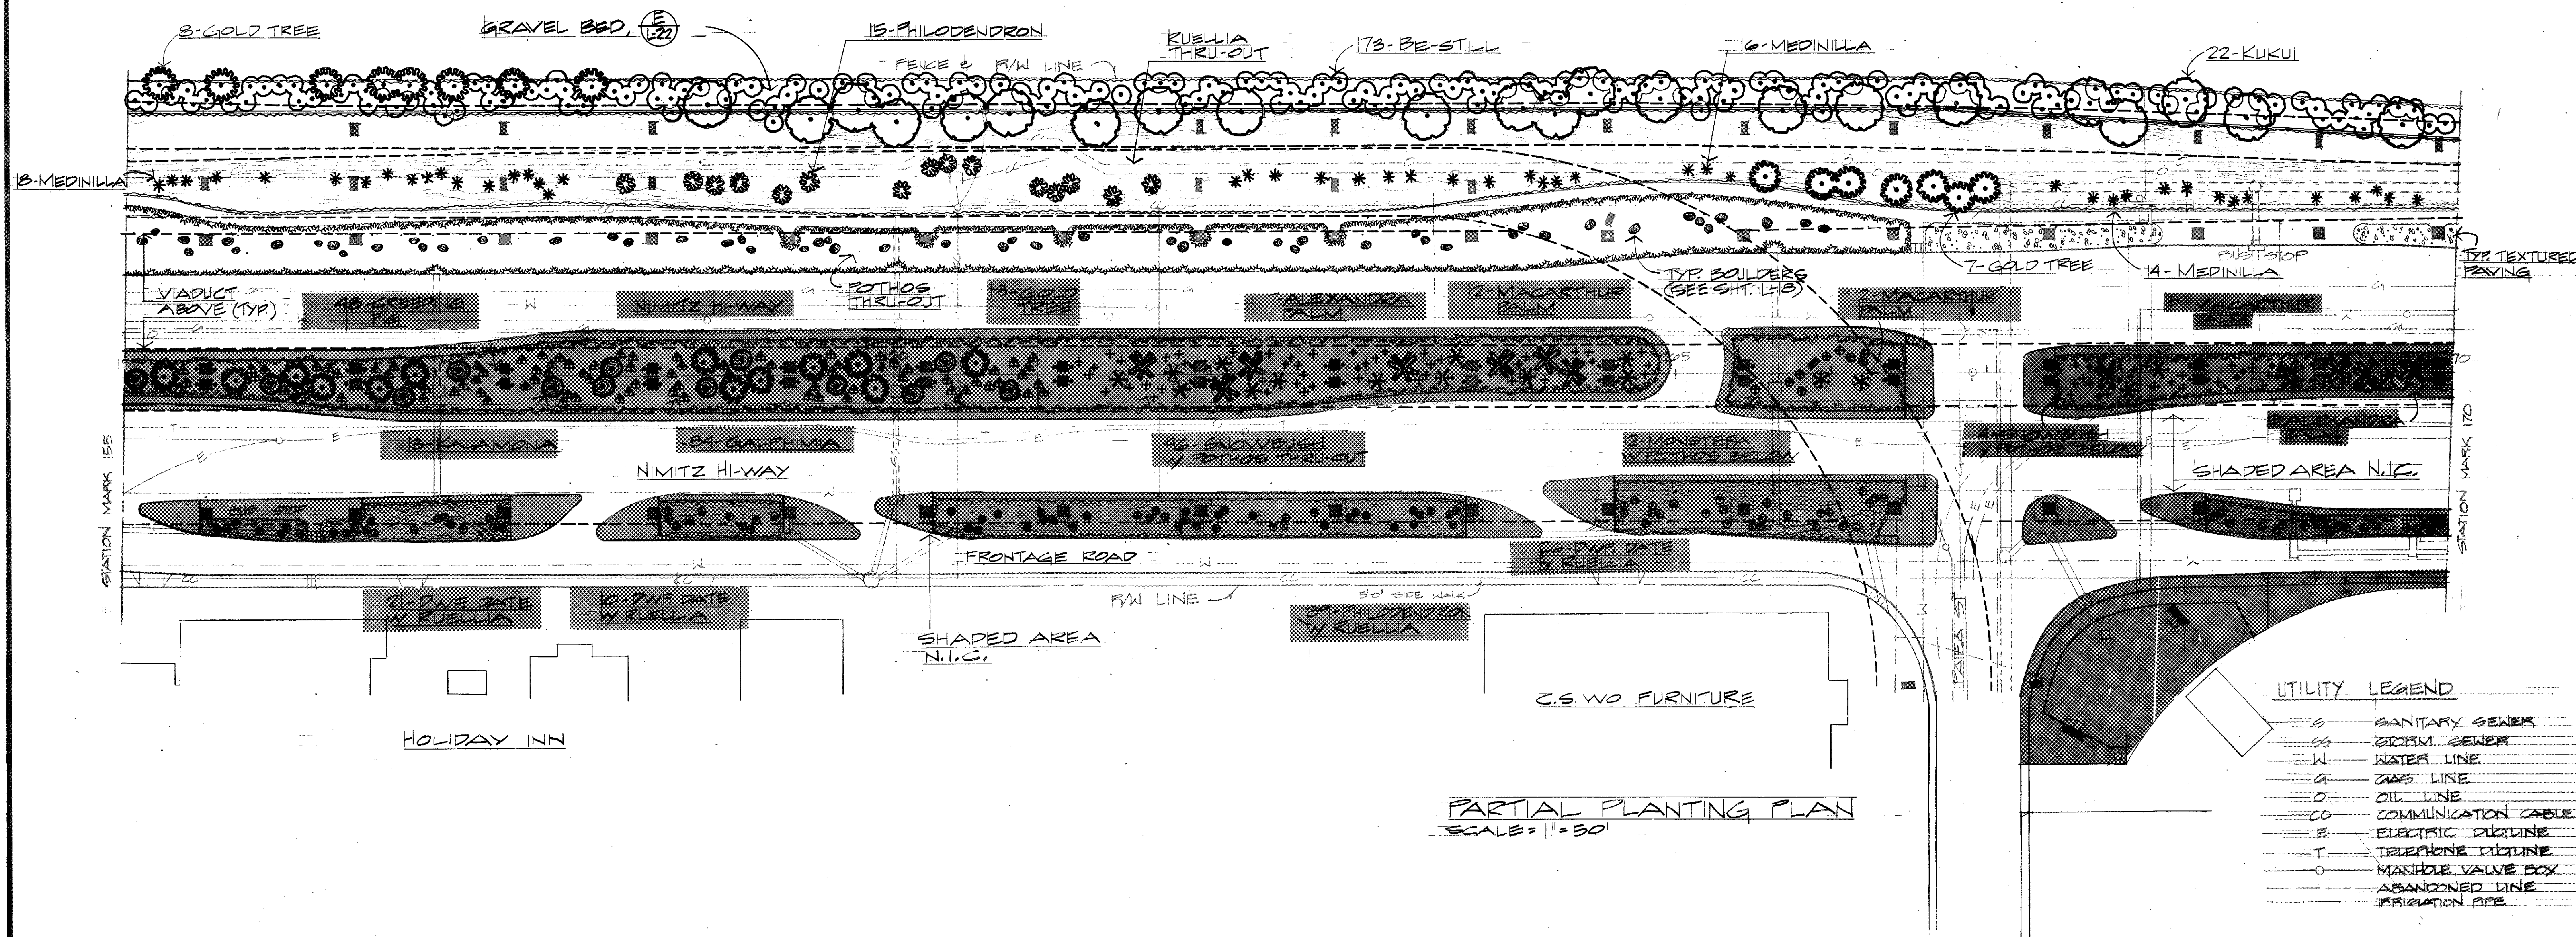

ORIGINAL PLAN	DATE
NOTED BY	
DESIGNED BY	
CHECKED BY	


STATE OF HAWAII
DEPARTMENT OF TRANSPORTATION
LAND TRANSPORTATION FACILITIES DIVISION

PLANTING PLAN

AIRPORT INTERCHANGE
ROADWAY LANDSCAPING
F.A.I. PROJ. NO. I-HI-1(164):16
SCALE AS SHOWN DATE: 9-14-81


SHEET NO. 26 OF 30 SHEETS

FED. ROAD DIST. NO.	STATE	FED. AID PROJ. NO.	FISCAL YEAR	SHEET NO.	TOTAL SHEETS
HAWAII	HAW.	I-HI-1(164):16	1981	23	30

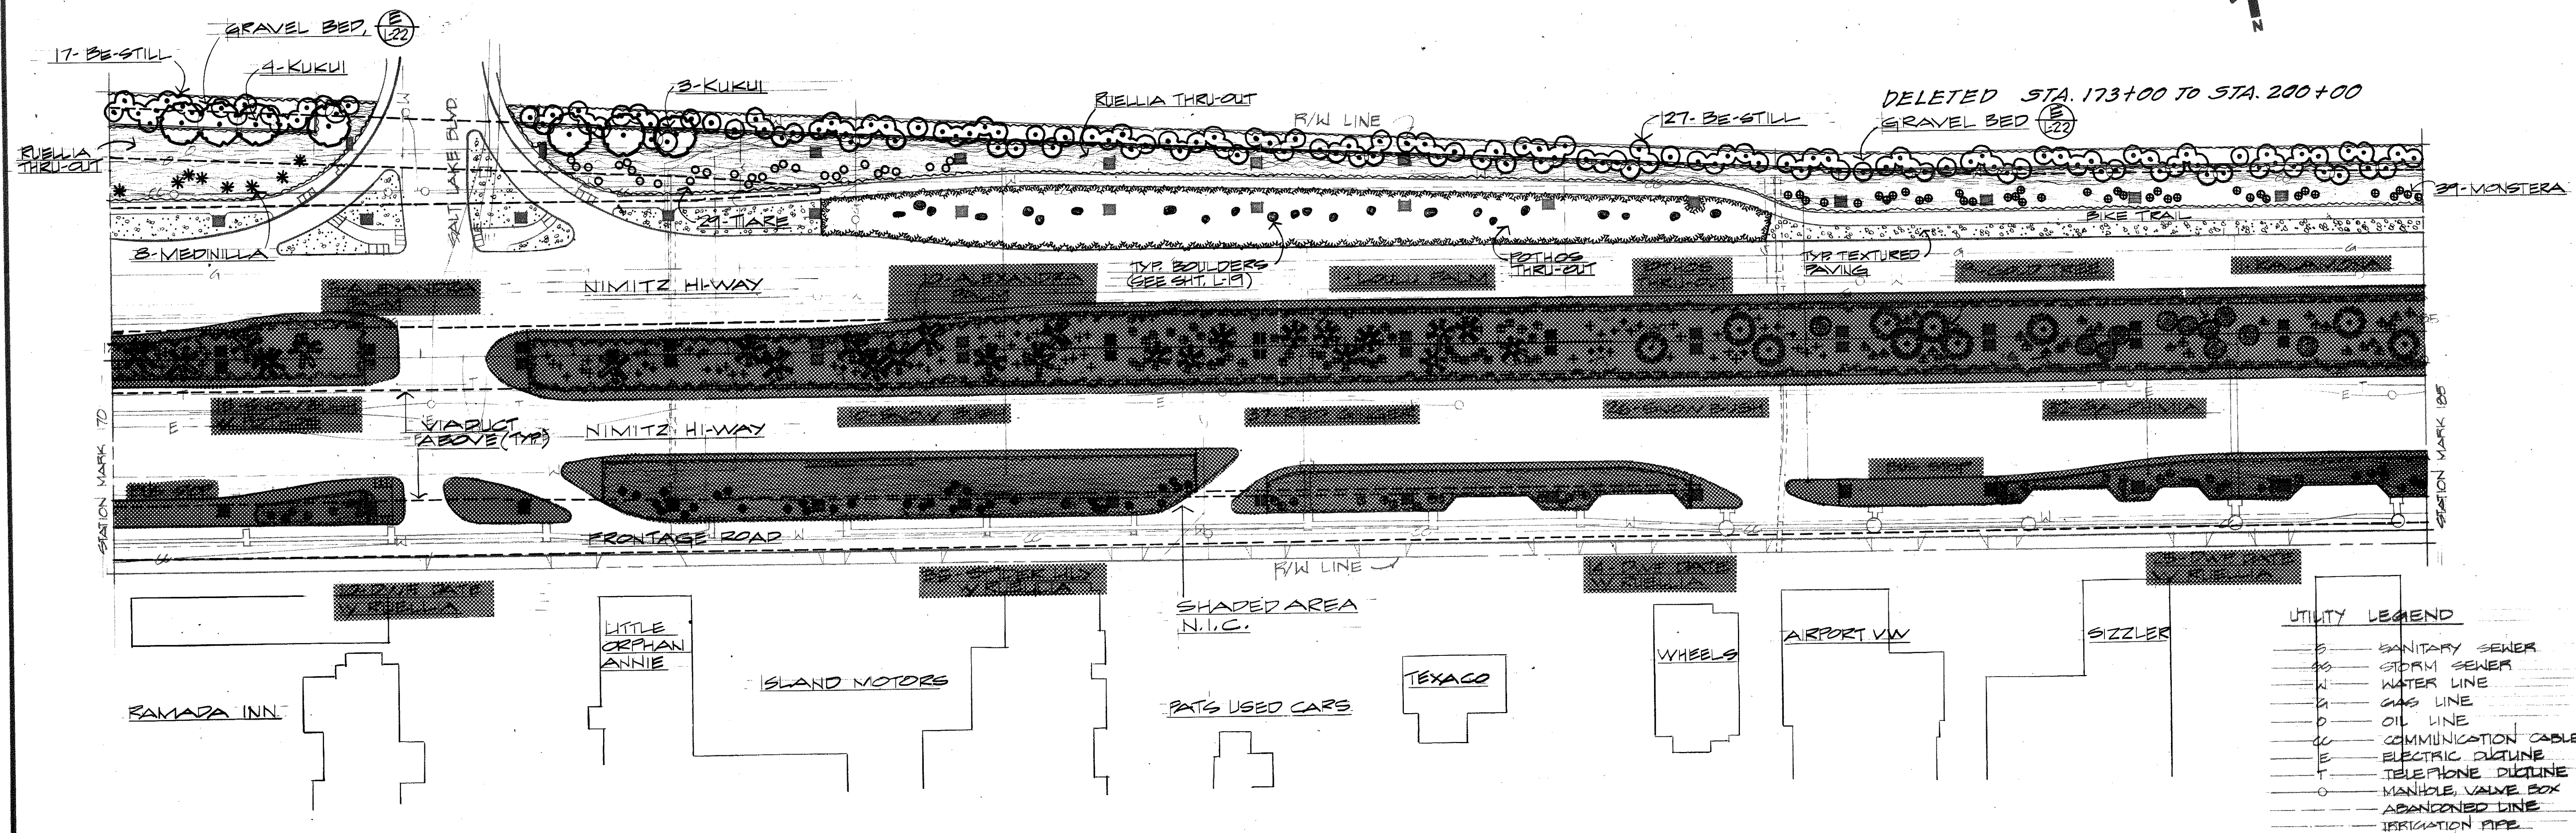

PARTIAL PLANTING PLAN
SCALE: 1" = 50'

ORIGINAL PLAN	SURVEY PLOTTED BY	DATE
NOTE BOOK	DRAWN BY	
	DESIGNED BY	
	CHECKED BY	

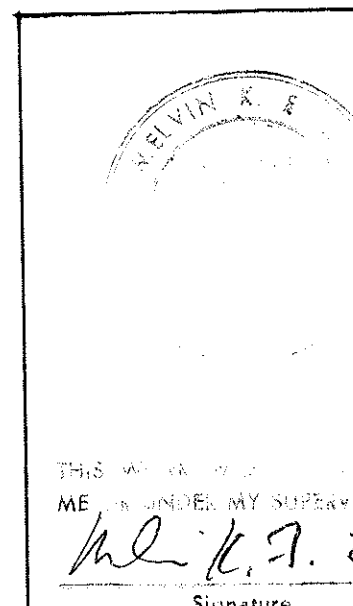



STATE OF HAWAII
DEPARTMENT OF TRANSPORTATION
LAND TRANSPORTATION FACILITIES DIVISION

PLANTING PLAN

AIRPORT INTERCHANGE
ROADWAY LANDSCAPING
F.A.I. PROJ. NO. I-HI-1(164):16
SCALE AS SHOWN DATE: 9-14-81

SHEET NO. 23 OF 30 SHEETS

FED. ROAD DIST. NO.	STATE	FED. AID PROJ. NO.	FISCAL YEAR	SHEET NO.	TOTAL SHEETS
HAWAII	HAW.	I-HI-1(164):16	1981	29	30

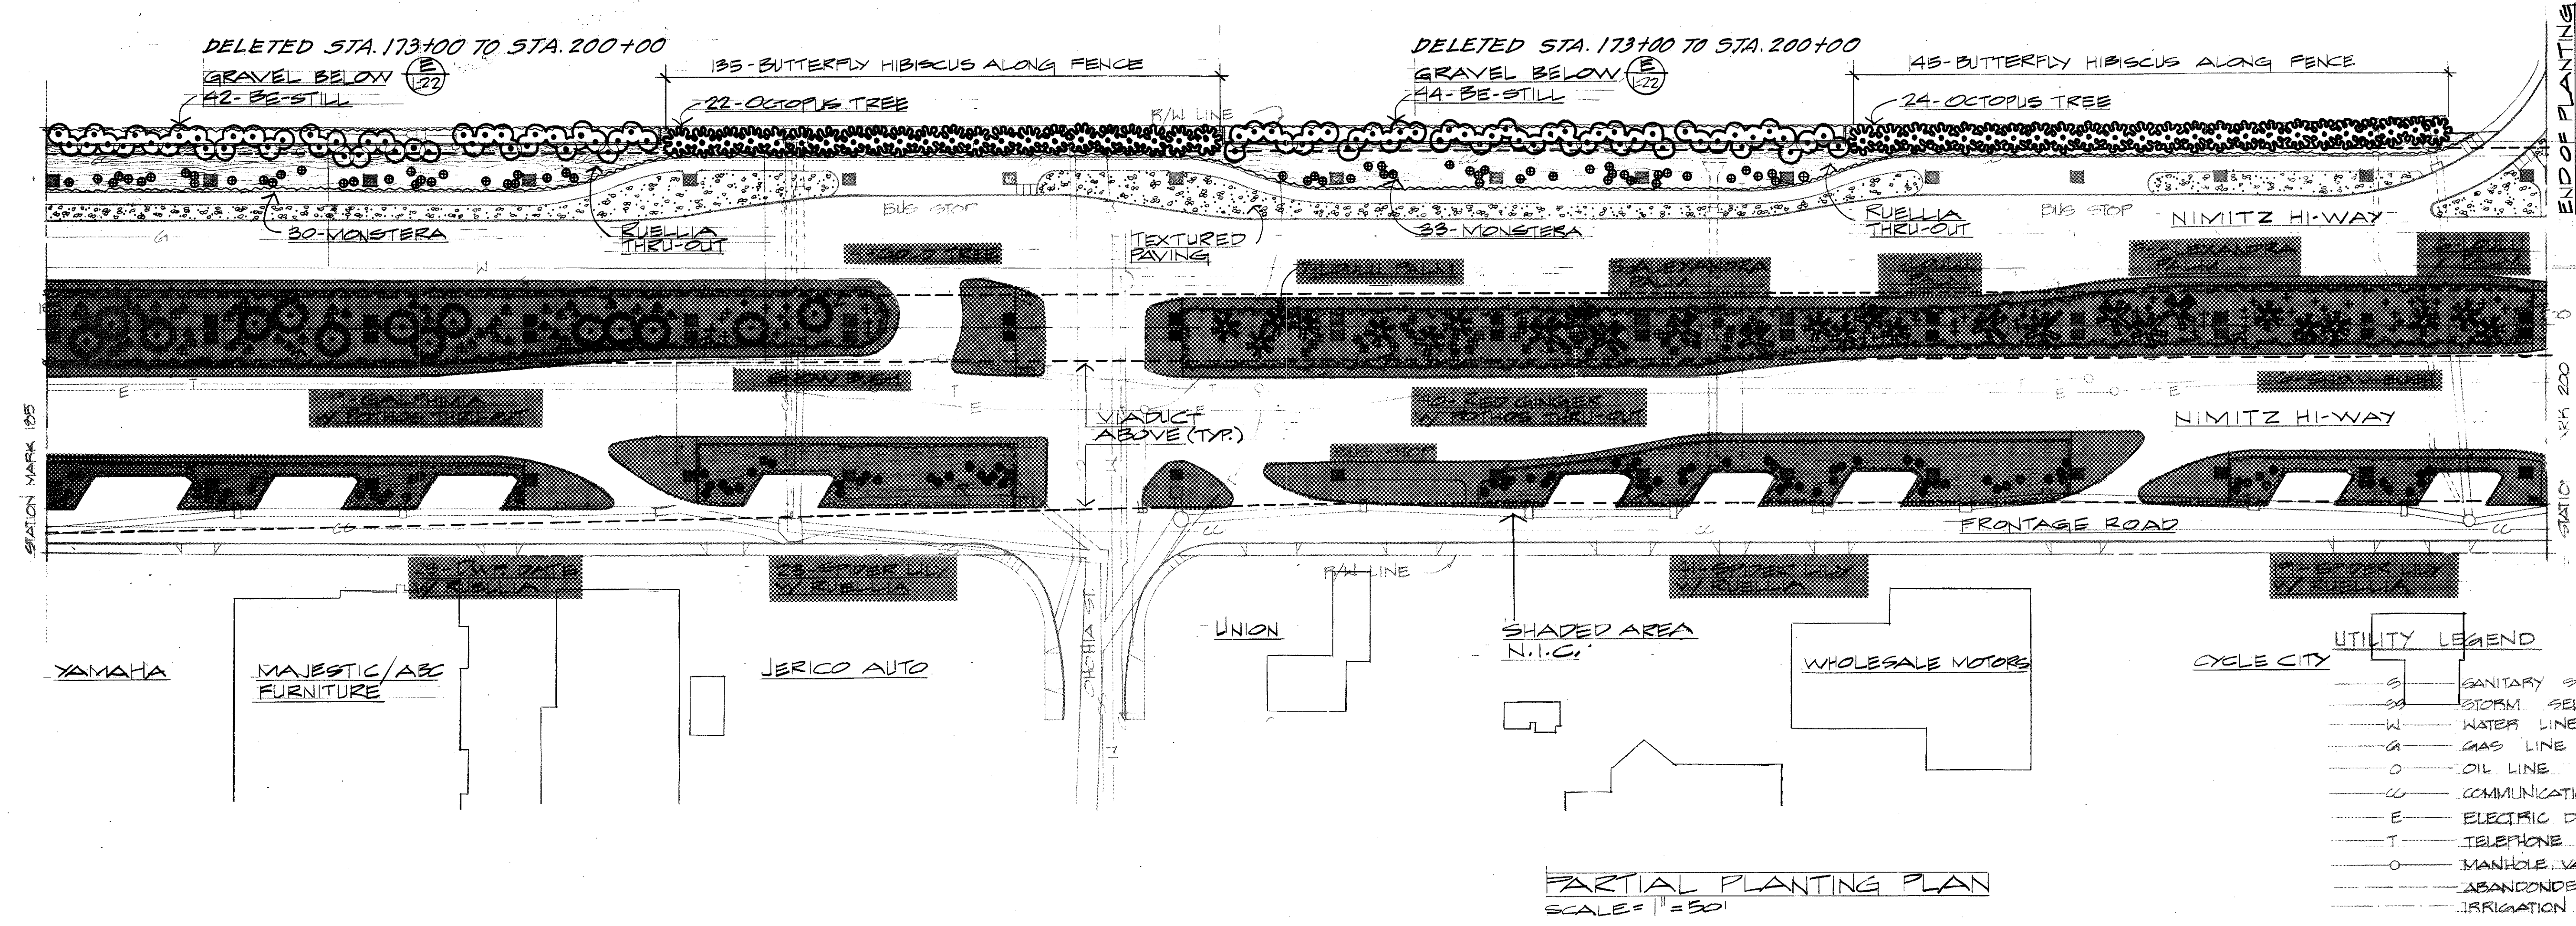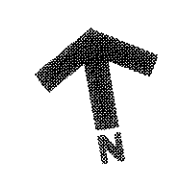

CYCLE CITY UTILITY LEGEND

S	SANITARY SEWER
SS	STORM SEWER
W	WATER LINE
G	GAS LINE
O	OIL LINE
CC	COMMUNICATION CABLE
E	ELECTRIC DUCTLINE
T	TELEPHONE DUCTLINE
○	MANHOLE VALVE BOX
---	ABANDONED LINE
---	IRRIGATION PIPE

ORIGINAL PLAN	DATE
SURVEY PLOTTED BY	
DRAWN BY	
DESIGNED BY	
NOTED BY	
CHECKED BY	

THIS WORK IS
HEREON UNDER MY SUPERVISION
William K. F. Fong
Signature

STATE OF HAWAII
DEPARTMENT OF TRANSPORTATION
LAND TRANSPORTATION FACILITIES DIVISION

PLANTING PLAN

AIRPORT INTERCHANGE
ROADWAY LANDSCAPING
F.A.I. PROJ. NO. I-HI-1(164):16
SCALE AS SHOWN DATE: 9-14-81

SHEET NO. 28 OF 30 SHEETS

PLANTING PLAN 1981