



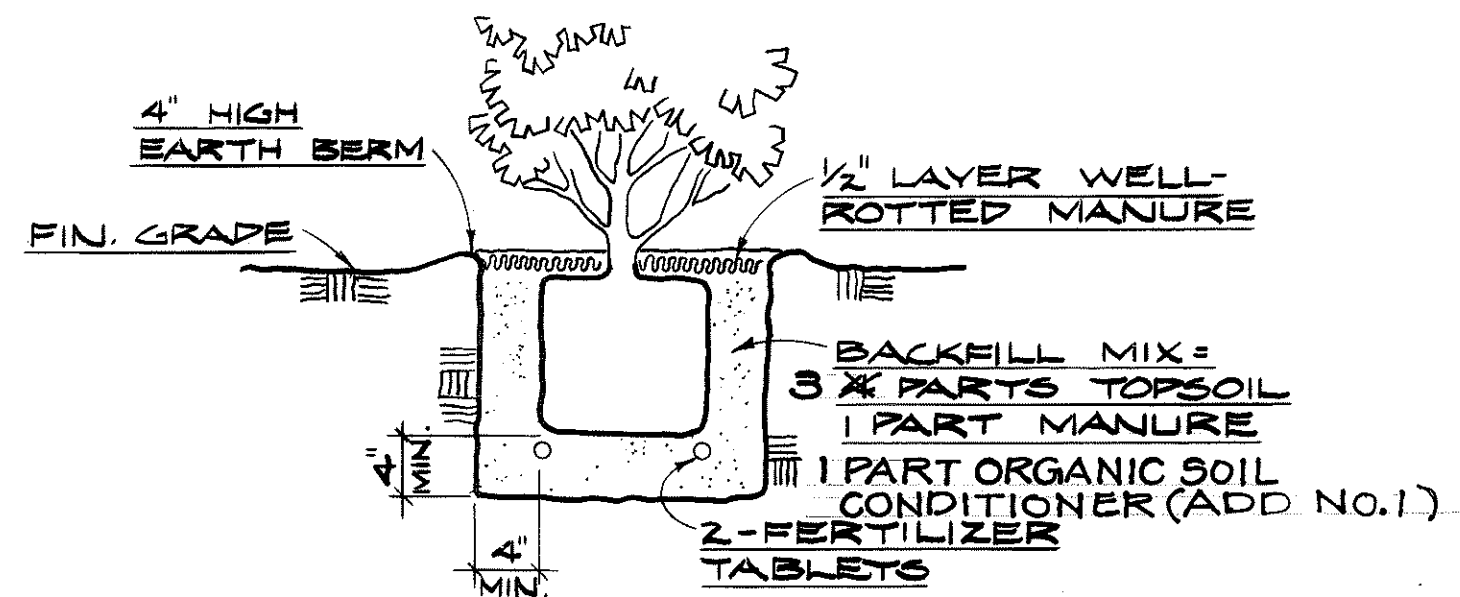

SHRUB PLANTING DETAIL
NO SCALE

CC.O #1 REVISED QUANTITY	QUANTITY	COMMON & BOTANIC NAME	SIZE (MINIMUM IN PLACE)
34	25	ALEXANDRA PALM = ARCHONTOPHOENIX ALEXANDRAE	25 g.c., 8" HIGH
	24	GOLD TREE = TABESBUIA DONNELL-SMITHII	25 g.c., 8" HIGH TRUNK
	12	MACARTHUR PALM = PLYCHOSPERMA MACARTHURII	25 g.c., 6" HIGH CLUMP
	22	BAMBOO PALM = RHAPIS EXCELSA	2 1/2 g.c., 3" HIGH CLUMP
0	20	AFRICAN IRIS = MORABA IRIDIODES	1 g.c., 2" HIGH, FULL
	87	DWARF IXORA = IXORA CHINENSIS	2 1/2 g.c., 18" HIGH
	63	INDIAN HAWTHORN = RAPHIOLEPS INDICA	2 1/2 g.c., 2" HIGH
	39	MONSTERA = MONSTERA DELICIOSA	5 g.c., 2" HIGH
0	82	PINWHEEL GARDENIA = ERYTANIA SPP	2 1/2 g.c., 2" HIGH
	16	PHILODENDRON = PHILODENDRON SELLOUM	5 g.c., 2" HIGH
0	39	RED GINGER = ALPINIA PURPURATA	2 1/2 g.c., 3" HIGH CLUMP
	1	SPATHIPHYLLUM = SPATHIPHYLLUM MEGCOY	1 g.c., 18" CLUMP
	58	SNOW BUSH = BREYNIA NIVOSA	2 1/2 g.c., 2" HIGH
	15	SPIDER LILY = CRINUM ASIATICUM	2 1/2 g.c., 2" HIGH
	215	LAUAE FERN = POLYPODIUM PHYMATODES	1 g.c., 18" HIGH, FULL
105,200	125,000	POTHOS = POTHOS AUREUS	ROOTED CUTTINGS @ 18" o.c.
28,500	138,000	RUPELLIA = RUPELLIA CILIOSA	" " " " " "
173	200	CREeping FIG = FICUS PUMILA	1 g.c., 2" LONG

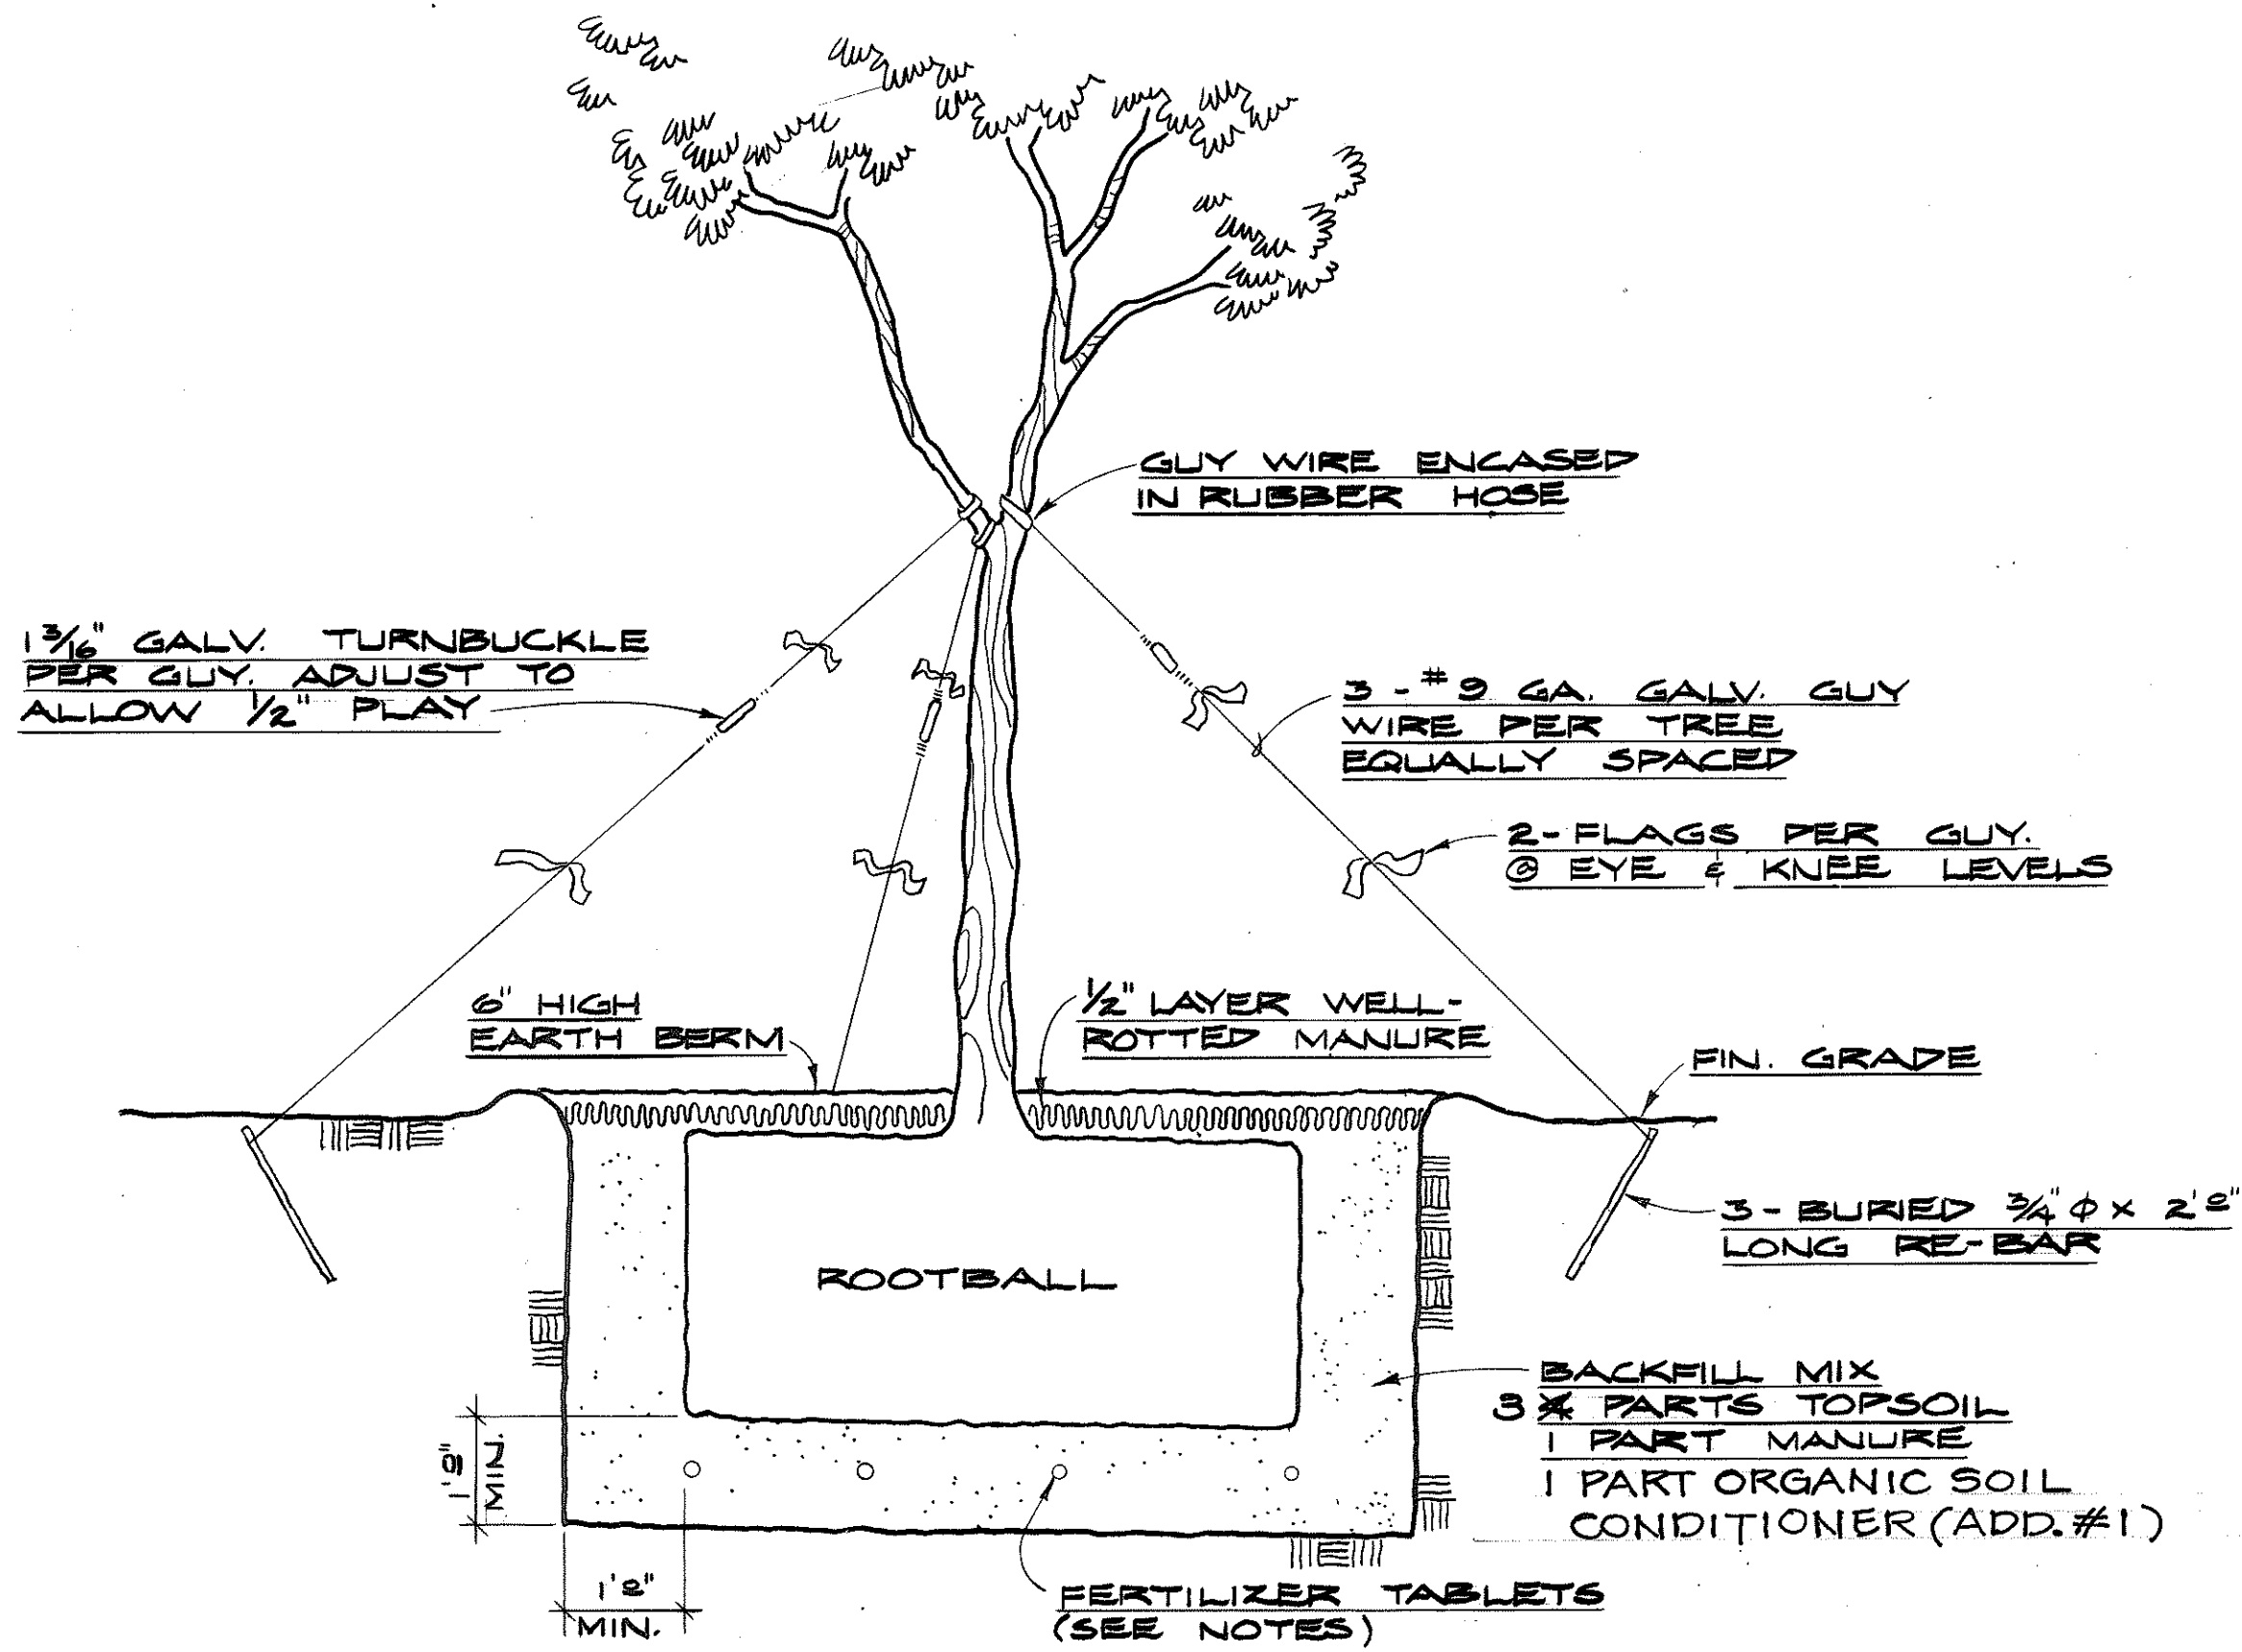

25 GAL. TREE PLANTING DETAIL
NO SCALE

NOTE:

1. CONTRACTOR SHALL BE RESPONSIBLE TO VERIFY ALL QUANTITIES, MEASUREMENTS & SITE CONDITIONS, INCLUDING LOCATIONS OF UNDERGROUND UTILITY LINES.
2. PRIOR TO EXCAVATION, ALL TREE PLANTING LOCATIONS SHALL BE STAKED BY THE CONTRACTOR FOR APPROVAL BY THE ENGINEER.
3. FERTILIZER TABLETS SHALL BE 20-10-5 ANALYSIS, 21 GRAM SIZE & USED IN THE FOLLOWING RATE = ALL TREES - 1 TABLET PER 1/2" CALIPER OF TRUNK. ALL SHRUBS - 2 TABLETS PER PLANT.

DATE	_____
SURVEY PLOTTED BY	_____
DRAWN BY	_____
CHECKED BY	_____
QUANTITIES BY	_____
NOTES BY	_____
NO.	_____

STATE OF HAWAII
DEPARTMENT OF TRANSPORTATION
LAND TRANSPORTATION FACILITIES DIVISION

PLANT LIST & DETAILS

AIRPORT INTERCHANGE
ROADWAY EROSION CONTROL & LANDSCAPING
F.A.I. PROJ. NO. I-IR-HI-1(173)16
SCALE AS SHOWN DATE: 2/3/83

SHEET NO. 22 OF 22 SHEETS

Signature: *W. K. 7*