



| FED. ROAD DIST. NO. | STATE | FED. AID PROJ. NO. | FISCAL YEAR | SHEET NO. | TOTAL SHEETS |
|---------------------|-------|--------------------|-------------|-----------|--------------|
| HAWAII              | HAW.  | IR-H-1 (186)       | 1987        | 72        | 97           |

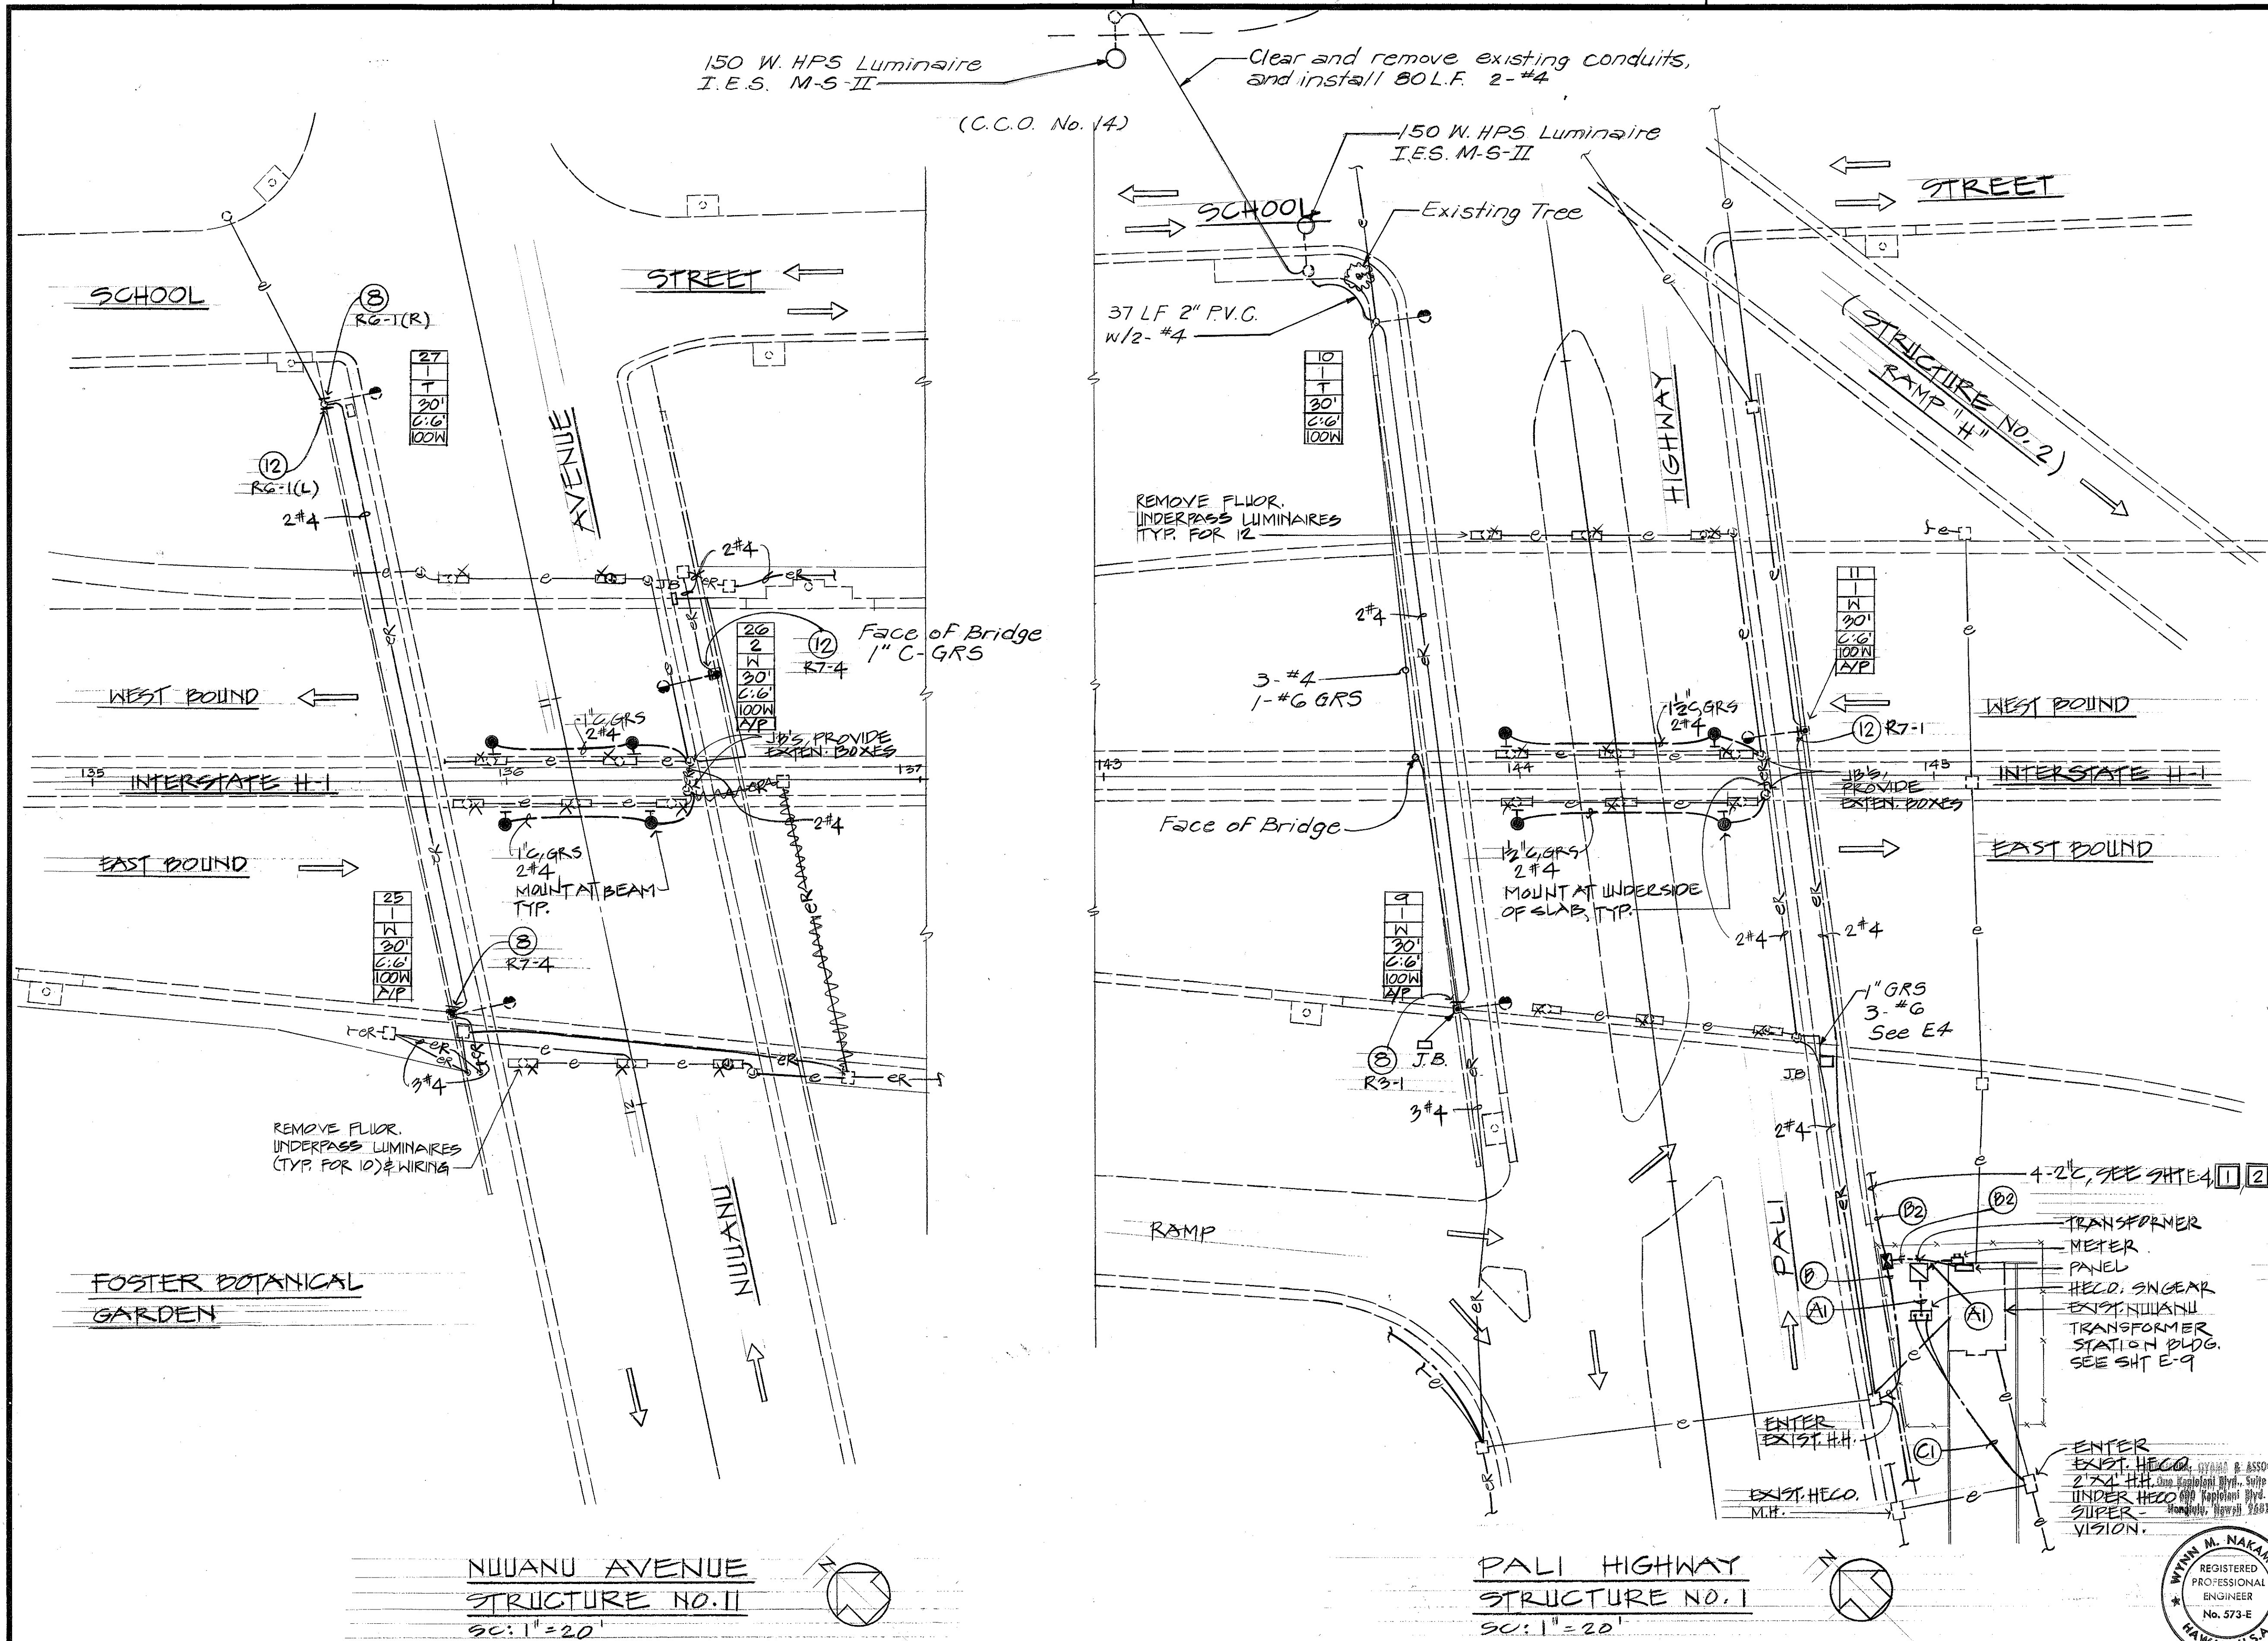

|                   |      |
|-------------------|------|
| ORIGINAL          | DATE |
| SURVEY PLOTTED BY |      |
| DRAWN BY          |      |
| DESIGNED BY       |      |
| NOTED BY          |      |
| CHECKED BY        |      |

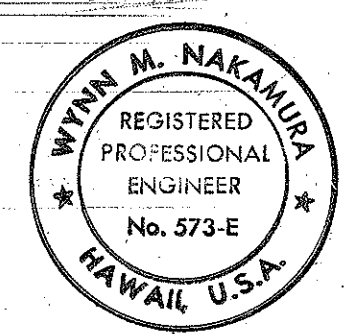

THIS WORK WAS PREPARED BY ME OR UNDER MY SUPERVISION.  
 Wynn M. Nakamura

STATE OF HAWAII  
 DEPARTMENT OF TRANSPORTATION  
 HIGHWAYS DIVISION

**HIGHWAY LIGHTING SYSTEM**

INTERSTATE ROUTE H-1  
 HIGHWAY LIGHTING IMPROVEMENTS  
 AALA STREET TO PUNCHBOWL STREET  
 KEEAUMOKU STREET TO OLD WAIALAE ROAD  
 PROJECT NO. IR-H-1 (186)

SCALE: AS NOTED DATE: 30 JAN 87

SHEET NO. E-7 OF 32 SHEETS