



FED. ROAD DIST. NO.	STATE	FED. AID PROJ. NO.	FISCAL YEAR	SHEET NO.	TOTAL SHEETS
HAWAII	HAW.	IK-HF(186)	1987	74	97

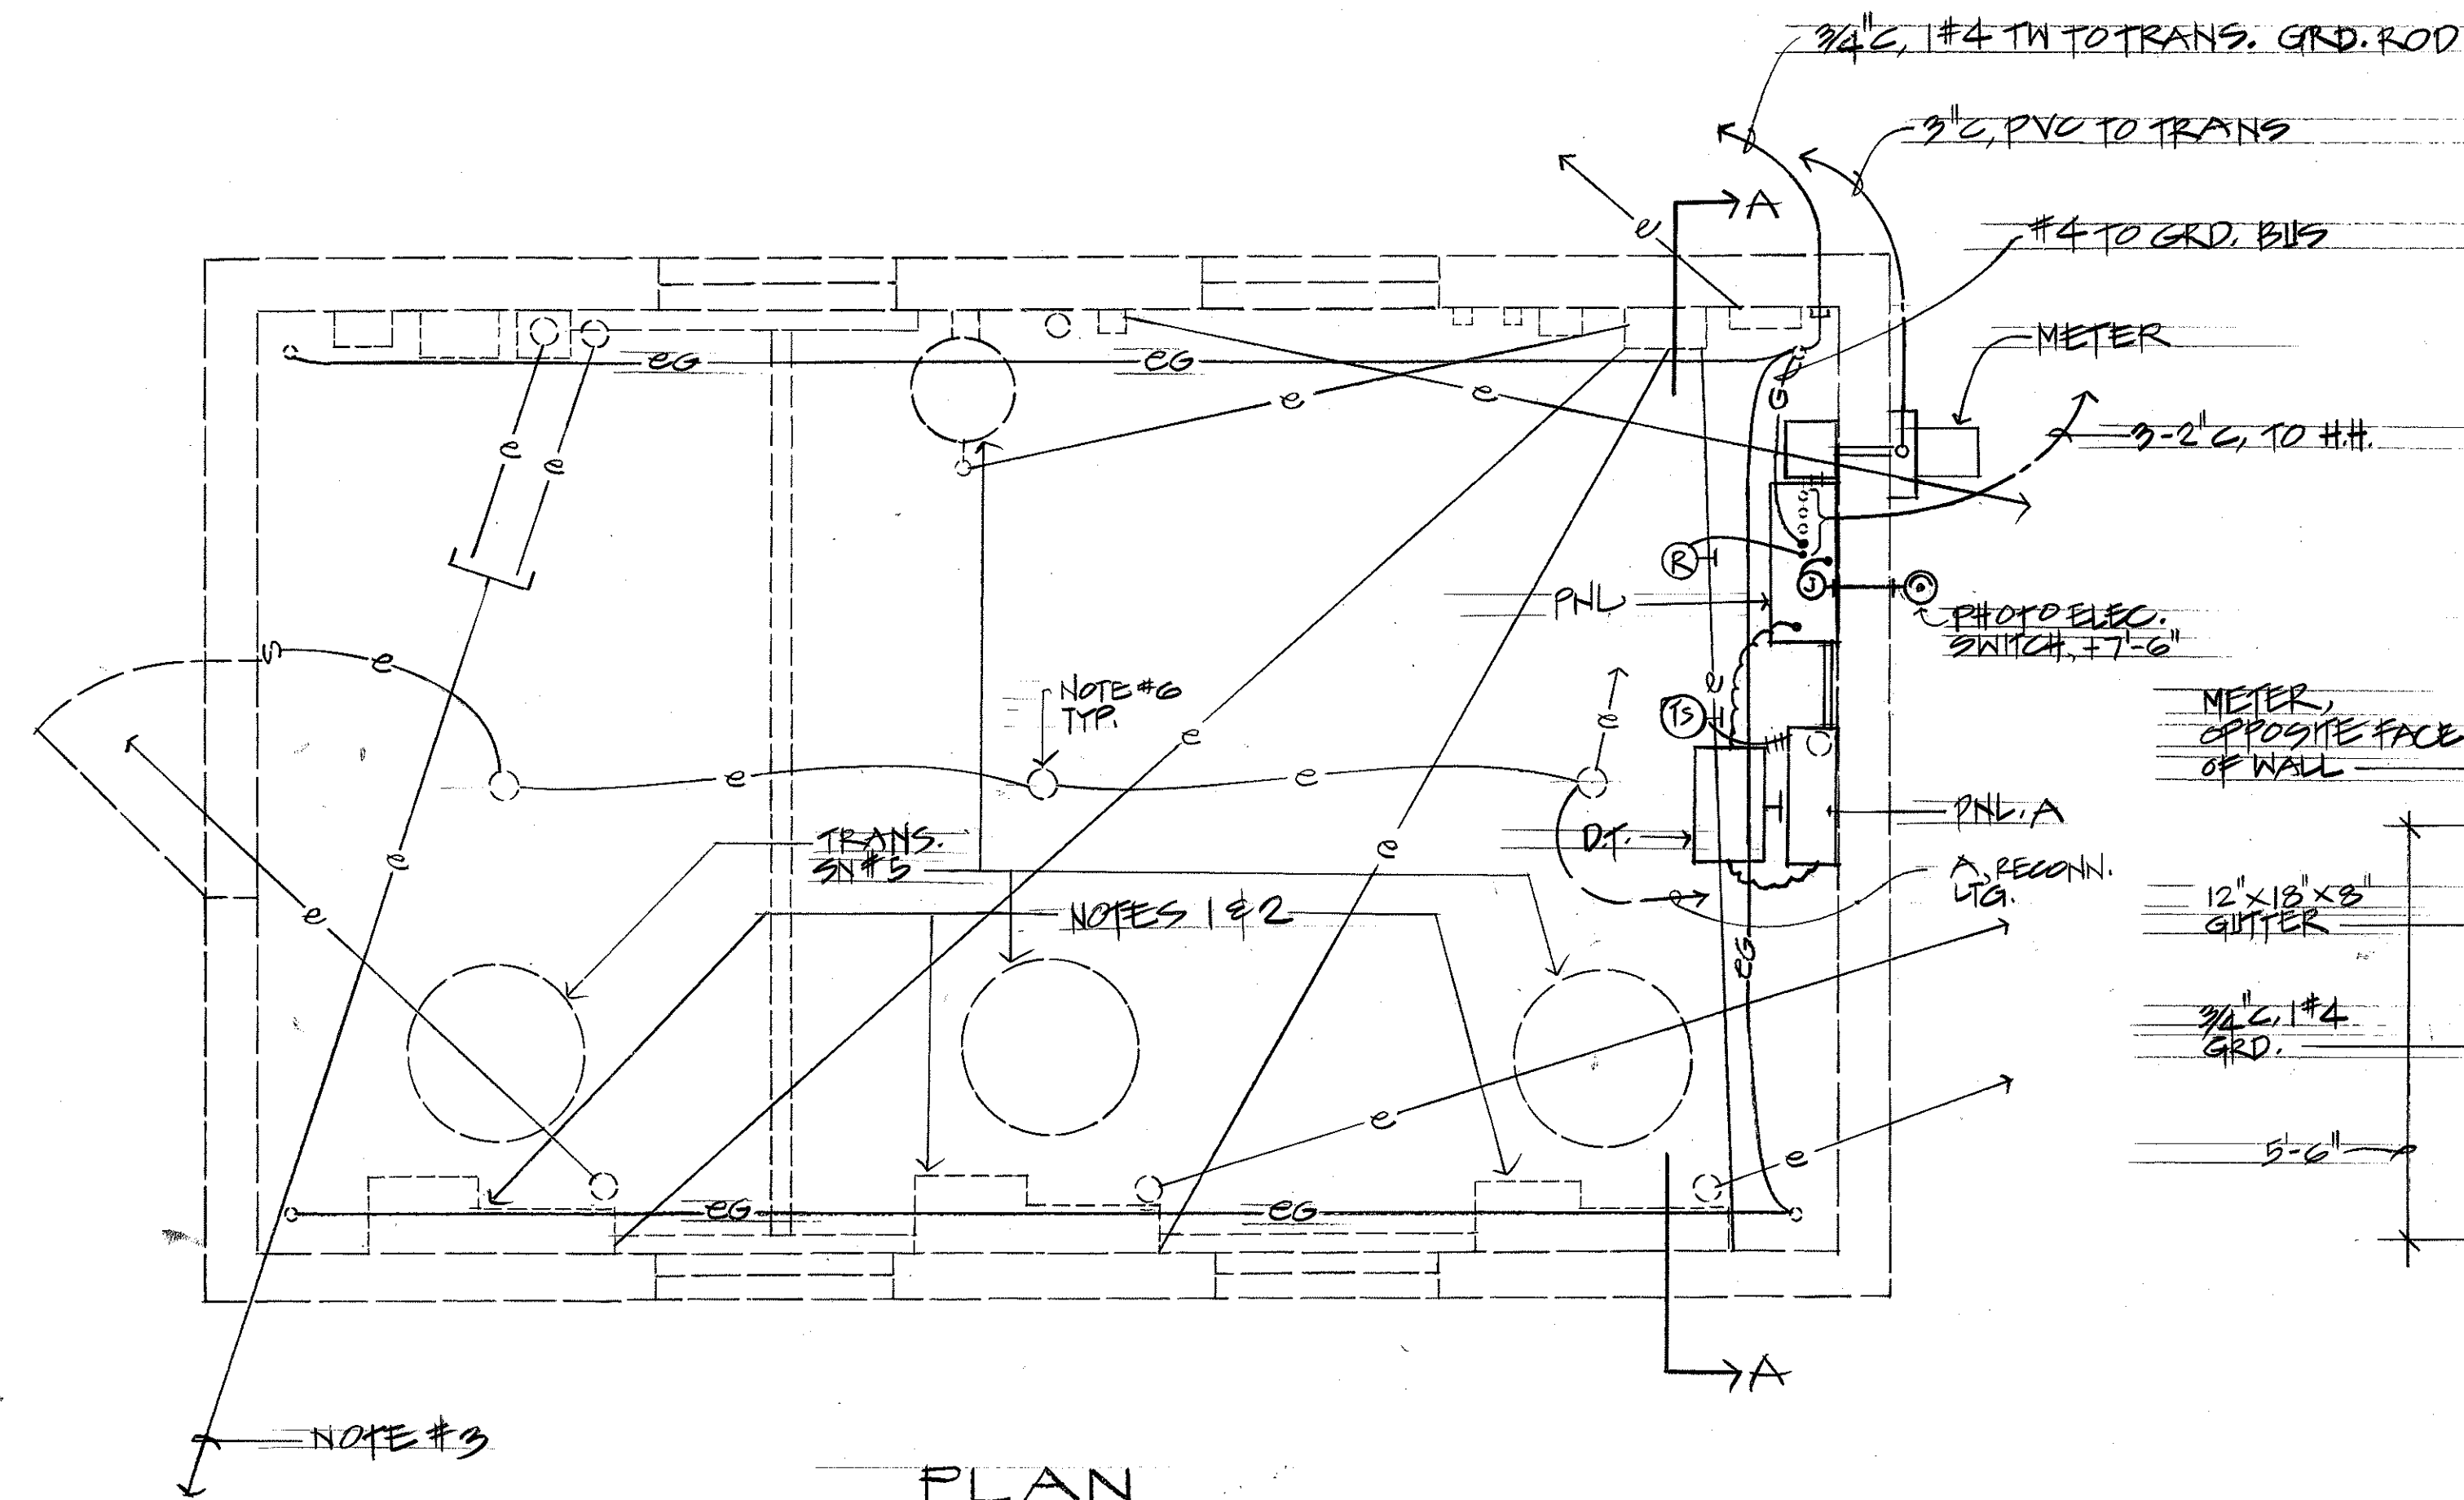


PLAN

NUJANU TRANSFORMER SUBSTATION


SCALE: $1/2'' = 1'-0''$

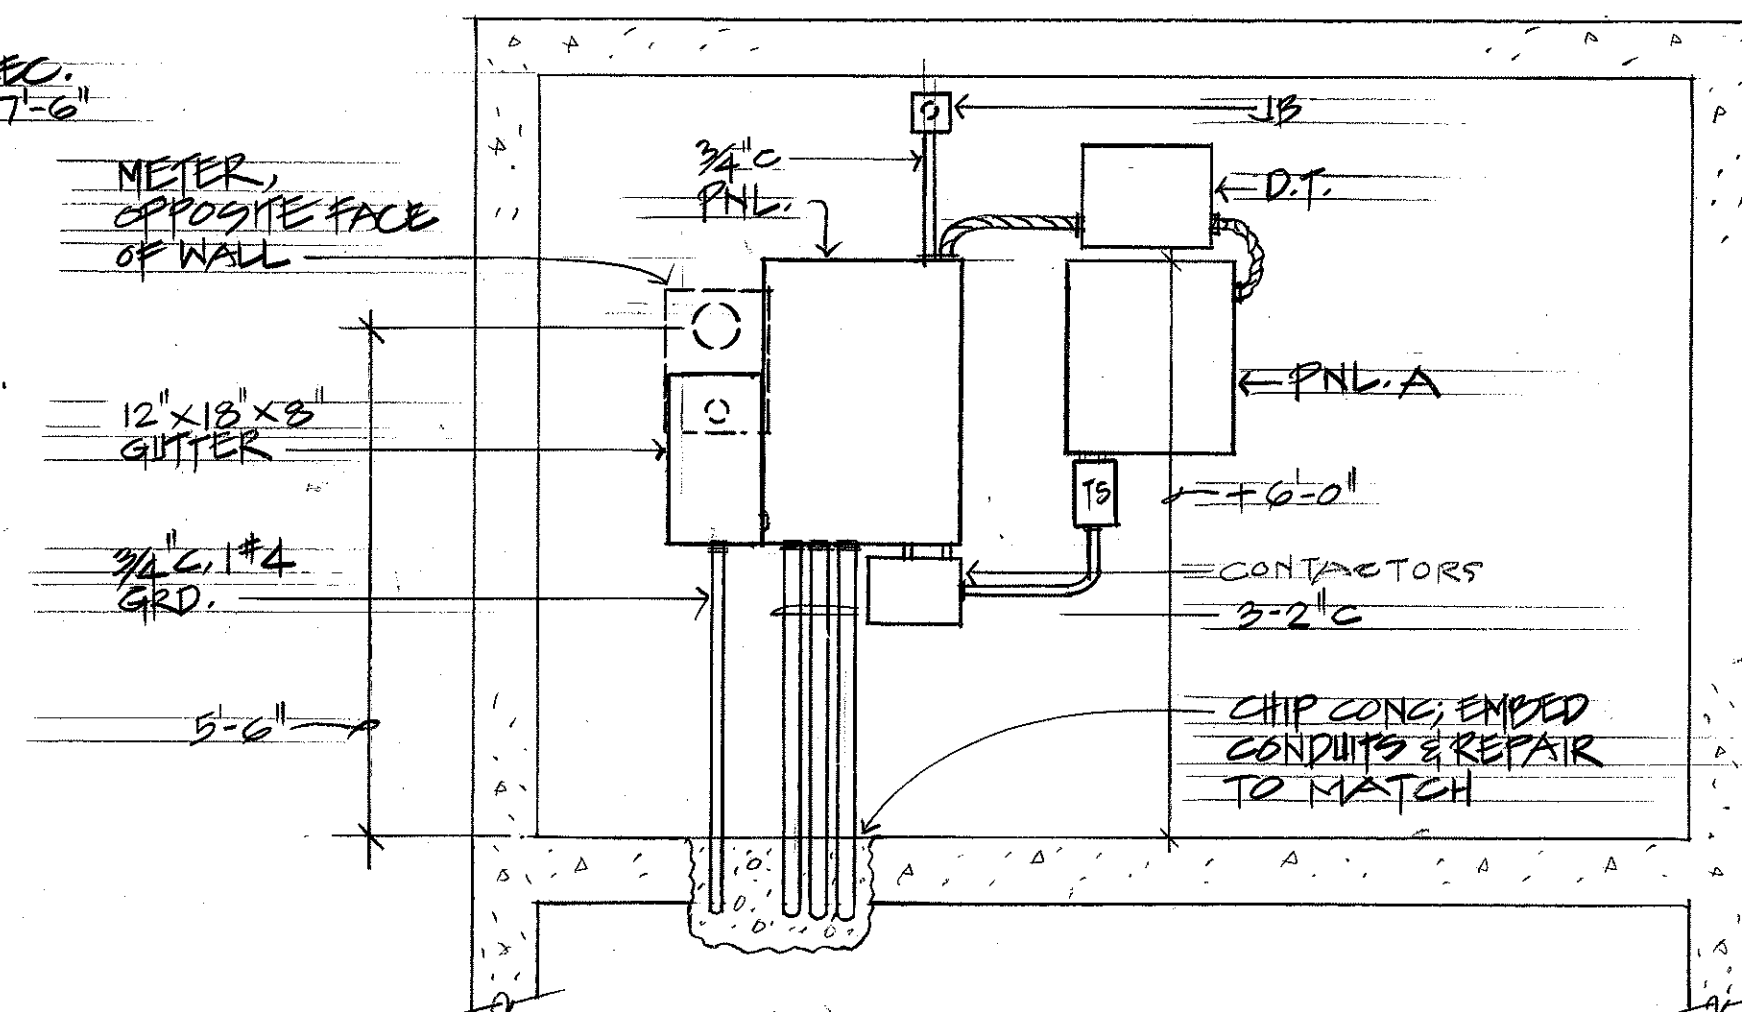

ELEVATION "A-A"
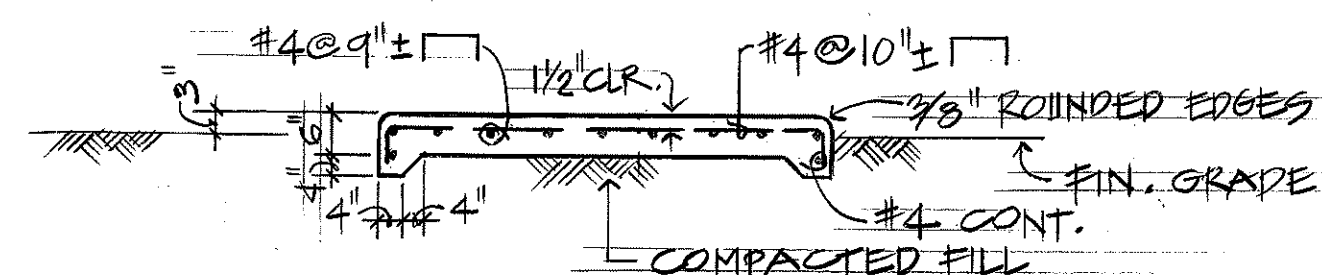
$$94: Y_n'' = |-b''|$$


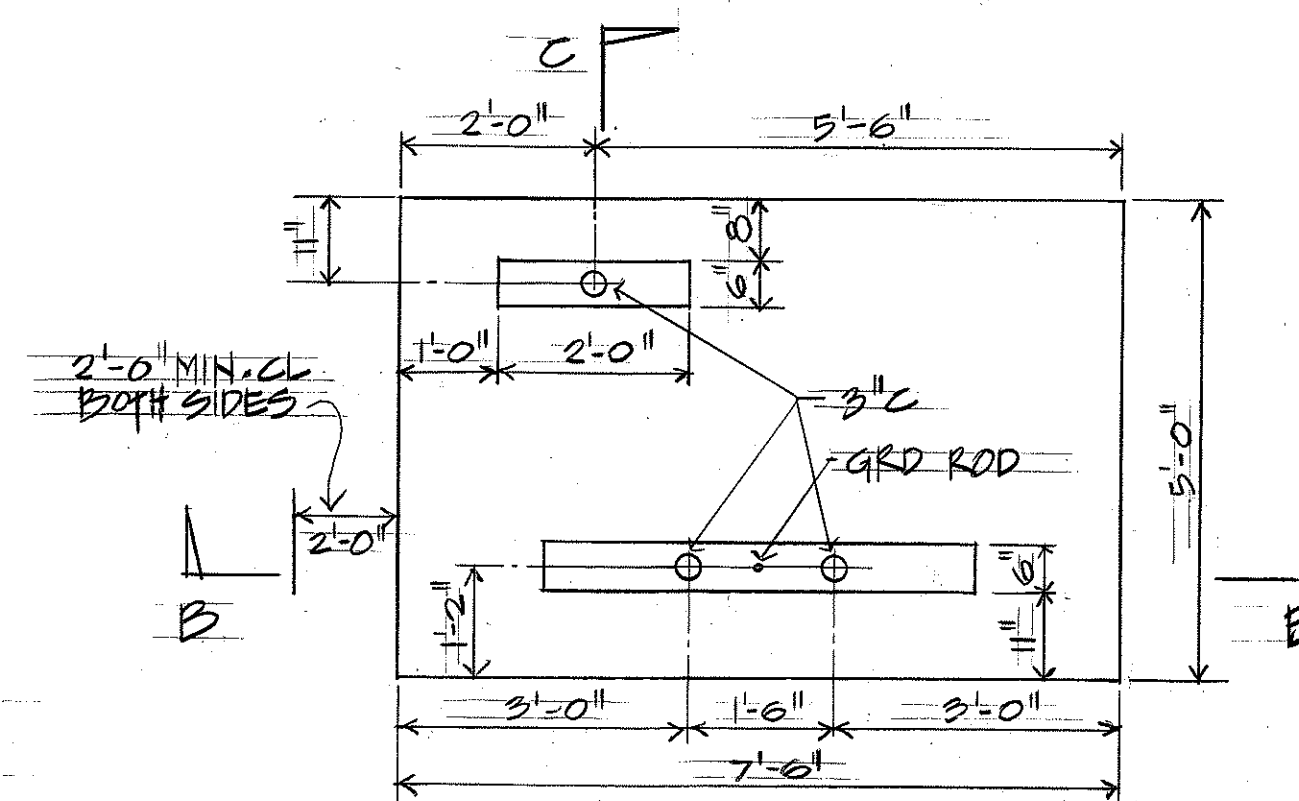
SECTION "A-A"

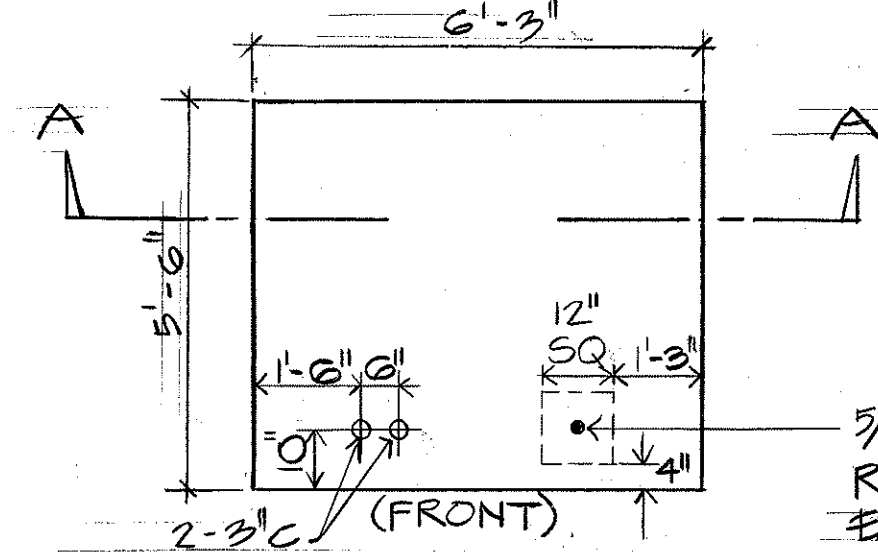

PLAN

TRANSFORMER PAD


SC: $3/8'' = 1'-0''$




PLAN

SWITCHGEAR PAD

SC: $1/2'' = 1'-0''$ SEE NOTE #4

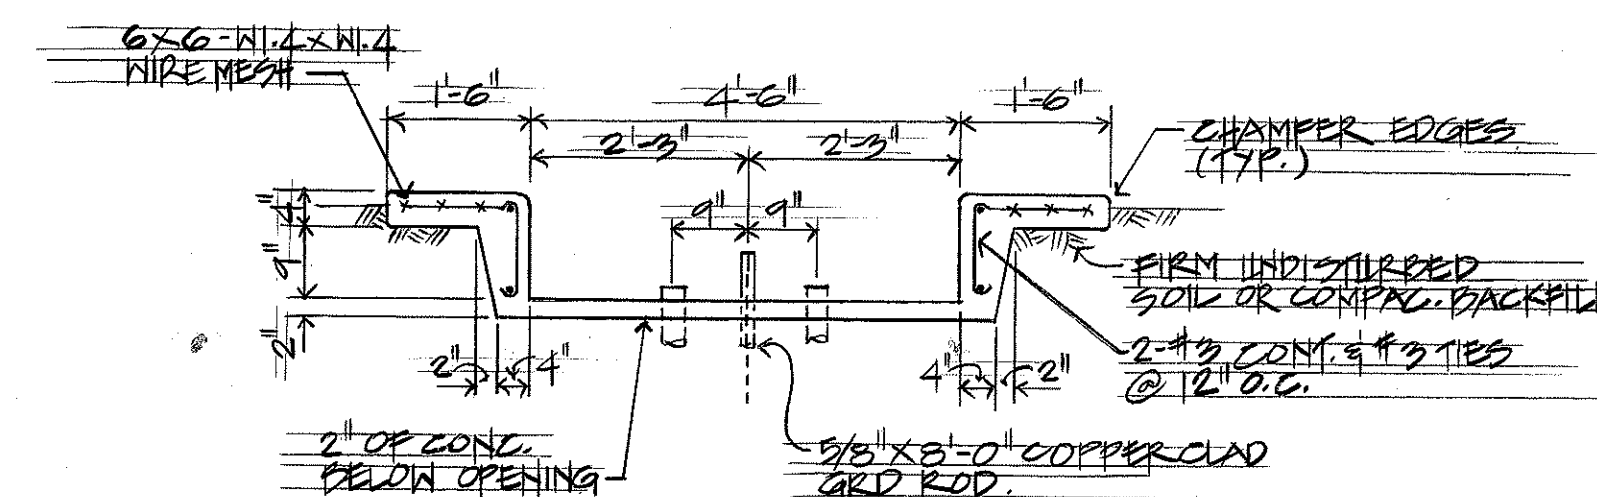

SECTION "B-B"

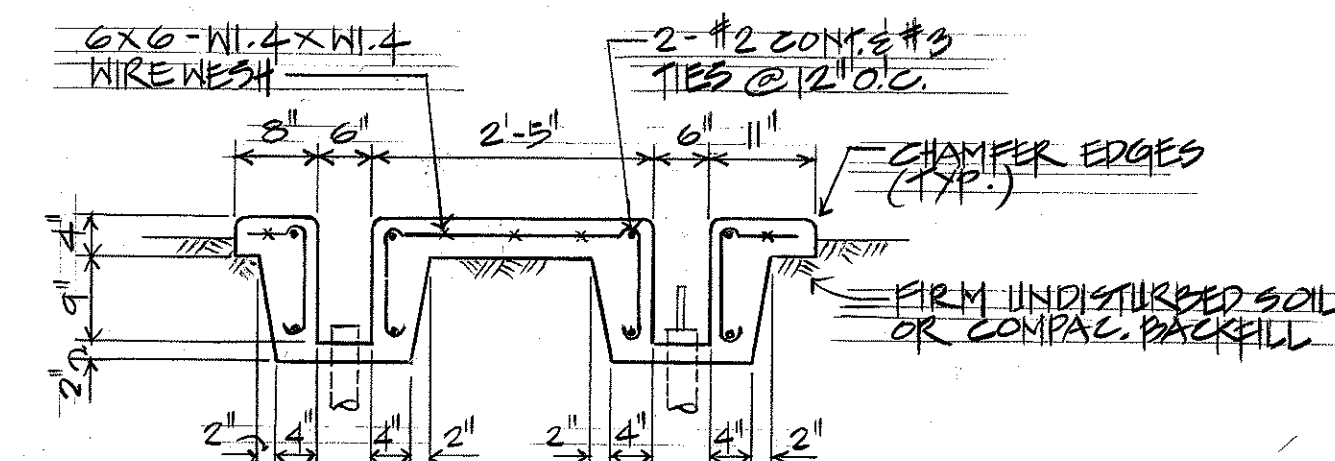

SECTION "C-C"

NAKAMURA, OYAMA & ASSOC., INC.
One Kapiolani Blvd., Suite 403
600 Kapiolani Blvd.
Honolulu, Hawaii 96813



THIS WORK WAS PREPARED BY
ME OR UNDER MY SUPERVISION.

Kenn Nakamura

STATE OF HAWAII
DEPARTMENT OF TRANSPORTATION
HIGHWAYS DIVISION

NILLANI TRANSFORMER STA.

INTERSTATE ROUTE H-1
HIGHWAY LIGHTING IMPROVEMENTS
AALA STREET TO PINCHBOWL STREET
KEEPAUMOKU STREET TO OLD NAI'IAE ROAD
PROJECT NO. IR-HI-1 (186)

SCALE: AS NOTED DATE: 30 JAN '87

SHEET No. E-9 OF 38 SHEETS