


FED. ROAD DIST. NO.	STATE	FED. AID PROJ. NO.
HAWAII	HAW.	IR-HI-1 (186)

Diagram labels and features:

- Signs:** SIGN E1, SIGN E2, SIGN E3, SIGN E4, SIGN E5, SIGN E6, SIGN E7, SIGN E8, SIGN E9, SIGN E10.
- Ramps:** RAMP A, RAMP B, RAMP C, RAMP D, RAMP E, RAMP F, RAMP G, RAMP H, RAMP R-8.
- Structures:** PALU HWY. STRUCTURE #1, RAMP F TUNNEL STRUCTURE #8.
- Other Labels:** NIIHAU TRANS. STA., 6.6A, 2400V SERIES SYSTEM, CKT #1, CKT #2, CKT #3, STA. 145+00, STA. 165+00.

NOTE: REMOVE SERIES CRT. CABLES & EXPOSED CONDUITS AFTER MULTIPLE SYSTEM IS OPERATIONAL. ABANDON DIRECT BURIAL CABLE IN PLACE.

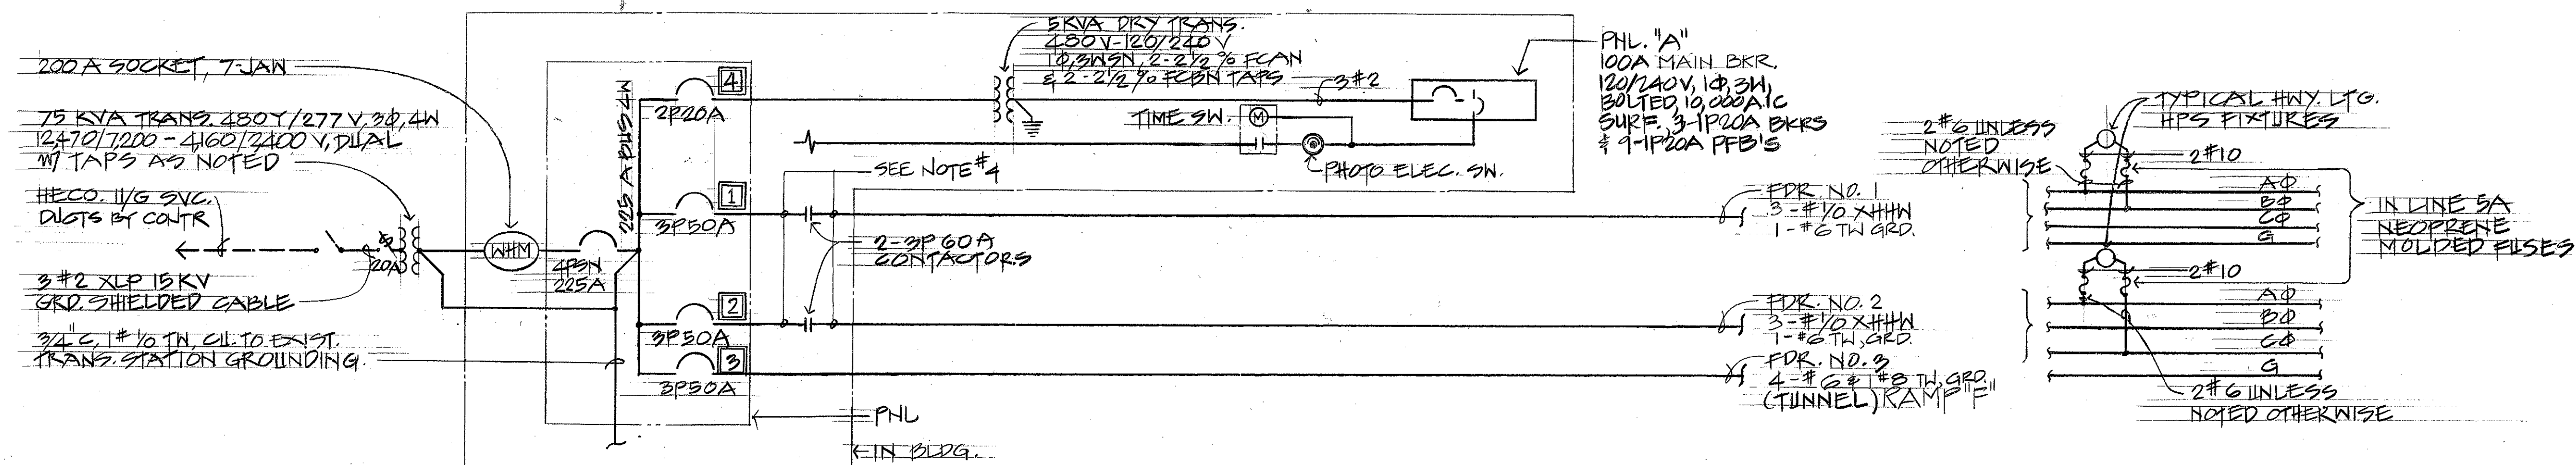

NOTES: 1. FOR SIGN LTG. WIRING, SEE SHT. E-26.
2. CONN. HWY. LT. ON ALTERNATE PHASES TO BALANCE LOADS
3. FOR GROUNDING, SEE NOTE ①, SHT. E-1.
4. TRIM CABLE STRANDS TO FIT LUGS.

ORIGINAL PLAN	SURVEY PLOTTED BY _____	DATE _____
	DRAWN BY _____	" _____
	TRACED BY _____	" _____
	DESIGNED BY _____	" _____
	QUANTITIES BY _____	" _____
	CHECKED BY _____	" _____
No. _____		

One Eastern Blvd., Suite 402
New York, New York 10013



THIS WORK WAS PREPARED BY
 [REDACTED] UNDER THE SUPERVISION OF
 [REDACTED]

Youn Nakamura

INTERSTATE ROUTE H-1
HIGHWAY LIGHTING IMPROVEMENTS
AALA STREET TO PINCHBOWL STREET
KEEAWMUK STREET TO OLD WIALAE ROAD
PROJECT NO. IR-HI-1(186)

SCALE: AS NOTED DATE: 30 JAN '87

SHEET No. E-2 OF 32 SHEETS