


[illegible]


NOTES:

1. FOR SIGN LTG. WIRING SEE SH. E-2G.
2. CONNECT HWY. LT. ON ALTERNATE PHASES TO BALANCE LOAD.
3. FOR GROUNDING, SEE NOTE ①, SH. E-1.
4. TRIM CABLE STRANDS TO FIT LUGS.

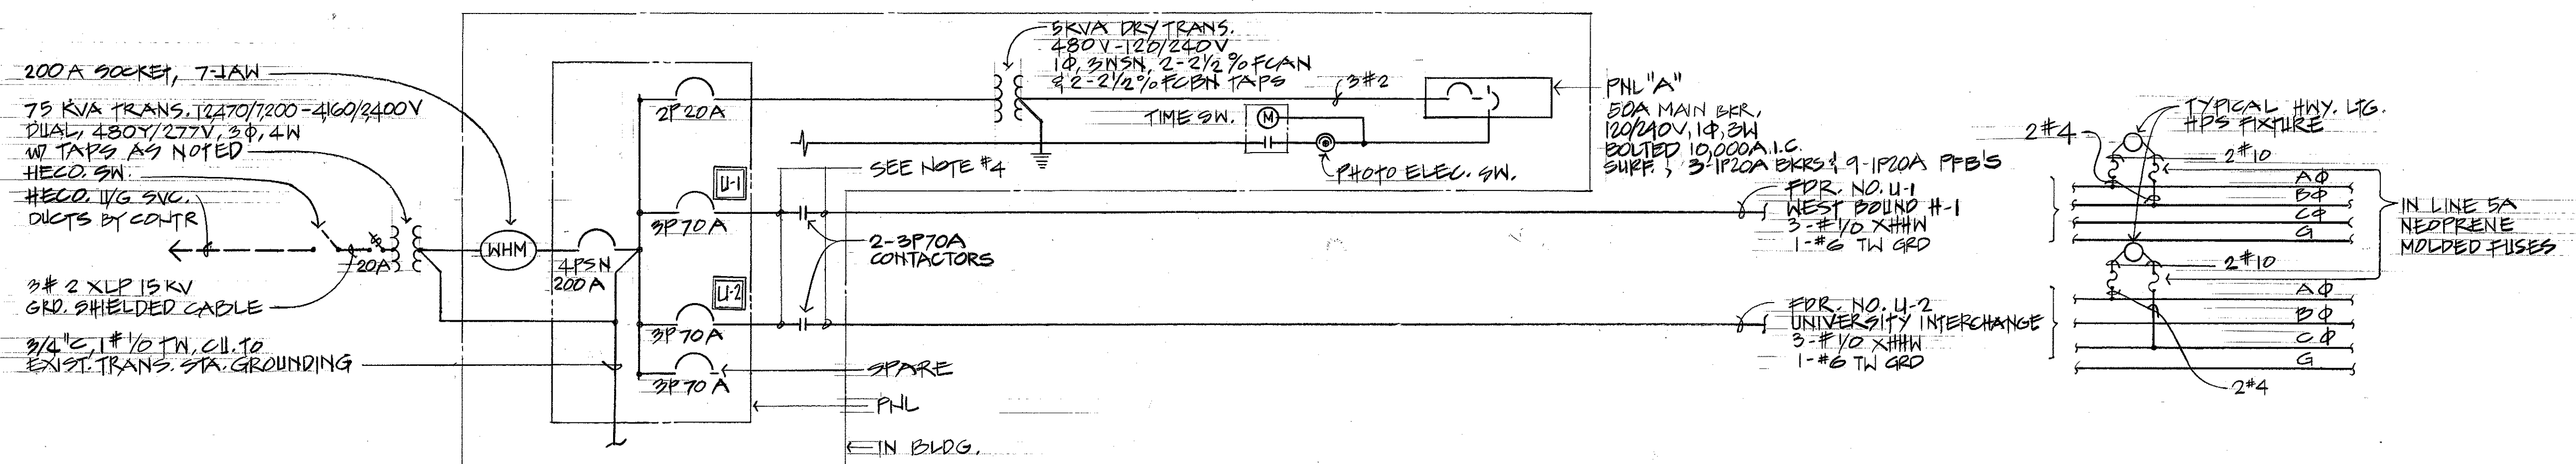

NOTES:

1. FOR SIGN LTG. WIRING, SEE SHT. E-2G.
2. CONNECT HWT. LT. ON ALTERNATE PHASES TO BALANCE LOAD.
3. FOR GROUNDING, SEE NOTE ①, SHT. E-1.
4. TRIM CABLE STRANDS TO FIT LUGS.

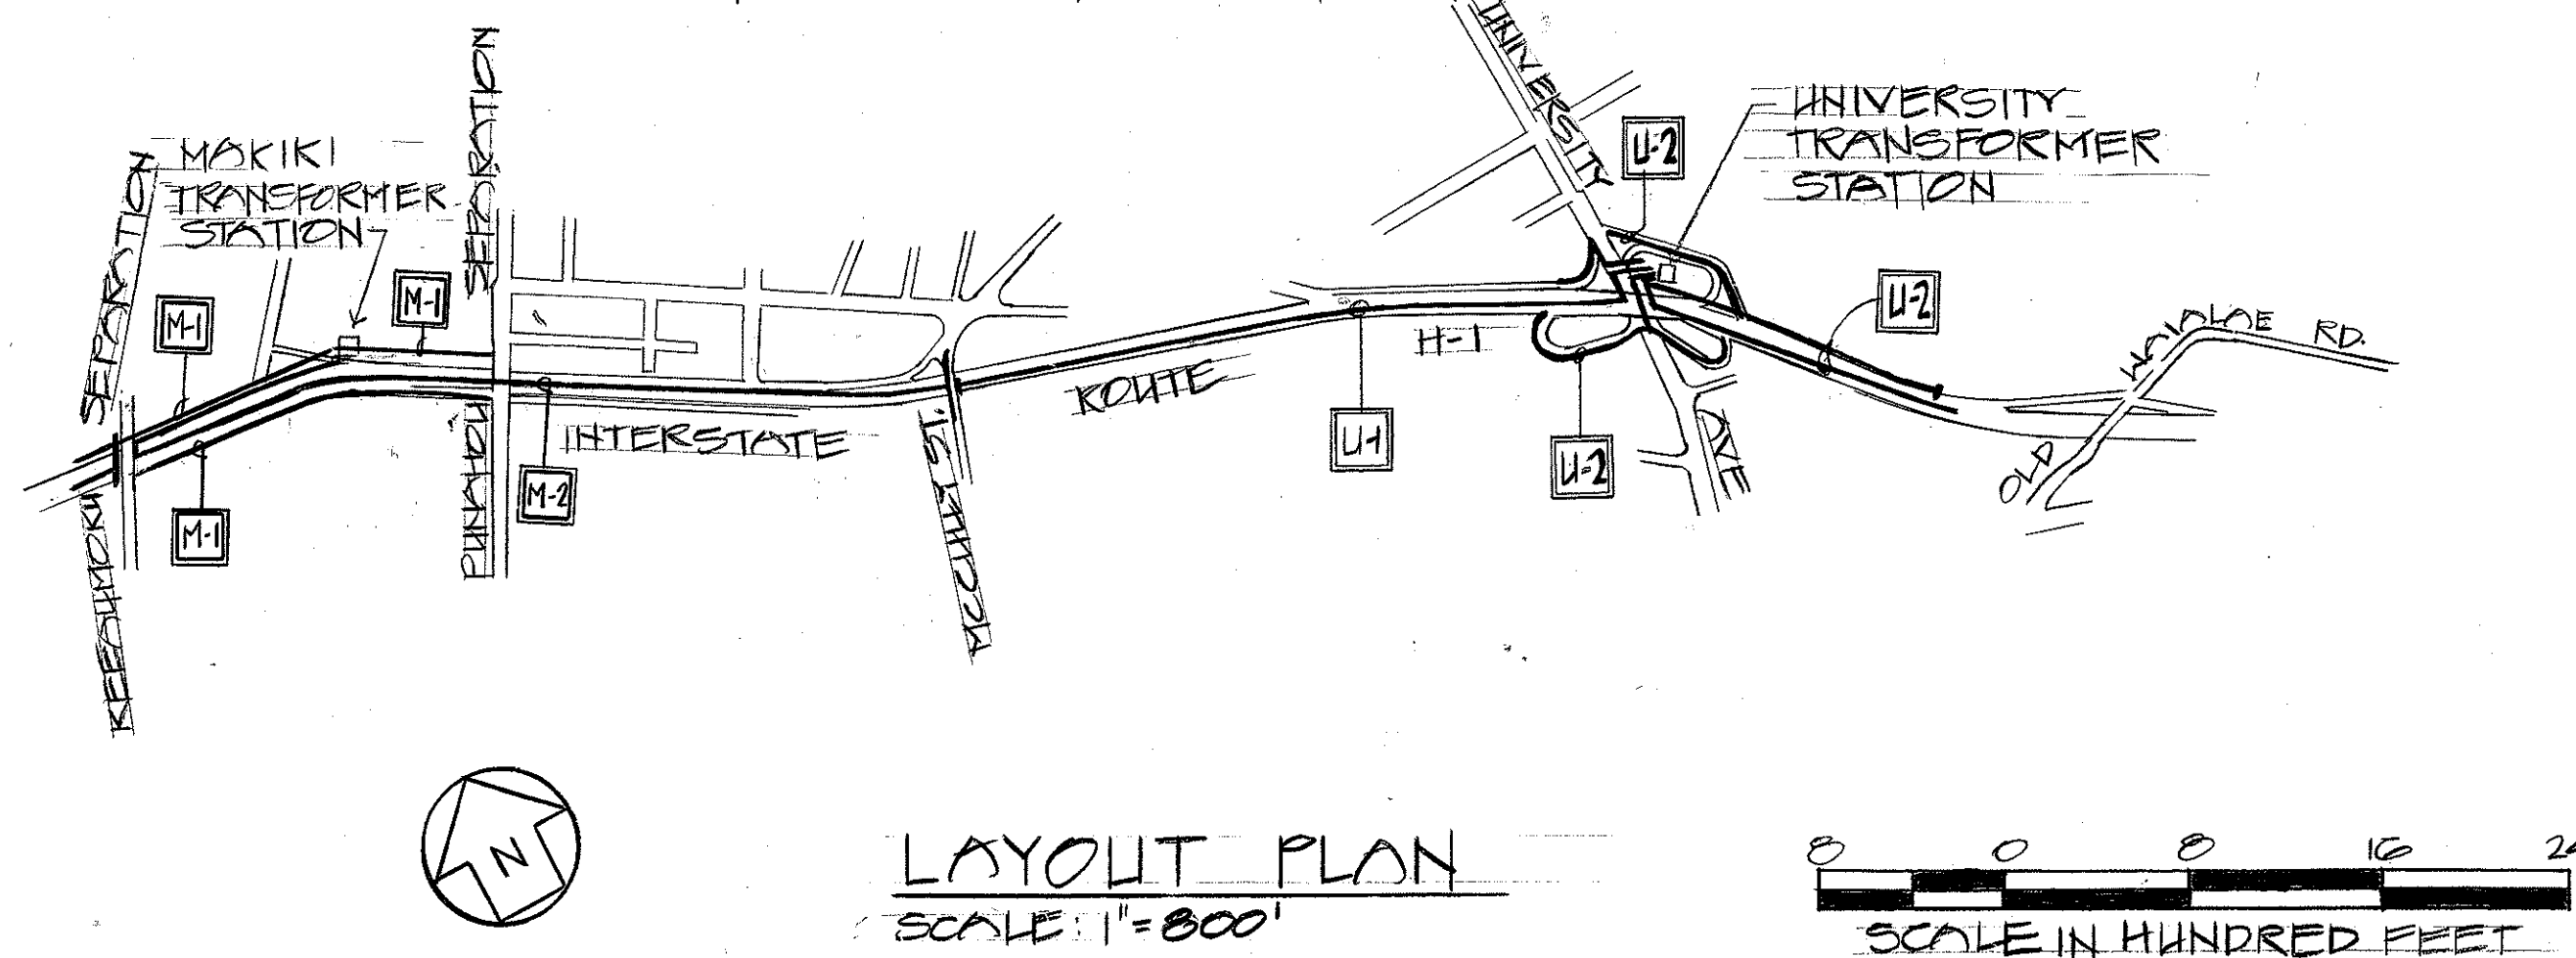

STATE OF HAWAII
DEPARTMENT OF TRANSPORTATION
HIGHWAYS DIVISION

HIGHWAY LIGHTING SYSTEM

INTERSTATE ROUTE H-1
HIGHWAY LIGHTING IMPROVEMENTS
AALA STREET TO PINCHBOWL STREET
KEEAUMOKU STREET TO OLD WAILALAE ROAD
PROJECT NO. IR - H-1-1 (180)

SCALE: AS NOTED DATE: 30 JAN '87

SHEET No.E -II OF 32 SHEETS