Secretarion of the second secretarion of the second		CONTROL CONTRO	TO NO SAME THE RESIDENCE OF THE SAME TO SAME TO SAME TO SAME THE SAME TH	enterporpular reportance inco	Samuel Celebration of Manager Manager	ives miornimo cari
	INDEX	ТО	DRAWINGS		-	
SHEET NO.			DESCRIPTION		<del>777/111</del>	
1 - 63	PROJ.	NO.	IR-HI-1(20	4)		
64 - 97	PROJ	NO.	IR-HI-I(18	6)		
		-				
					-	
	,,,,,,,,,,,,,,,,,,,,,,,,,,,,,,,,,,,,,,,					
			and the second s			
	*					
		,				
:					,	
,	1 '0 '0	-				- 111
-						
		7				
•						

STATE OF HAWAII

DEPARTMENT OF TRANSPORTATION HIGHWAYS DIVISION HONOLULU, HAWAII


> "AS-BUILT" PLANS FOR

INTERSTATE ROUTE H-I RESURFACING MIDDLE STREET TO AINAKOA AVENUE F. A. I. PROJECT NO. IR-HI-I(204)

AND

INTERSTATE ROUTE H-I HIGHWAY LIGHTING IMPROVEMENTS AALA STREET TO PUNCHBOWL STREET AND KEEAUMOKU STREET TO OLD WAIALAE ROAD F. A.I. PROJECT NO. IR-HI-I(186)

> DISTRICT OF HONOLULU ISLAND OF OAHU

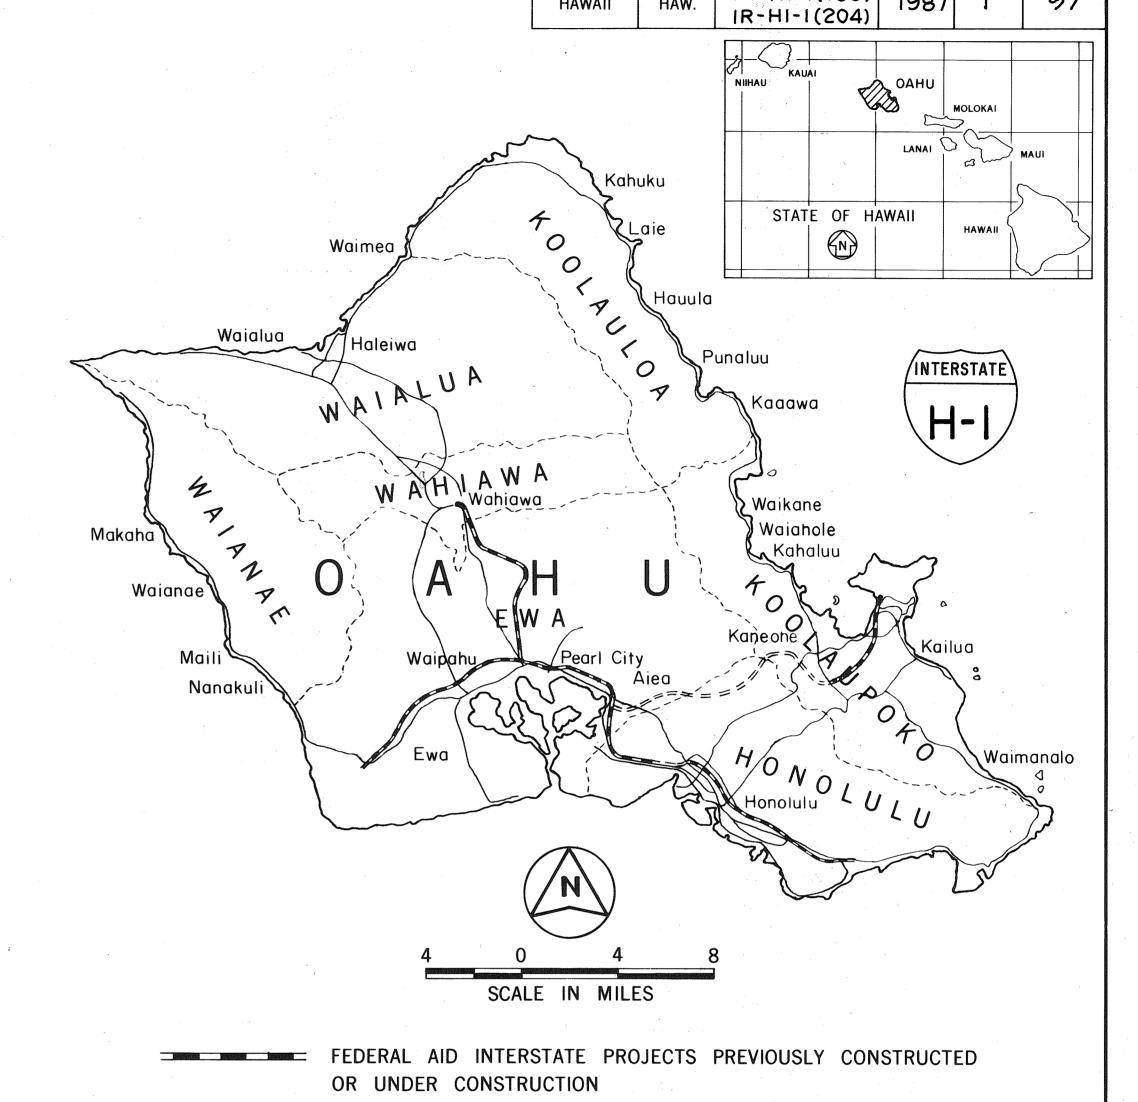

CHANGES MADE DURING CONSTRUCTION HAVE BEEN INCORPORATED ON THESE PLANS EXCEPT CHANGES IN THE ORIGINAL THEORETICAL QUANTITIES. FOR ACTUAL QUANTITIES, REFER TO PROJECT LEDGER AND/OR COMPUTATION BOOK.\*

RESIDENT ENGINEER